FED. ROAD DIST. NO.	STATE	PROJ. NO.	FISCAL YEAR	SHEET NO.	TOTAL SHEETS
HAWAII	HAW.	93A-01-01 93A-02-01	2004	1	48

INDEX TO DRAWINGS

SHEET NO.	DESCRIPTION
1	TITLE SHEET
2	STANDARD PLANS SUMMARY
3	GENERAL NOTES AND LEGEND
4 – 6	UTILITIES NOTES
7 – 8	WATER POLLUTION & EROSION CONTROL NOTES
9 – 14	SIDEWALK & DRIVEWAY DETAILS
15 – 16	PLAN
17 – 24	DRAINAGE PLAN
25 – 26	DRAINAGE PROFILE
27 – 38	DRAINAGE DETAILS
39 – 42	GUARDRAIL DETAILS AND NOTES
43 – 45	WATER LINE PLAN & PROFILE
46 - 47	LOOP DETECTOR DETAILS
48	DETECTABLE WARNING DETAILS

STATE OF HAWAII

DEPARTMENT OF TRANSPORTATION

HIGHWAYS DIVISION

HONOLULU, HAWAII

"AS-BUILT" PLANS FOR

FARRINGTON HIGHWAY DRAINAGE IMPROVEMENTS

VICINITY OF NANAKULI AVENUE TO NANAKULI STREAM AND VICINITY OF LUALEI PLACE TO PRINCESS KAHANU AVENUE

PROJECT NOS. 93A-01-01 AND 93A-02-01

DISTRICTS OF EWA AND WAIANAE

ISLAND OF OAHU

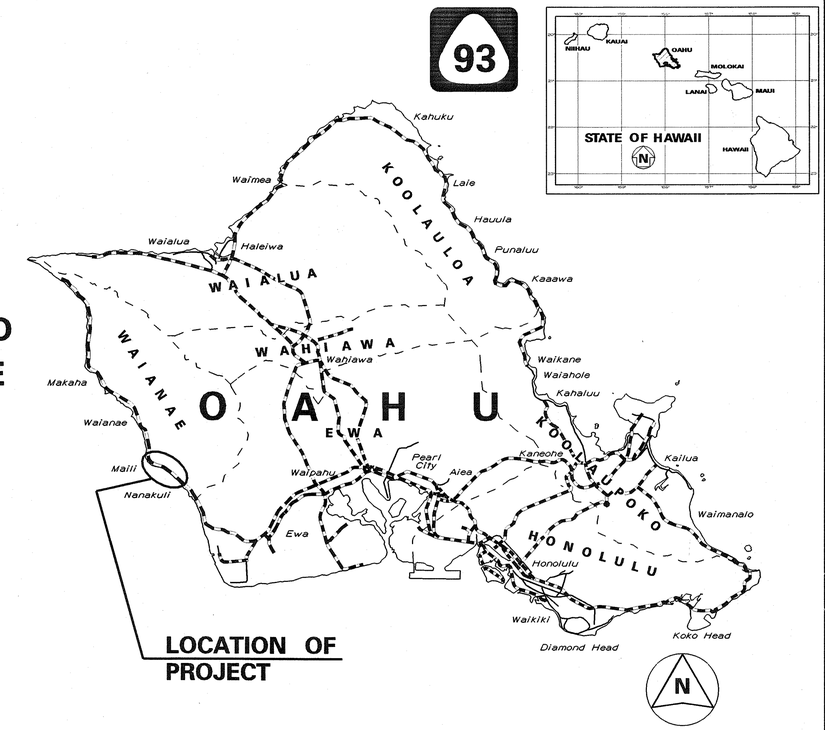

FEDERAL AID PROJECTS PREVIOUSLY CONSTRUCTED OR UNDER CONSTRUCTION

I. MILE POST 4.81 TO MILE POST 5.26

III. MILE POST 6.54 TO MILE POST 6.81

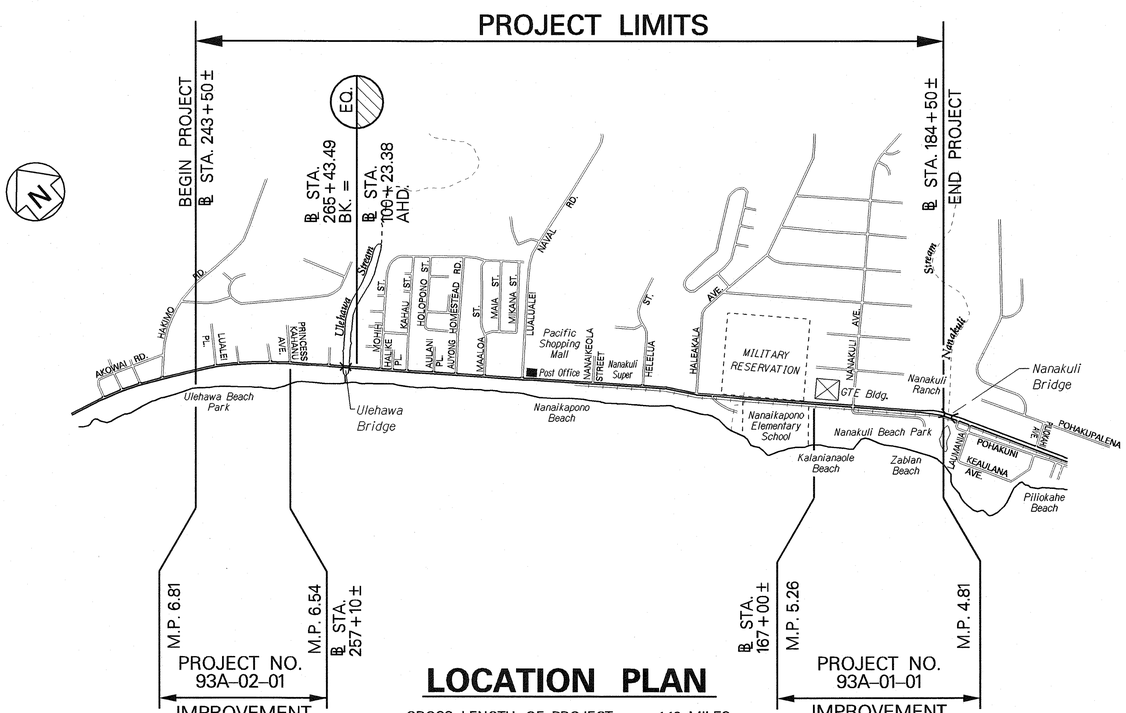

LOCATION PLAN

GROSS LENGTH OF PROJECT.....1.16 MILES

NET LENGTH OF PROJECT.....1.16 MILES

1 0 1 2 3

SCALE IN THOUSAND FEET

CHANGES MADE DURING CONSTRUCTION HAVE BEEN INCORPORATED ON THESE PLANS EXCEPT CHANGES IN THE ORIGINAL THEORETICAL QUANTITIES. FOR ACTUAL QUANTITIES, REFER TO PROJECT LEDGER AND/OR CONSTRUCTION BOOK.

RESIDENT ENGINEER — DATE 1/28/09

DEPARTMENT OF TRANSPORTATION STATE OF HAWAII	
APPROVED:	
for DIR. OF TRANSPORTATION	DATE 5/9/03

HWY-D DESIGNED BY | HWY-DD MANAGED BY | 692-7570 PHONE | AUGUST, 2002 DATE

kfardfsht.dgn loglin gwen r1-11-99

DDO Highway Design Section