



FED. ROAD DIST. NO.	STATE	FED. AID PROJ. NO.	FISCAL YEAR	SHEET NO.	TOTAL SHEETS
HAWAII	HAW.	BR-093-1(20)	2020	ADD.32	168

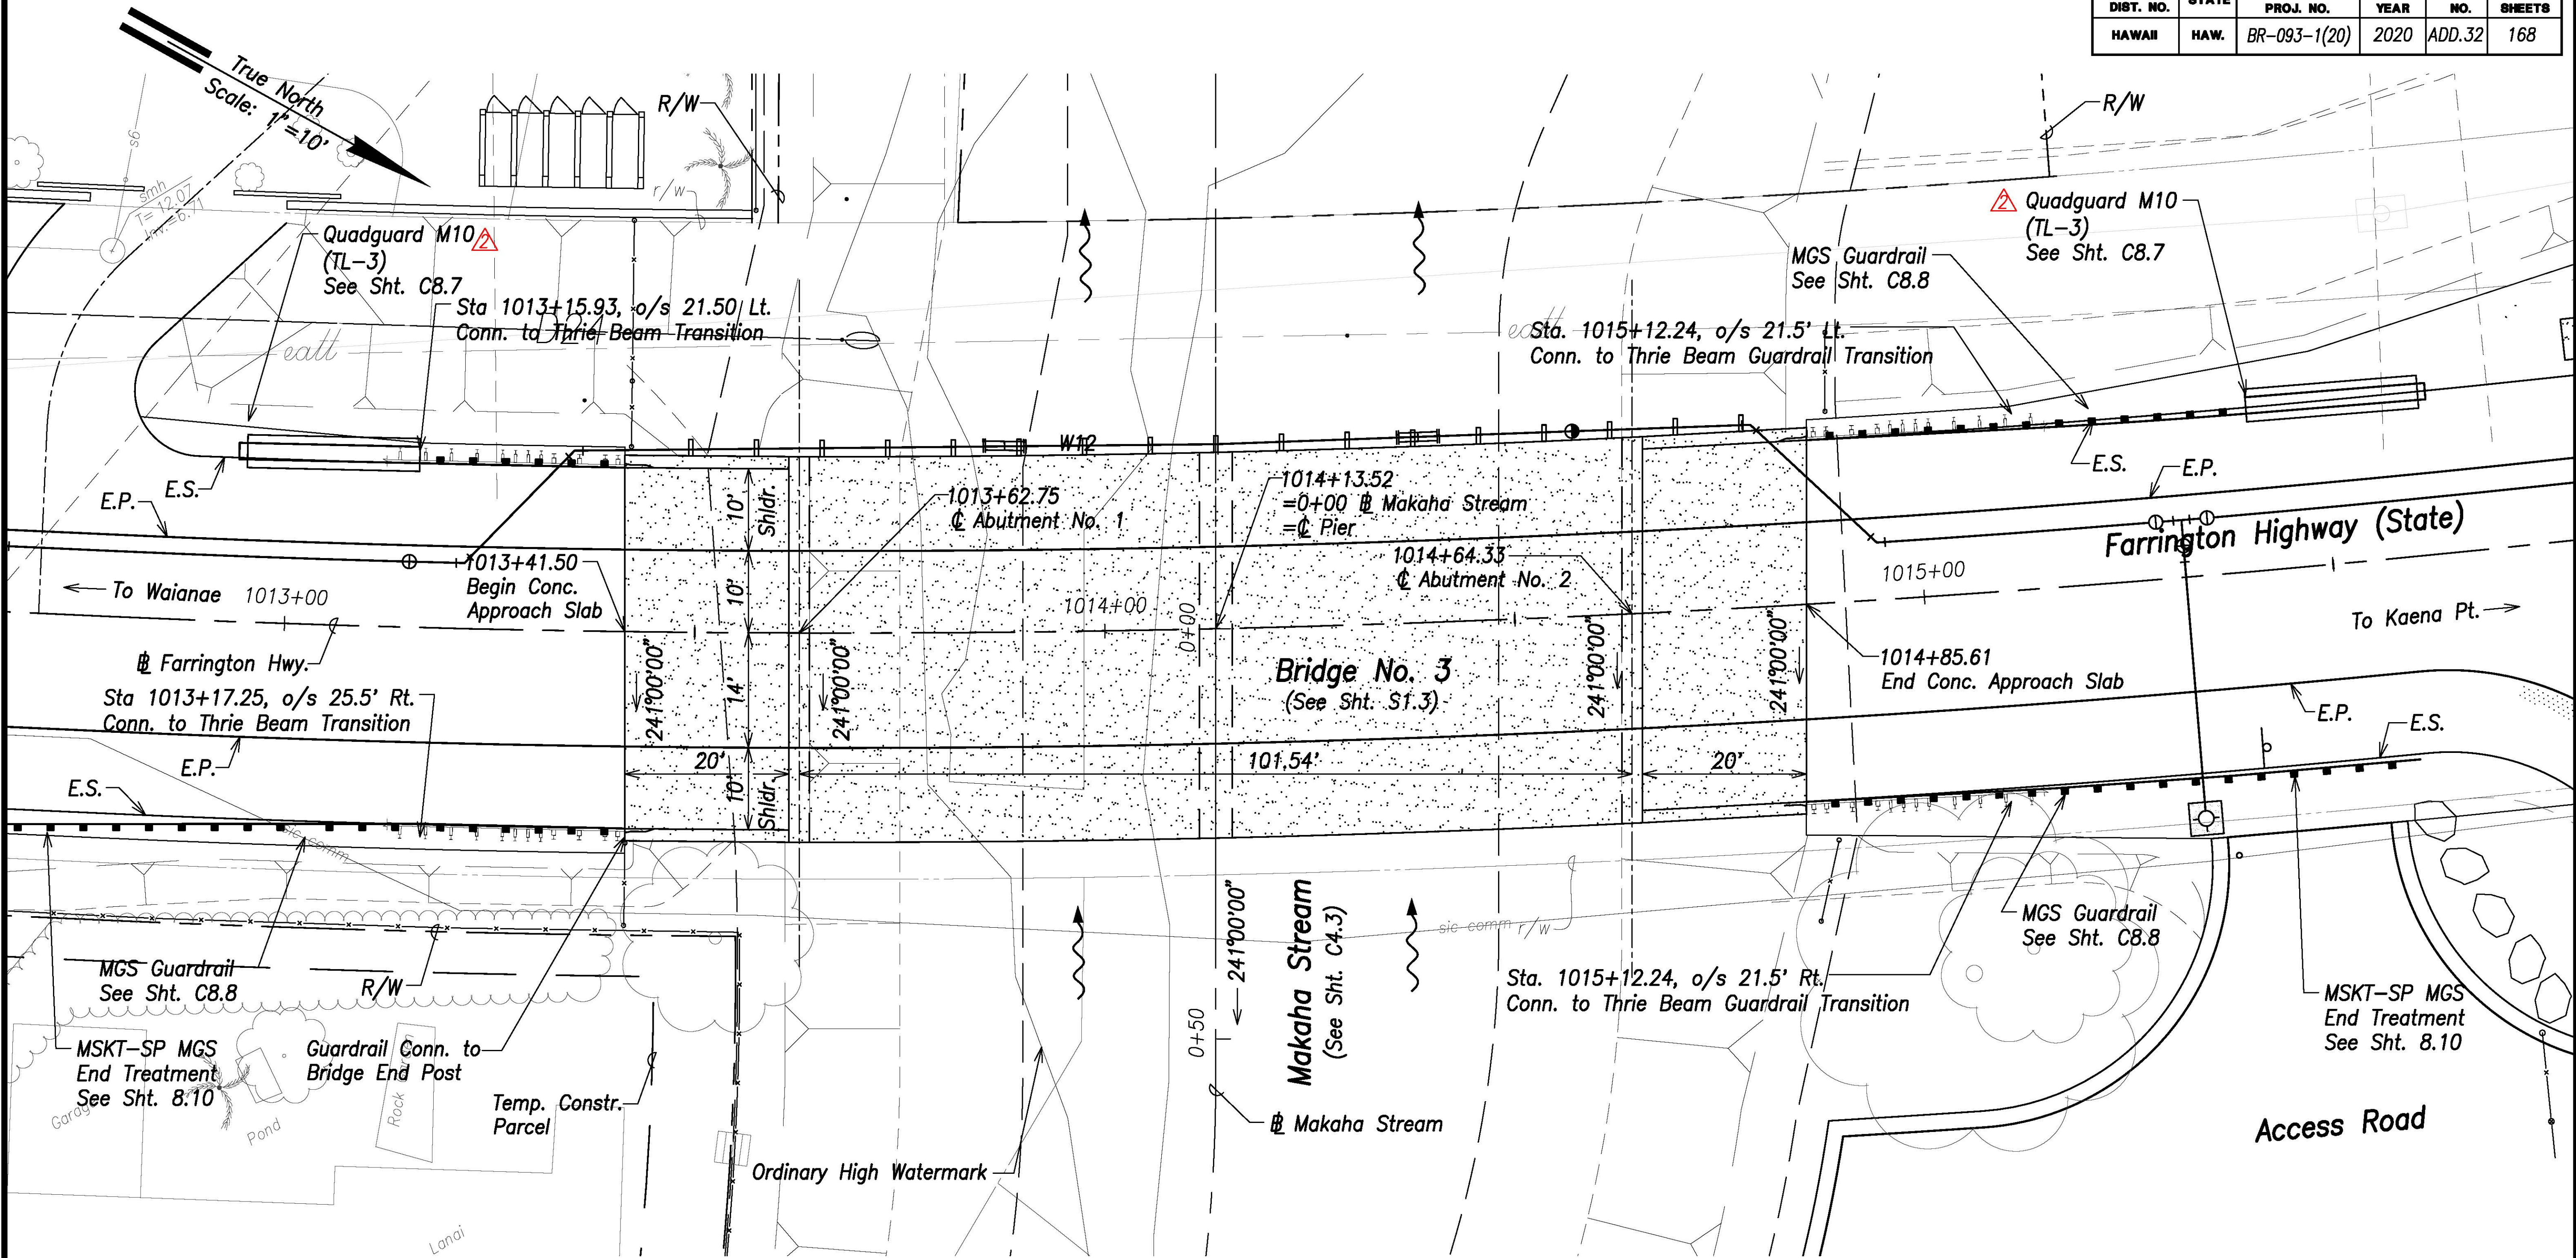

Makaha Bridge No. 3 Plan
Scale: 1"=10'

APPROVED:

Manager and Chief Engineer,
Board of Water Supply
(For work affecting BWS facilities in
City/State R/W and easements only)

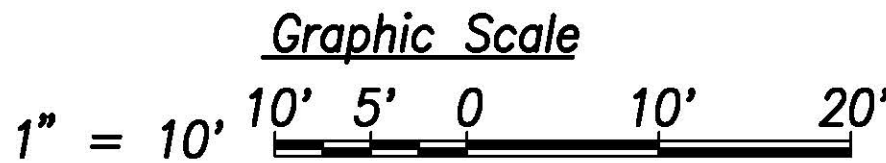


THIS WORK WAS PREPARED BY ME
OR UNDER MY SUPERVISION AND
CONSTRUCTION OF THIS PROJECT
WILL BE UNDER MY OBSERVATION.

Michael H. Okamoto
SIGNATURE EXPIRATION DATE
OF THE LICENSE

11/18/20	Added Approval Block, Revised Callout
Date	Description
STATE OF HAWAII DEPARTMENT OF TRANSPORTATION HIGHWAYS DIVISION	
BRIDGE NO. 3 PLAN	
FARRINGTON HIGHWAY	
Replacement of Makaha Bridge	
No. 3 and Makaha Bridge 3A	
F. A. Project No. BR-093-1(20)	
Scale: 1" = 10'	Date: July 2020
SHEET No. C4.1 OF 168 SHEETS	


FED. ROAD DIST. NO.	STATE	FED. AID PROJ. NO.	FISCAL YEAR	SHEET NO.	TOTAL SHEETS
HAWAII	HAW.	BR-093-1(20)	2020	ADD.33	168

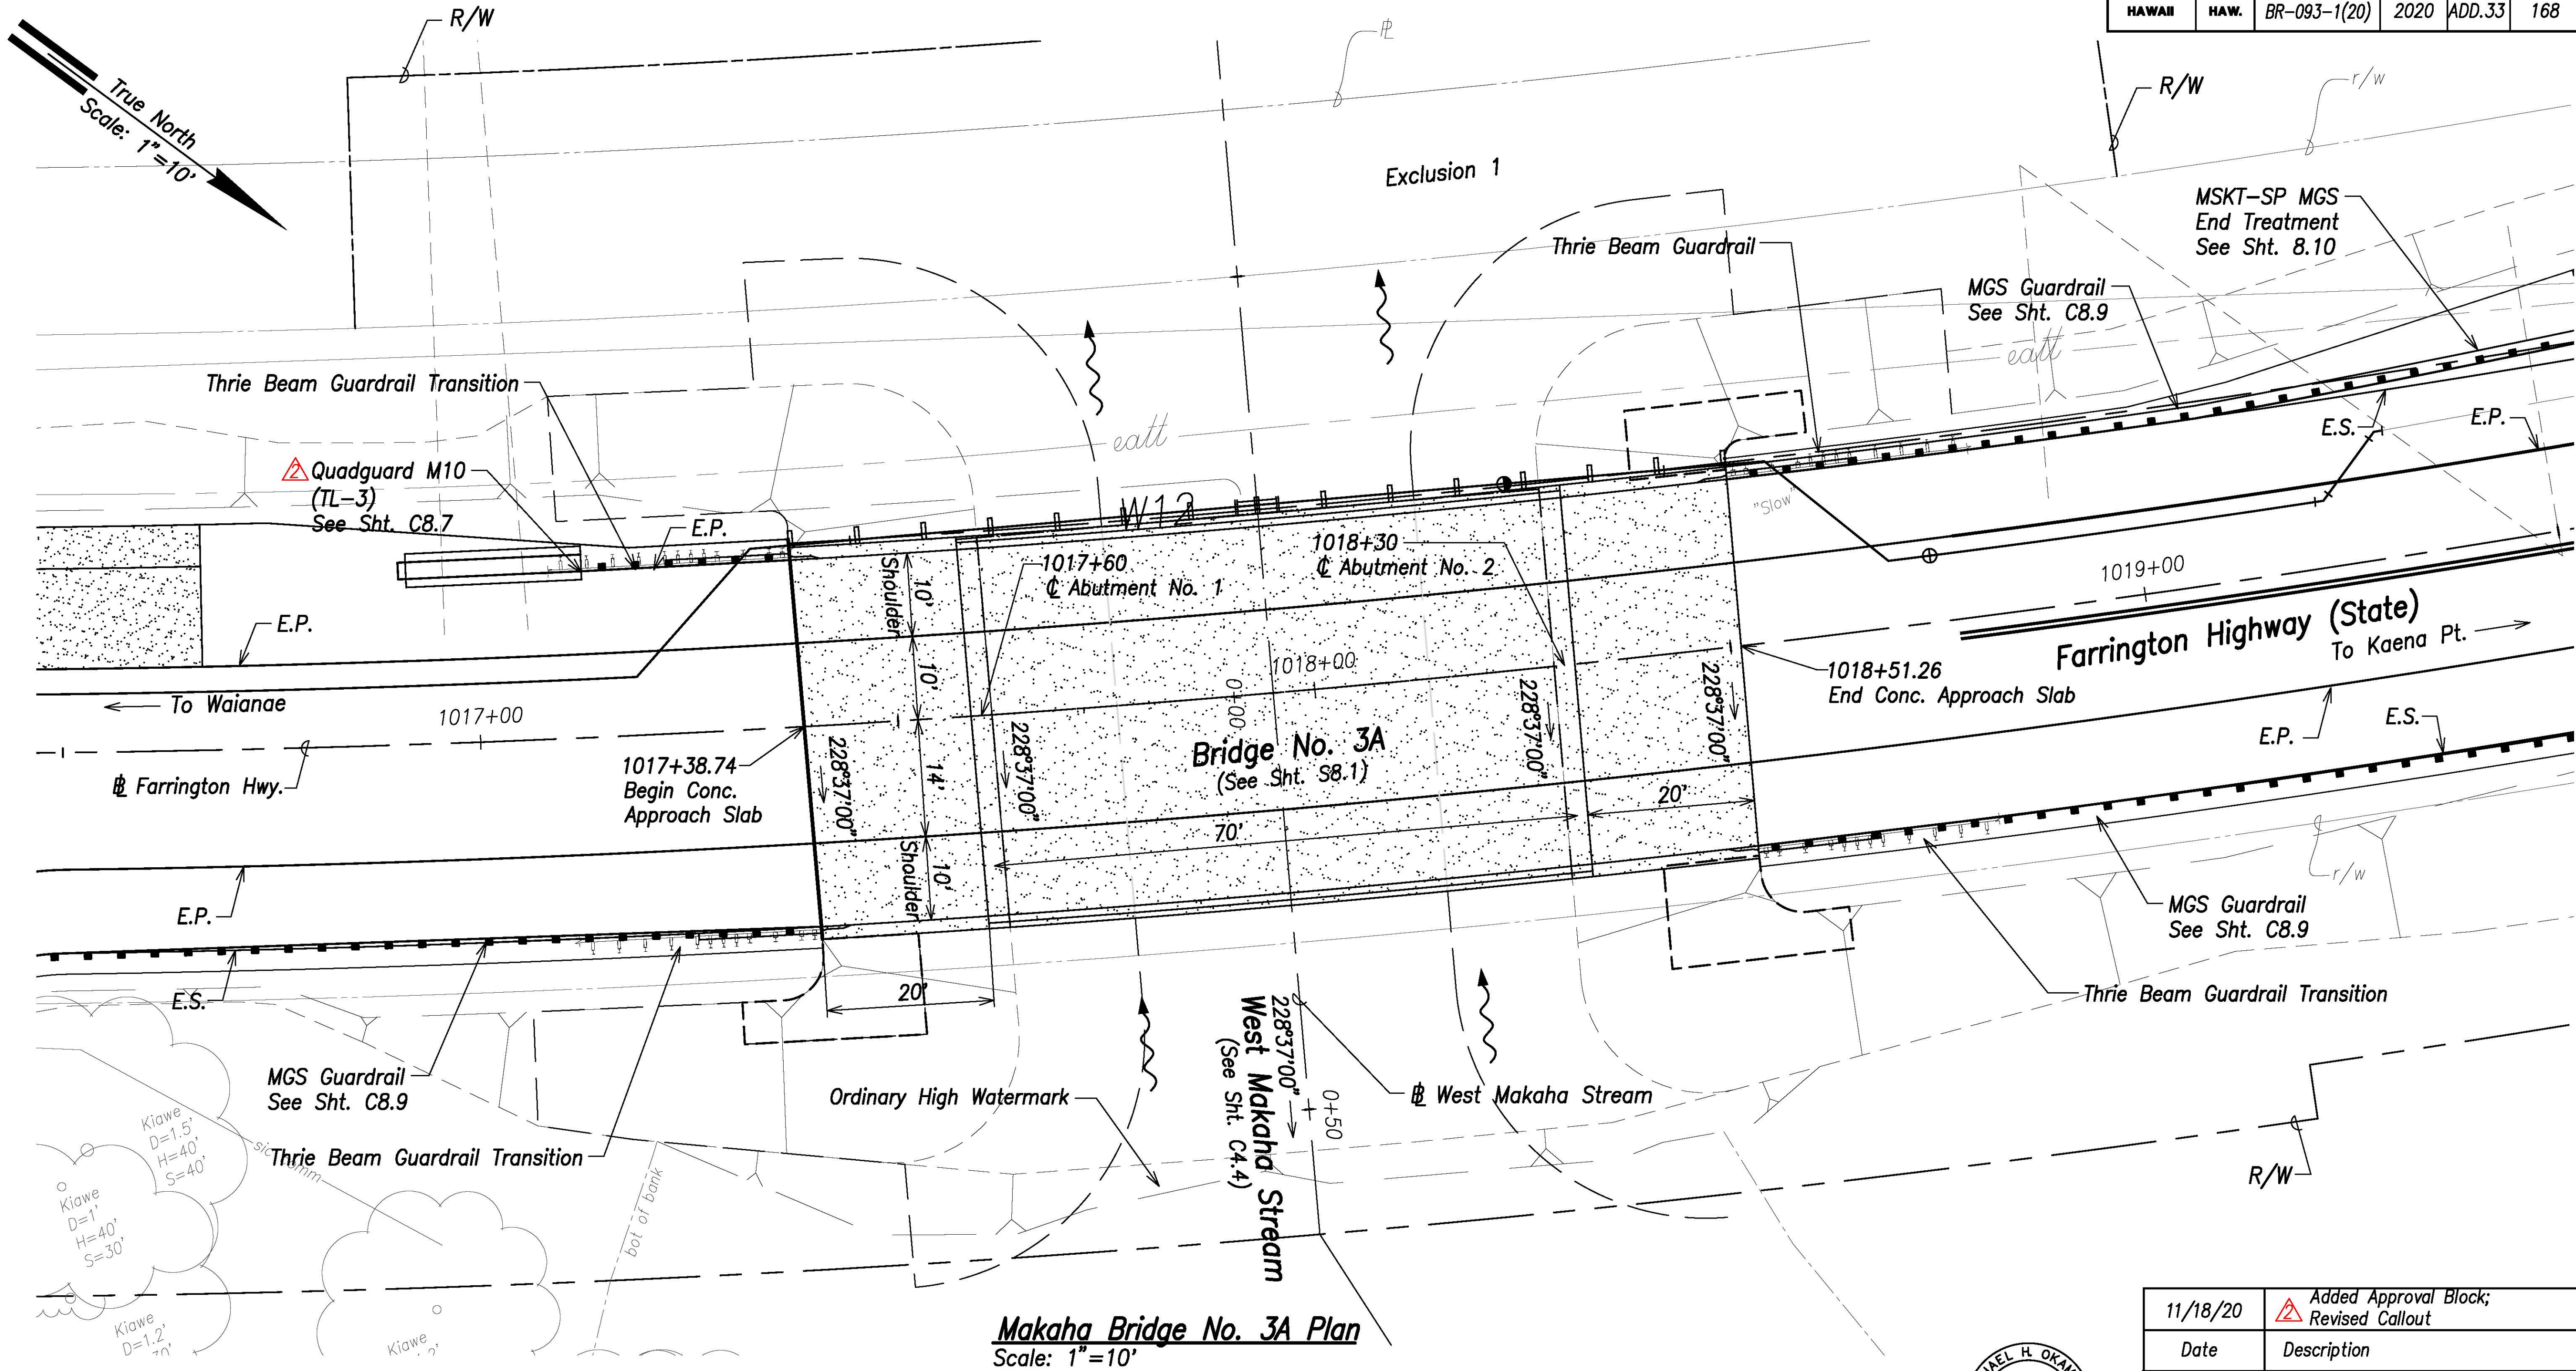

Makaha Bridge No. 3A Plan
Scale: 1"=10'

APPROVED:

Manager and Chief Engineer,
Board of Water Supply
(For work affecting BWS facilities in
City/State R/W and easements only)

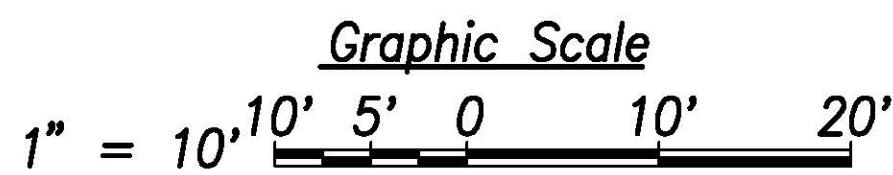

THIS WORK WAS PREPARED BY ME
OR UNDER MY SUPERVISION AND
CONSTRUCTION OF THIS PROJECT
WILL BE UNDER MY OBSERVATION.

Michael H. Okamoto
SIGNATURE EXPIRATION DATE
OF THE LICENSE

11/18/20	Added Approval Block; Revised Callout
Date	Description
DEPARTMENT OF TRANSPORTATION HIGHWAYS DIVISION	
BRIDGE NO. 3A PLAN	
FARRINGTON HIGHWAY	
Replacement of Makaha Bridge	
No. 3 and Makaha Bridge 3A	
F. A. Project No. BR-093-1(20)	
Scale: 1" = 10'	Date: July 2020
SHEET No. C4.2 OF 168 SHEETS	