FED. ROAD DIST. NO.	STATE	PROJ. NO.	FISCAL YEAR	SHEET NO.	TOTAL SHEETS
HAWAII	HAW.	93A-01-06M	2010	1	36

93

INDEX TO DRAWINGS

SHEET NO.	DESCRIPTION
1	TITLE SHEET
2	STANDARD PLANS SUMMARY
3	GENERAL NOTES AND LEGEND
4 – 5	WATER POLLUTION AND EROSION CONTROL NOTES
6 – 9	TYPICAL SECTIONS AND DETAILS
10 – 20	ROADWAY PLANS
21	PAVEMENT MARKINGS LEGEND DETAILS AND NOTES
22 – 23	WORK ZONE SIGNING PLANS
24 – 34	PAVEMENT STRIPING AND SIGNING PLANS
35 – 36	LOOP DETECTOR PLAN AND DETAILS

STATE OF HAWAII

DEPARTMENT OF TRANSPORTATION

HIGHWAYS DIVISION

HONOLULU, HAWAII

"AS-BUILT"

PLANS FOR

FARRINGTON HIGHWAY PAVEMENT PREVENTIVE MAINTENANCE

KEANANOIO BRIDGE TO PALAILAI INTERCHANGE

PROJECT NO. 93A-01-06M

DISTRICT OF EWA

ISLAND OF OAHU

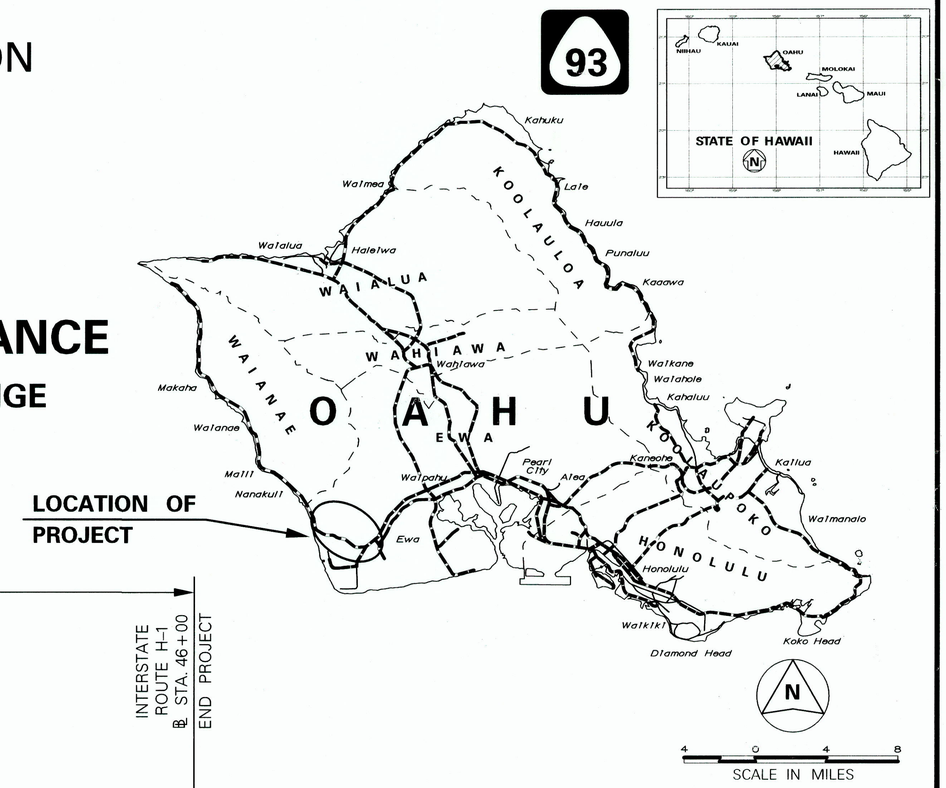

PROJECT LIMITS

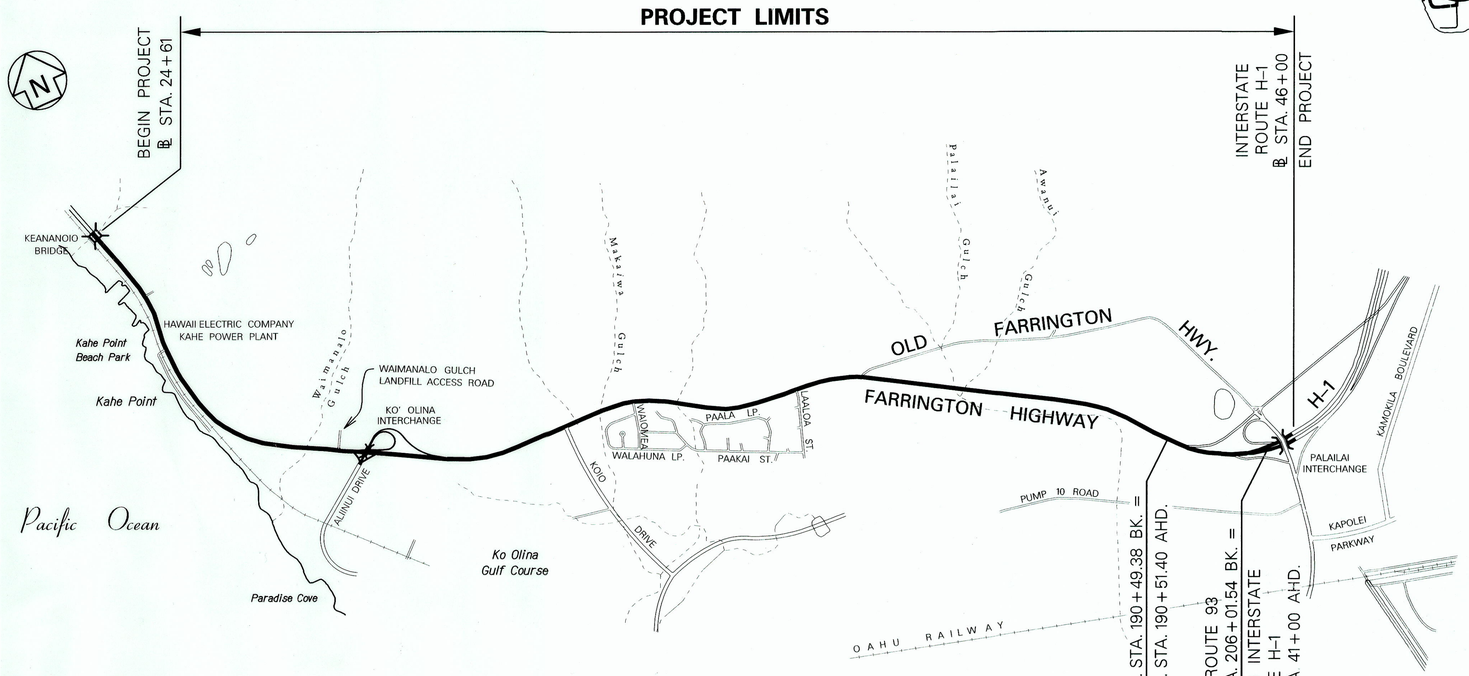

LOCATION PLAN

LENGTH OF PROJECT..... 3.52 MILES

1 0 1 2 3

SCALE IN THOUSAND FEET

N

4 0 4 8

SCALE IN MILES

FEDERAL AID PROJECTS PREVIOUSLY CONSTRUCTED OR UNDER CONSTRUCTION

ROUTE 93: MILE POST 3.43 TO MILE POST 0.00

ROUTE H-1: MILE POST 0.00 TO MILE POST 0.09

CHANGES MADE DURING CONSTRUCTION HAVE BEEN INCORPORATED ON THESE PLANS EXCEPT CHANGES IN THE ORIGINAL THEORETICAL QUANTITIES. FOR ACTUAL QUANTITIES, REFER TO PROJECT LEDGER AND/OR COMPUTATION BOOK.

RESIDENT ENGINEER — DATE 12/11/13

DEPARTMENT OF TRANSPORTATION
STATE OF HAWAII

APPROVED:

DIR. OF TRANSPORTATION — DATE 5/11/10

HWY-D DESIGNED BY | HWY-DD MANAGED BY | 692-7570 PHONE | MAY 2010 DATE