FED. ROAD DIST. NO.	STATE	FED. AID PROJ. NO.	FISCAL YEAR	SHEET NO.	TOTAL SHEETS
Hawaii	HAW	BF-098-1(2) UNIT 1	1957	2	6

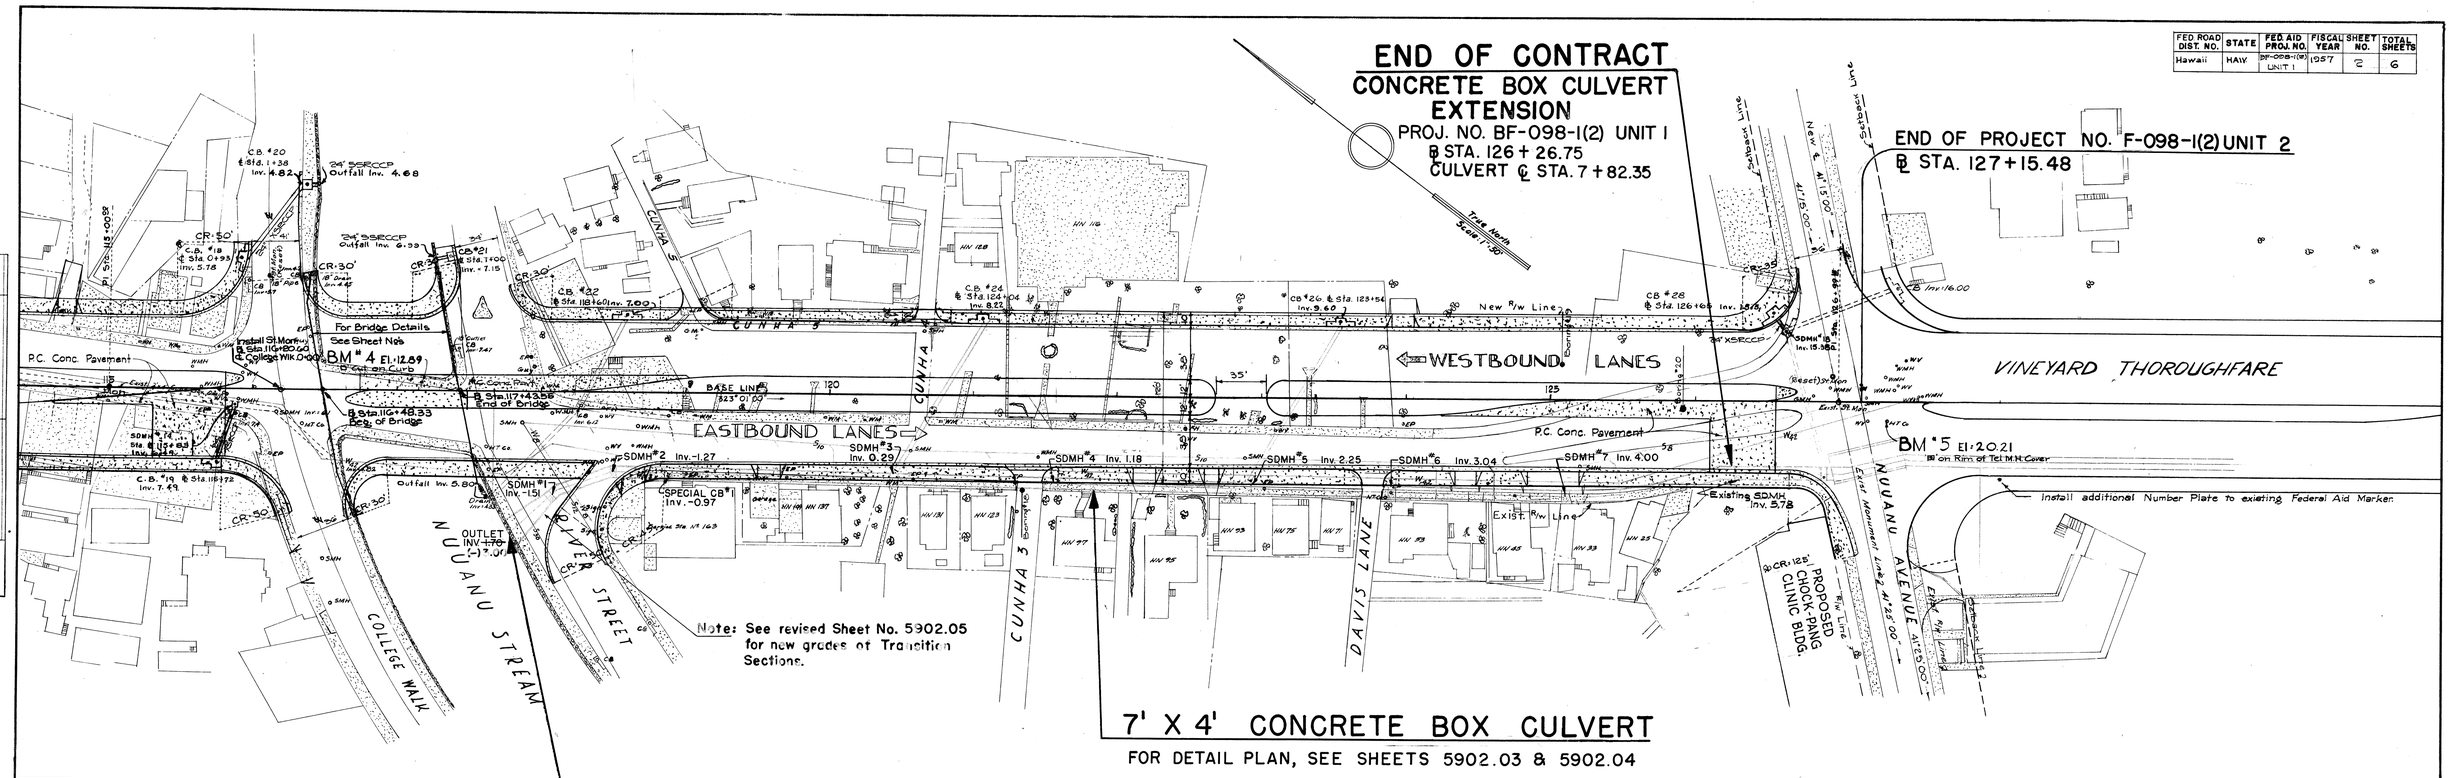

PLAN: SURVEYED, PLOTTED, GRADES CHECKED, BLAUPUNKTS CHECKED, STRUCTURE NOTATIONS CH'KD. — NOTE BOOK, NO. — BY — DATE

PROFILE: SURVEYED, PLOTTED, GRADES CHECKED, BLAUPUNKTS CHECKED, STRUCTURE NOTATIONS CH'KD. — NOTE BOOK, NO. — BY — DATE

PLATE 1 – PLAN-PROFILE O. P. R. & R. E. STANDARD
KEUFFEL & ESSER CO., NEW YORK.
K & E Co. No. 348

5902.02