


FED. ROAD DIST. NO.	STATE	FED. AID PROJ. NO.	FISCAL YEAR	SHEET NO.	TOTAL SHEETS
HAWAII	HAW.	I-HI-1(3) Unit 1	1967	13A	292

FINAL SURVEY	BY	DATE
SURVED		
PLOTTED		
NOTE BOOK TEMPLATE		
NO.	AREAS CHECKED	

ORIGINAL	SURVEYED	BY	DATE
SURVEY	PLOTTED		
NOTE BOOK	TEMPLATE		
AREAS	AREAS		
NO.	AREAS CHECKED		

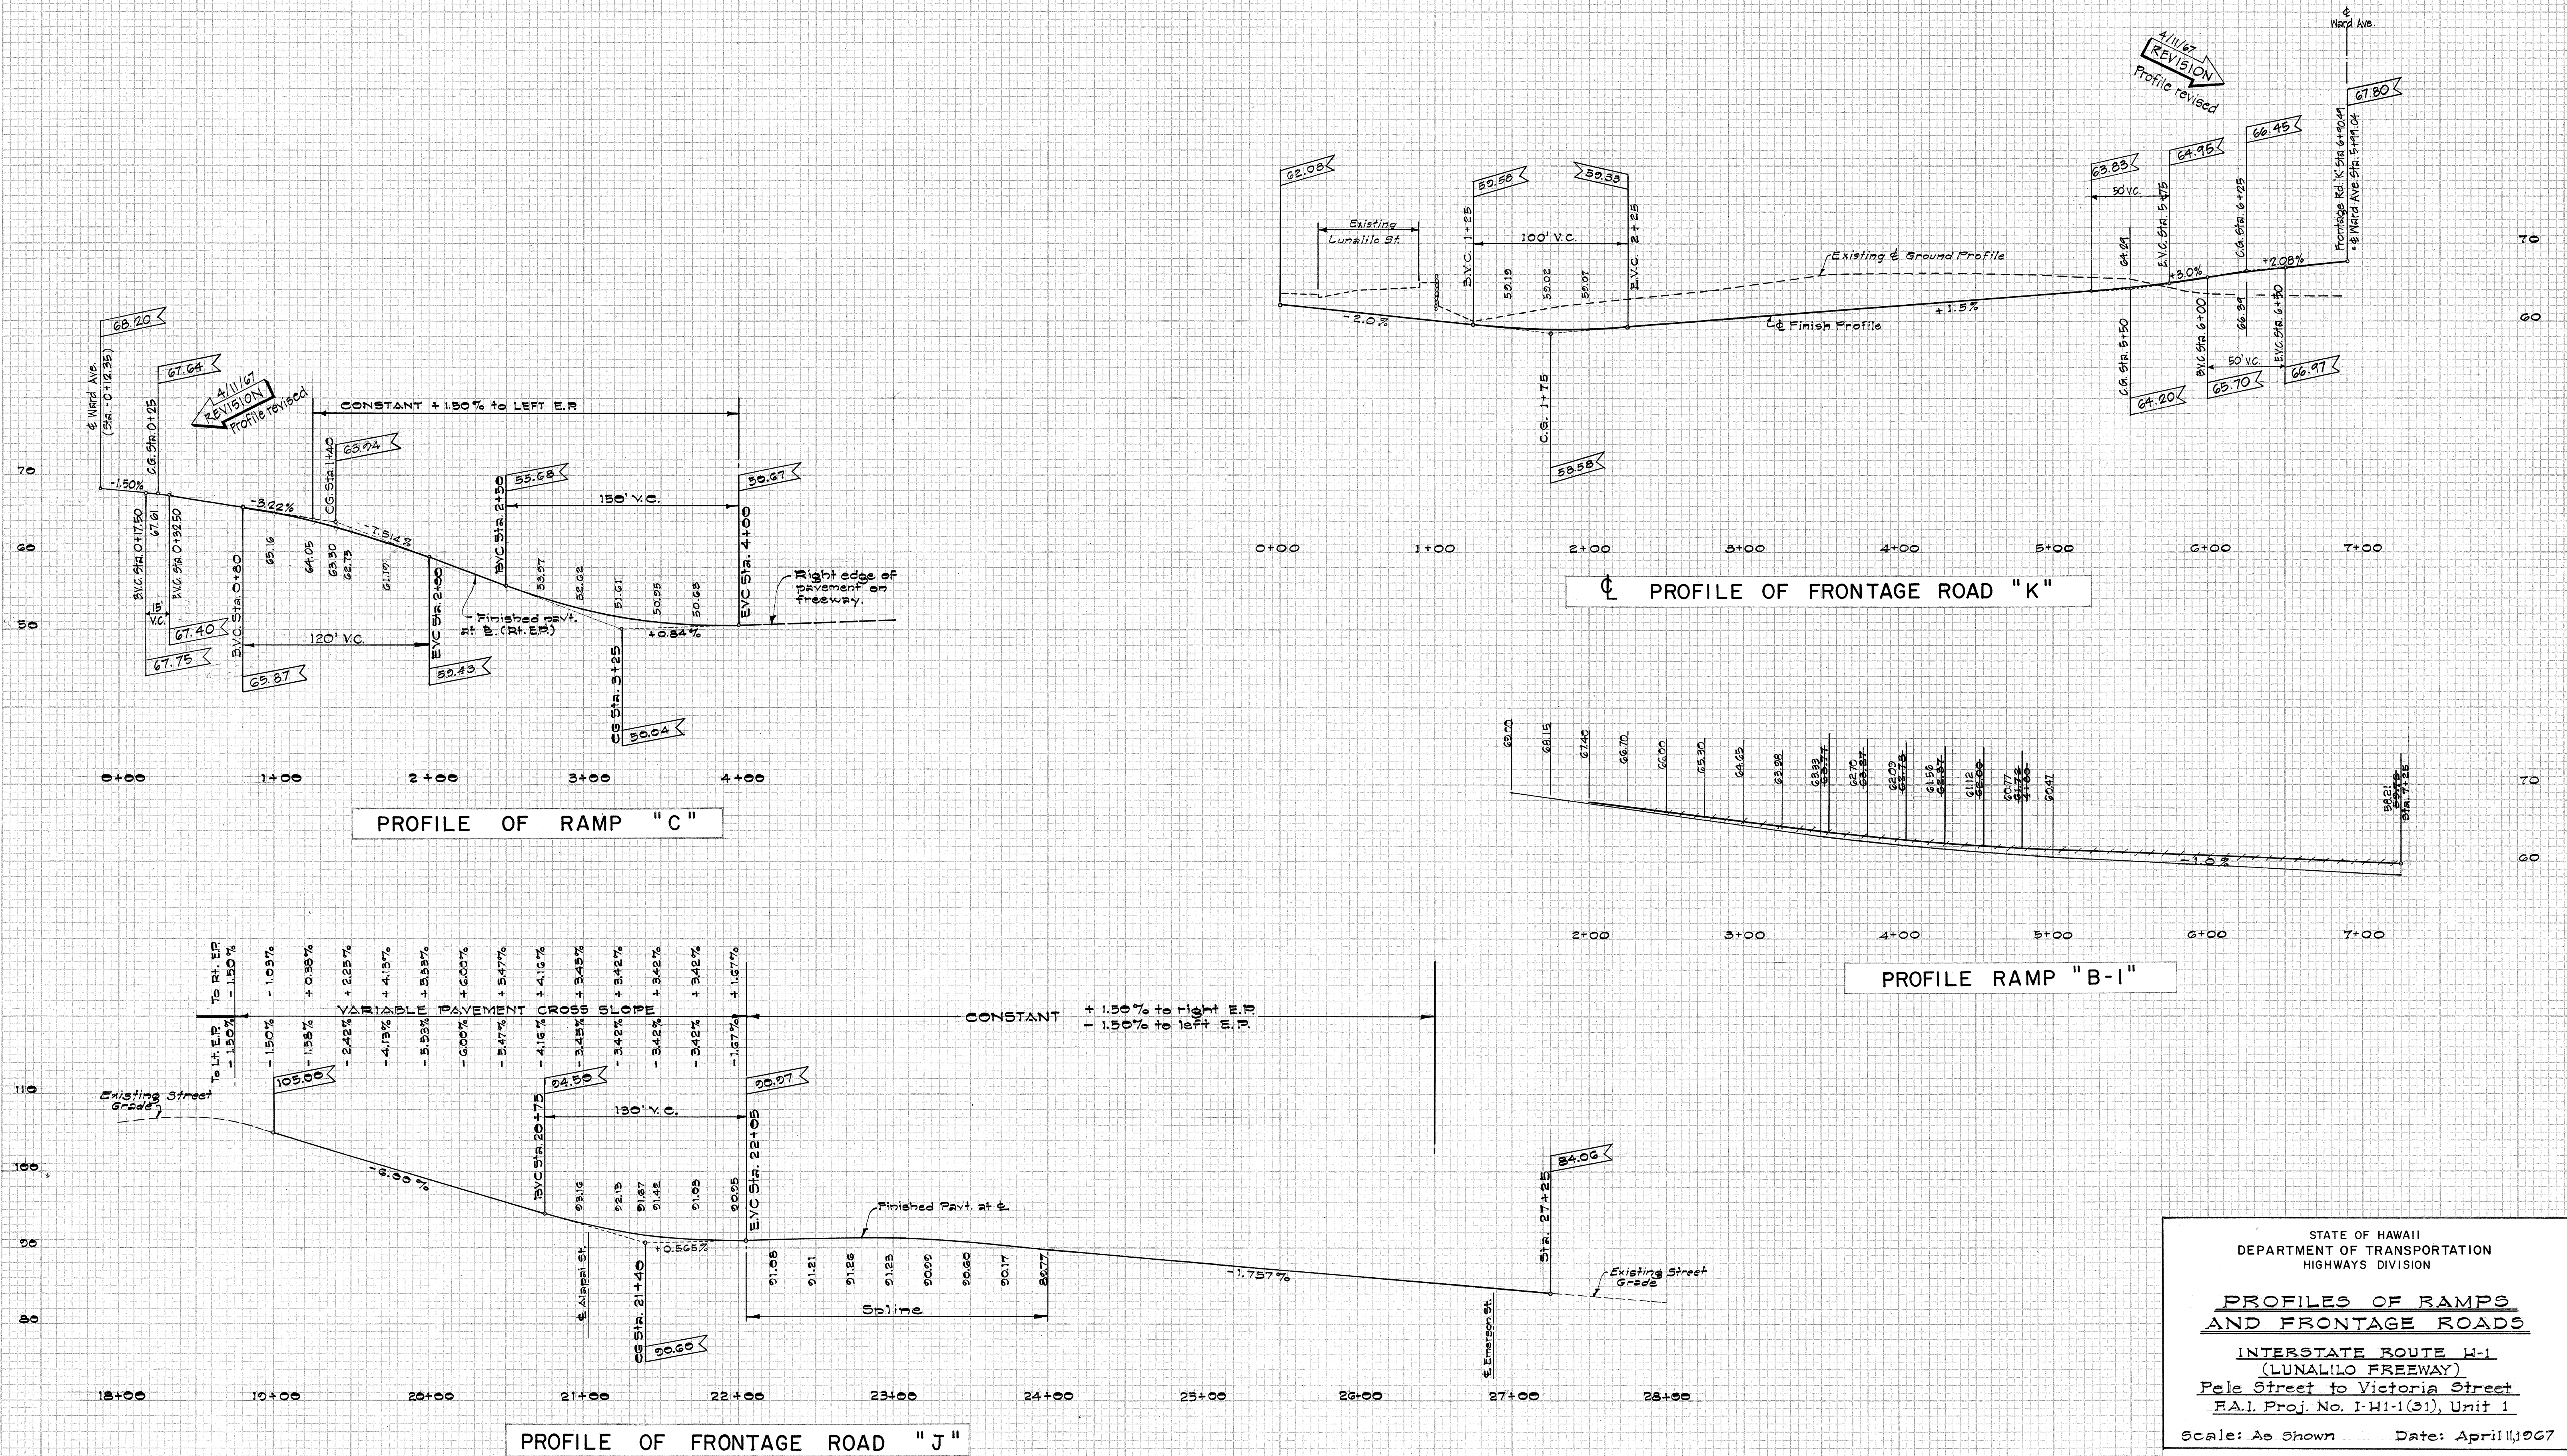

K+E PLATE 3, CROSS SECTION
KEINFEL & ESSER CO.

AB 7000 IMPERIAL[®] TRACING GLOTH 7054

THIS SHEET SUPERCEDES SHEET 13

13A