FED. ROAD DIST. NO.	STATE	PROJ. NO.	FISCAL YEAR	SHEET NO.	TOTAL SHEETS
HAWAII	HAW.	9800A-01-81M	1981	1	14

INDEX TO DRAWINGS

SHEET NO.	DESCRIPTION
1	TITLE SHEET
2	TYPICAL SECTION
3	GENERAL NOTES
3 - 6	PLANS
7 - 10	PAVEMENT MARKING PLANS
11 - 14	STANDARD DETAILS

STATE OF HAWAII

DEPARTMENT OF TRANSPORTATION

HIGHWAYS DIVISION

HONOLULU, HAWAII

"AS BUILT"

PLANS FOR

VINEYARD BOULEVARD RESURFACING

AALA STREET EASTERLY TO H-1 RAMPS

AND

PALAMA STREET TO H-1 WESTBOUND RAMP

PROJECT NO. 9800A-01-81M

DISTRICT OF HONOLULU

ISLAND OF OAHU

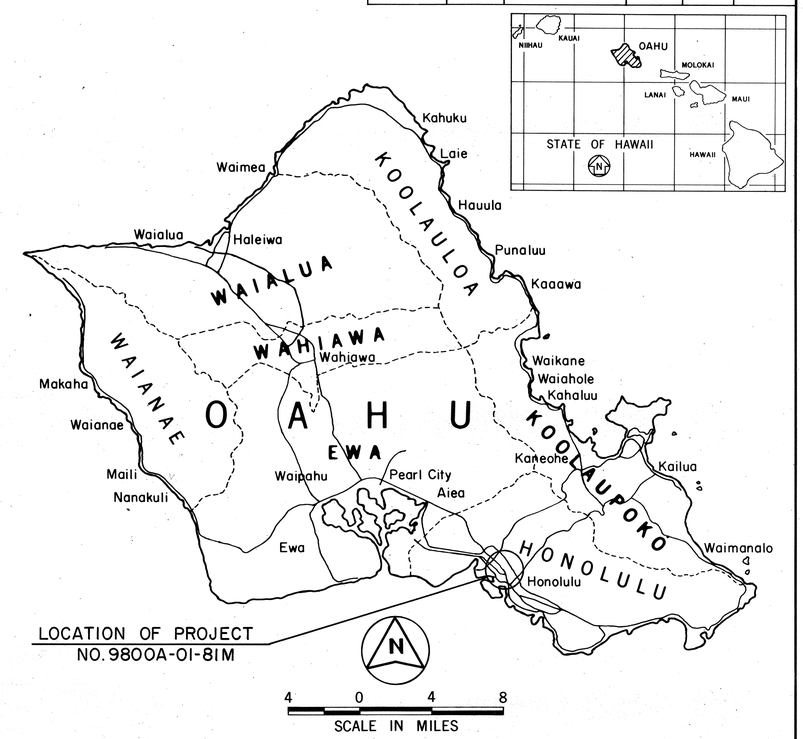

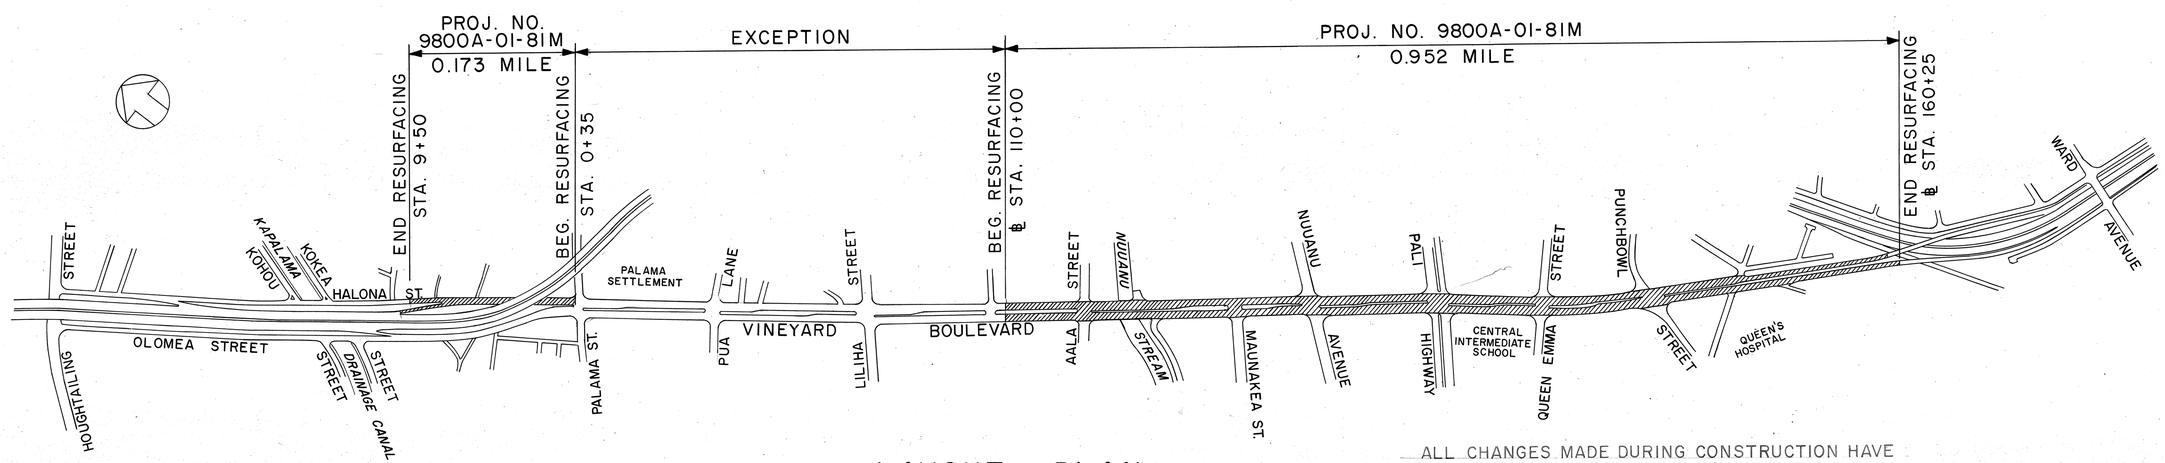

LAYOUT PLAN

4 0 4 8
SCALE IN HUNDRED FEET

ALL CHANGES MADE DURING CONSTRUCTION HAVE BEEN INCORPORATED ON THESE PLANS IN RED EXCEPT CHANGES IN THE ORIGINAL THEORETICAL QUANTITIES. FOR ACTUAL QUANTITIES, REFER TO PROJECT LEDGER AND/OR COMPUTATION BOOK.

Michael Dimiza for RESIDENT ENGINEER — 4/5/82 DATE

DEPARTMENT OF TRANSPORTATION
STATE OF HAWAII

APPROVED:

Ryokichi Higashionna — 4/30/81
DIR. OF TRANSPORTATION — DATE

UNIT "A" — DESIGNED BY
R. Mikami — P. S. & E. BY
548-7534 — PHONE
APRIL 30, 1981 — DATE