FED. ROAD DIST. NO.	STATE	FED. AID PROJ. NO.	FISCAL YEAR	SHEET NO.	TOTAL SHEETS
HAWAII	HAW.	STP-098-1(10) NH-098-1(9)	1993	ADD. 1	35

INDEX TO DRAWINGS	
SHEET NO.	DESCRIPTION
1 – 23	F.A. PROJECT NO. STP-098-1(10)
24 – 35	F.A. PROJECT NO. NH-098-1(9)

STATE OF HAWAII

DEPARTMENT OF TRANSPORTATION

HIGHWAYS DIVISION

HONOLULU, HAWAII

"AS-BUILT"

PLANS FOR

VINEYARD BOULEVARD RESURFACING

H-1 OFF-RAMP TO H-1 ON-RAMP

F.A. PROJECT NO. STP-098-1(10)

AND

HIGHWAY LIGHTING IMPROVEMENTS AND REHABILITATION

VINEYARD BOULEVARD: PALAMA STREET TO PUNCHBOWL STREET

F.A. PROJECT NO. NH-098-1(9)

DISTRICT OF HONOLULU

ISLAND OF OAHU

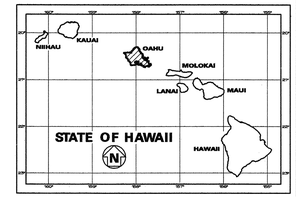

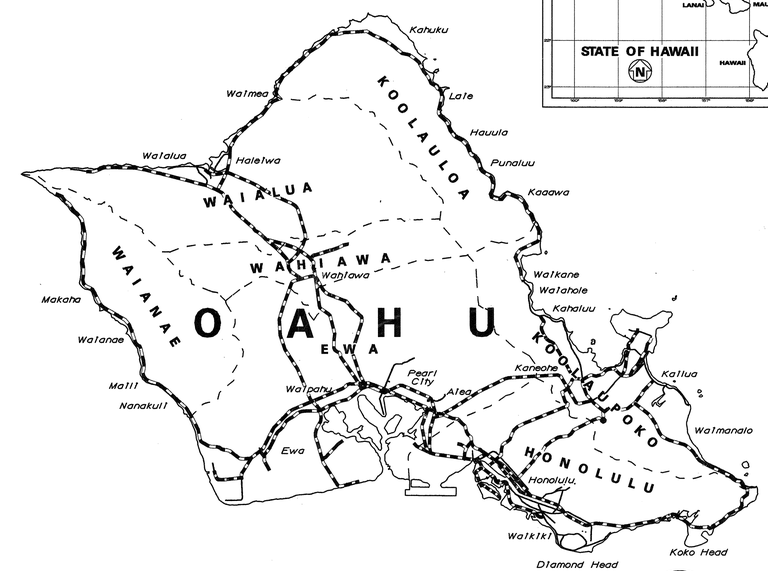

N

4 0 4 8

SCALE IN MILES

FEDERAL AID PROJECTS PREVIOUSLY CONSTRUCTED OR UNDER CONSTRUCTION

DESIGN UNIT E	R. TAKAESU	587-2249	MAY 1993
DESIGNED BY	P. S. & E. BY	PHONE	DATE

CHANGES MADE DURING CONSTRUCTION HAVE BEEN INCORPORATED ON THESE PLANS EXCEPT CHANGES IN THE ORIGINAL THEORETICAL QUANTITIES. FOR ACTUAL QUANTITIES, REFER TO PROJECT LEDGER AND/OR COMPUTATION BOOK.

Gary Lee
RESIDENT ENGINEER

6/17/99
DATE

DATE	REVISION
6/7/93	Revised Sub-title

ADD. 1

1vbldtsh1.dgn dd4/jason

login: jason 1vbldtsh1.dgn 6-7-93