FED. ROAD DIST. NO.	STATE	FED. AID PROJ. NO.	FISCAL YEAR	SHEET NO.	TOTAL SHEETS
HAWAII	HAW.	STP-098-1(10)	1993	2	35

98

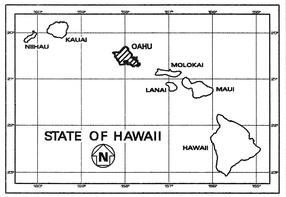

INDEX TO DRAWINGS	
SHEET NO.	DESCRIPTION
2	TITLE SHEET
3	STANDARD PLANS SUMMARY
4	GENERAL NOTES AND LEGEND
5 – 6	TYPICAL SECTIONS
7	MISCELLANEOUS DETAILS
8 – 13	ROADWAY PLANS
14 – 23	PAVEMENT MARKINGS, SIGNING, LEGEND, DETAILS & NOTES

STATE OF HAWAII

DEPARTMENT OF TRANSPORTATION

HIGHWAYS DIVISION

HONOLULU, HAWAII

"AS-BUILT"

PLANS FOR

VINEYARD BOULEVARD RESURFACING

H-1 OFF-RAMP TO H-1 ON-RAMP

FEDERAL AID PROJECT NO. STP-098-1(10)

DISTRICT OF HONOLULU

ISLAND OF OAHU

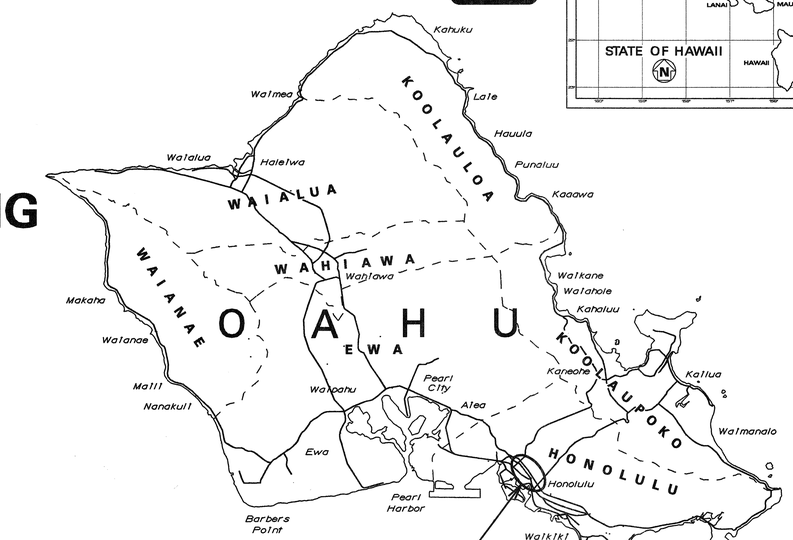

CHANGES MADE DURING CONSTRUCTION HAVE BEEN INCORPORATED ON THESE PLANS EXCEPT CHANGES IN THE ORIGINAL THEORETICAL QUANTITIES. FOR ACTUAL QUANTITIES, REFER TO PROJECT LEDGER AND/OR COMPUTATION BOOK.

RESIDENT ENGINEER DATE

PROJECT LIMITS
FED. AID PROJ. NO. STP-098-1(10)

BEGIN PROJECT M.P. 0.00

END PROJECT M.P. 1.76

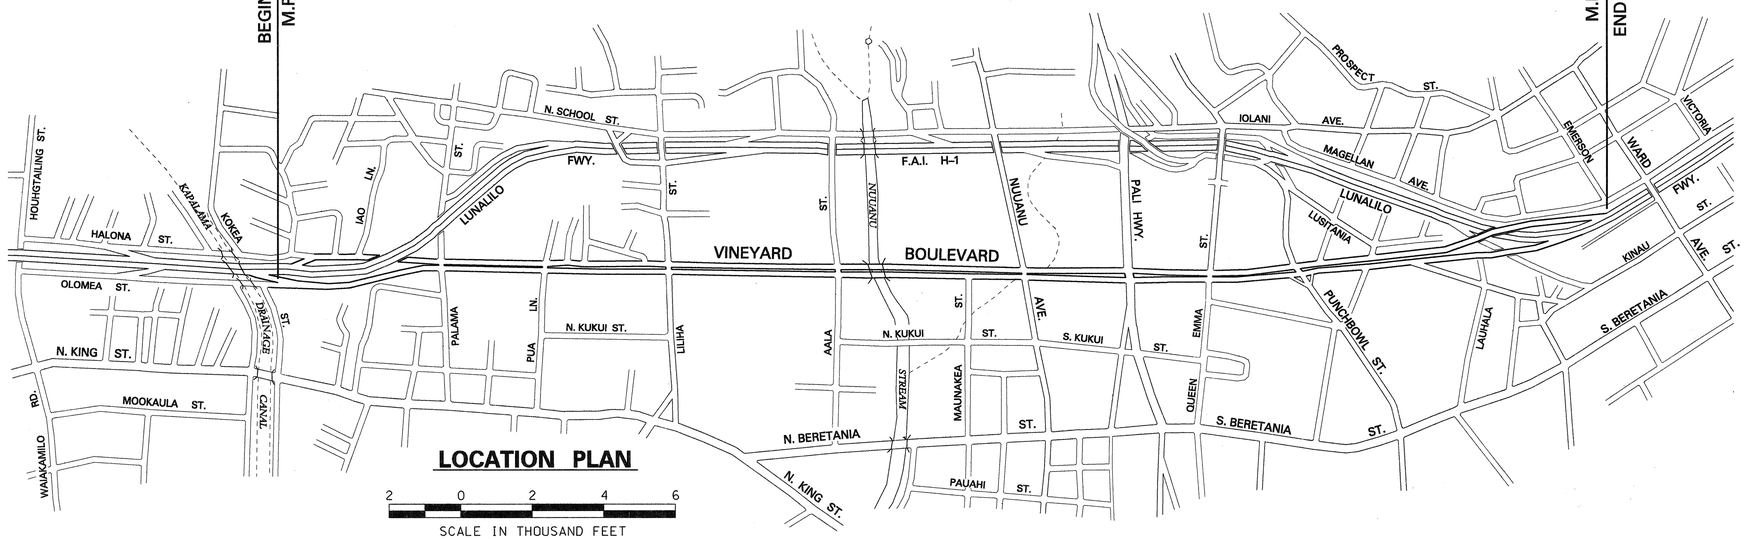

LOCATION PLAN

2 0 2 4 6
SCALE IN THOUSAND FEET

4 0 4 8
SCALE IN MILES

MILE POST 0.00 TO MILE POST 1.76

DESIGN DESIGNATION

CURENT ADT(1992)	41,500
DESIGN ADT(2002)	56,600
DHV	5,350
D	55/45
T_{24}	3.5
V	45 mph

DEPARTMENT OF TRANSPORTATION FEDERAL HIGHWAY ADMINISTRATION	
APPROVED:	
for DIVISION ADMINISTRATOR	5/25/93 DATE

DEPARTMENT OF TRANSPORTATION STATE OF HAWAII	
APPROVED:	
for DIR. OF TRANSPORTATION	5/14/93 DATE

UNIT "E"	R. TAKAESU	587-2249	OCT., 1992
DESIGNED BY	P. S. & E. BY	PHONE	DATE

lvbldtsht.dgn/jason/dd4