



FED. ROAD DIST. NO.	STATE	PROJ. NO.	FISCAL YEAR	SHEET NO.	TOTAL SHEETS
HAWAII	HAW.	98A-01-70	1970	6	19

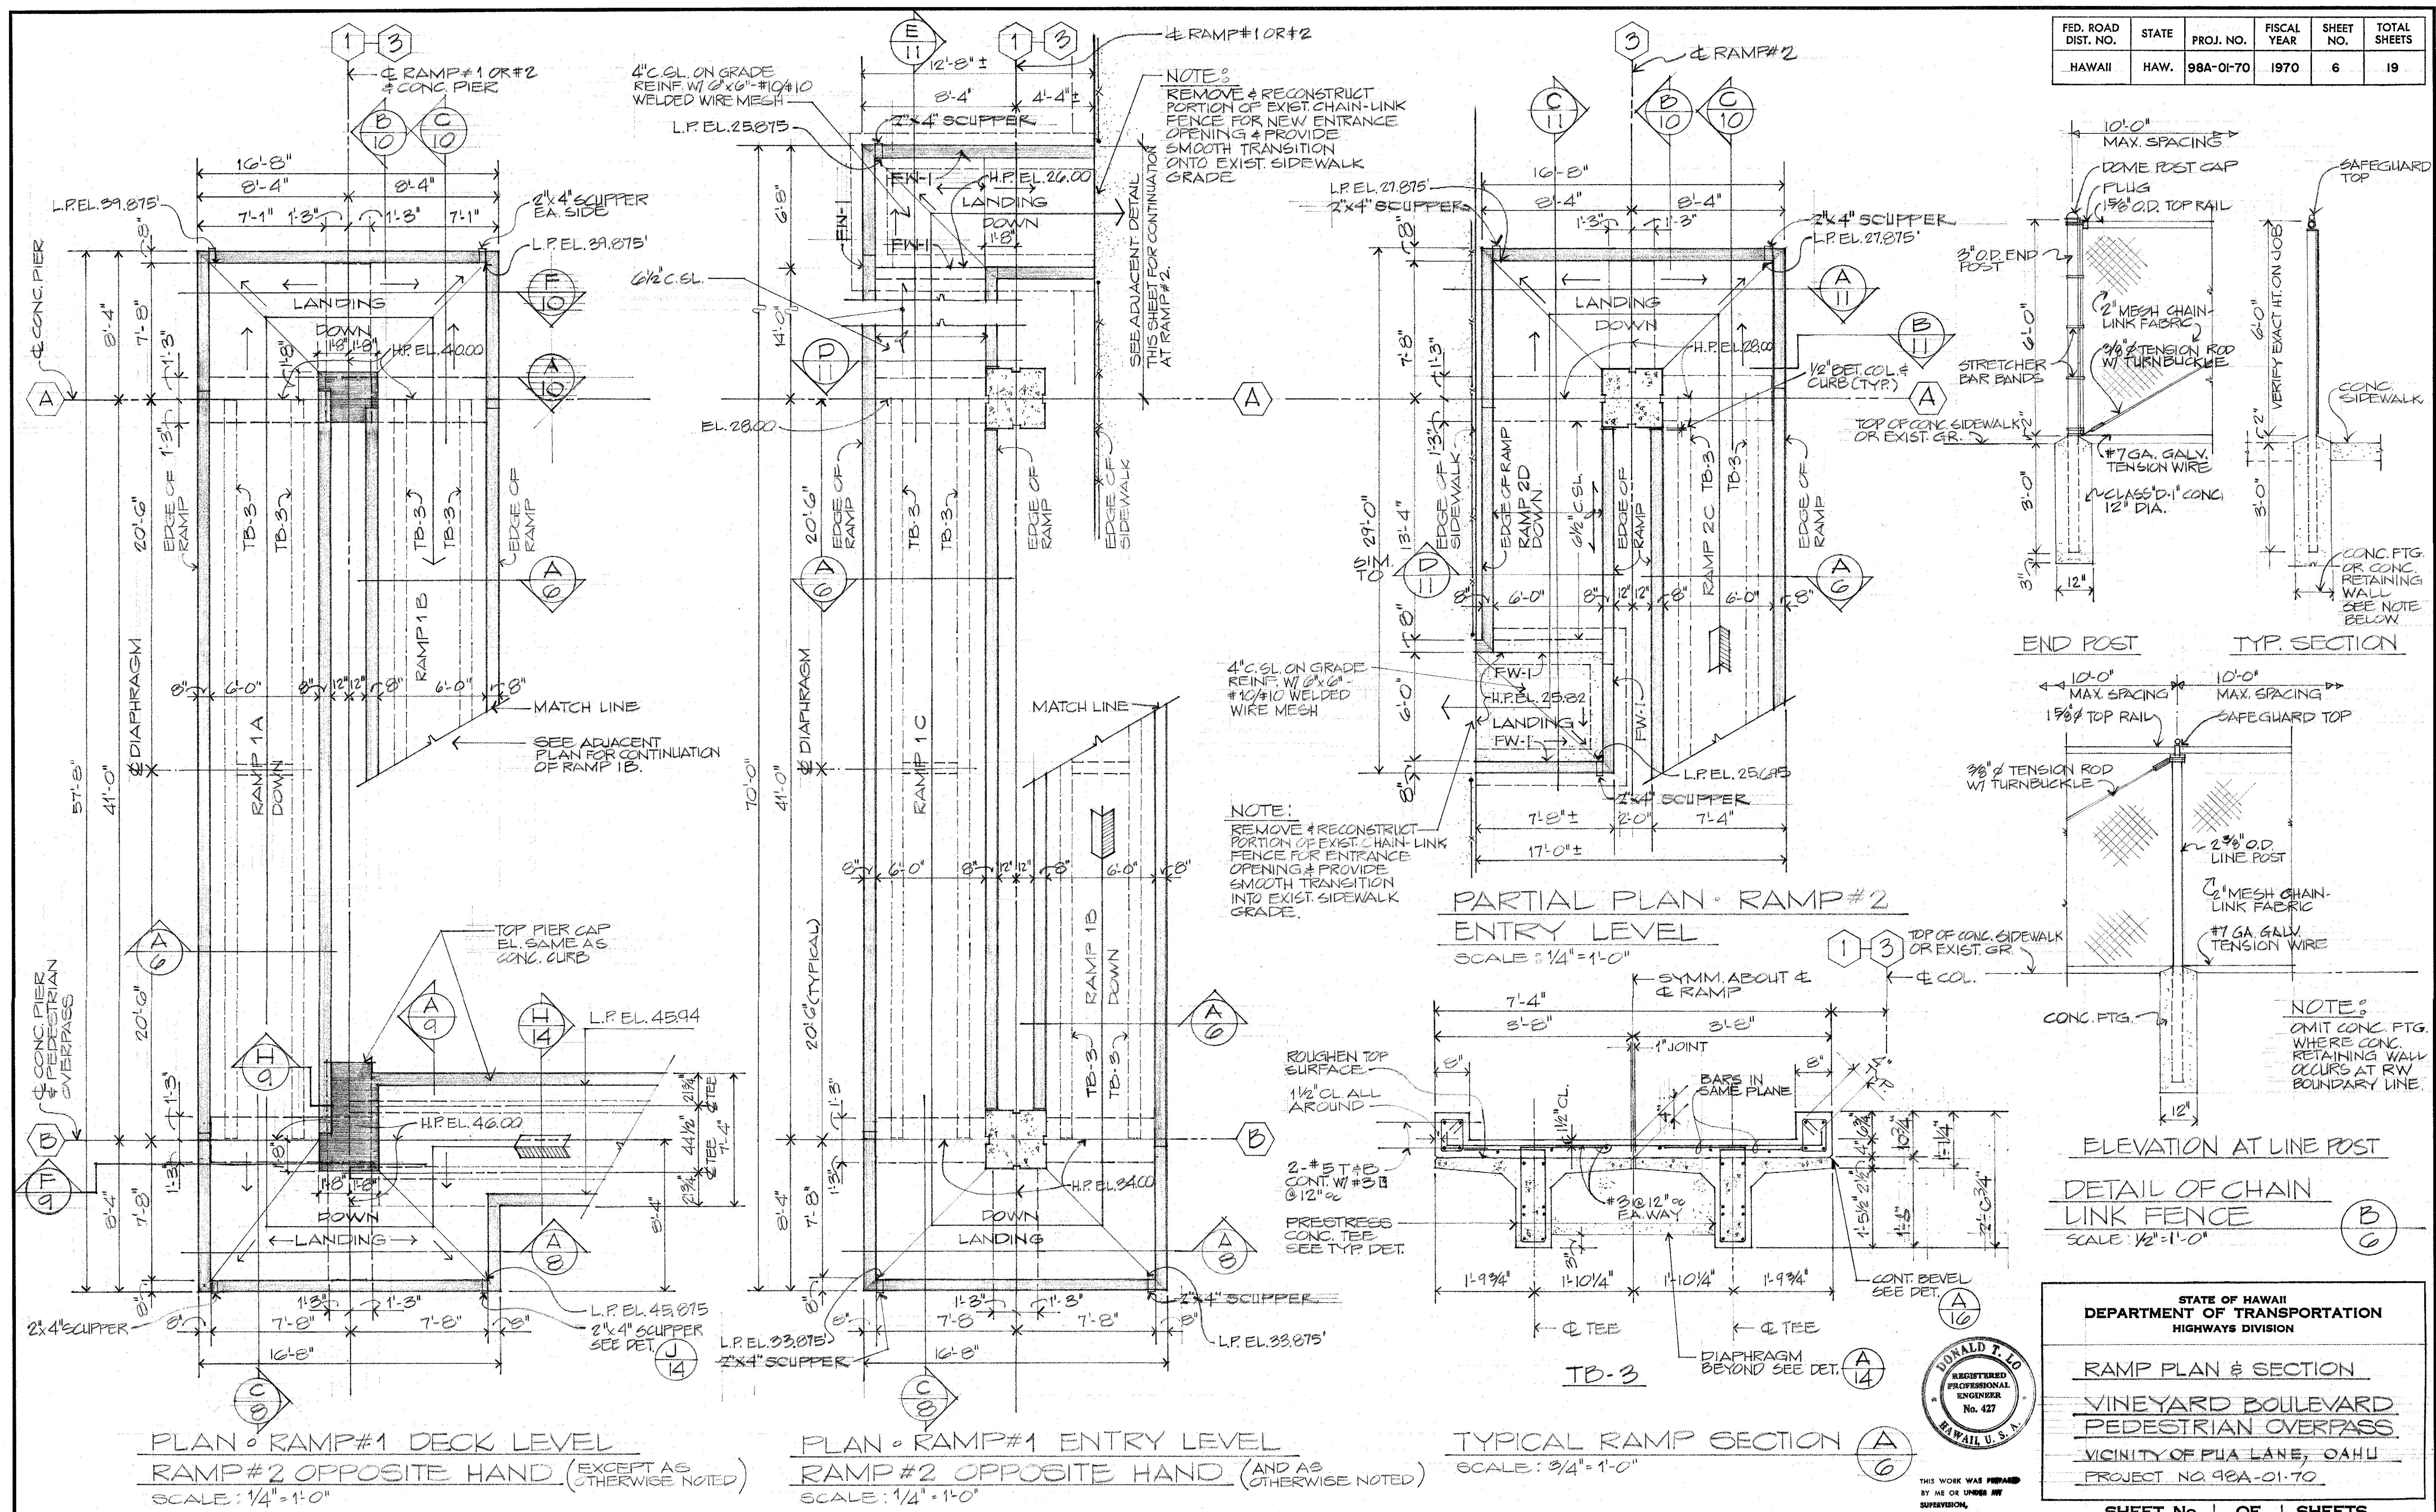

DATE	
ORIGINAL PLAN	
TRACED BY	
NOTED BY	
CHECKED BY	
NO.	

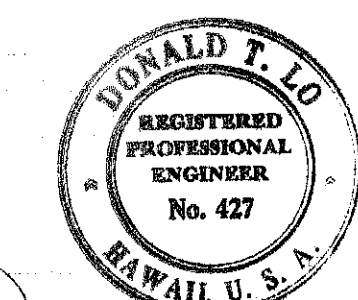

STATE OF HAWAII
DEPARTMENT OF TRANSPORTATION
HIGHWAYS DIVISION

RAMP PLAN & SECTION
VINEYARD BOULEVARD
PEDESTRIAN OVERPASS
VICINITY OF PUA LANE, OAHU
PROJECT NO. 98A-01-70

SHEET No. 1 OF 1 SHEETS