



DATE	_____
SURVEY PLOTTED BY	_____
DESIGNED BY	_____
DRAWN BY	_____
NOTED BY	_____
CHECKED BY	_____
ORIGINAL PLAN	_____
NOTE BOOK	_____
QUANTITIES CHECKED BY	_____
NO.	_____

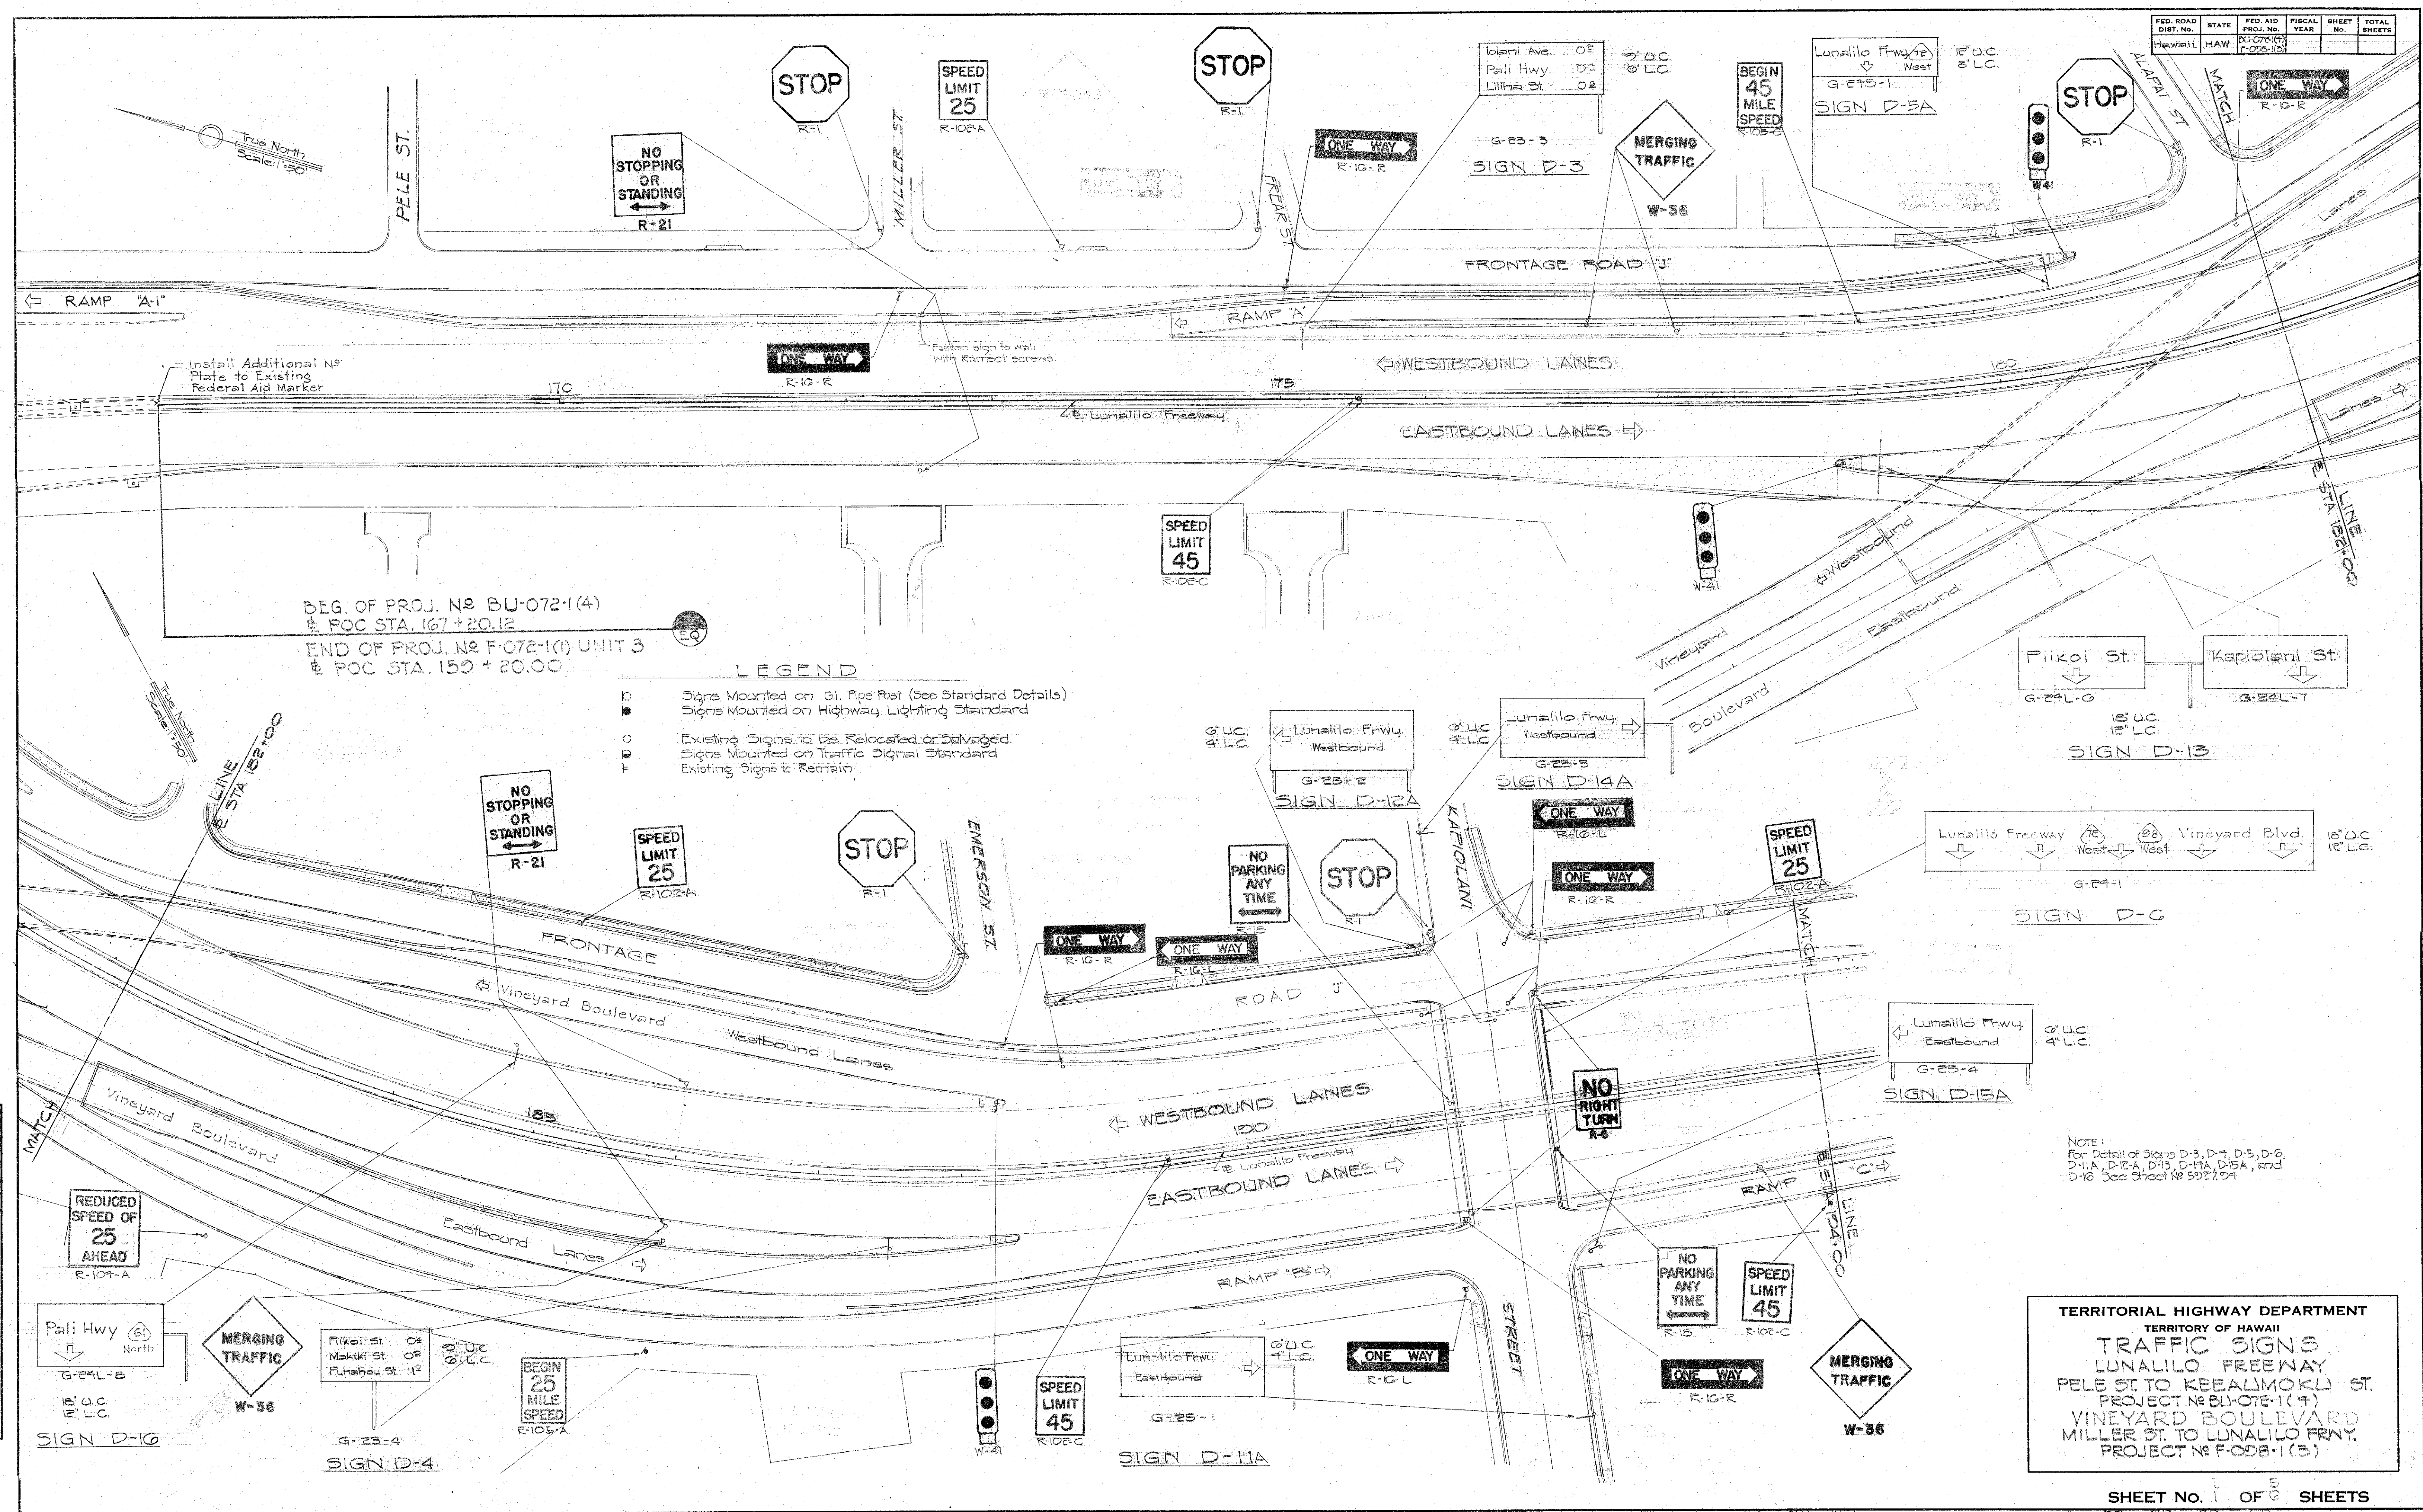

5927.04 5928.04

DATE	
SURVEY PLOTTED BY	
PLAN	
TRACED BY	
QUANTITIES CHECKED BY	
NOTE BOOK	
NO.	

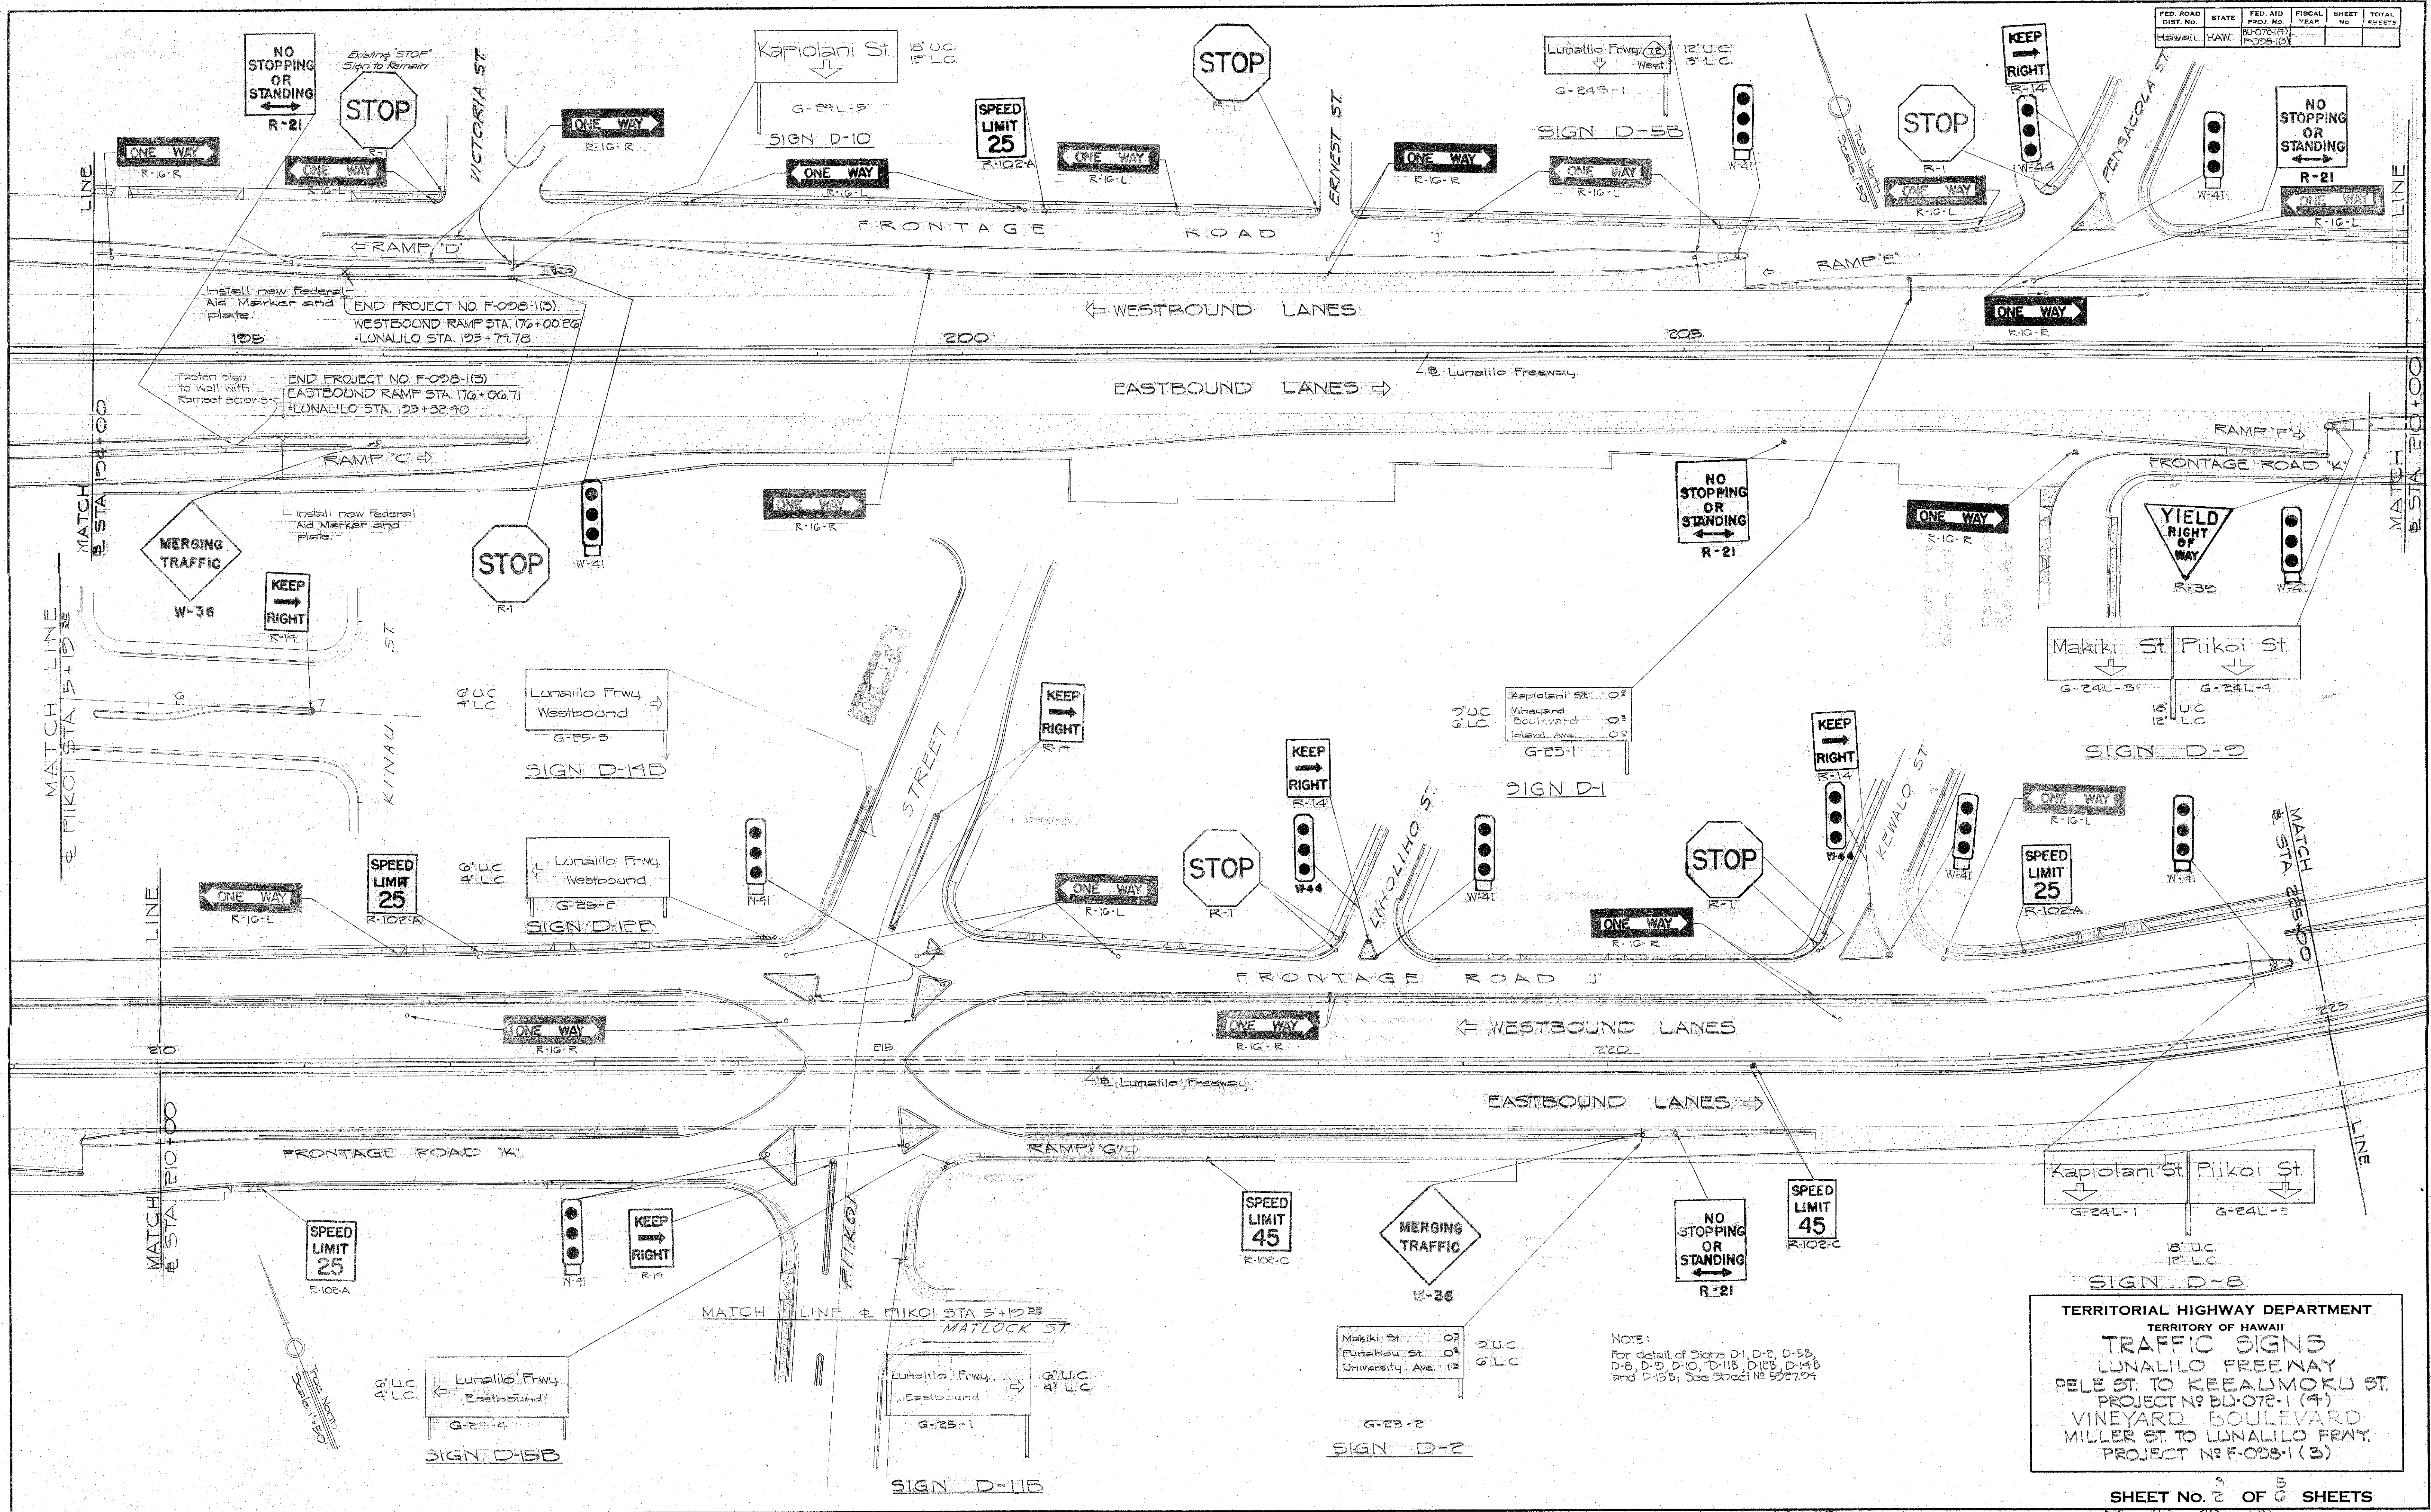

TERRITORIAL HIGHWAY DEPARTMENT
TERRITORY OF HAWAII
TRAFFIC SIGNS
PELE ST. TO KEEALIMOKU ST.
VINEYARD BOULEVARD
