FED. ROAD DIV. NO.	STATE	PROJ. NO.	FISCAL YEAR	SHEET NO.	TOTAL SHEETS
HAWAII	HAW.	WPGH 7I	1935	1	23

INDEX TO DRAWINGS	
SHEET NO.	DESCRIPTIONS
1	Title Sheet
Sec.7G 2	Typical Section
3	Plan and Profile
4 - 6	Standard Details (1.2.3)
7 - 8	Culvert Details
9 - 16	R. R. Overpass Details
17 - 23	Cross Sections

TERRITORY OF HAWAII
TERRITORIAL HIGHWAY DEPARTMENT
HONOLULU T. H.

PLANS OF

KAMEHAMEHA HIGHWAY

WAIKAKALALIA UNDERPASS

U.S. WORKS PROGRAM GRADE CROSSING PROJECT NO. WPGH 7I

EWA DISTRICT Fed Aid Proj No 71 (2) Underpass

OAHU. T.H.

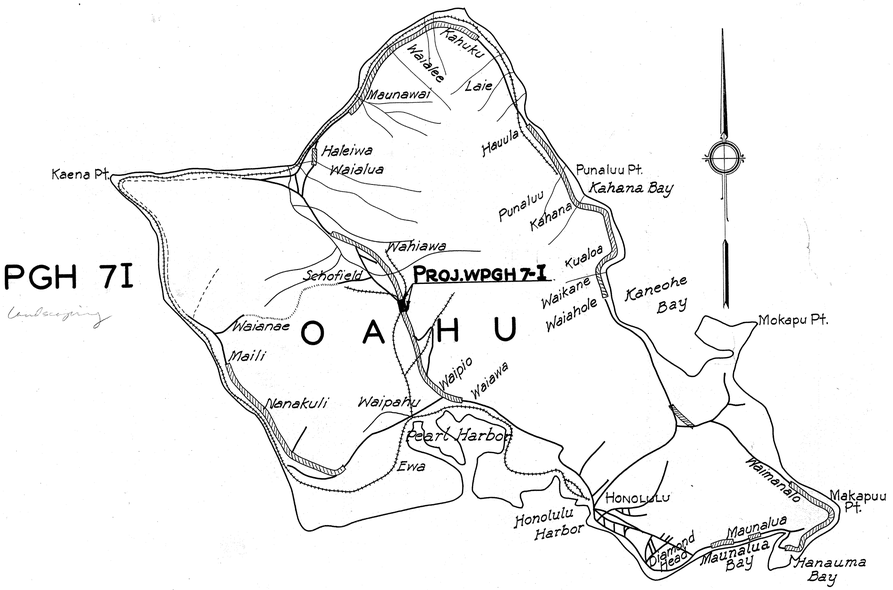

CONVENTIONAL SIGNS

PRESENT ROAD
EXISTING FENCE
EXISTING STONE FENCE
RAILROAD
CENTER LINE
BRIDGES
CULVERTS

SCALE

PLAN		1 INCH	100 FEET
PROFILE	HOR.	1 INCH	100 FEET
	VER.	1 INCH	20 FEET
CROSS SECTION		1 INCH	10 FEET

Previously Constructed Federal Aid Projects.

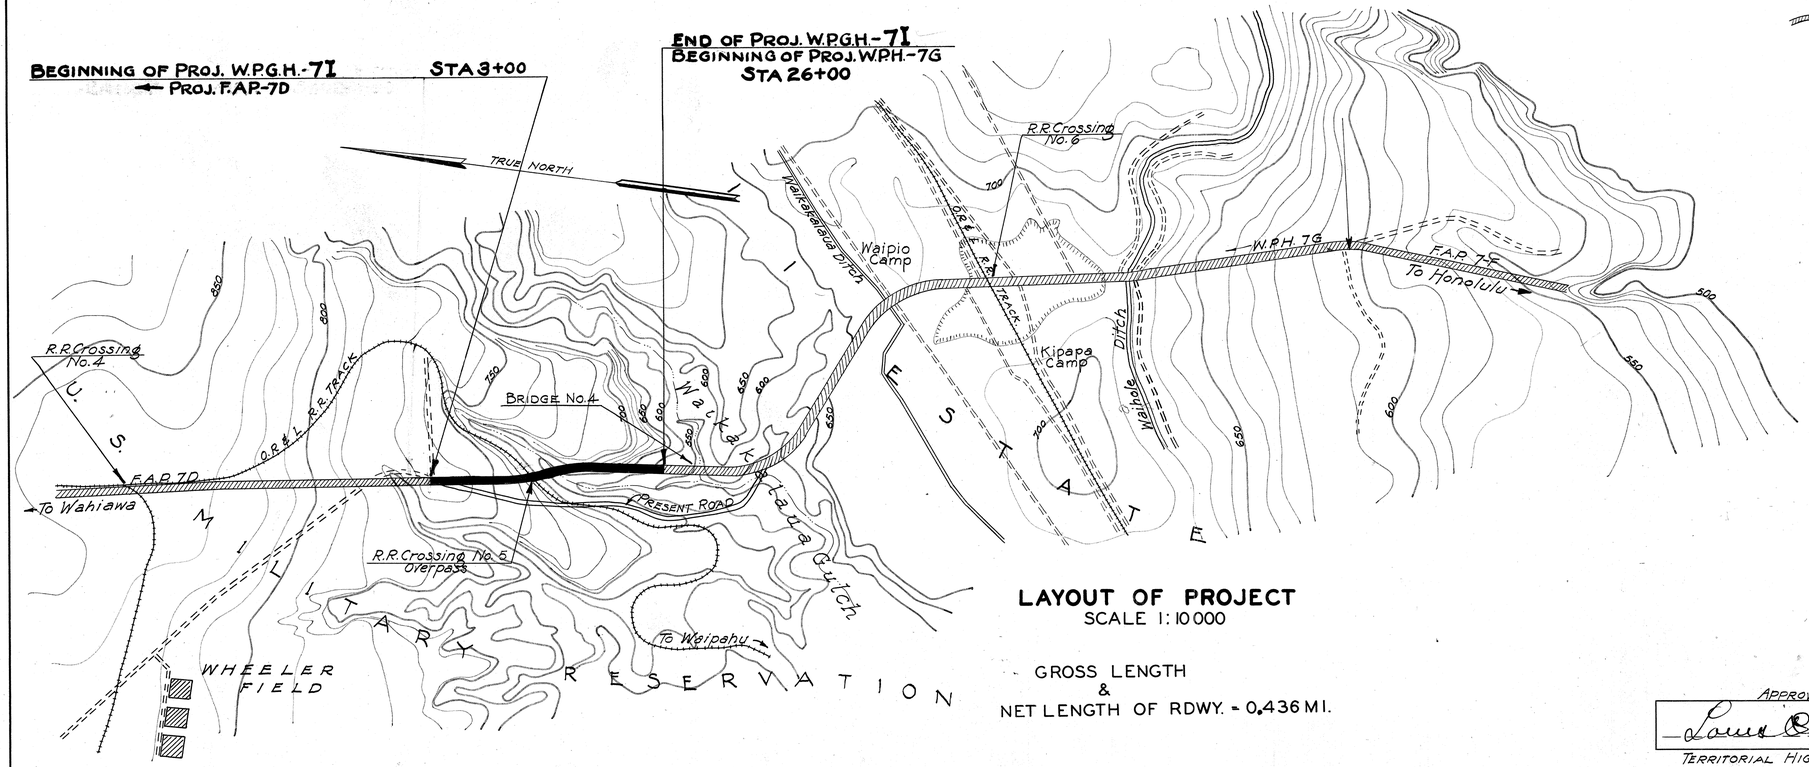

LAYOUT OF PROJECT
SCALE 1:10000

GROSS LENGTH
&
NET LENGTH OF RDWY. = 0.436 MI.

ORIGINAL PLANS	
SURVEY PLOTTED BY	DATE
DESIGNED BY	"
DRAWN BY	"
CALCULATED BY K.A.	9-7-935
NOTE BOOK	"
QUANTITIES BY	"
No.	CHECKED BY "

RECOMENDED FOR APPROVAL

PRINCIPAL HIGHWAY ENGINEER
Bureau of Public Roads

RECOMENDED FOR APPROVAL

CHIEF ENGINEER, Bureau of Public Roads

APPROVED

Louis R. Cain

TERRITORIAL HIGHWAY ENGINEER

APPROVED

CHIEF, Bureau of Public Roads

DD-N

4343.1