FED. ROAD DIST. NO.	STATE	FED. AID PROJ. NO.	FISCAL YEAR	SHEET NO.	TOTAL SHEETS
HAW.	HAW.	N.R.H. 9-C	1935	1	72

INDEX TO DRAWINGS

SHEET NO.	DESCRIPTION
1	Title Sheet.
2	Typical Road Sections.
3 - 8	Plan & Profile.
9 - 11	Standard Detail Sheets.
12 - 15	Syphon, Culvert & Intersection Details - Borrow Pit.
16 - 41	Bridge Details.
42 - 72	Cross Sections.

TERRITORY OF HAWAII

TERRITORIAL HIGHWAY DEPARTMENT

HONOLULU T.H.

PLANS OF

KAMEHAMEHA HIGHWAY

U.S. PUBLIC WORKS PROJECT NO. N.R.H. 9-C (1935)

HAWAII F.A.P. NO. 9-C.

DISTRICT OF EWA
ISLAND OF OAHU

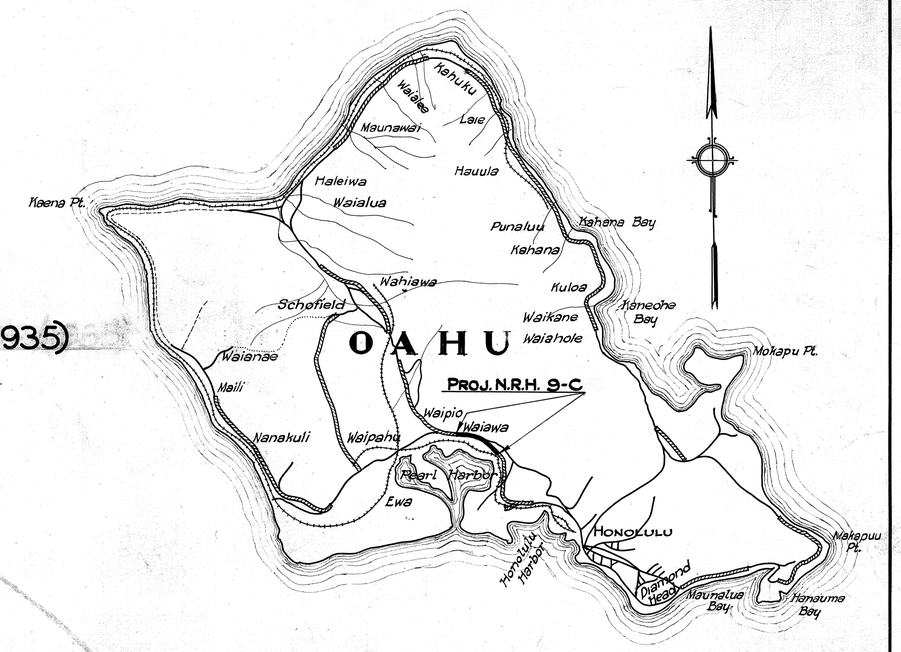

Federal Aid Projects previously constructed or under construction.

CONVENTIONAL SIGNS

- PRESENT ROAD
- EXISTING FENCE
- BOUNDARY LINE (NOT FENCED)
- EXISTING STONE FENCE
- RAILROAD
- CENTER LINE
- LARGE TREE
- CEMENT RUBBLE RETAINING WALLS
- BRIDGES
- CULVERTS

SCALE

PLAN	1 INCH	100 FEET
PROFILE	HOR. 1 INCH	100 FEET
	VER. 1 INCH	10 FEET
CROSS SECTION	1 INCH	5 FEET

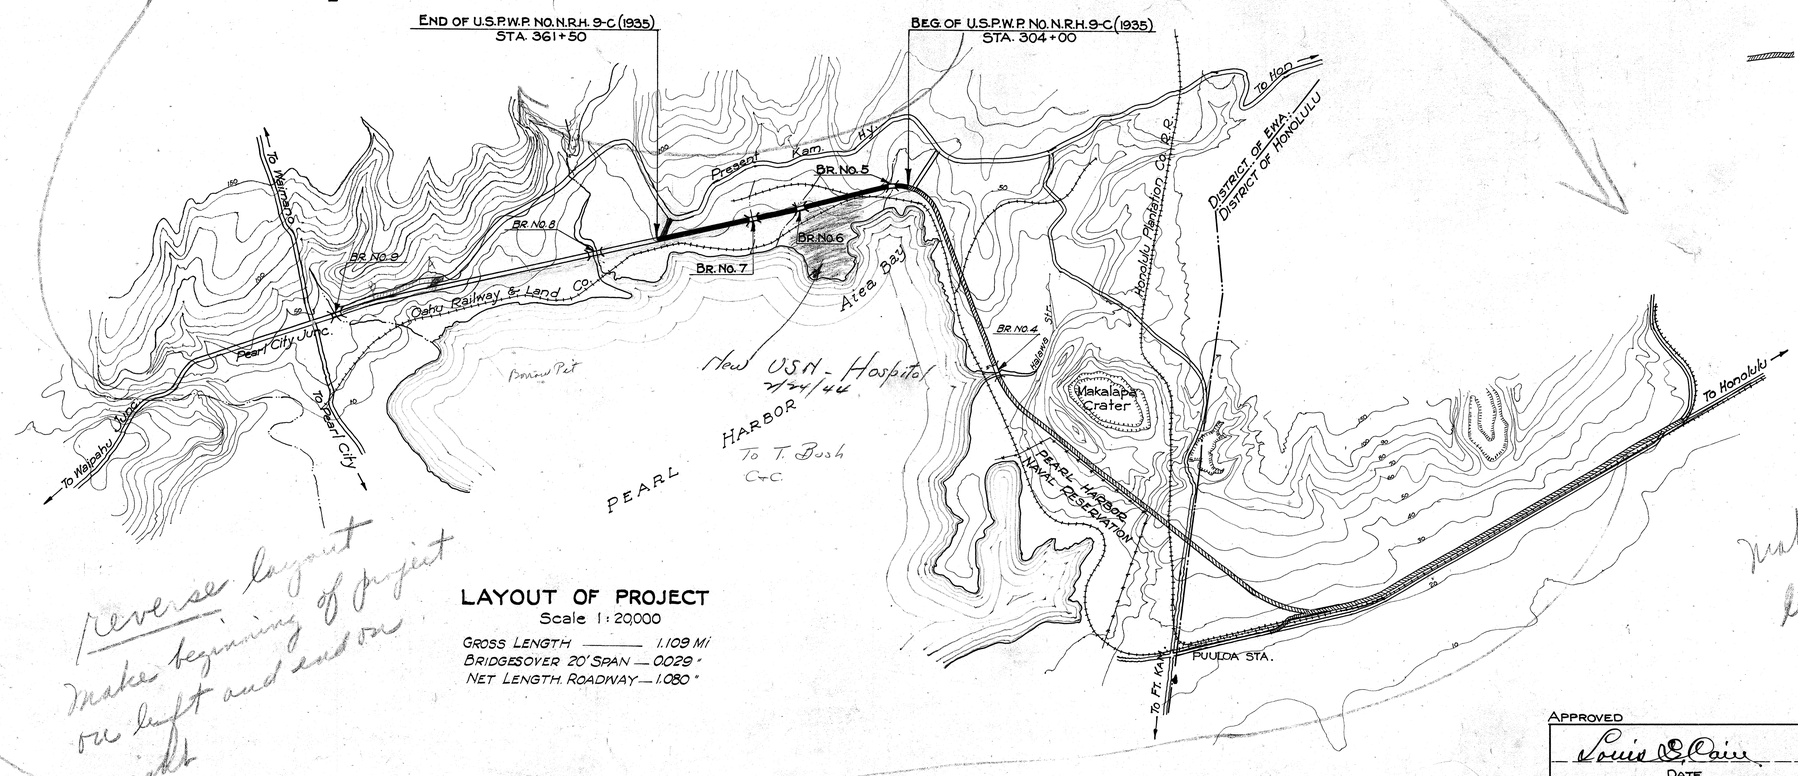

Reverse layout
Make beginning of project on left and end on right

Make black like this

LAYOUT OF PROJECT

Scale 1:20,000

GROSS LENGTH ——— 1.109 Mi
BRIDGES OVER 20' SPAN — 0.029 "
NET LENGTH. ROADWAY — 1.080 "

ORIGINAL PLAN		
SURVEY PLOTTED BY	N.H.M.	DATE 1933
DESIGNED BY	T.H.D.	1934
DRAWN BY	" "	1934
QUANTITIES BY	" "	1934
NOTE BOOK		
No.		
CHECKED BY		

RECOMMENDED FOR APPROVAL

Jack Mackowitz

PRINCIPAL HIGHWAY ENGINEER, Bu. of Pub. Rds.

RECOMMENDED FOR APPROVAL

[redacted]

CHIEF ENGINEER Bureau of Public Roads

APPROVED

Louis E. Cain

DATE

TERRITORIAL HIGHWAY ENGINEER

APPROVED

[redacted]

CHIEF, Bureau of Public Roads.

4325.1