


FINAL SURVEY
DATE
BY
NO.

ORIGINAL SURVEY
DATE
BY
NO.

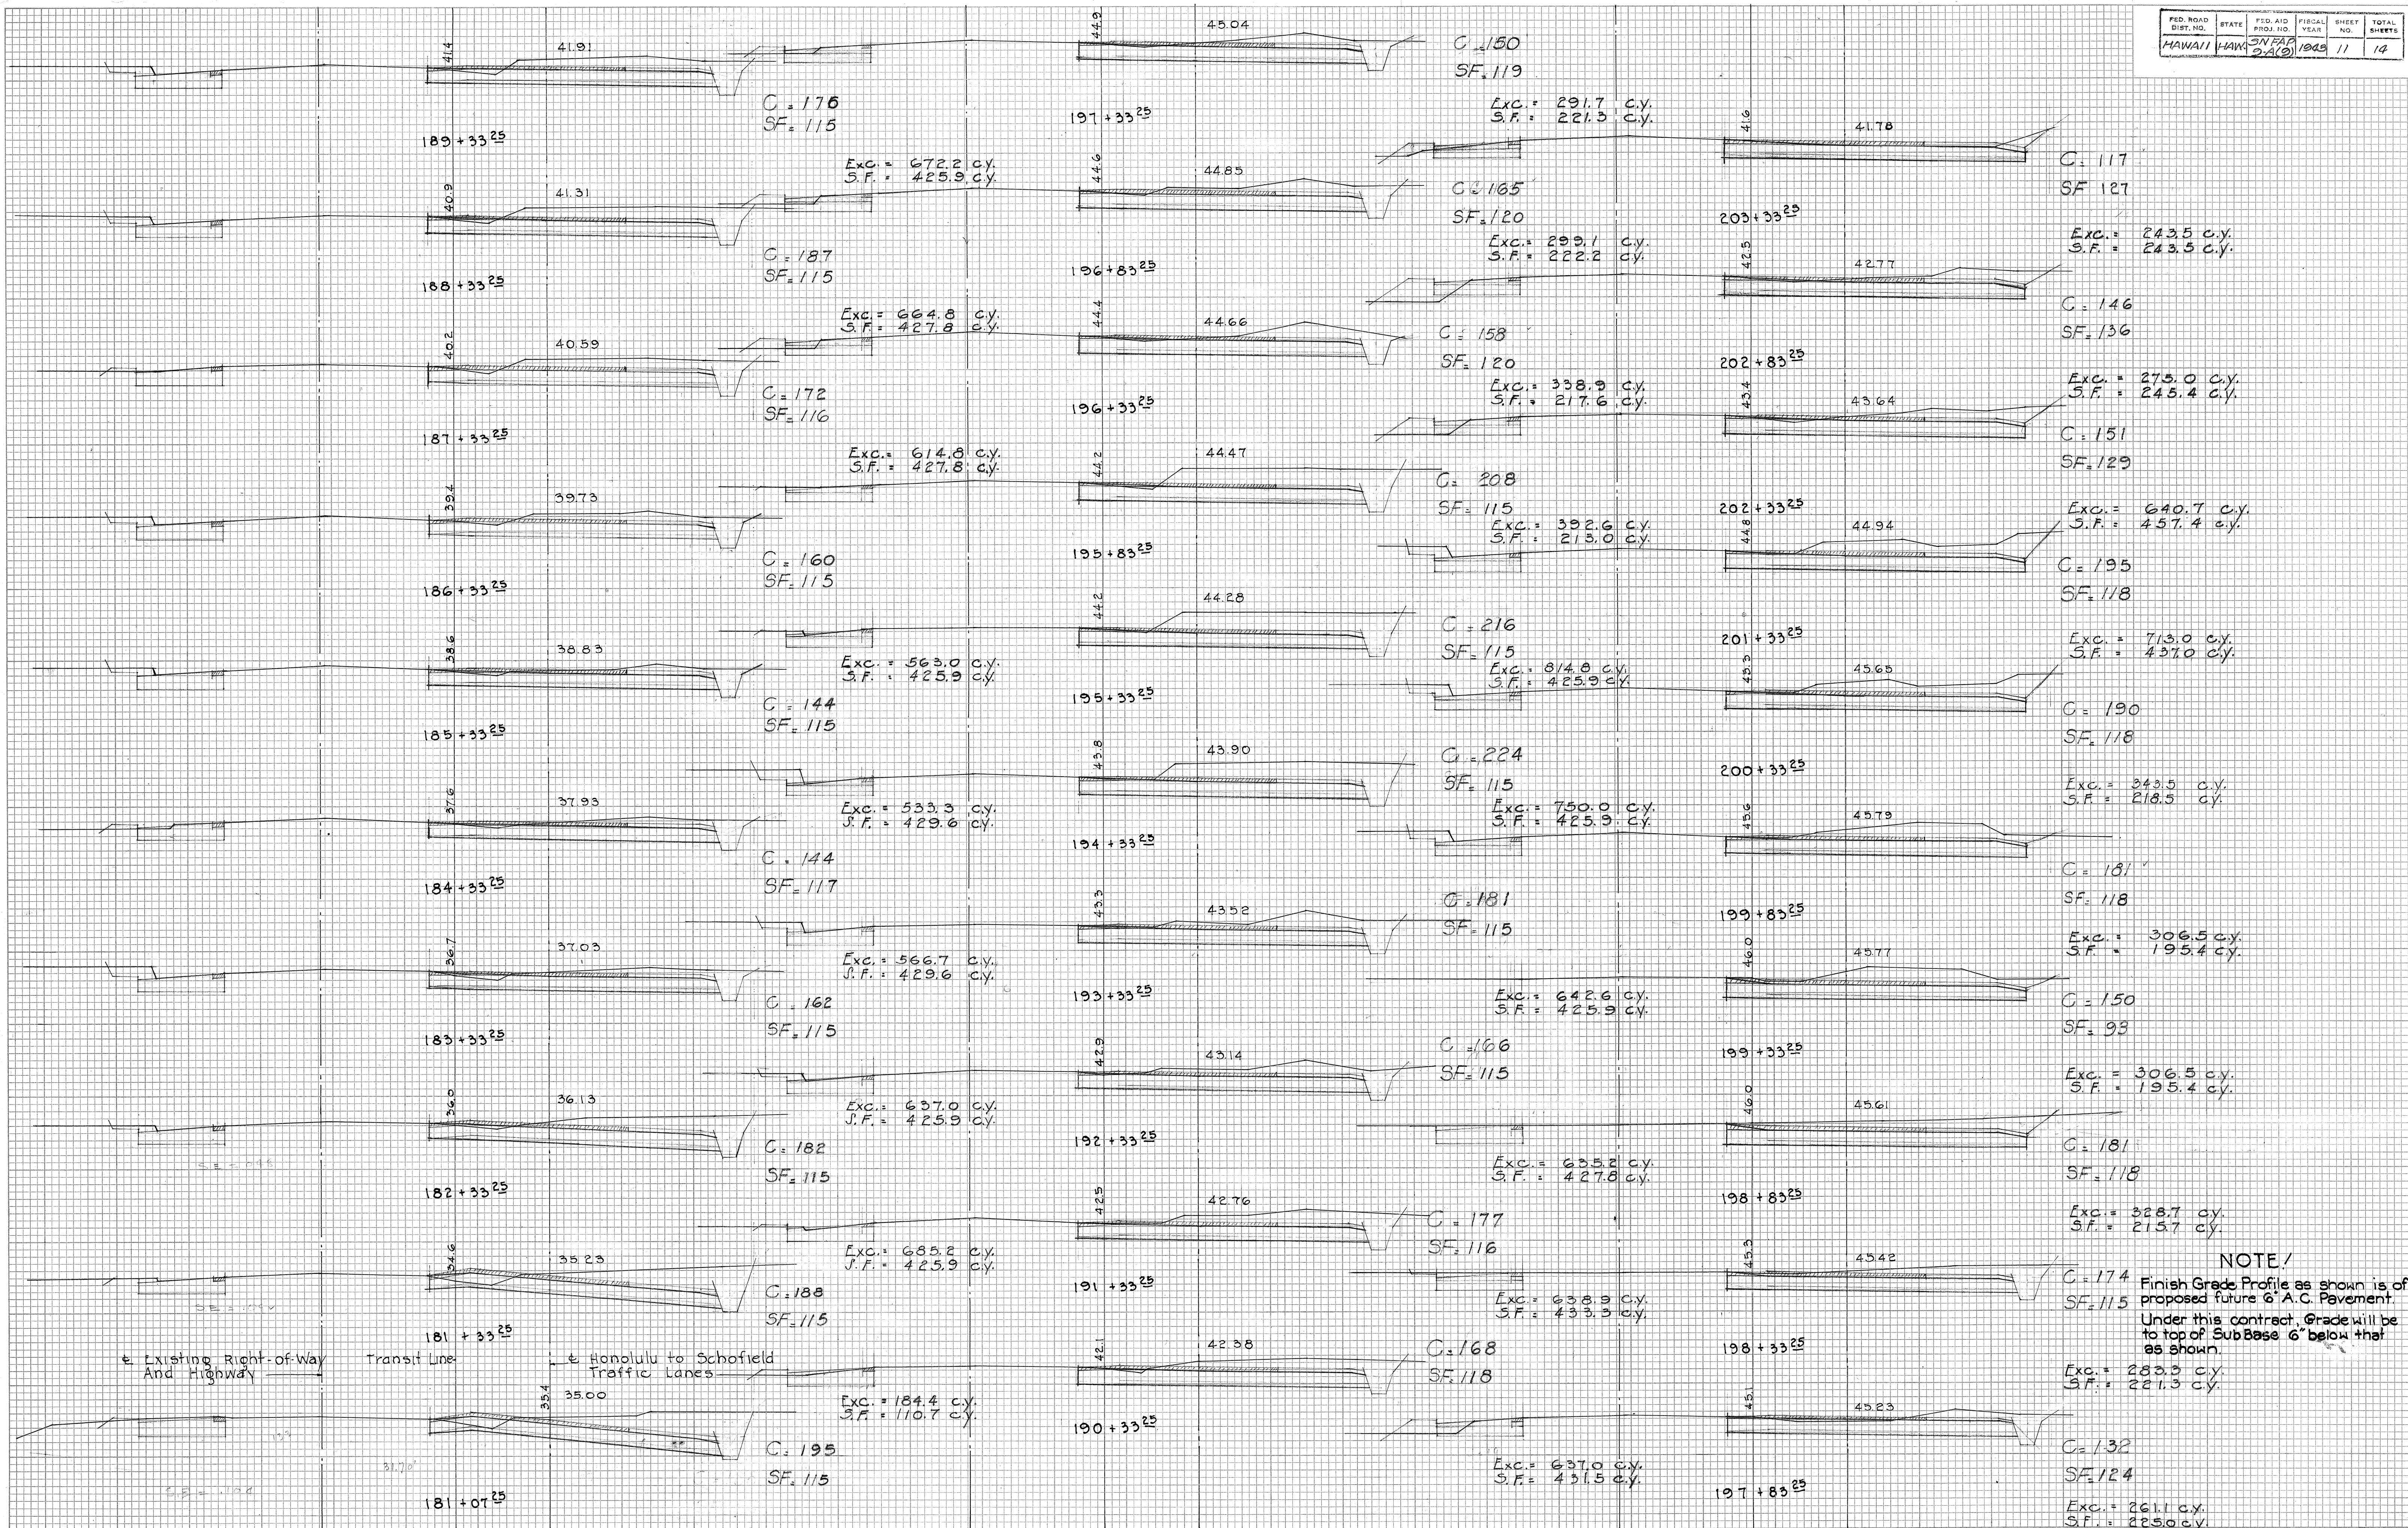


NOTE!
Finish Grade Profile as shown is of proposed future 6" A.C. Pavement. Under this contract, Grade will be to top of SubBase 6" below that as shown.

FINAL	SURVEYED	DATE
SURVEY	PLOTTED	BY
NOTE BOOK	TEMA	
NO.	AREAS CHECKED	

ORIGINAL	SURVEYED	DATE
SURVEY	PLOTTED	BY
NOTE BOOK	TEMA	
NO.	AREAS CHECKED	

FED. ROAD DIST. NO.	STATE	FED. AID PROJ. NO.	FISCAL YEAR	SHEET NO.	TOTAL SHEETS

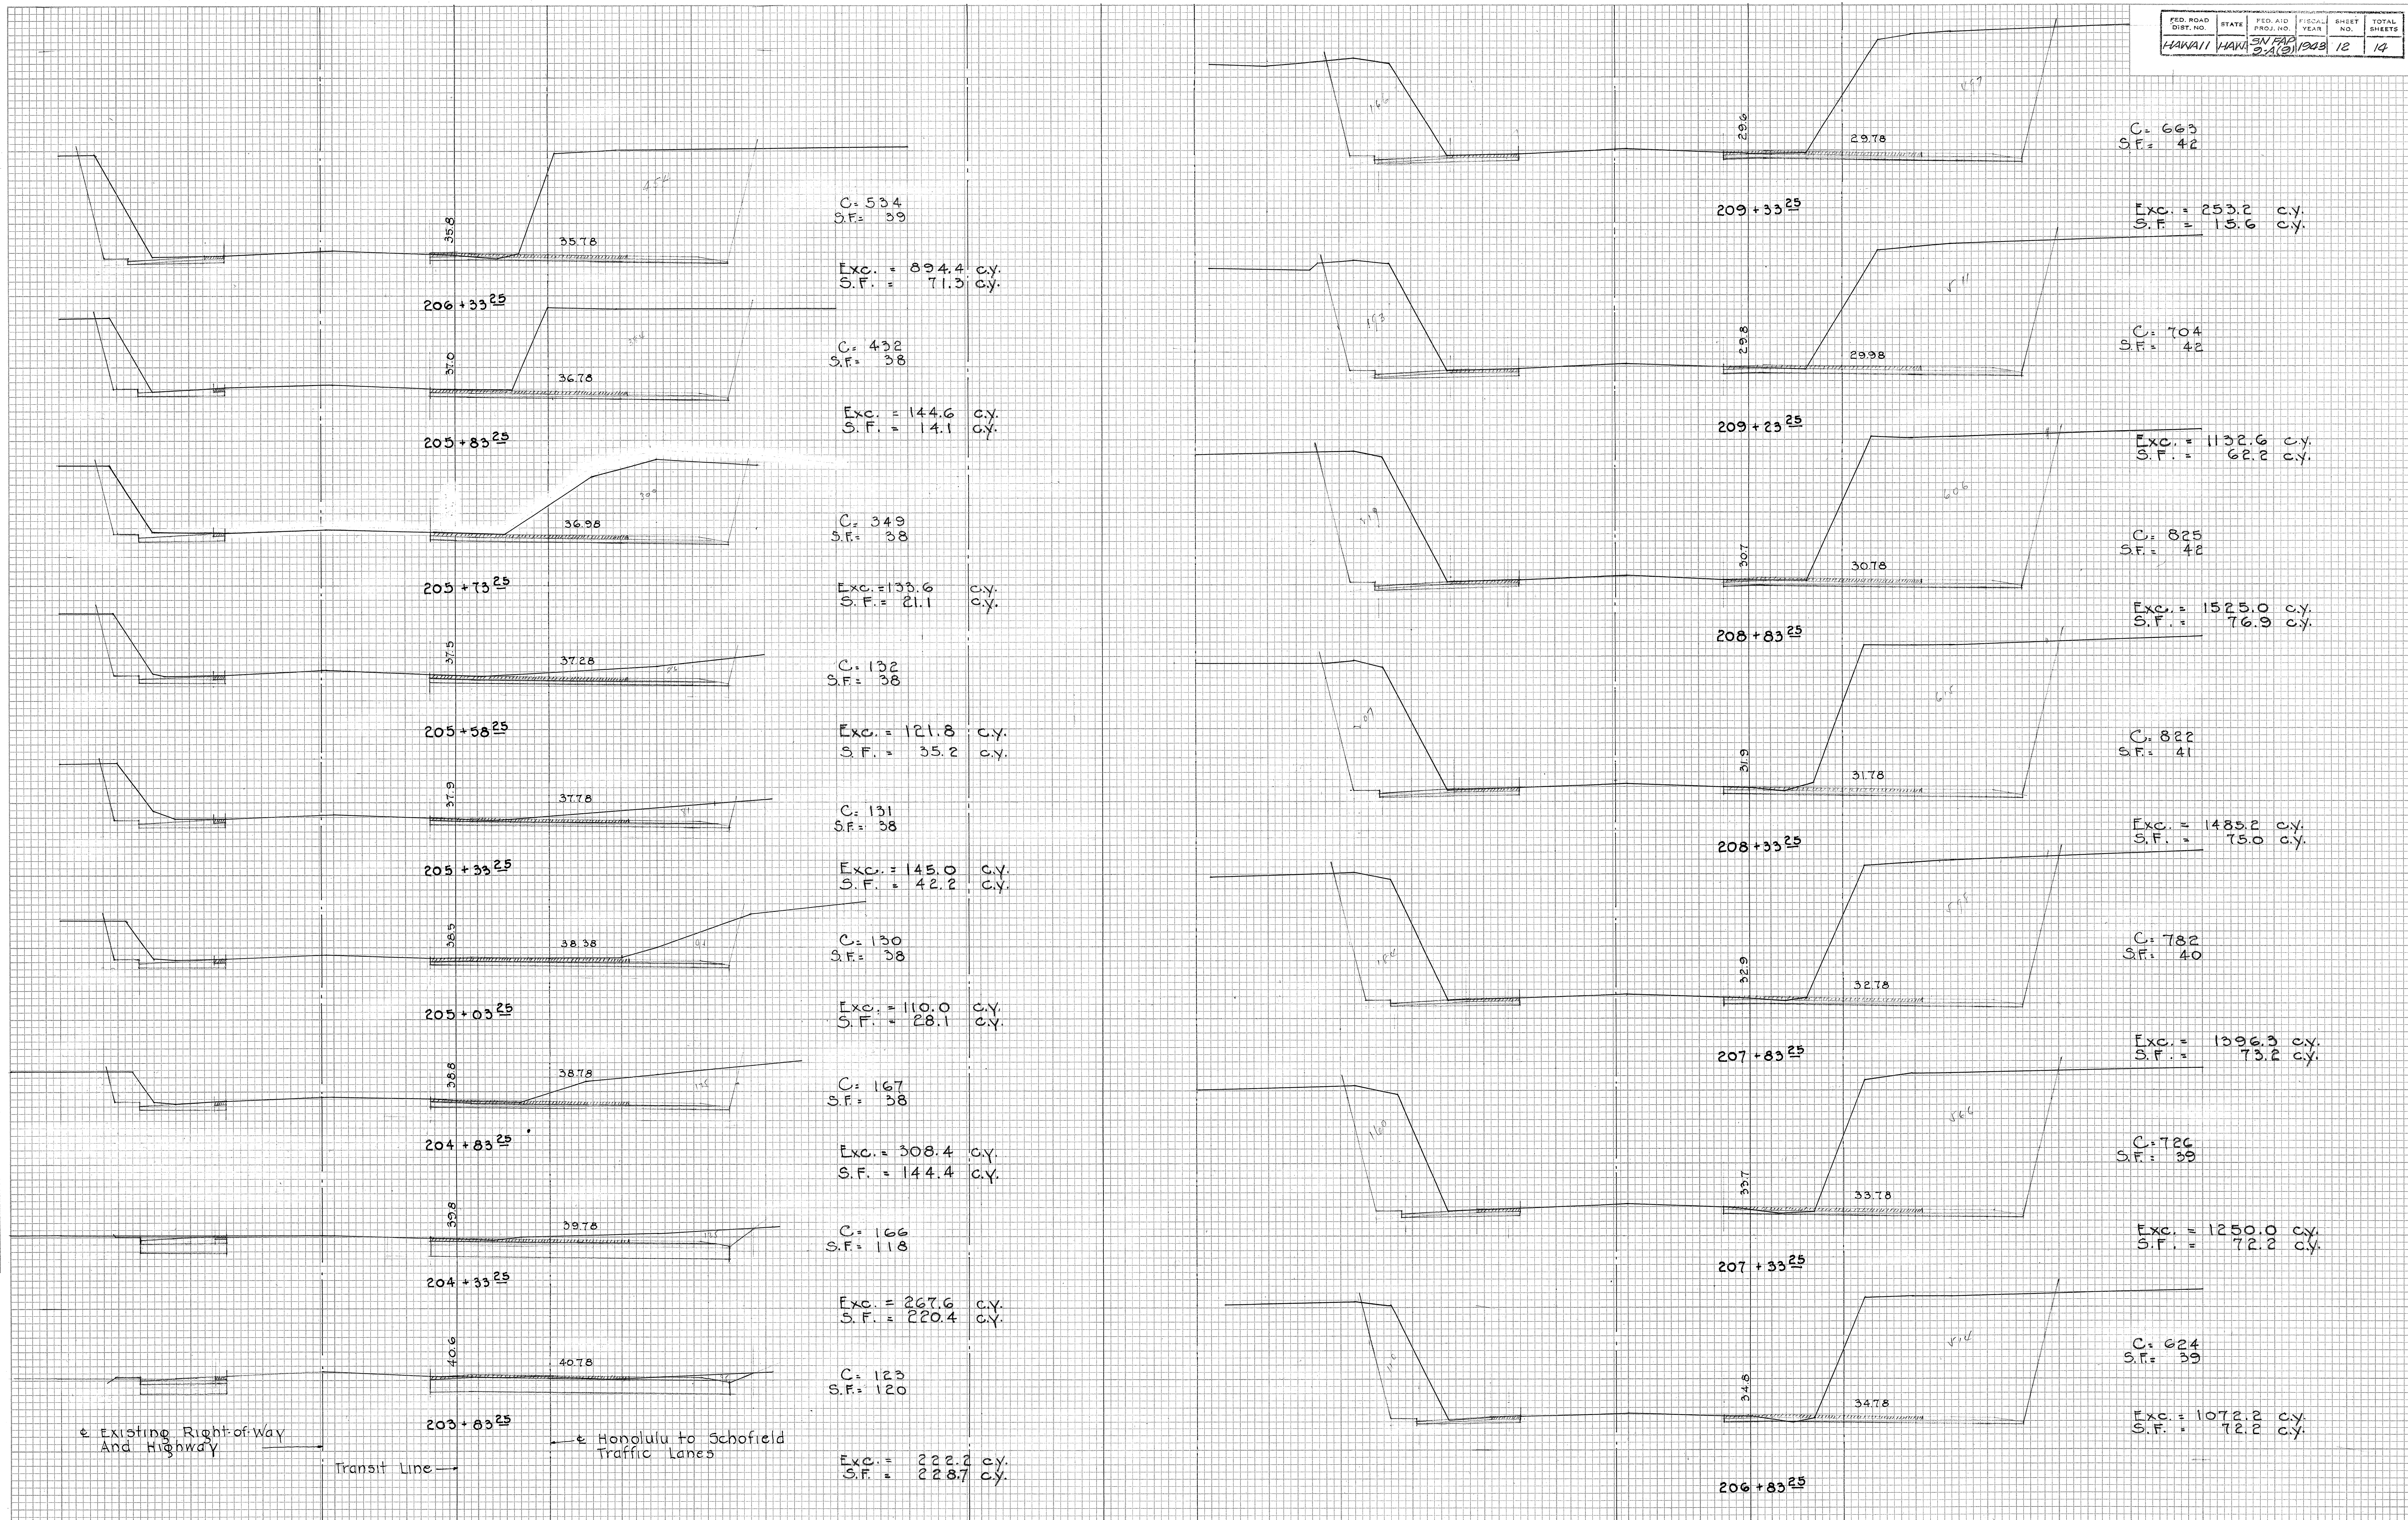

FED. ROAD DIST. NO.	STATE	FED. AID PROJ. NO.	FISCAL YEAR	SHEET NO.	TOTAL SHEETS
HAWAII	HAW.	SNAP 2A(2)	1963	13	14

Exc. = 113.9 c.y.
S.F. = 113.9 c.y.

C = 56
SF = 107

Exc. = 103.7 c.y.
S.F. = 200.0 c.y.

C = 56
SF = 109

Exc. = 113.0 c.y.
S.F. = 210.2 c.y.

C = 66
SF = 117

Exc. = 118.5 c.y.
S.F. = 215.7 c.y.

C = 62
SF = 115

Exc. = 114.8 c.y.
S.F. = 212.0 c.y.

C = 62
SF = 114

Exc. = 143.5 c.y.
S.F. = 204.6 c.y.

C = 93
SF = 107
F = 340

Exc. = 248.2 c.y.
S.F. = 287.0 c.y.
Emb. = 398.2 c.y.

C = 175
SF = 156
F = 90

Exc. = 287.0 c.y.
S.F. = 183.3 c.y.
Emb. = 83.3 c.y.

C = 135
SF = 42
F = 0

Exc. = 422.6 c.y.
S.F. = 54.5 c.y.

C = 517
SF = 42

Exc. = 327.8 c.y.
S.F. = 23.3 c.y.

C = 95
SF = 37

Exc. = 174.1 c.y.
S.F. = 79.6 c.y.

C = 93
SF = 49

Exc. = 240.7 c.y.
S.F. = 87.0 c.y.

C = 167
SF = 45

Exc. = 358.3 c.y.
S.F. = 83.3 c.y.

C = 220
SF = 45

Exc. = 363.0 c.y.
S.F. = 83.3 c.y.

C = 172
SF = 45

Exc. = 232.4 c.y.
S.F. = 83.3 c.y.

C = 79
SF = 45
F = 0

Exc. = 221.3 c.y.
S.F. = 228.7 c.y.
Emb. = 55.6 c.y.

C = 100
SF = 140
F = 111
F = 0

Exc. = 154.6 c.y.
S.F. = 154.6 c.y.

C = 67
SF = 103

Exc. = 124.1 c.y.
S.F. = 195.4 c.y.

C = 67
SF = 108

NOTE:

Finish Grades as shown are of proposed future G.A.C. Pavement. Under this contract, Grades will be to top of Subbase 6' below that as shown.

Sta. 211+15 Beginning of Navy Entrance Quantities. See Separate Sheet

211+15 F = 390
SF = 51

Sta. 214+55 End of Navy Entrance Quantities

Existing Right of Way


Transit Line

Honolulu to Schofield Traffic Lanes

FED. ROAD DIST. NO.	STATE	FED. AID PROJ. NO.	FISCAL YEAR	SHEET NO.	TOTAL SHEETS
HAWAII	HAWAII	SNFAP 9-A(2)	1963	14	14

FINAL SURVEY	DATE	
	BY	
	SURVEYED	
	NOTE BOOK	
	AREAS CHECKED	

ORIGINAL SURVEY	DATE	
	BY	
	SURVEYED	
	NOTE BOOK	
	AREAS CHECKED	

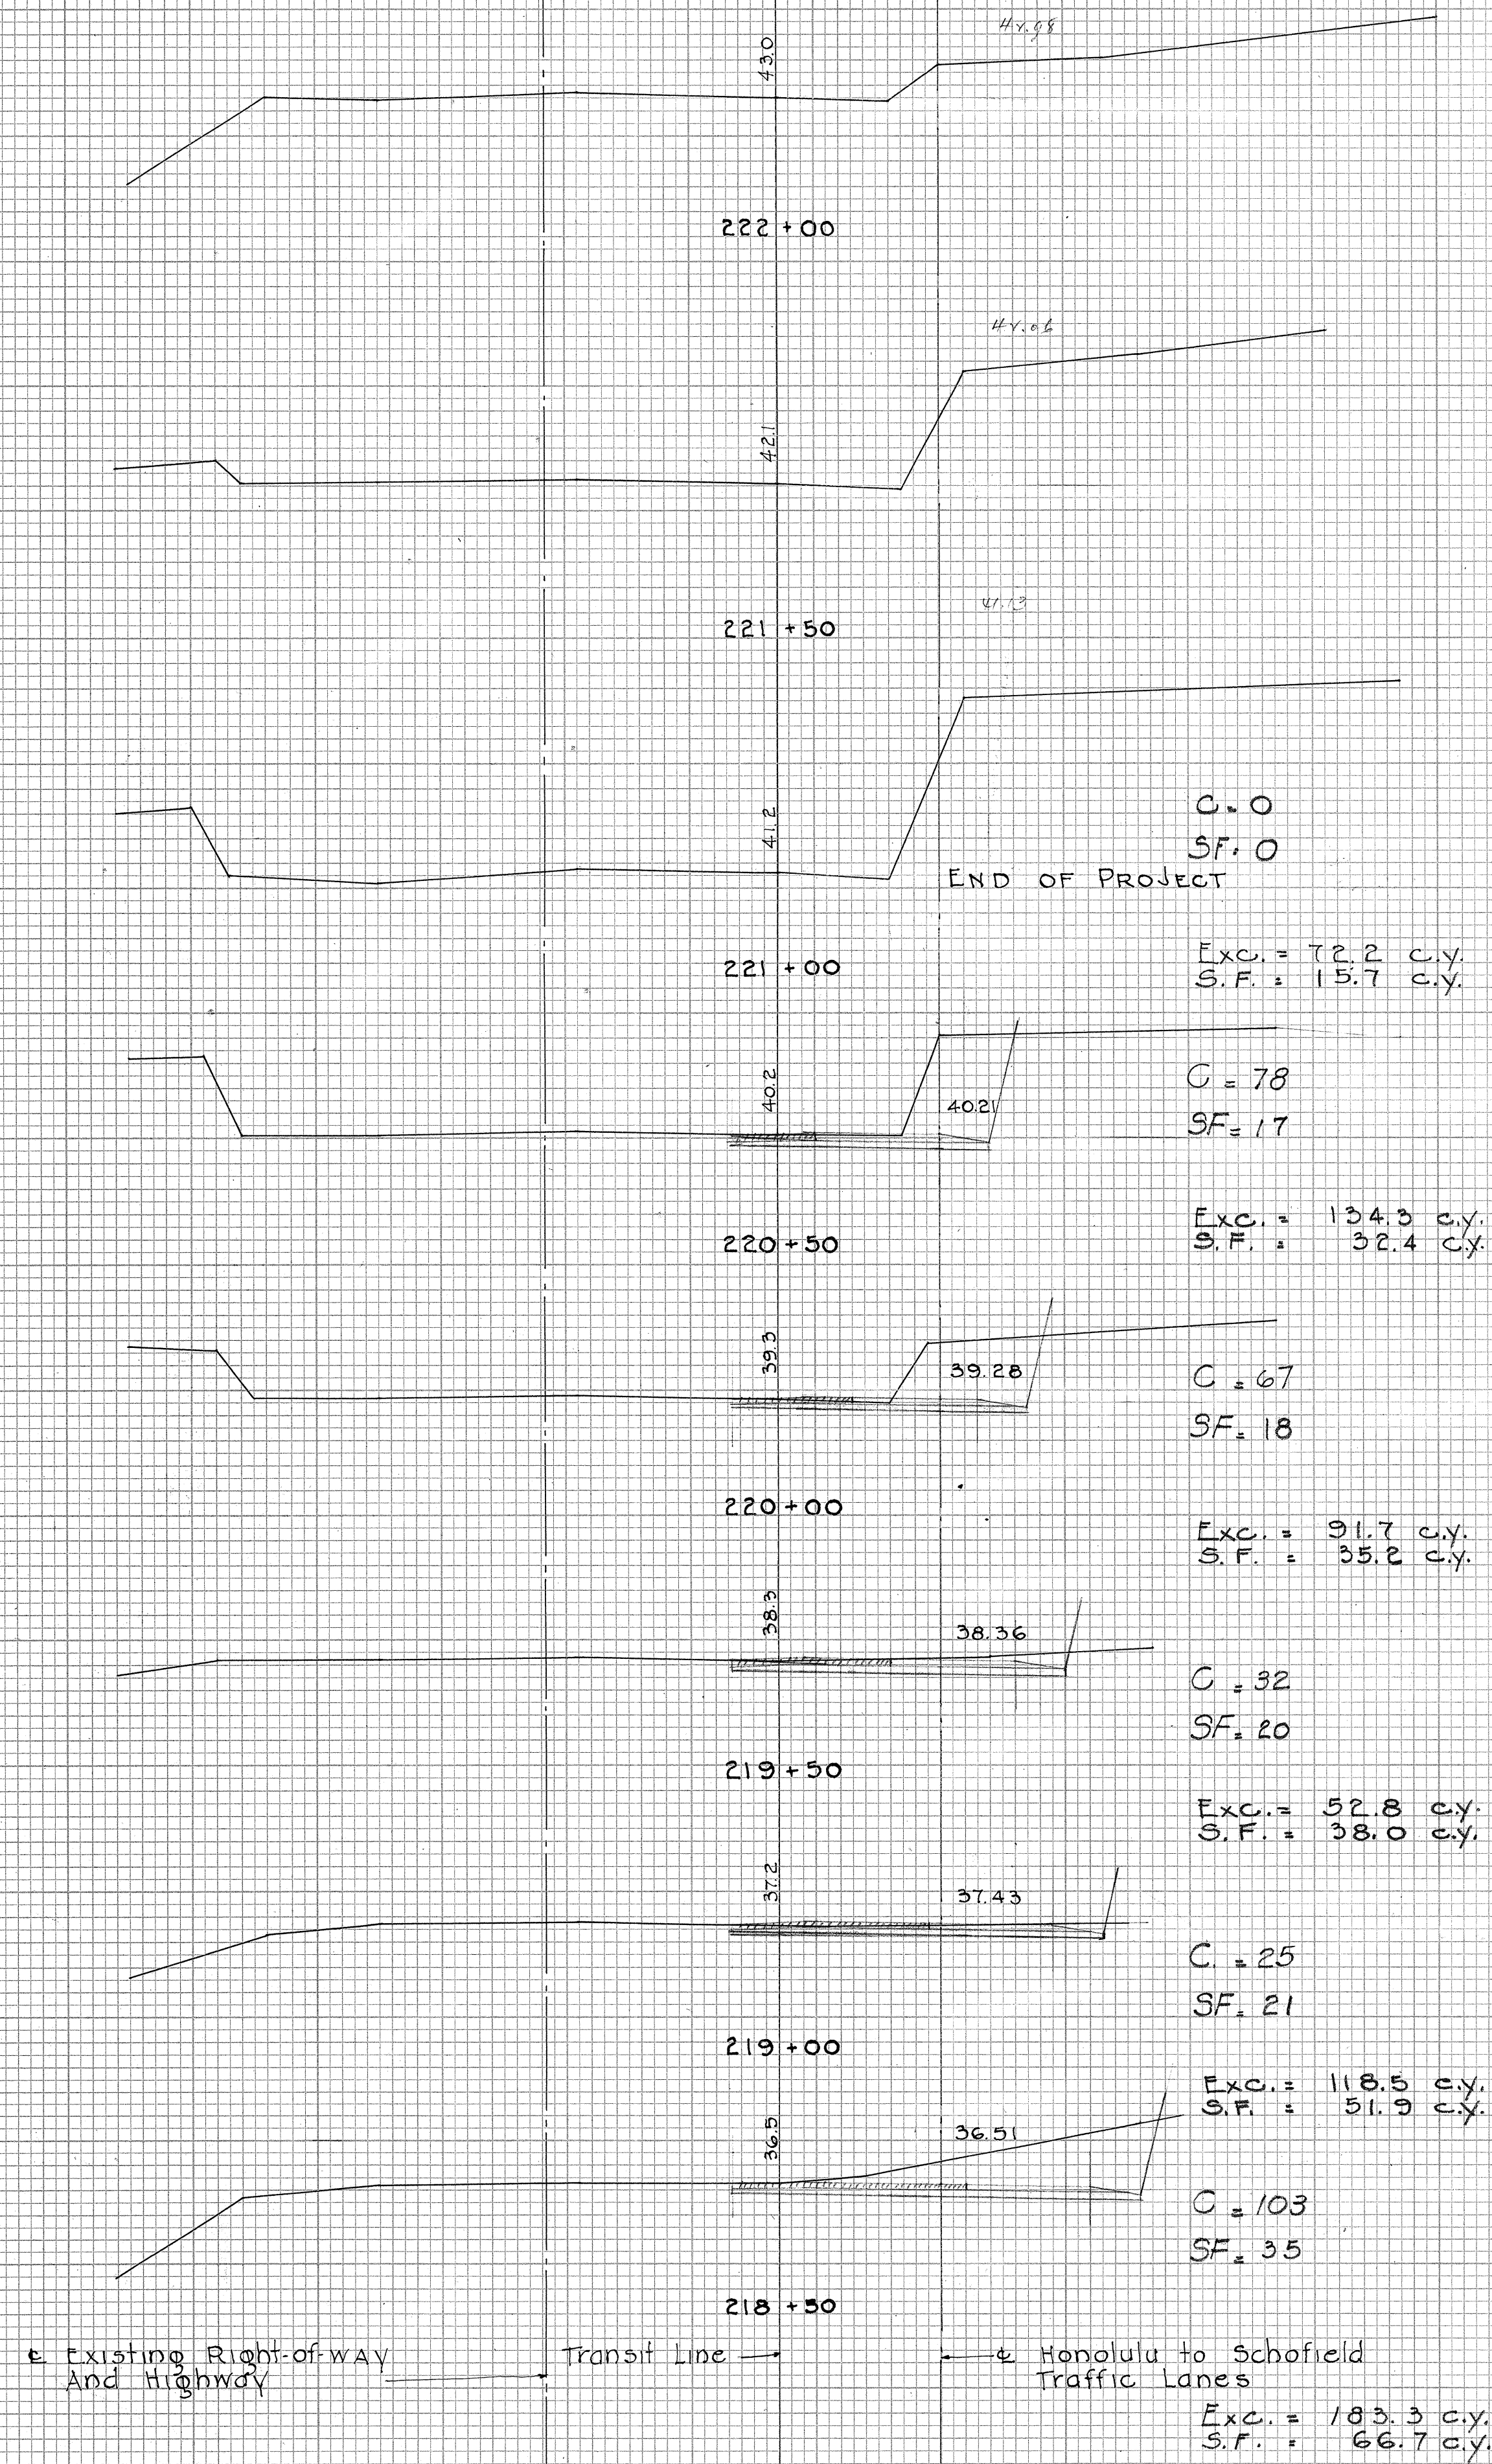

NOTE!
 Finish Grades as shown is of proposed future 6" A.C. Pavement. Under this contract, Grades will be to top of Sub Base 6" below that as shown.