FED. ROAD DIST. NO.	STATE	FED. AID PROJ. NO.	FISCAL YEAR	SHEET NO.	TOTAL SHEETS
HAWAII	HAW	DA-WR 10(2)	1945	1	36

INDEX TO DRAWINGS

SHEET NO.	DESCRIPTION
1	Title Sheet
2	Typical Sections
3-9	Plan & Profile
10-13	Standard Details
14	Culvert Detail
15-36	Cross Sections

All changes made during construction have been shown in red on these tracings and checked by:

Howard T. Kurio
Resident Engineer

Date April 7, 1947

TERRITORY OF HAWAII
TERRITORIAL HIGHWAY DEPARTMENT
HONOLULU - T. H.

PLANS OF
KAMEHAMEHA HIGHWAY
HAWAII PROJECT NO. DA-WR 10 (2)
EWA DISTRICT, ISLAND OF OAHU

SCALES

PLAN		1 INCH = 50 FEET
PROFILE	HOR:	1 INCH = 50 FEET
	VER:	1 INCH = 5 FEET
CROSS SECTIONS	HOR:	1 INCH = 10
	VER:	1 INCH = 5

NOTE:
BRIDGES TO BE DONE UNDER PROJECT NO. DA-WR 10 (3)

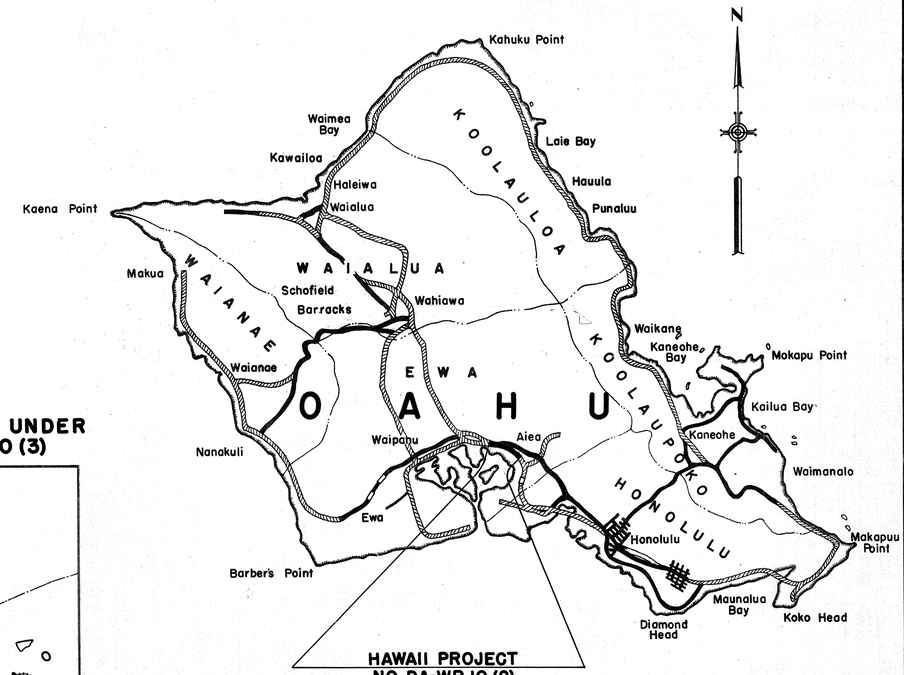

Federal Aid Projects Previously Constructed or Under Construction

CONVENTIONAL SIGNS

Centerline
Boundary Lines
Fences (Noted)
Existing Roadway
Circular Conc. Culvert
Railroad
Telephone Pole — T.P.
Electric Power Line Pole — P.P.
Sewer Manhole — S.M.H.
Telephone Manhole — T.M.H.
Fire Hydrant — F.H.
Water Valve — W.V.
Water Manhole — W.M.H.
St'd Conc. Roll Curb
Water Main — W
Gasoline Pipe Line — G
Communication Cable
Warning & Regulatory Signs — (Type)
Centerline Monument

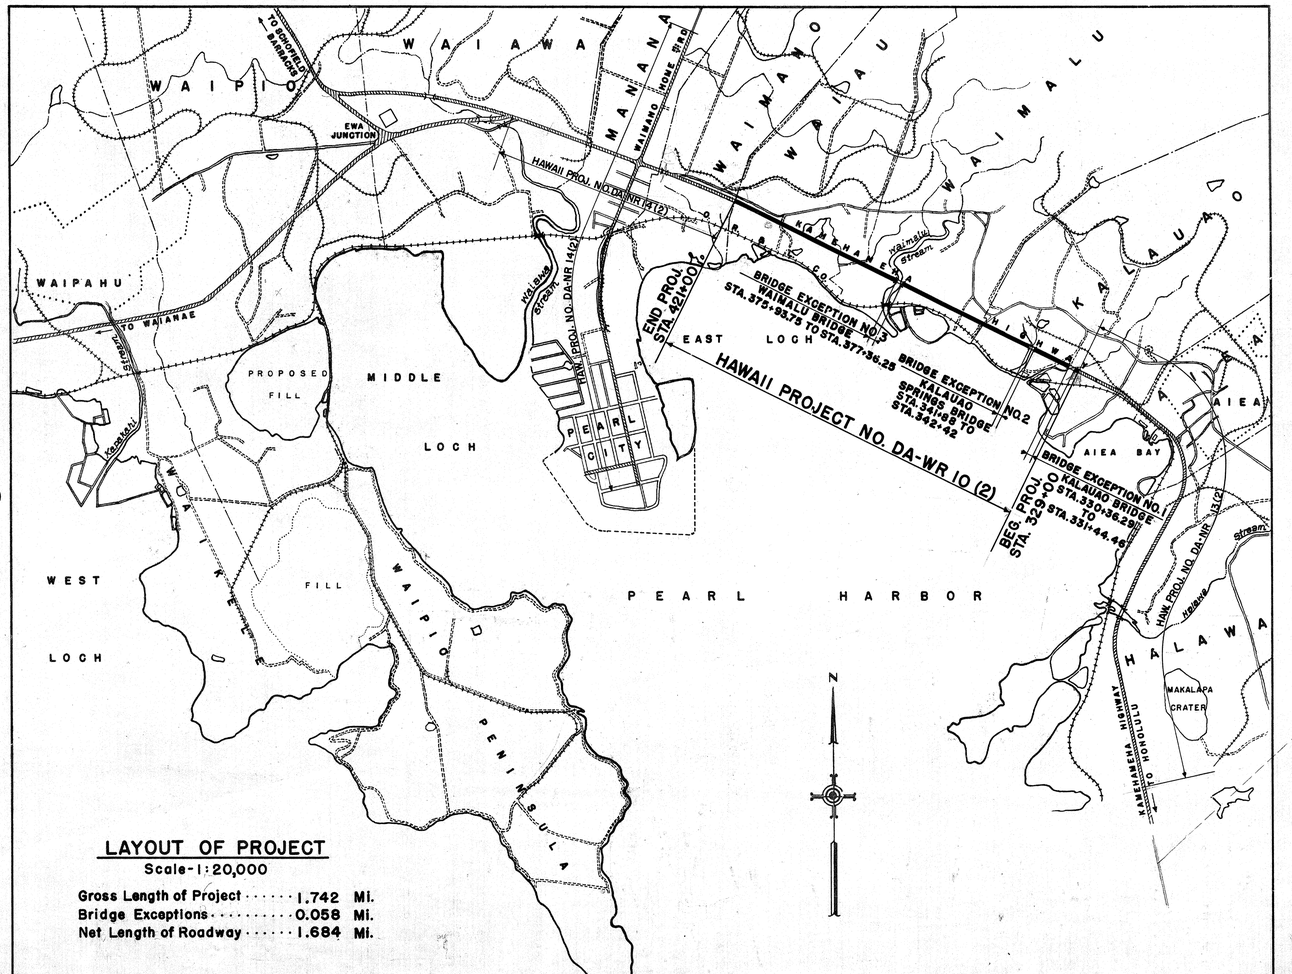

LAYOUT OF PROJECT
Scale-1:20,000

Gross Length of Project	1.742	Mi.
Bridge Exceptions	0.058	Mi.
Net Length of Roadway	1.684	Mi.

ORIGINAL PLAN		
	SURVEY PLOTTED BY	DATE
	DESIGNED BY	"
	TRACED BY	"
	CHECKED BY	"
NOTE BOOK	QUANTITIES BY	"
	QUANTITIES CHECKED BY	"
No.		

Corrected 4/11/47

APPROVED
[redacted]

APPROVED
B. F. Rush
TERRITORIAL HIGHWAY ENGINEER
DATE: 7-28-45

RECOMMENDED FOR APPROVAL
[redacted]
• DISTRICT ENGINEER •
Public Roads Administration, Federal Works Agency

RECOMMENDED FOR APPROVAL
[redacted]
• CHIEF WESTERN REGION •
Public Roads Administration, Federal Works Agency

APPROVED
[redacted]
• COMMISSIONER •
Public Roads Administration, Federal Works Agency

5156.1