


FED. ROAD DIST. NO.	STATE	FED. AID PROJ. NO.	FISCAL YEAR	SHEET NO.	TOTAL SHEETS
HAWAII	HAWAII	F47(4)	1958	17	48

Rev. 6-18-52

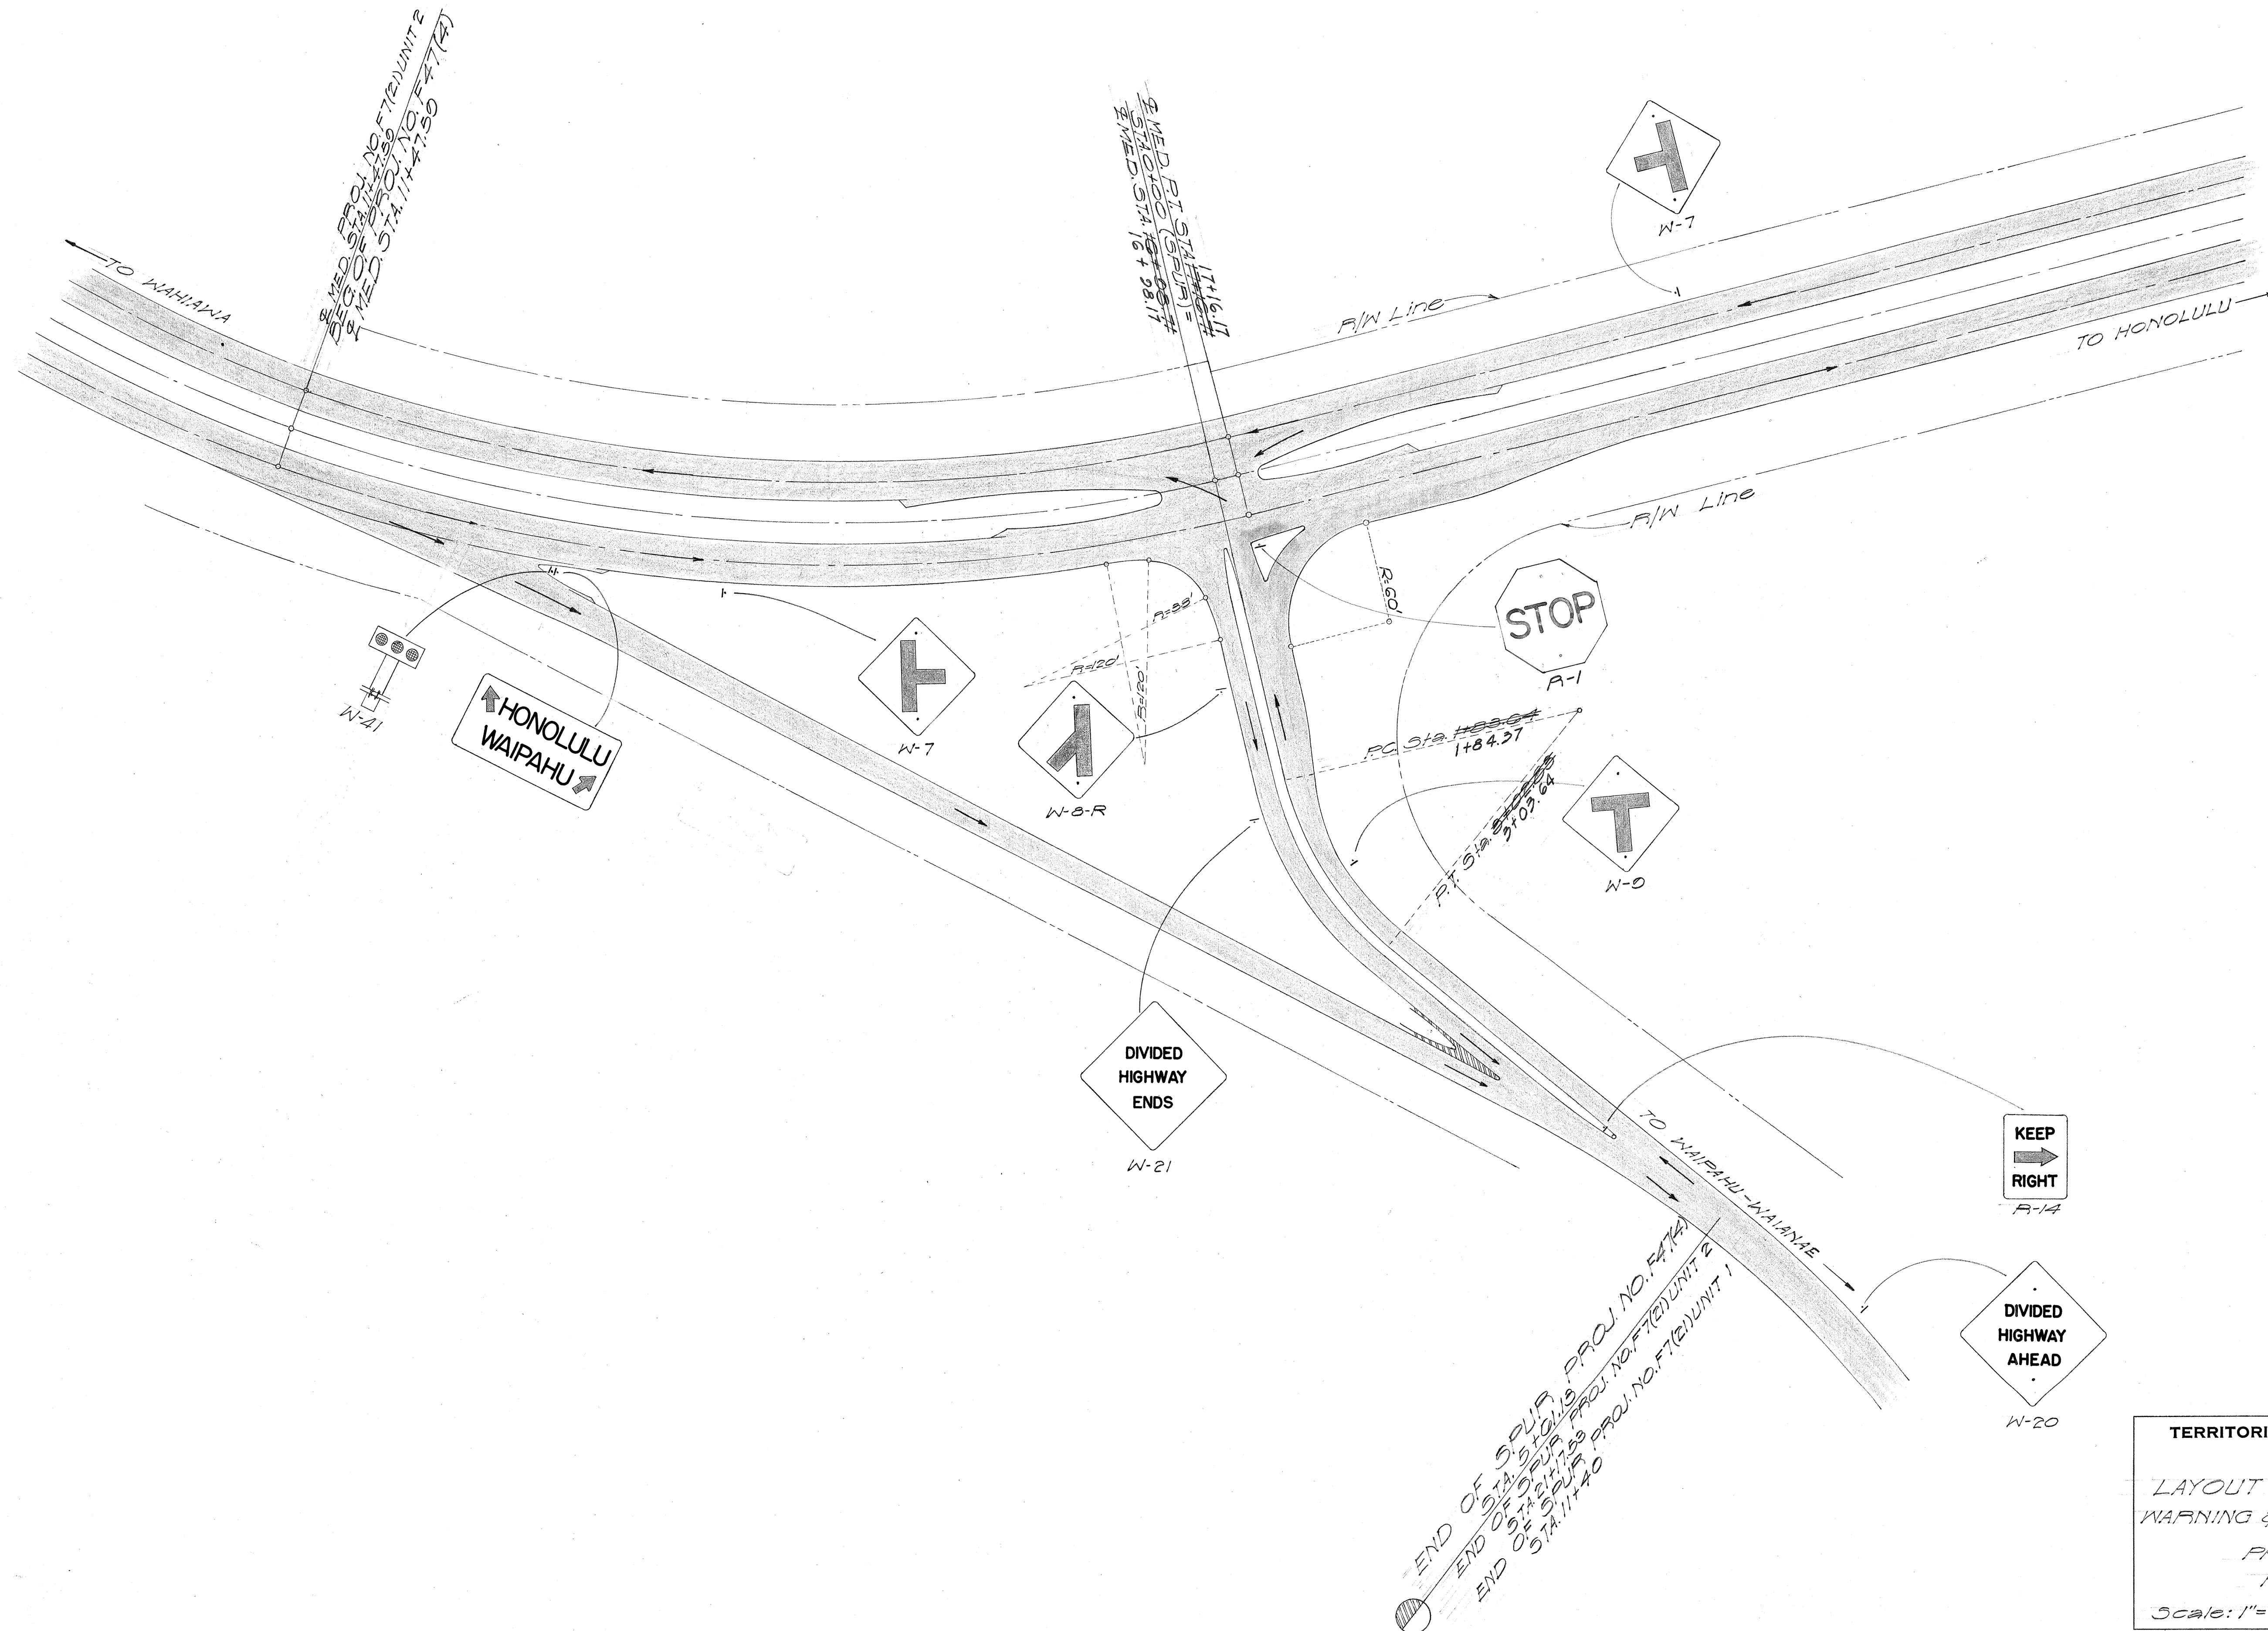

SURVEY PLOTTED BY	DATE
DESIGNED BY	
DRAWN BY	
QUANTITIES CHECKED BY	
NOTE BOOK No.	


TERRITORIAL HIGHWAY DEPARTMENT
TERRITORY OF HAWAII
LAYOUT OF REGULATORY,
WARNING & DESTINATION SIGNS
PROJECT NO. F47(4)
HONOLULU T.H.
Scale: 1"=50'

SHEET No. 1 OF 3 SHEETS

5479.17

FED. ROAD DIST. NO.	STATE	FED. AID PROJ. NO.	FISCAL YEAR	SHEET NO.	TOTAL SHEETS
HAWAII	HAW.	F-47(4)	1958	18	43

Rev. 6-18-52

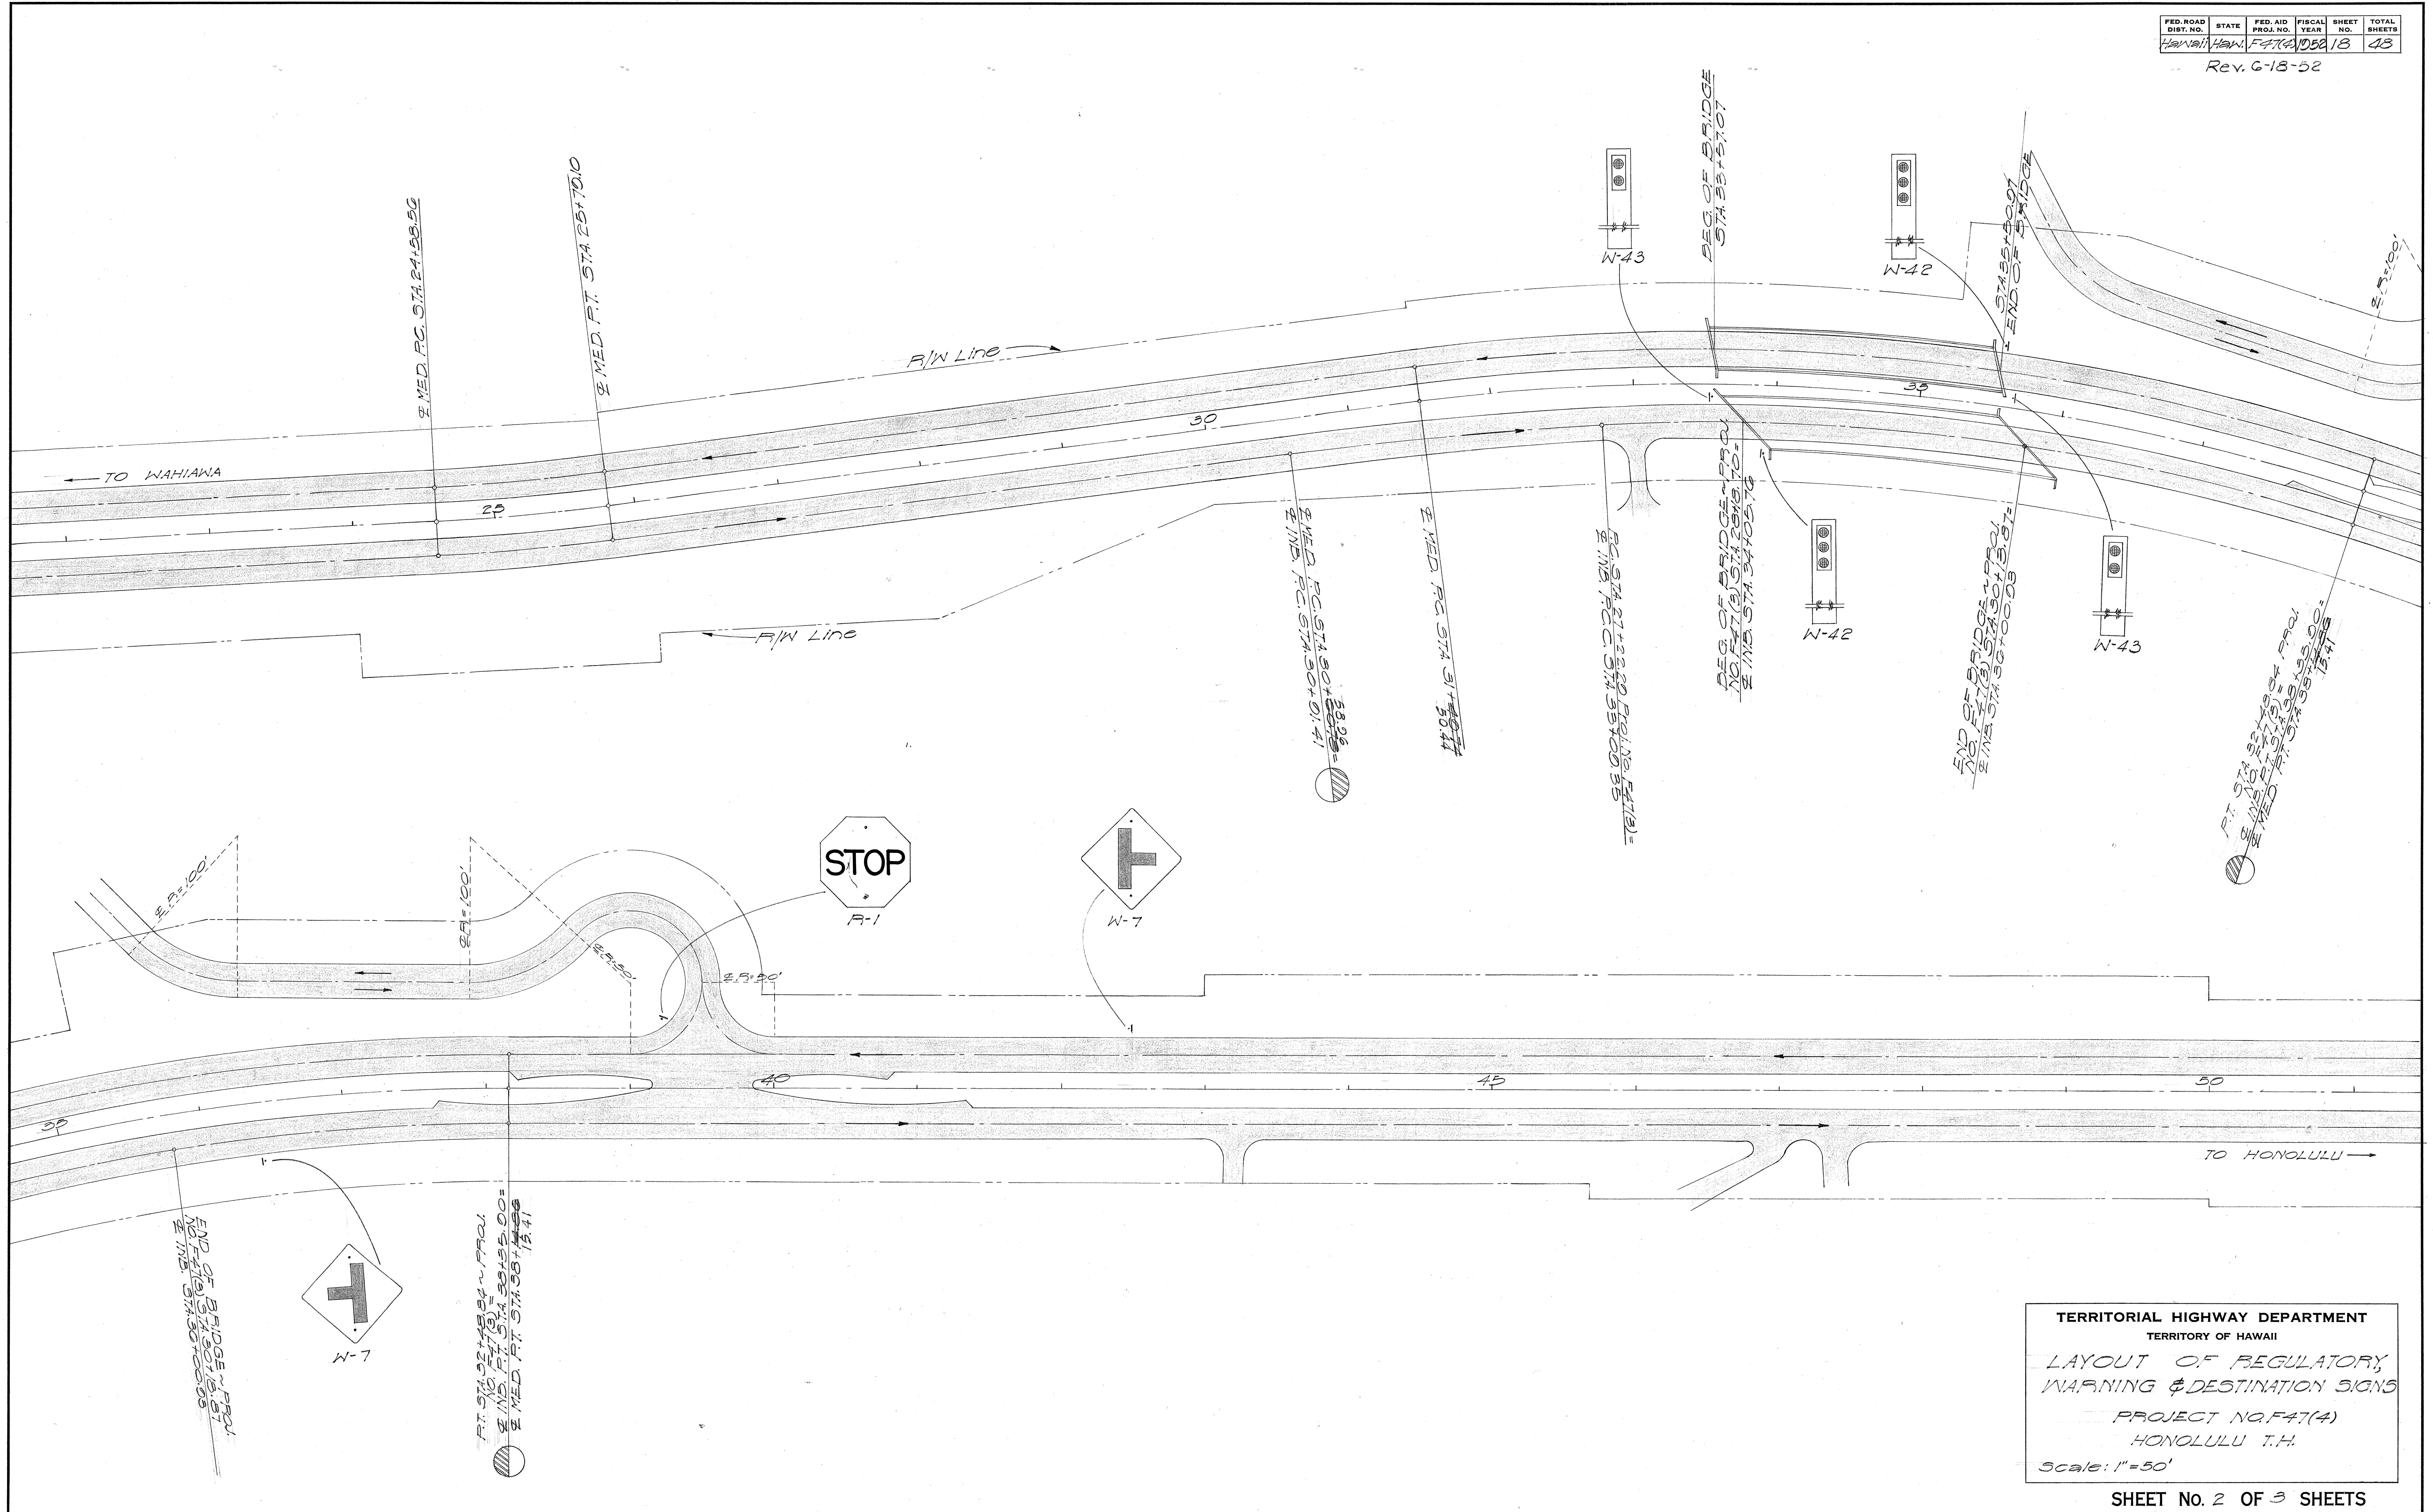

TERRITORIAL HIGHWAY DEPARTMENT
TERRITORY OF HAWAII
LAYOUT OF REGULATORY,
WARNING & DESTINATION SIGNS
PROJECT NO. F47(4)
HONOLULU T.H.
Scale: 1"=50'

SHEET No. 2 OF 3 SHEETS

5479.18

ORIGINAL PLAN	NOTE BOOK
DESIGNED BY	NO.
DRAWN BY	
CHECKED BY	
QUANTITIES CHECKED BY	
DATE	

