FED. ROAD DIST. NO.	STATE	FED AID PROJ. NO.	FISCAL YEAR	SHEET NO.	TOTAL SHEETS
HAWAII	HAW.	U-090-1(16)	1969	1	50

INDEX TO DRAWINGS

SHEET NO.	DESCRIPTION
1	TITLE SHEET
2	TYPICAL SECTIONS
3-5	ROADWAY PLANS
6-9	MISC. ROADWAY DETAILS
10-12	R/W ADJUSTMENT PLANS & DETAILS
13-22	STANDARD DETAILS
23-28	DRAINAGE DETAILS
29-31	TRAFFIC SIGNAL SYSTEM PLANS & DETAILS
32-42	HIGHWAY LIGHTING & UTILITIES
43-50	CROSS SECTIONS

STATE OF HAWAII

DEPARTMENT OF TRANSPORTATION

HIGHWAYS DIVISION

HONOLULU, HAWAII

"AS-BUILT" PLANS OF

KAMEHAMEHA HIGHWAY WIDENING MAKALAPA GATE TO FORD ISLAND FERRY LANDING ACCESS ROAD

FEDERAL AID PROJECT NO. U-090-1(16)

DISTRICT OF EWA

ISLAND OF OAHU

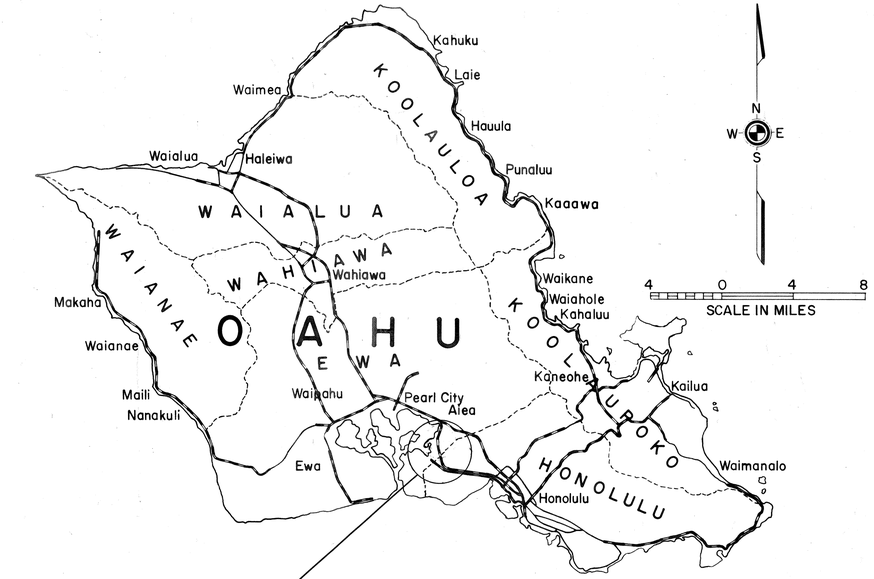

LOCATION OF PROJECT NO. U-090-1(16)

Federal Aid Projects Previously Constructed or Under Construction

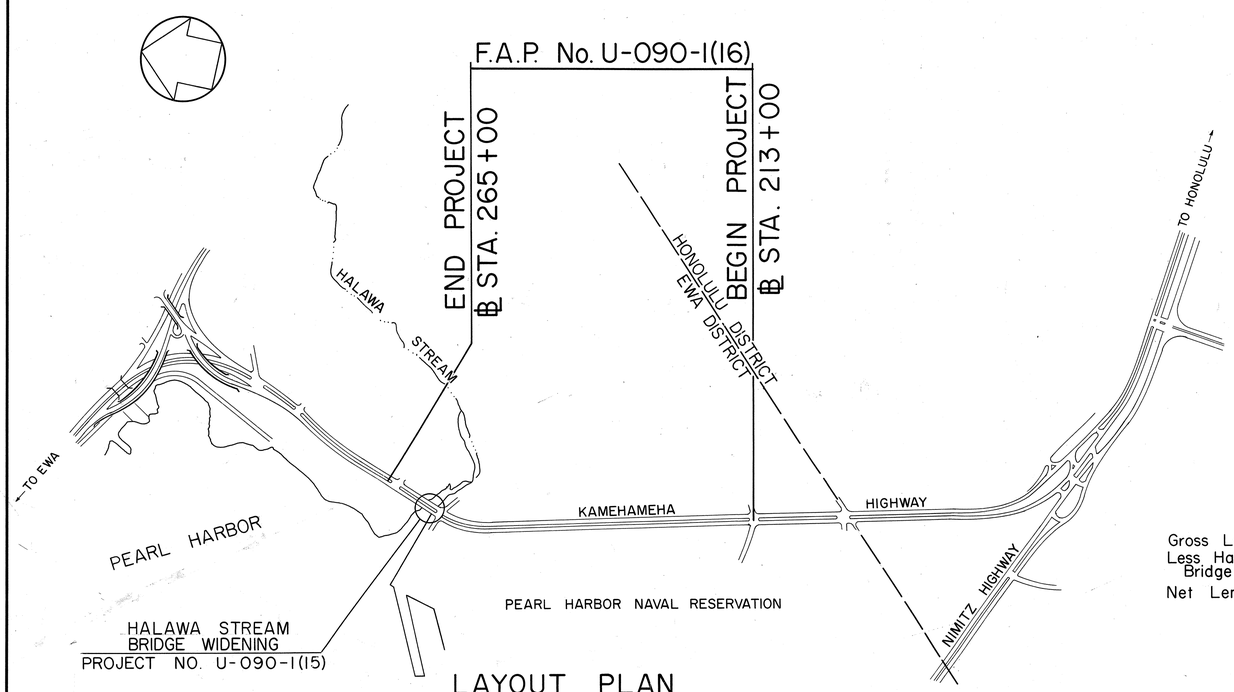

LAYOUT PLAN

SCALE: 1" = 1000'

Gross Length of Project	0.985	Mi.
Less Halawa Stream Bridge Widening	0.089	Mi.
Net Length of Project	0.896	Mi.

NOTE:

ALL CHANGES MADE DURING CONSTRUCTION HAVE BEEN NOTED IN RED ON THESE TRACINGS AND CHECKED BY:

Felipe A. Cabana

PROJECT ENGINEER

2/10/77

DATE

DESIGN CLASSIFICATION

ADT (1969)	20,820
INTERIM ADT (1970)	35,000
DESIGN ADT (1979)	20,820
DHV	7.5%
D	85/15
T	5.0%
T_{24}	6.0%
V	50 MPH

DEPARTMENT OF TRANSPORTATION
BUREAU OF PUBLIC ROADS

APPROVED:

Ralph T. Segawa 9/18/69

for DIVISION ENGINEER — DATE

DEPARTMENT OF TRANSPORTATION
STATE OF HAWAII

APPROVED:

E. Alvey Wright 9/10/69

for DIR. OF TRANSPORTATION — DATE

R. MIKAMI JUNE, 1969

5-3-50