| FED. ROAD DIST. NO. | STATE | PROJ. NO. | FISCAL YEAR | SHEET NO. | TOTAL SHEETS |
|---|---|---|---|---|---|
| HAWAII | HAW. | 90BD-03-70 PHASE I | 1970 | 1 | 16 |

INDEX TO DRAWINGS


| SHEET NO. | DESCRIPTION |
|---|---|
| 1 | TITLE SHEET |
| 2 | TYPICAL ROAD SECTION AND LEGEND |
| 3-5 | PLANS AND DETAILS |
| 6 | MISCELLANEOUS DETAILS |
| 7-9 | CROSS-SECTIONS |
| 10-15 | STANDARD DETAILS |
| 16 | PROJECT INFORMATION SIGN |


STATE OF HAWAII

DEPARTMENT OF TRANSPORTATION

HIGHWAYS DIVISION

HONOLULU, HAWAII

"AS BUILT"

PLANS FOR

# KAMEHAMEHA HIGHWAY IMPROVEMENTS

PROJECT NO. 90BD-03-70

PHASE I

INCLUDING

# INTERSECTION IMPROVEMENTS

ON

KAMEHAMEHA HIGHWAY INBOUND AT LEHUA AVENUE

KAMEHAMEHA HIGHWAY INBOUND AT HONOMANU STREET

KAMEHAMEHA HIGHWAY INBOUND AT ELLIOTT STREET

DISTRICTS OF HONOLULU AND EWA

ISLAND OF OAHU

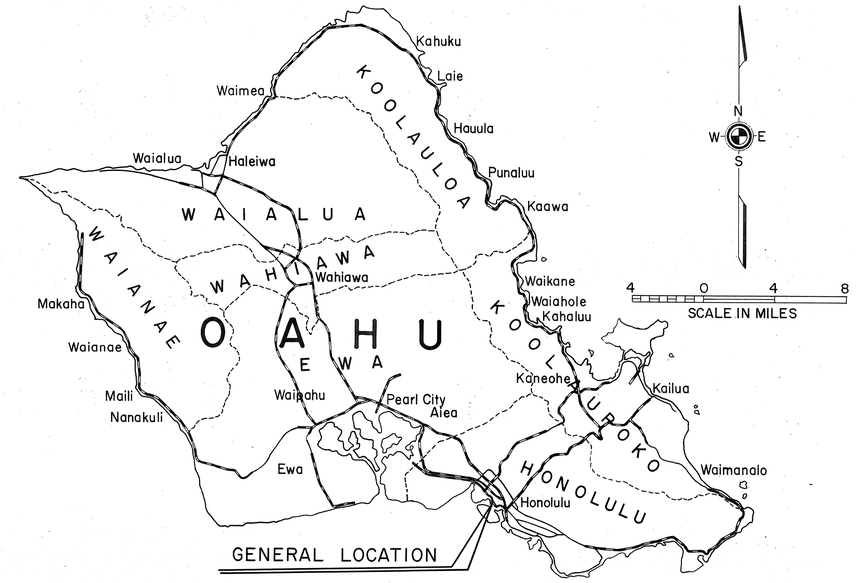


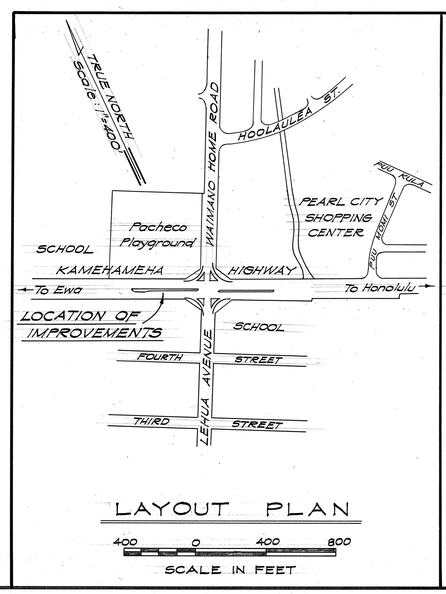


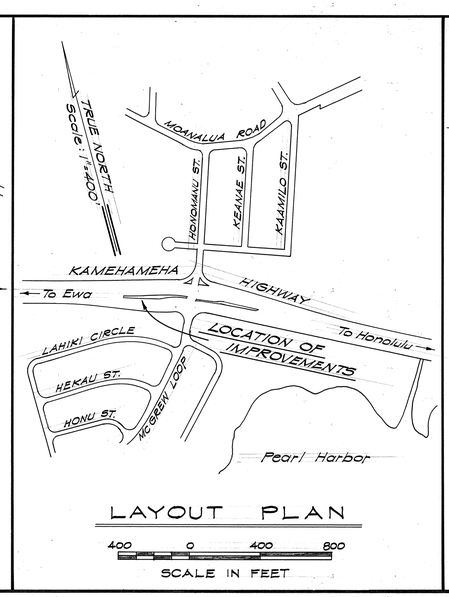


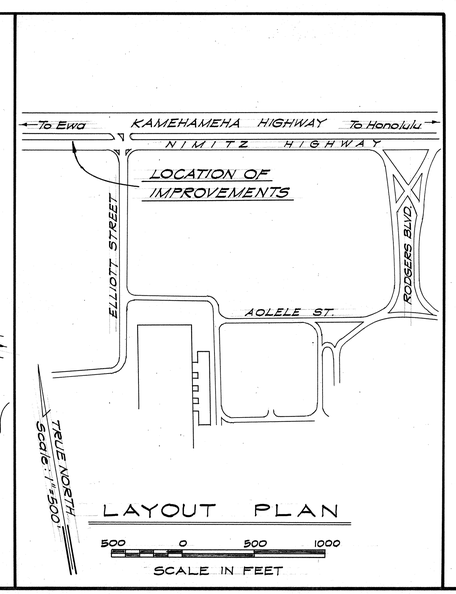


NOTE:
NO "AS BUILT" CHANGES.

R. T. Sasaki 2/21/73
for Project Engineer Date

WILLIAM C. HONG
REGISTERED PROFESSIONAL ENGINEER
No. 787
HAWAII, U.S.A.

THIS WORK WAS PREPARED BY ME OR UNDER MY SUPERVISION

William C. Hong

DEPARTMENT OF TRANSPORTATION
STATE OF HAWAII

APPROVED:

E. Alvey Wright 10/6/70
for DIR. OF TRANSPORTATION DATE