FED. ROAD DIST. NO.	STATE	PROJ. NO.	FISCAL YEAR	SHEET NO.	TOTAL SHEETS
HAWAII	HAW.	99D-01-17	2022	C.O. 10	35

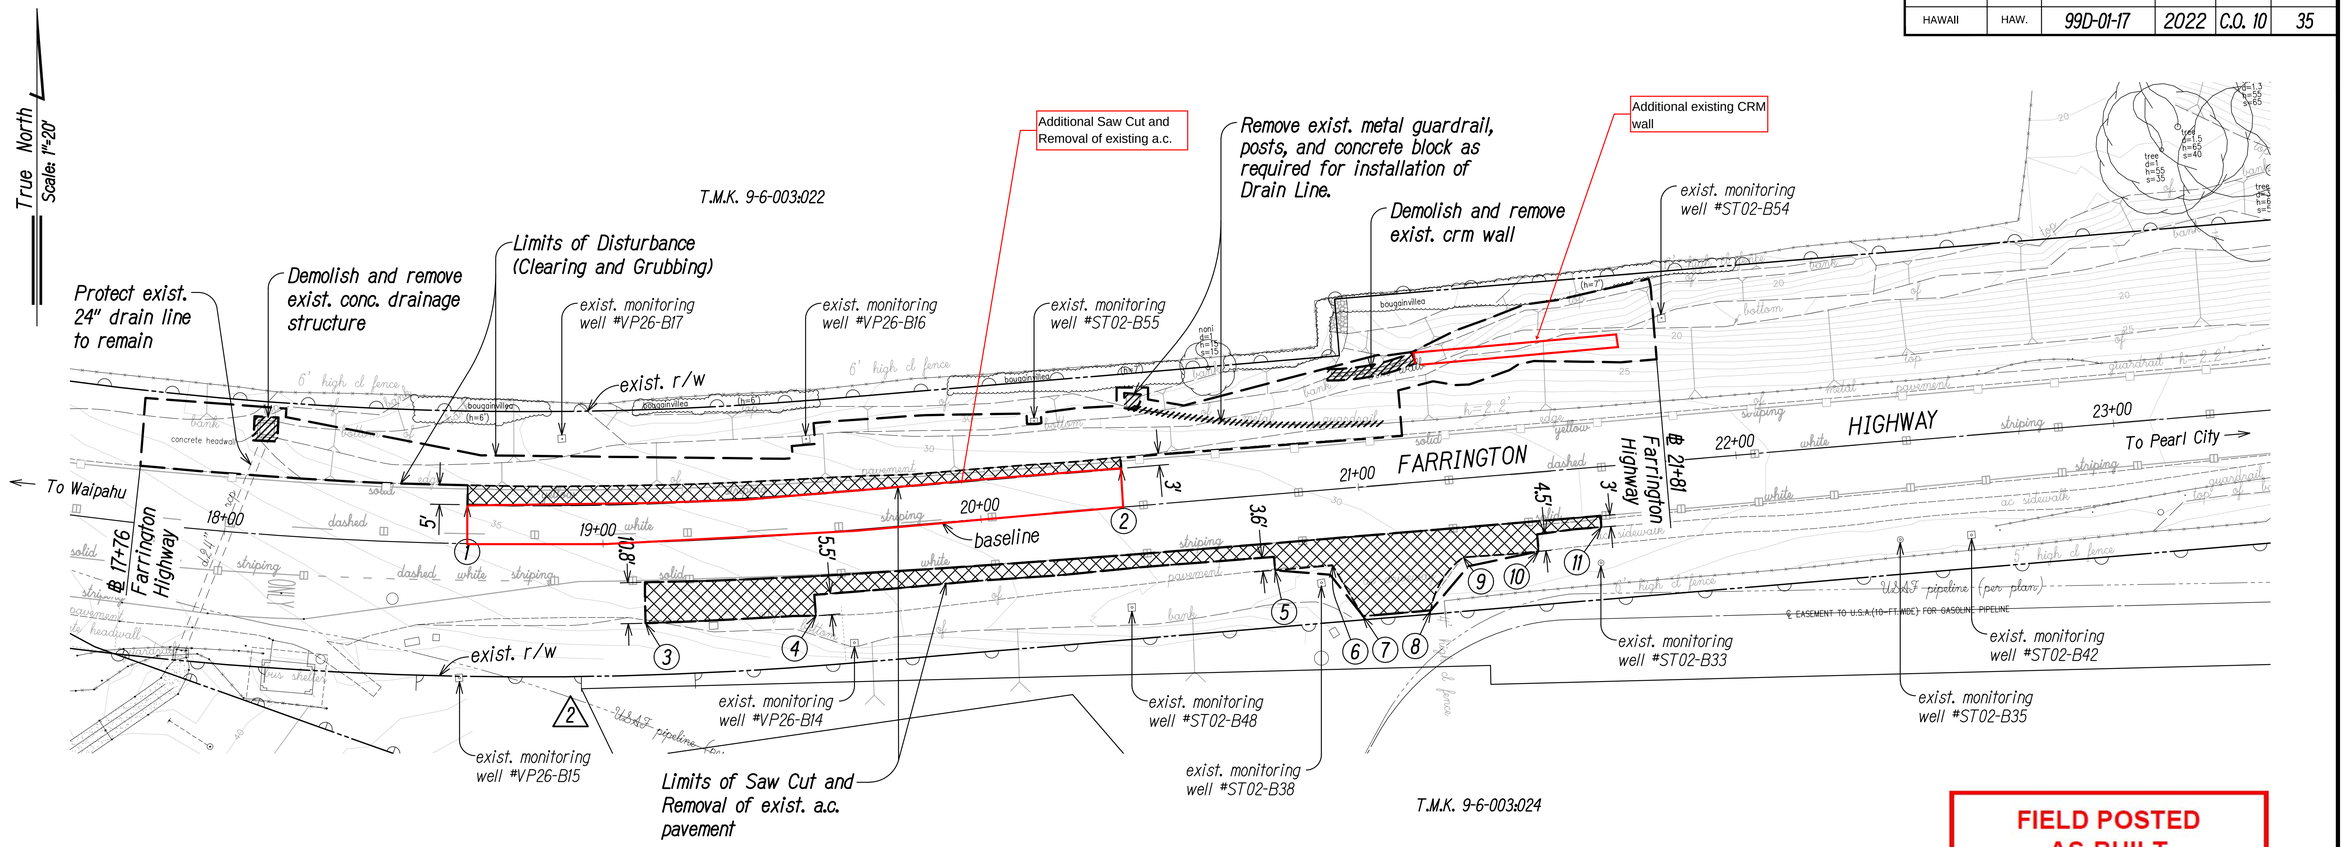

Notes:

1. The Contractor shall notify Mr. Clint Zenigami (Ph. No. 808-471-4610) of NAVFAC Hawaii, EV3, RPM at least fourteen (14) calendar days prior to the start of any work in the vicinity of the existing monitoring wells.
2. The Contractor shall protect all existing monitoring wells to remain.
3. No section where guardrails have been removed shall be left unshielded at the end of each work day. Open sections shall be shielded by portable physical barriers. Furnishing, installing, and maintaining physical barriers shall be considered incidental to the various contract items.
4. The exact locations and limits of areas to be excavated, reconstructed, and paved shall be located in the field by the Contractor and accepted by the Engineer. The Contractor shall provide drawings showing the location and outlines of the repair areas. The total area and volume calculations of paving, and repairs shall be calculated and provided to the Engineer. The Contractor shall not begin any work until the Engineer verifies and accepts the location and size of the repair area.
5. The Contractor shall remove and dispose of existing concrete blocks and boulders within the Limits of Disturbance (Clearing and Grubbing) as directed by the Engineer. Costs shall be included in lump sum Pay Item No. 202.0500, Removal of Existing Concrete Blocks and Boulders and shall not be paid for separately.

DEMOLITION PLAN

Scale: 1" = 20'

Construction Disturbance Area:	0.19 acres
Staging and Stockpiling Area:	0.23 acres
Total Ground Disturbance Area:	0.42 acres

2

1. ℄ 18+64 (o/s 10.3' Lt.) Farrington Hwy
2. ℄ 20+38 (o/s 10.3' Lt.) Farrington Hwy
3. ℄ 19+10.5 (o/s 21.3' Rt.) Farrington Hwy
4. ℄ 19+54.6 (o/s 21.8' Rt.) Farrington Hwy
5. ℄ 20+76.2 (o/s 20.0' Rt.) Farrington Hwy
6. ℄ 20+91.5 (o/s 20.0' Rt.) Farrington Hwy
7. ℄ 20+98.3 (o/s 34.0' Rt.) Farrington Hwy
8. ℄ 21+16.3 (o/s 34.0' Rt.) Farrington Hwy
9. ℄ 21+26 (o/s 20.8' Rt.) Farrington Hwy
10. ℄ 21+45.9 (o/s 20.9' Rt.) Farrington Hwy
11. ℄ 21+63 (o/s 15.9' Rt.) Farrington Hwy

FIELD POSTED AS-BUILT

Certified By: Sam Ramos, Project Engineer, Integrated Construction, Inc.

Date: November 30, 2022

RUSSELL M. ARAKAKI LICENSED PROFESSIONAL ENGINEER No. 8297-C HAWAII, U.S.A.

THIS WORK WAS PREPARED BY ME OR UNDER MY SUPERVISION.

ParEn, Inc. dba PARK ENGINEERING — APRIL 30, 2022 LIC. EXP. DATE

ORIGINAL PLAN	SURVEY PLOTTED BY	DATE
NOTE BOOK	DRAWN BY	
No.	TRACED BY	
	DESIGNED BY	
	QUANTITIES BY	
	CHECKED BY	

DATE	REVISION
2 03/07/22	Revised Limits of A.C. Demolition Work along Right Shoulder.

STATE OF HAWAI'I
DEPARTMENT OF TRANSPORTATION
HIGHWAYS DIVISION

DEMOLITION PLAN

FARRINGTON HIGHWAY
Drainage Improvements
Vicinity of Leeward Community College
PROJECT NO. 99D-01-17

Scale: As Shown Date: June 2021

SHEET No. DM1 OF DM1 SHEETS

"AS-BUILT"

C.O. 10