FED. ROAD DIST. NO.	STATE	PROJ. NO.	FISCAL YEAR	SHEET NO.	TOTAL SHEETS
HAWAII	HAW.	90BC-01-76M	1976	1	10

INDEX TO DRAWINGS

SHEET NO.	DESCRIPTION
1	TITLE SHEET
2	TYPICAL SECTION
3-7	PLAN
8	PAVEMENT MARKING DETAILS
9	STANDARD DETAILS
10	SURVEY MONUMENTS DETAILS

STATE OF HAWAII

DEPARTMENT OF TRANSPORTATION
HIGHWAYS DIVISION

HONOLULU, HAWAII

"AS BUILT"
PLANS FOR

KAMEHAMEHA HIGHWAY RESURFACING

HALAWA STREAM TO HEKAHA STREET

PROJECT NO. 90BC-01-76M

DISTRICT OF EWA
ISLAND OF OAHU

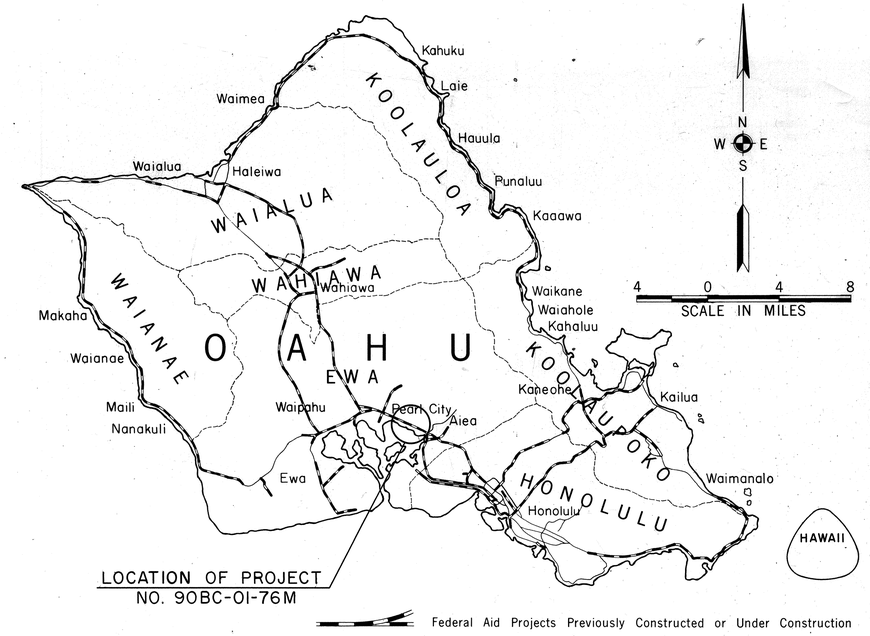

Federal Aid Projects Previously Constructed or Under Construction

ALL CHANGES MADE DURING CONSTRUCTION HAVE BEEN INCORPORATED ON THESE PLANS (IN RED), EXCEPT CHANGES IN THE ORIGINAL THEORETICAL QUANTITES. FOR ACTUAL QUANTITIES REFER TO PROJECT LEDGER AND/OR COMPUTATION BOOK.

PROJECT ENGINEER — DATE 12/6/81

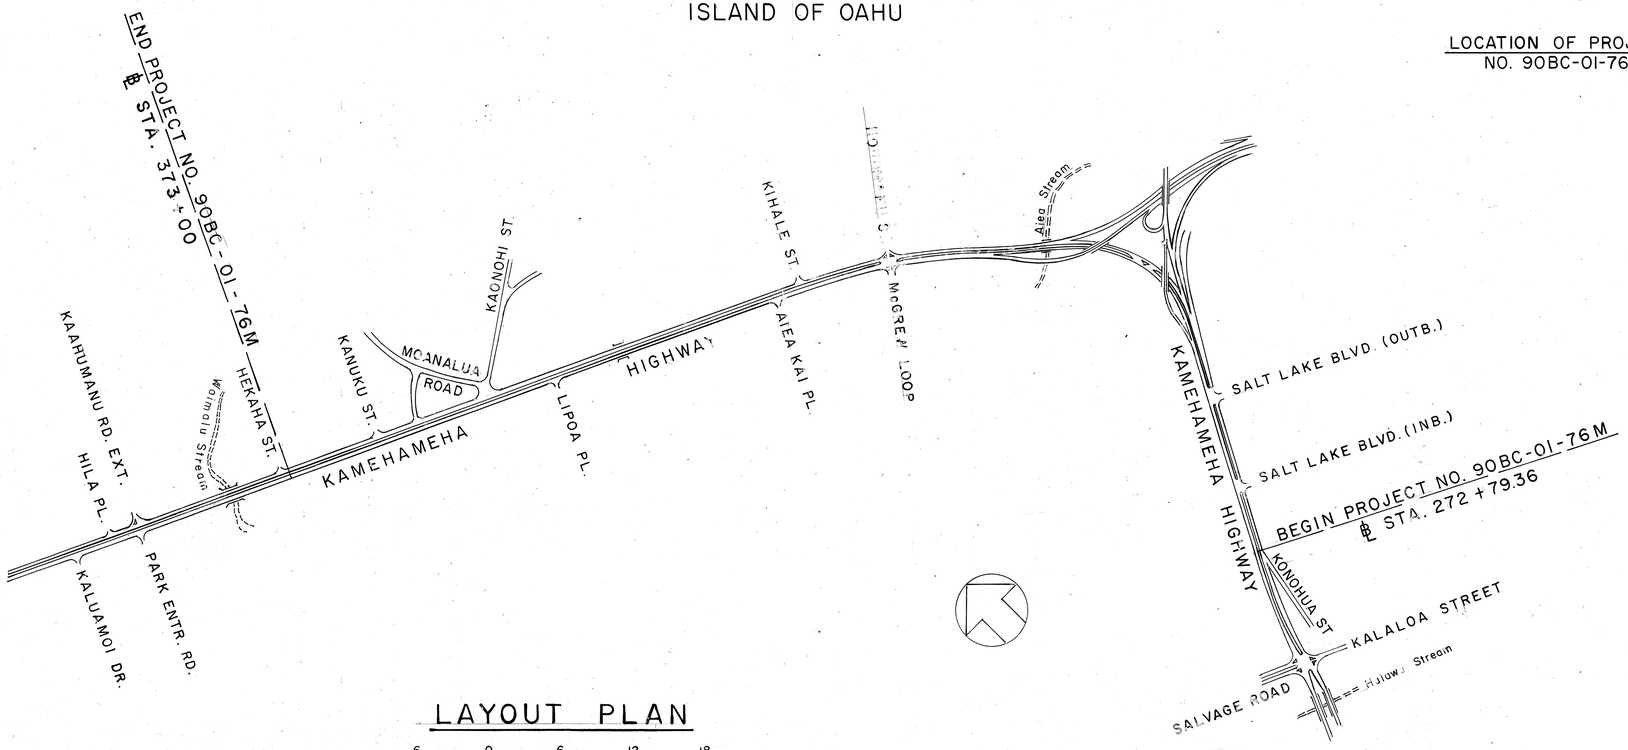

LAYOUT PLAN

6 0 6 12 18
SCALE IN HUNDRED FEET

GROSS LENGTH OF PROJECT 1.898 Miles

DESIGNED BY — P. S. & E. BY: R. Mikami — PHONE: 548-7534 — DATE

DEPARTMENT OF TRANSPORTATION
STATE OF HAWAII

APPROVED: R. Higashionna 5/5/76
for DIR. OF TRANSPORTATION — DATE