FED. ROAD DIST. NO.	STATE	PROJ. NO.	FISCAL YEAR	SHEET NO.	TOTAL SHEETS
HAWAII	HAW.	99C-01-78M	1978	1	17

INDEX TO DRAWINGS

SHEET NO.	DESCRIPTION
1	TITLE SHEET
2 - 3	TYPICAL SECTIONS
4 - 14	PLANS
15 - 17	STANDARD DETAILS

STATE OF HAWAII

DEPARTMENT OF TRANSPORTATION

LAND TRANSPORTATION FACILITIES DIVISION

HONOLULU, HAWAII

AS-BUILT PLANS FOR

KAMEHAMEHA HIGHWAY RESURFACING

CRESTVIEW TO WAHIAWA

PROJECT NO. 99C-01-78M

DISTRICT OF EWA & WAHIAWA
ISLAND OF OAHU

ALL CHANGES MADE DURING CONSTRUCTION HAVE BEEN INCORPORATED ON THESE PLANS IN RED, EXCEPT CHANGES IN THE ORIGINAL THEORETICAL QUANTITIES, REFER TO PROJECT LEDGER AND/OR COMPUTATION BOOK.

Garret R. Ohada — Oct. 5, 1979
RESIDENT ENGINEER — DATE

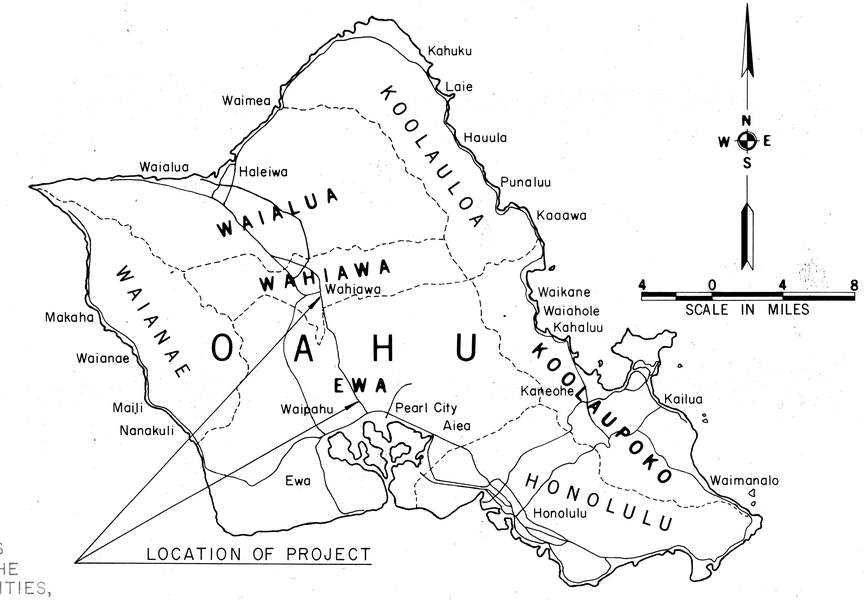

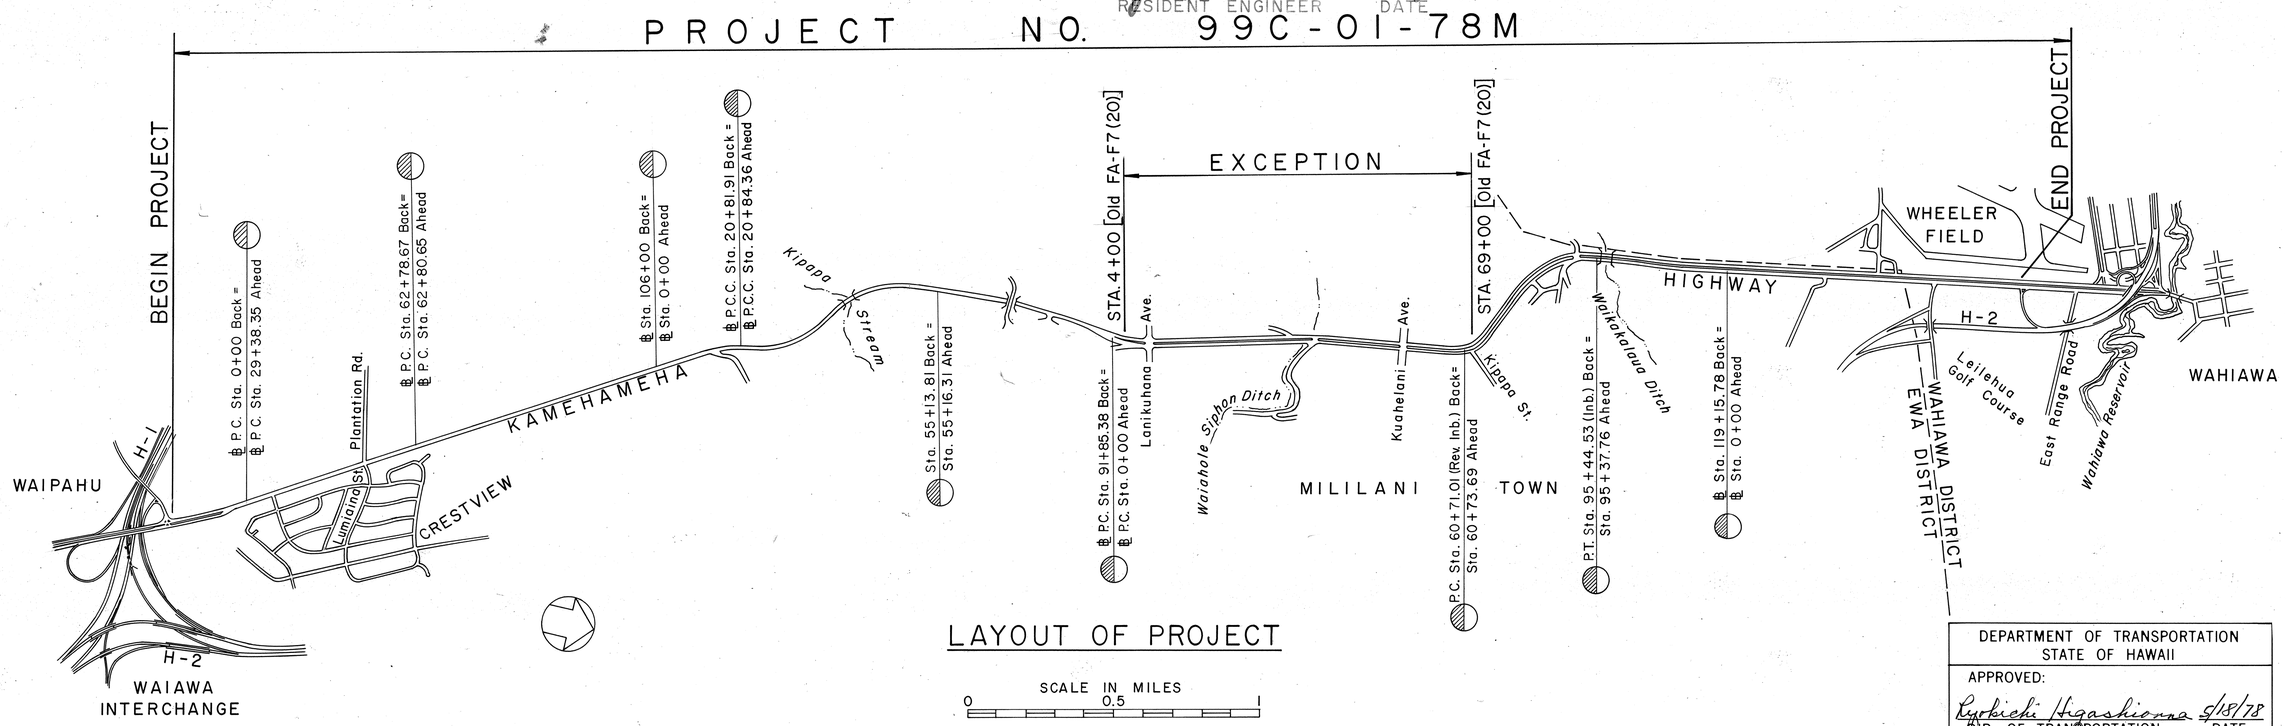

LAYOUT OF PROJECT

DESIGN UNIT "E"	D. BEVIER	548-7537	MAY 11, 1978
DESIGNED BY	P. S. & E. BY	PHONE	DATE

DEPARTMENT OF TRANSPORTATION
STATE OF HAWAII

APPROVED:

Kyoshi Higashionna — 5/18/78
DIR. OF TRANSPORTATION — DATE