FED. ROAD DIST. NO.	STATE	PROJ. NO.	FISCAL YEAR	SHEET NO.	TOTAL SHEETS
HAWAII	HAW.	99C-01-79M LT-0-03-79M	1978	1	8

INDEX TO DRAWINGS

SHEET NO.	DESCRIPTION
1	TITLE SHEET
2-3	TYPICAL SECTIONS, GENERAL NOTES AND SCHEDULE OF RECONSTRUCTION
4-8	STANDARD DETAILS

STATE OF HAWAII

DEPARTMENT OF TRANSPORTATION

LAND TRANSPORTATION FACILITIES DIVISION

"AS-BUILT" PLANS FOR

WILIKINA DRIVE RESURFACING

KAMEHAMEHA HIGHWAY (BEGINNING OF H-2 FREEWAY)
TO KAMANANUI ROAD

PROJECT NO. 99C-01-79M

DISTRICT OF WAHIAWA
ISLAND OF OAHU

AND

KAMEHAMEHA HIGHWAY RESURFACING

WEED JUNCTION TOWARDS WAHIAWA

PROJECT NO. LT-0-03-79M

DISTRICT OF WAIALUA
ISLAND OF OAHU

ALL CHANGES MADE DURING CONSTRUCTION HAVE BEEN INCORPORATED ON THESE PLANS IN RED, EXCEPT CHANGES IN THE ORIGINAL THEORETICAL QUANTITIES, REFER TO PROJECT LEDGER AND/OR COMPUTATION BOOK.

Gerald S. Okada
RESIDENT ENGINEER

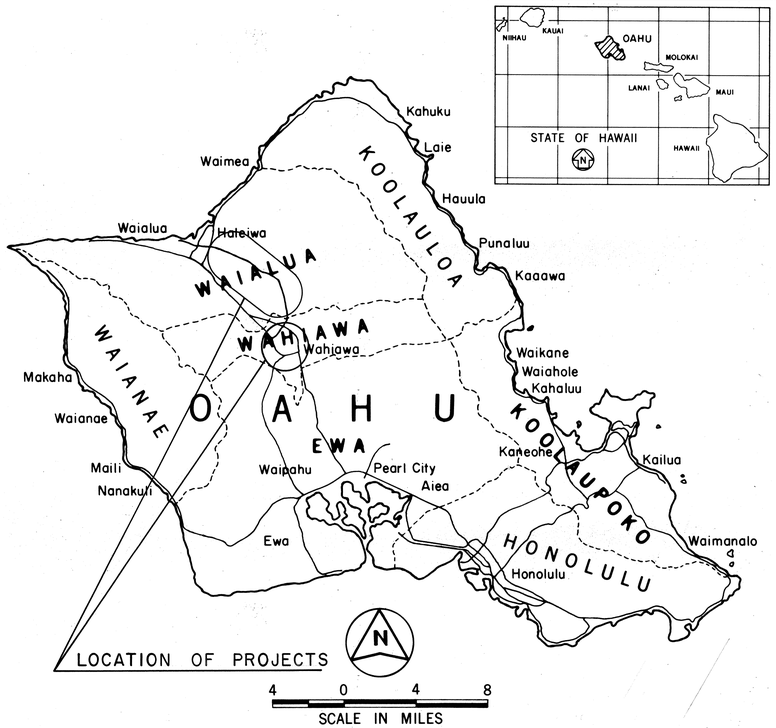

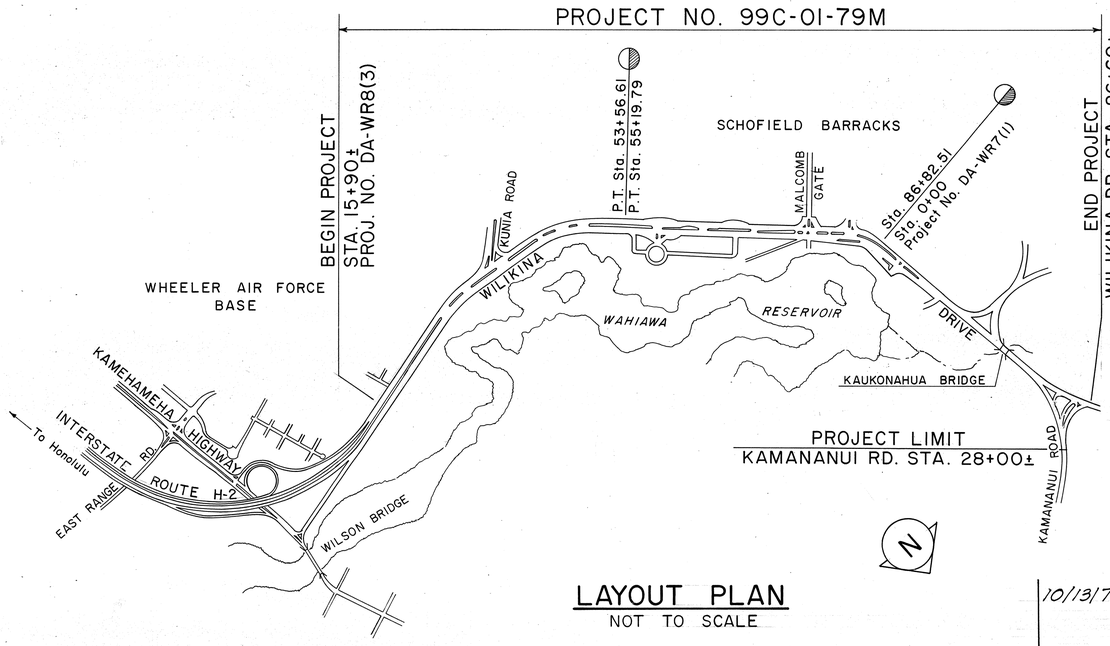

LAYOUT PLAN
NOT TO SCALE

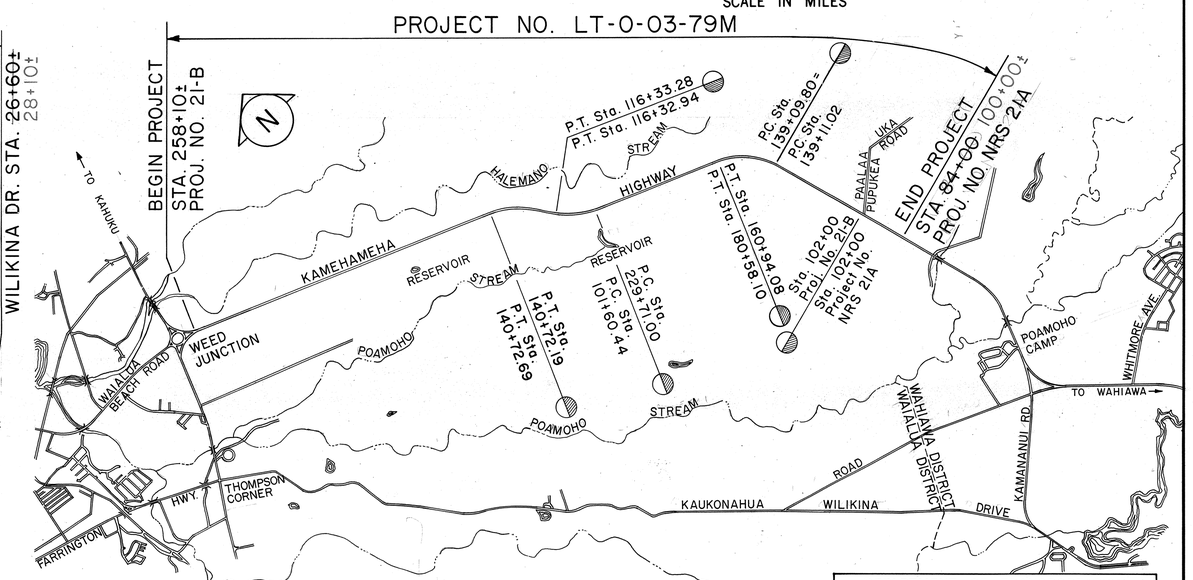

LAYOUT PLAN
NOT TO SCALE

DATE	REVISION
10/13/78	Increased scope of work by extending project length to Sta. 84+00 towards Wahiawa per Subsection 104.09 – Availability of Funds of the Special Provisions.

DEPARTMENT OF TRANSPORTATION
STATE OF HAWAII

APPROVED:
Ryokichi Higashionna 8/28/78
DIR. OF TRANSPORTATION DATE

DESIGN UNIT "E"	D. BEVIER	548-7537	AUG. 28, 1978
DESIGNED BY	P. S. & E. BY	PHONE	DATE

6137-2/22
6161-2/22

D-8-1

1 R