FED. ROAD DIST. NO.	STATE	PROJ. NO.	FISCAL YEAR	SHEET NO.	TOTAL SHEETS
HAWAII	HAW.	99D-01-79	1980	1	19

INDEX TO DRAWINGS

SHEET NO.	DESCRIPTION
1	TITLE SHEET
2	GENERAL NOTES & LEGEND
3	TRAFFIC SIGNAL SYSTEM
4	PAVEMENT MARKINGS, SIGNING & UTILITIES
5-19	MISCELLANEOUS, TYPICAL & STANDARD DETAILS

STATE OF HAWAII

DEPARTMENT OF TRANSPORTATION

HIGHWAYS DIVISION

"AS BUILT"

PLANS FOR

INSTALLATION OF TRAFFIC SIGNALS ON KAMEHAMEHA HWY. AT ACACIA ROAD

PROJECT NO. 99D-01-79

DISTRICT OF EWA

ISLAND OF OAHU

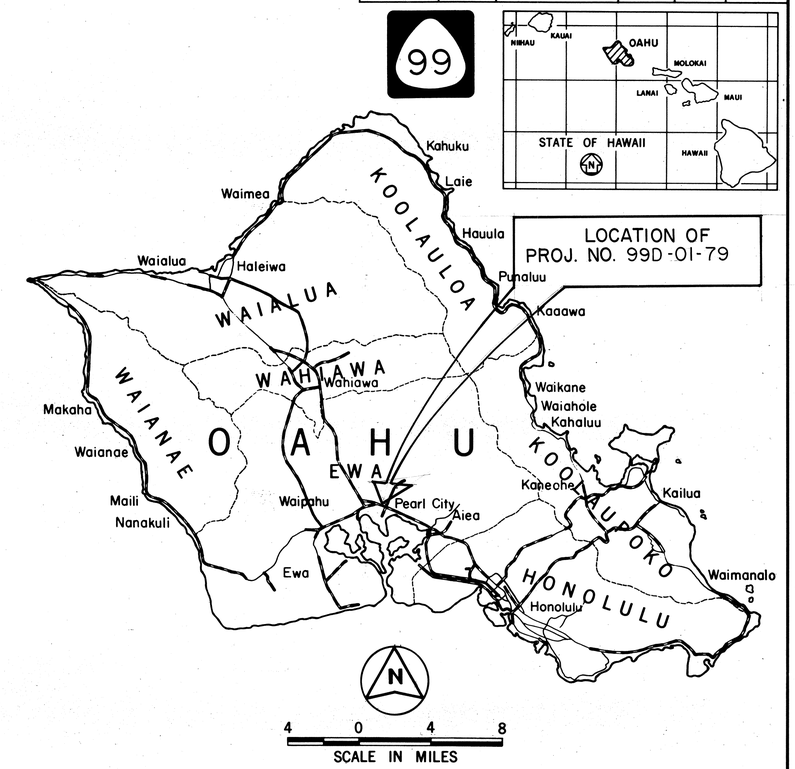

FEDERAL AID PROJECTS PREVIOUSLY CONSTRUCTED OR UNDER CONSTRUCTION

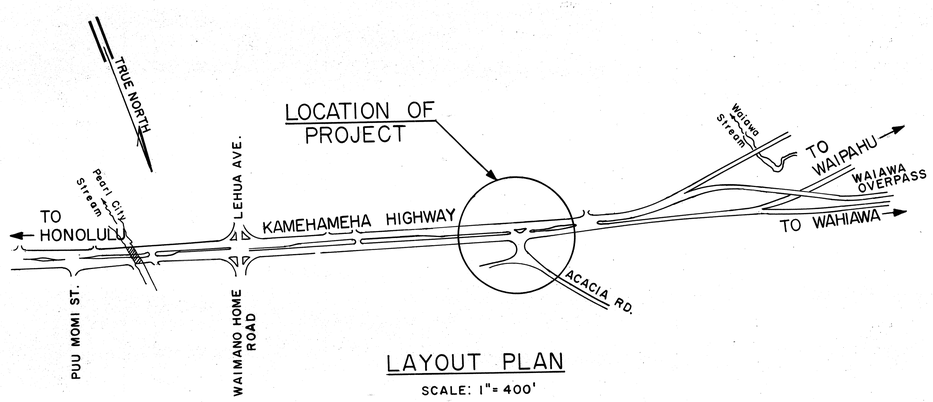

LAYOUT PLAN

SCALE: 1" = 400'

ALL CHANGES MADE DURING CONSTRUCTION HAVE BEEN INCORPORATED ON THESE PLANS EXCEPT CHANGES IN THE ORIGINAL THEORETICAL QUANTITIES

PROJECT ENGINEER — 12-3-81 DATE

DEPARTMENT OF TRANSPORTATION
STATE OF HAWAII

APPROVED: Ryoichi Higashiuma — May 8, 1980

DIR. OF TRANSPORTATION — DATE

LT-DT — DESIGNED BY

A. Yamaguchi — P. S. & E. BY

548-7537 — PHONE

May 8, 1980 — DATE

0.6-8 2290-2122