FED. ROAD DIST. NO.	STATE	PROJ. NO.	FISCAL YEAR	SHEET NO.	TOTAL SHEETS
HAWAII	HAW.	99 C-01-90	1990	1	49

INDEX TO DRAWINGS

SHEET NO.	DESCRIPTION
1	TITLE SHEET
2	STANDARD PLANS SUMMARY SHEET
3	GENERAL NOTES & BORING LOG
4	TYPICAL ROAD SECTIONS
5 - 8	KAMEHAMEHA HWY. PLAN & PROFILE
9 & 10	SURVEY CONTROLS
11 - 15	CONSTRUCTION PHASING & DETOUR PLAN
16	LUMIAUAU & LUMIAINA INTERS. DETAILS
17	LUMIAUAU & LUMIAINA INTERS. GRADES
18	WATER NOTES & MISCELLANEOUS DETAILS
19	GUARDRAIL IMPROVEMENTS
20 & 21	DRAINAGE DETAILS
22	DRAINLINE PROFILES
23 & 24	BARRIER WALL DETAILS
25 & 26	ROADWAY SIGNS & PAVEMENT MARKINGS
27 - 43	ELECTRICAL PLANS
44 - 49	KAMEHAMEHA HWY. CROSS-SECTIONS

STATE OF HAWAII

DEPARTMENT OF TRANSPORTATION

HIGHWAYS DIVISION

HONOLULU, HAWAII

"AS-BUILT"

PLANS OF

KAMEHAMEHA HIGHWAY WIDENING

PROJECT NO. 99 C-01-90

DISTRICT OF EWA

ISLAND OF OAHU

SCALES:

PLAN & PROFILE	HOR.	1" = 40'
	VER.	1" = 4'
CROSS SECTIONS	HOR.	1" = 10'
	VER.	1" = 5'

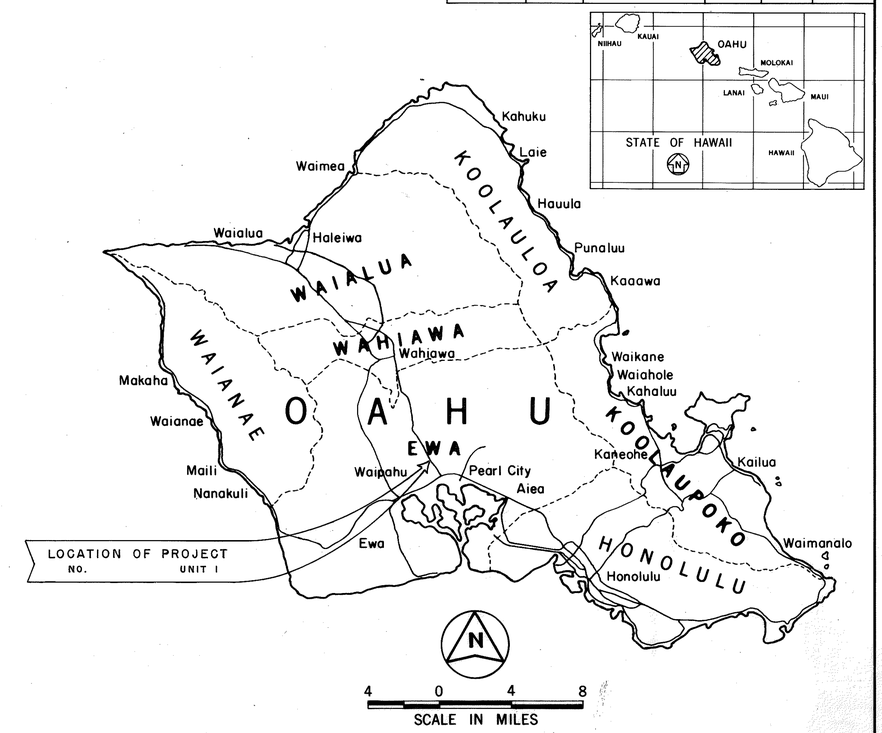

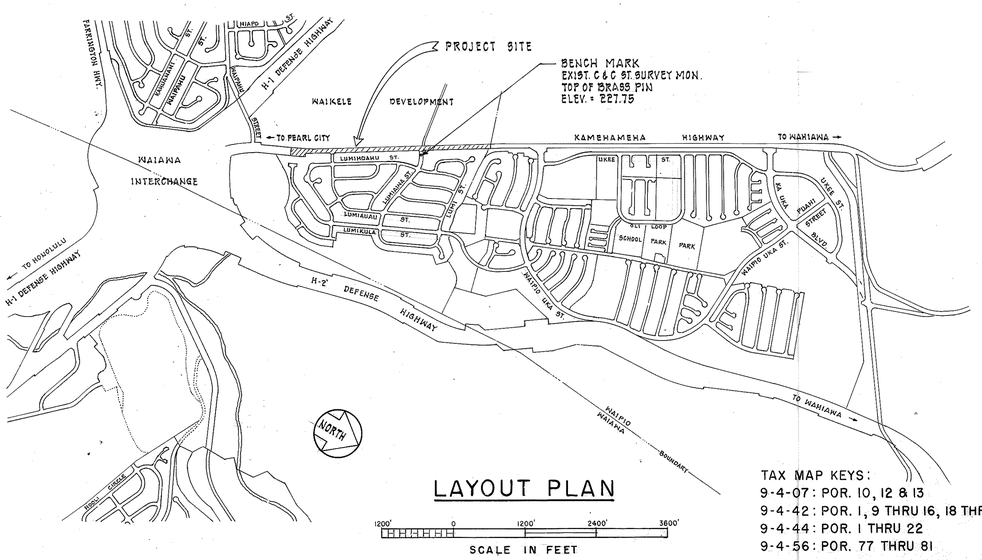

LAYOUT PLAN

TAX MAP KEYS:
9-4-07: POR. 10, 12 & 13
9-4-42: POR. 1, 9 THRU 16, 18 THRU 21
9-4-44: POR. 1 THRU 22
9-4-56: POR. 77 THRU 81

CHANGES MADE DURING CONSTRUCTION HAVE BEEN INCORPORATED ON THESE PLANS EXCEPT CHANGES IN THE ORIGINAL THEORETICAL QUANTITIES. FOR ACTUAL QUANTITIES, REFER TO PROJECT LEDGER AND/OR COMPUTATION BOOK.

Mary Shimose - Insp III — 04/22/96
RESIDENT ENGINEER (PERMIT PROJECT) — DATE

RECORD DRAWING TRACINGS

CERTIFIED BY: Bernard C. P. Hong, ROYAL CONTRACTING CO. LTD. LIC. NO. ABC 8310 DATE: 9/5/91

SUBMITTED BY: Bernard D. Lee, COMMUNITY PLANNING, INC. DATE: 10/11/91

APPROVED BY: _____ DATE: _____

DESIGN DESIGNATION

DESIGN ADT (2008)	58,000
DHV	3,750
D	70/30
T	3.2 %
V	55 MPH

for [signature] — 1/10/90
CHIEF, HIGHWAYS DIVISION — DATE
STATE DEPARTMENT OF TRANSPORTATION
(APPROVAL GRANTED FOR WORK WITHIN STATE RIGHT-OF-WAY ONLY.
I.D. NO. 0-86-4. LETTER OF APPROVAL NO. HWY-CM 2.9983
DATED JANUARY 10, 1990

COMMUNITY PLANNING, INC. — DESIGNED BY — A. YAMAGUCHI, P. S. & E. — BY — 587-2235 — PHONE — NOV. 1991 — DATE

Permit No 0-86-100

Kamehameha Highway Widening

RECORD DRAWINGS