FED. ROAD DIST. NO.	STATE	FEDERAL AID PROJ. NO.	FISCAL YEAR	SHEET NO.	TOTAL SHEETS
HAWAII	HAW.	NH-099-1(11)	1993	1	11

INDEX TO DRAWINGS

SHEET NO.	DESCRIPTION
1	TITLE SHEET
2	STANDARD PLAN SUMMARY SHEET
3	GENERAL NOTES, LEGEND AND DETAILS
4	UTILITY NOTES
5	ROADWAY PLAN
6	DRAINAGE PLAN
7	DRAINAGE PROFILES
8 - 11	DRAINAGE DETAILS

STATE OF HAWAII

DEPARTMENT OF TRANSPORTATION

HIGHWAYS DIVISION

HONOLULU, HAWAII

"AS-BUILT"

PLANS FOR

KAMEHAMEHA HIGHWAY IMPROVEMENTS

PUU MOMI STREET TO KALUAMOI PLACE

FEDERAL AID PROJECT NO. NH-099-1(11)

DISTRICT OF EWA

ISLAND OF OAHU

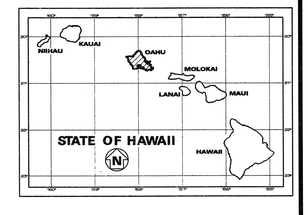

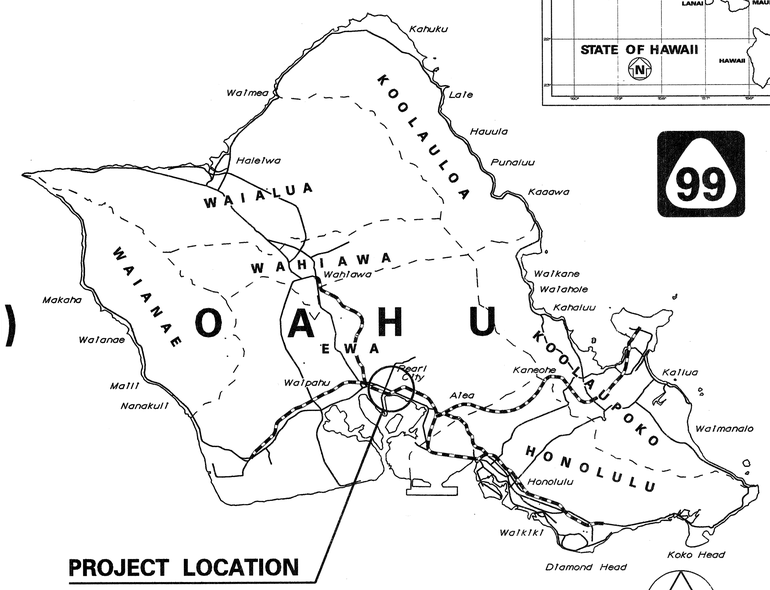

FEDERAL AID INTERSTATE PROJECTS PREVIOUSLY CONSTRUCTED OR UNDER CONSTRUCTION

MILE POST 18.77 TO MILE POST 19.61

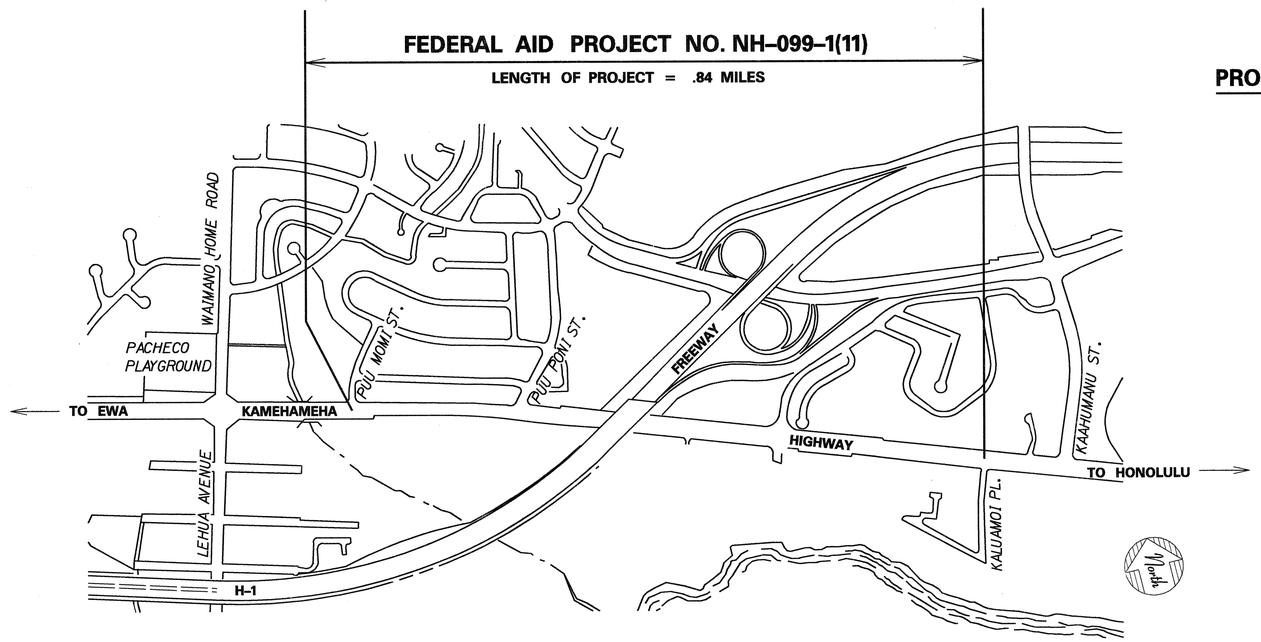

LAYOUT PLAN

DESIGN DESIGNATION

ADT (1993).....53,650
ADT (2013).....131,410
DHV 9,860
D 65/35
T .....2.5 %

CHANGES MADE DURING CONSTRUCTION HAVE BEEN INCORPORATED ON THESE PLANS EXCEPT CHANGES IN THE ORIGINAL THEORETICAL QUANTITIES. FOR ACTUAL QUANTITIES, REFER TO PROJECT LEDGER AND OR COMPUTATION BOOK.

RESIDENT ENGINEER — DATE 10/23/98

DEPARTMENT OF TRANSPORTATION
STATE OF HAWAII
APPROVED:
FOR DIR. OF TRANSPORTATION — DATE 4/23/93

HWY-DD (UNIT A)	JULIUS B. FRONDA	587-2246	Apr., 1993
DESIGNED BY	P. S. & E. BY	PHONE	DATE