
ORIGINAL PLAN	SURVEY PLOTTED BY _____ DATE _____
	DRAWN BY _____ " _____
NOTE BOOK	TRACED BY _____ " _____
	DESIGNED BY _____ " _____
No. _____	QUANTITIES BY _____ " _____
	CHECKED BY _____ " _____

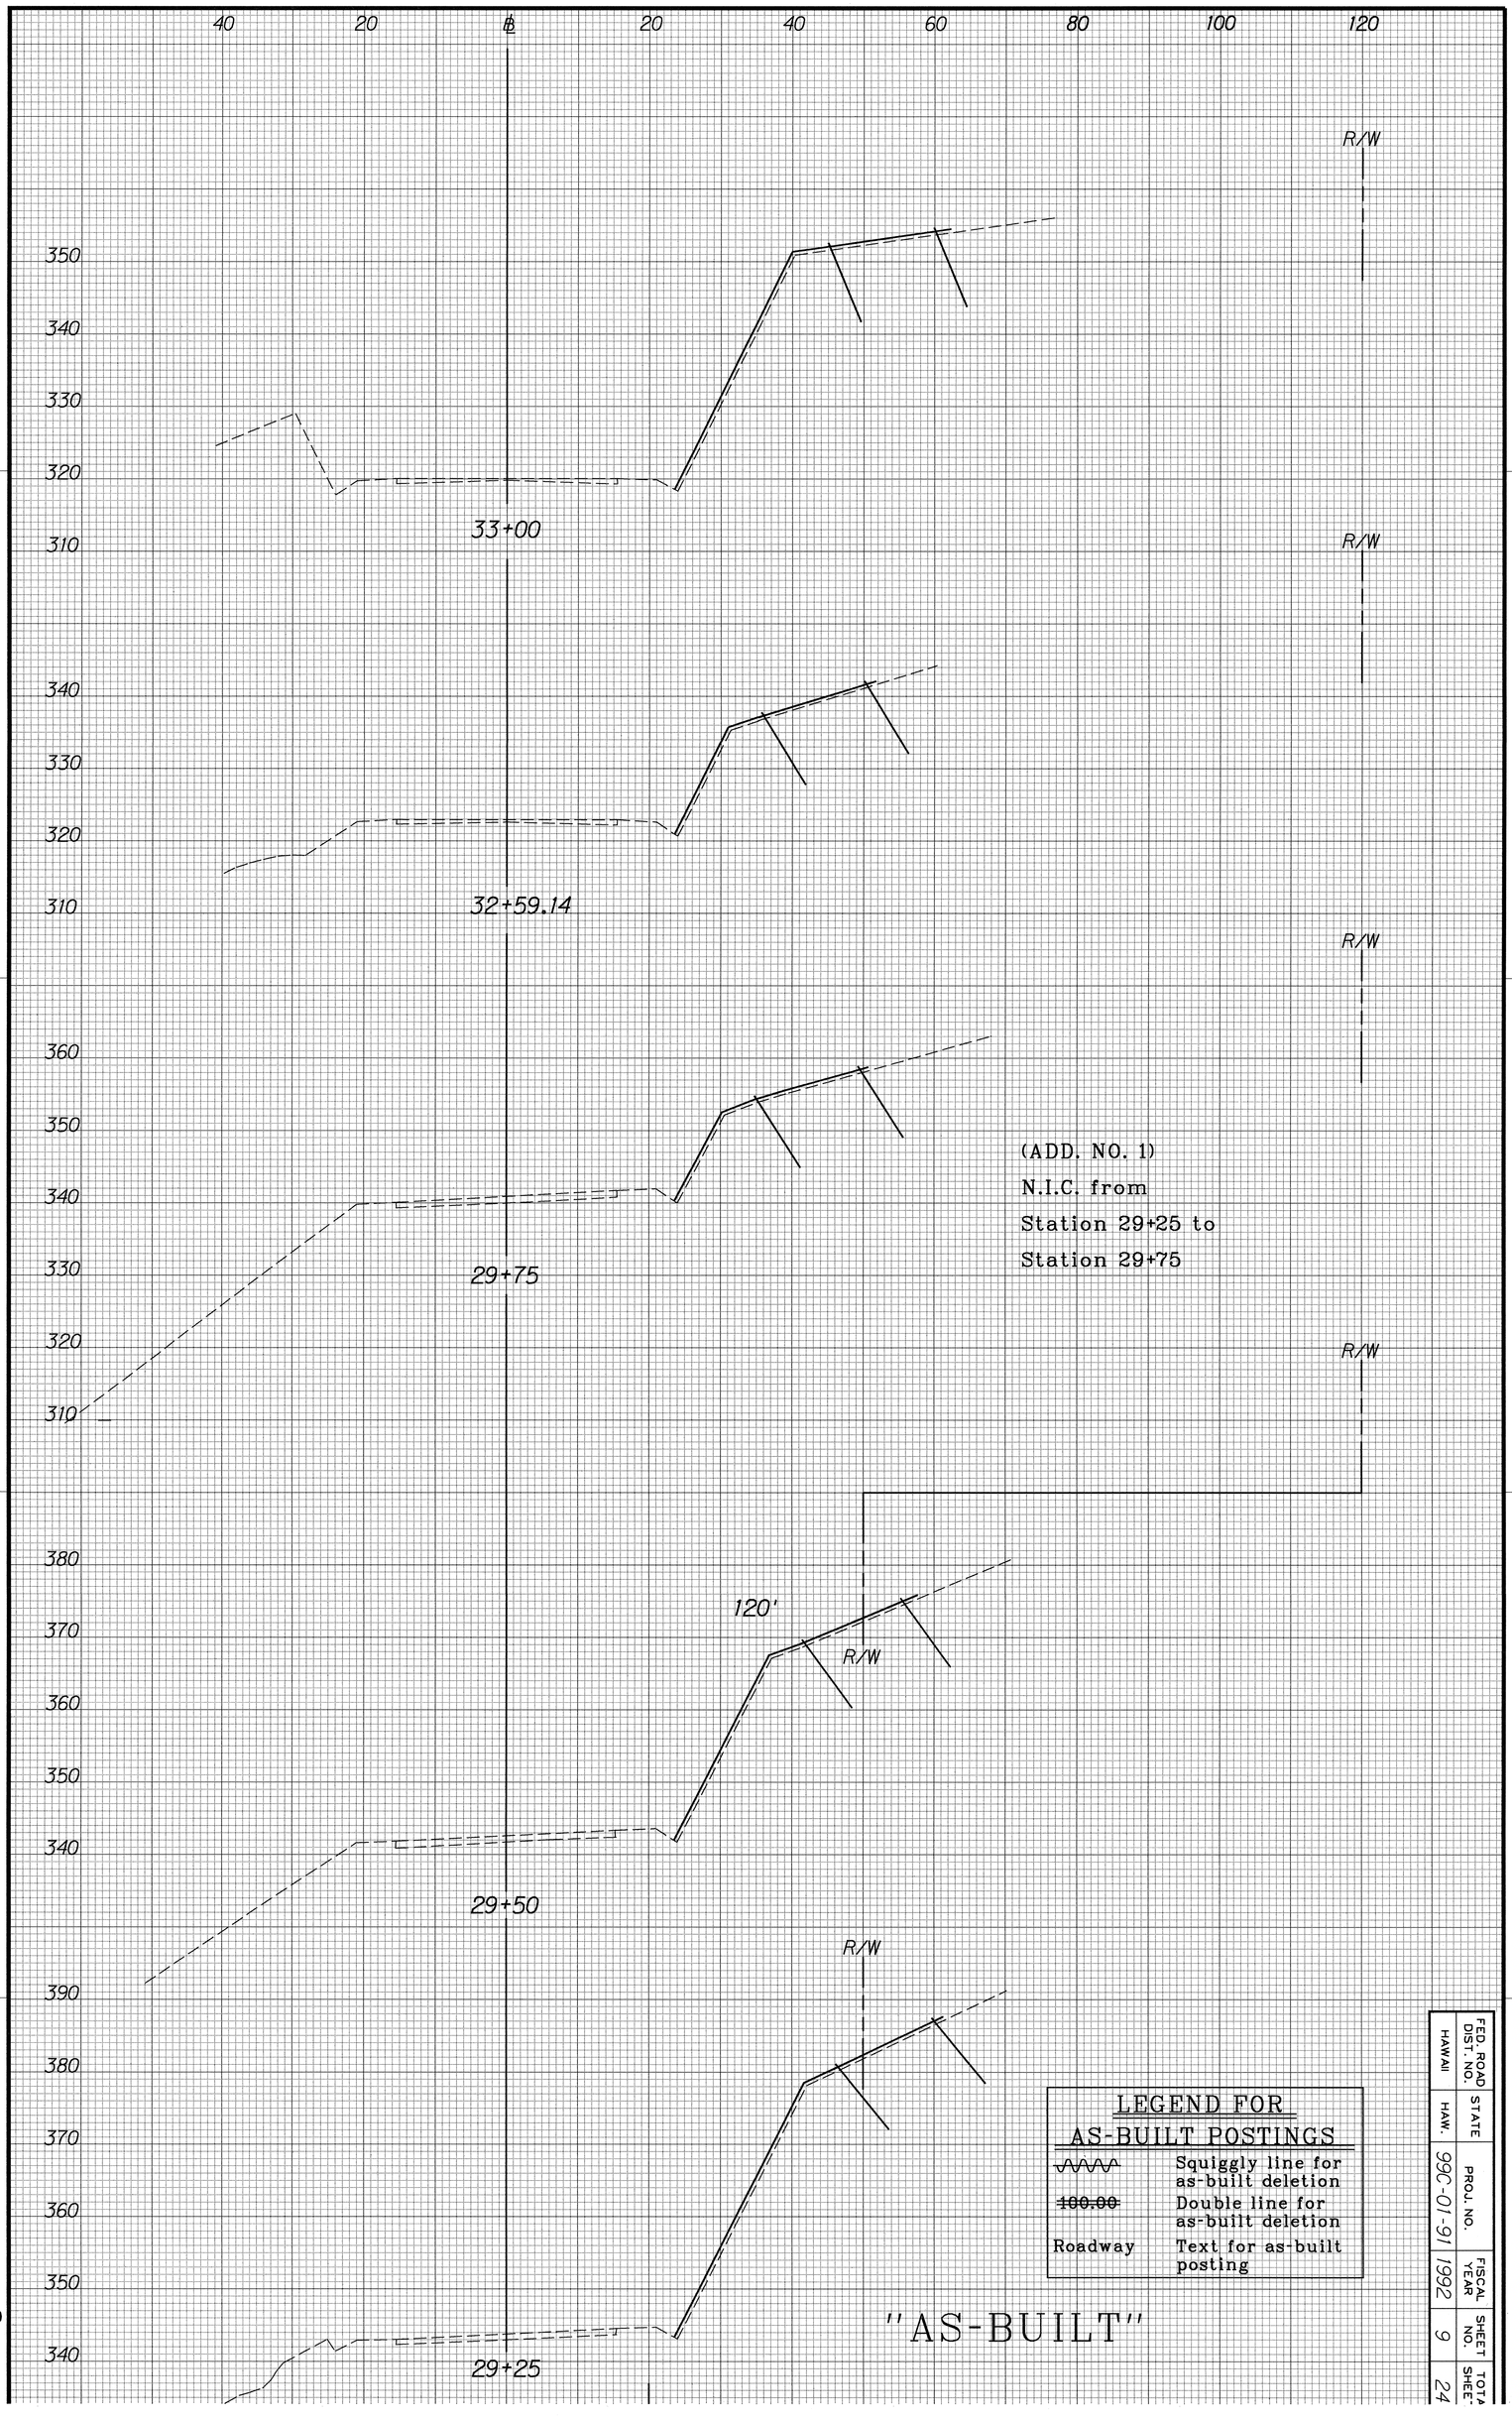

LEGEND FOR AS-BUILT POSTINGS


∿∿∿∿	Squiggly line for as-built deletion
~~100.00~~	Double line for as-built deletion
Roadway	Text for as-built posting

"AS-BUILT"

FED. ROAD DIST. NO.	STATE	PROJ. NO.	FISCAL YEAR	SHEET NO.	TOTAL SHEETS
HAWAII	HAW.	99C-01-91	1992	9	24

1kamdxs2.dgn 4/16/92


ORIGINAL PLAN	SURVEY PLOTTED BY	DATE
	DRAWN BY	
NOTE BOOK	TRACED BY	
	DESIGNED BY	
No.	QUANTITIES BY	
	CHECKED BY	

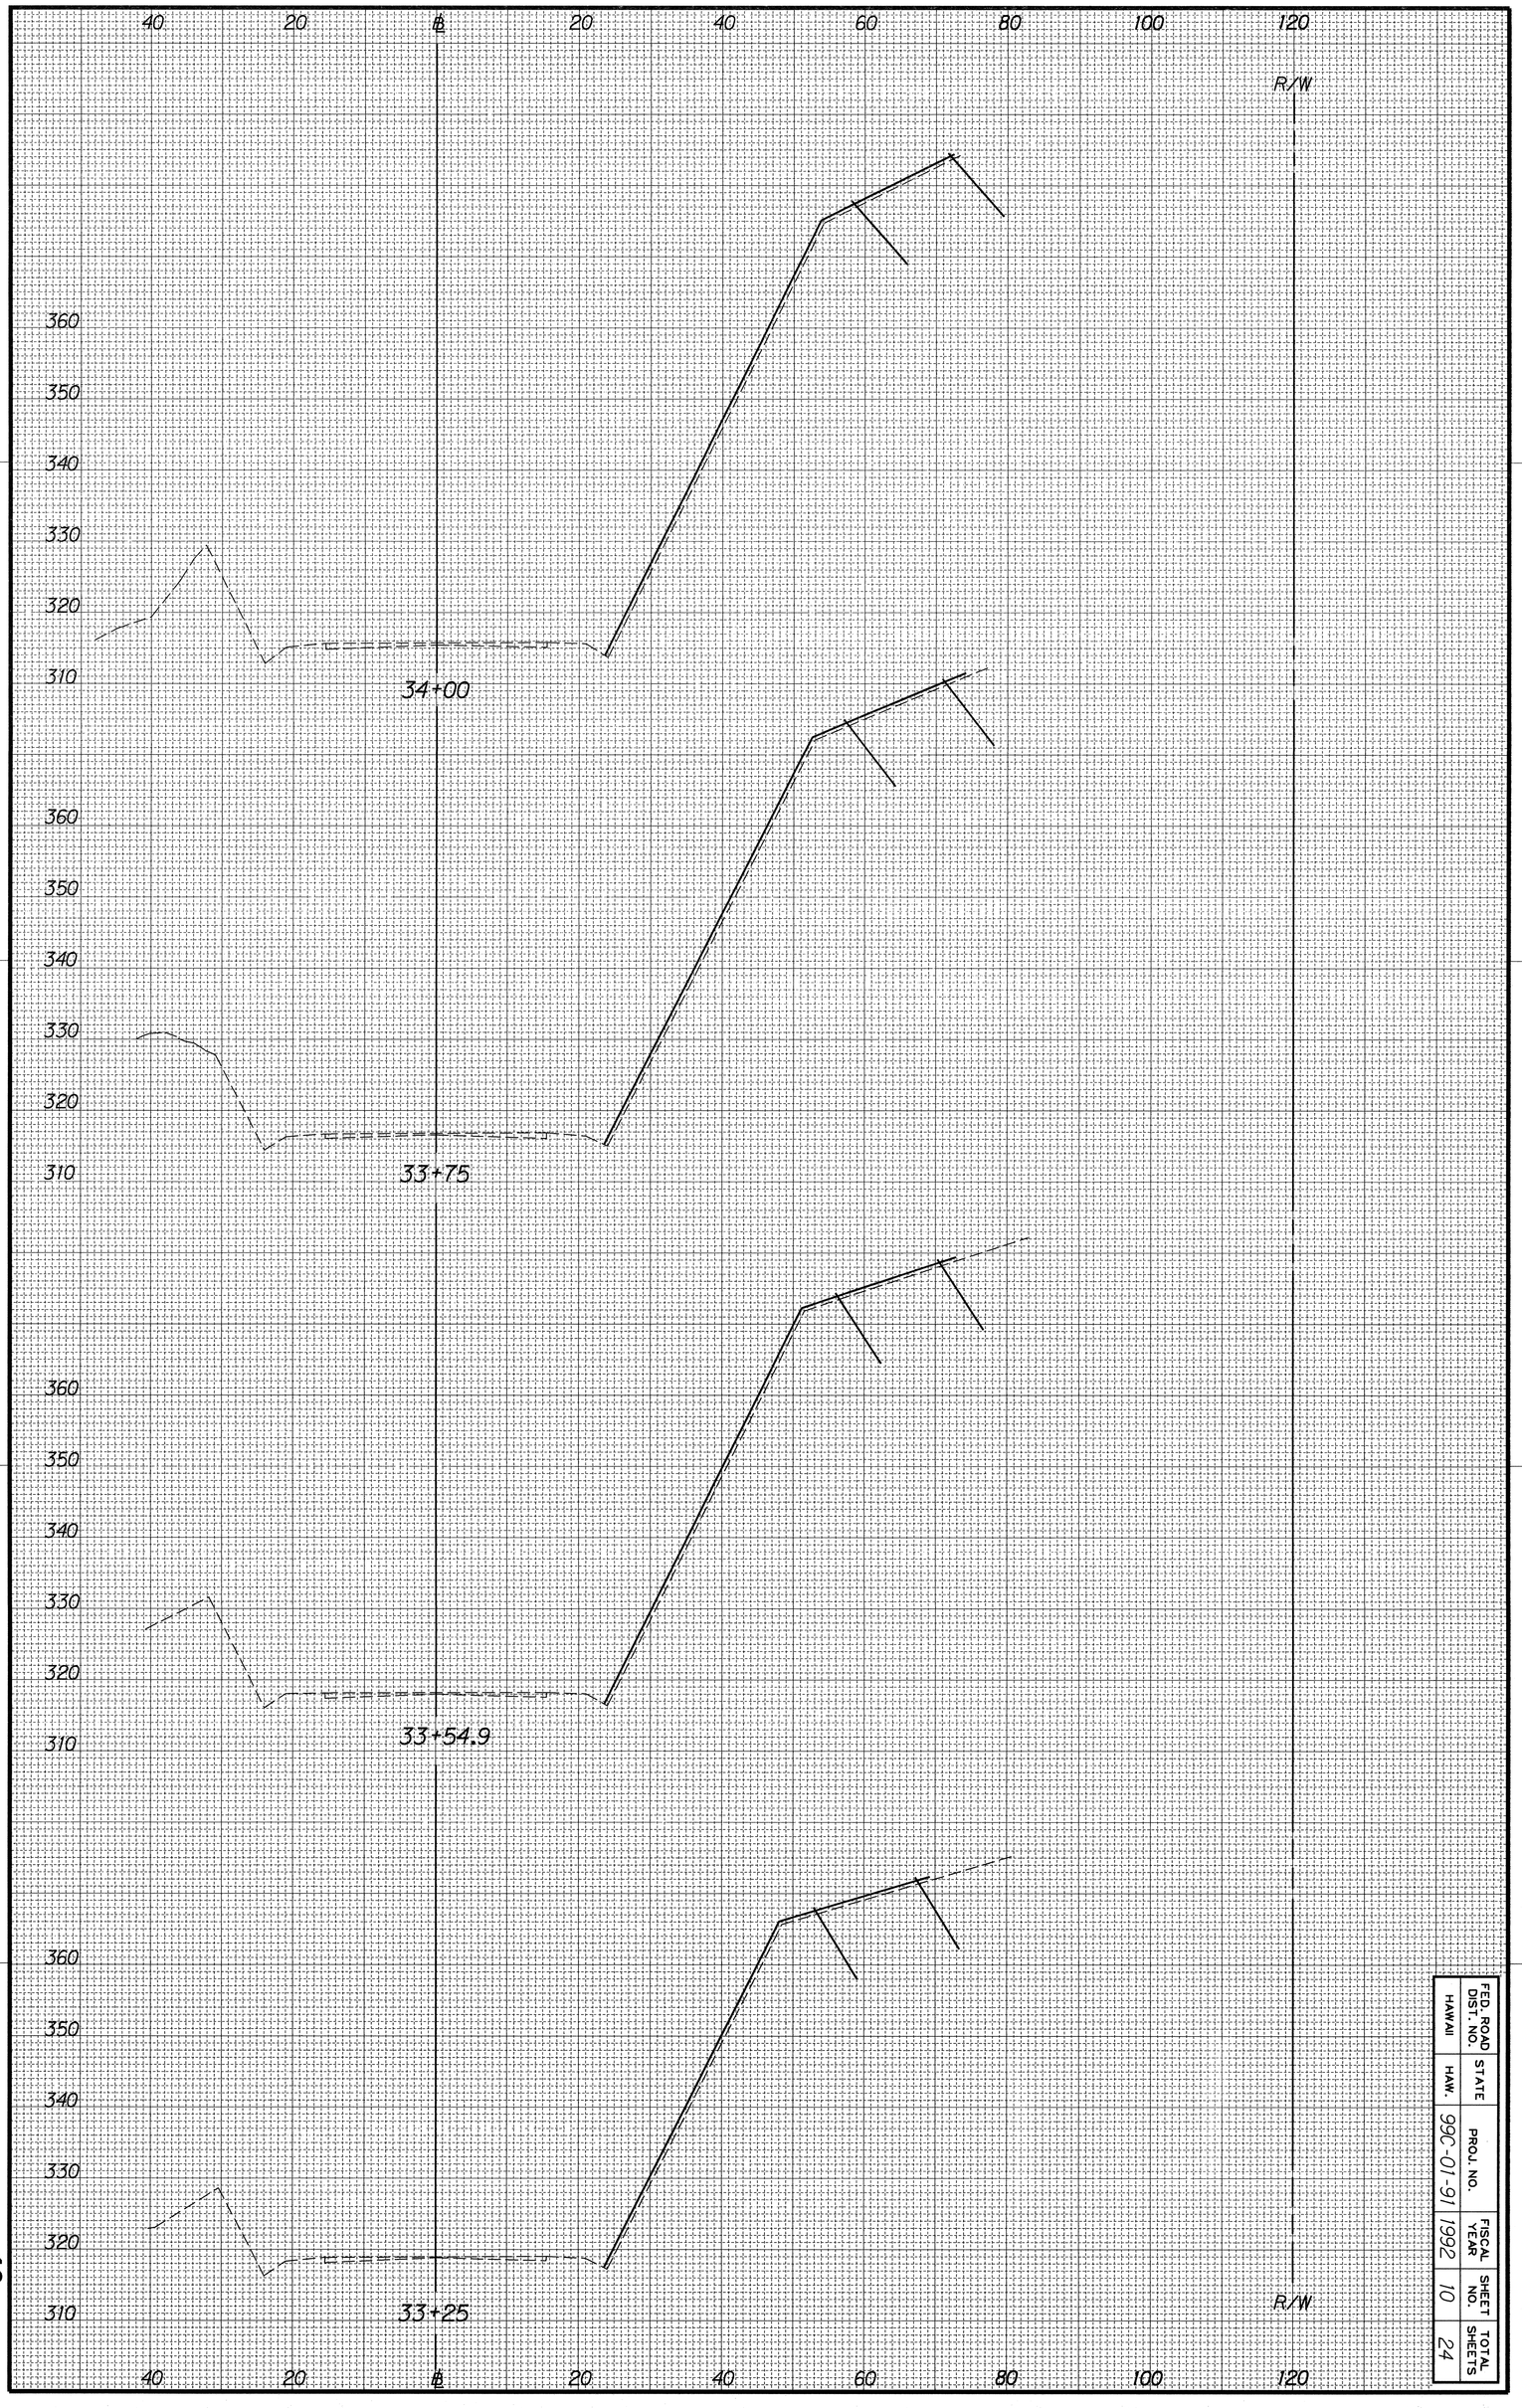

FED. ROAD DIST. NO.	STATE	PROJ. NO.	FISCAL YEAR	SHEET NO.	TOTAL SHEETS
HAWAII	HAW.	99C-01-91	1992	10	24

1kamdxs3.dgn 4/16/92

ORIGINAL PLAN	SURVEY PLOTTED BY _____ DATE _____
	DRAWN BY _____ " _____
NOTE BOOK	TRACED BY _____ " _____
	DESIGNED BY _____ " _____
No. _____	QUANTITIES BY _____ " _____
	CHECKED BY _____ " _____

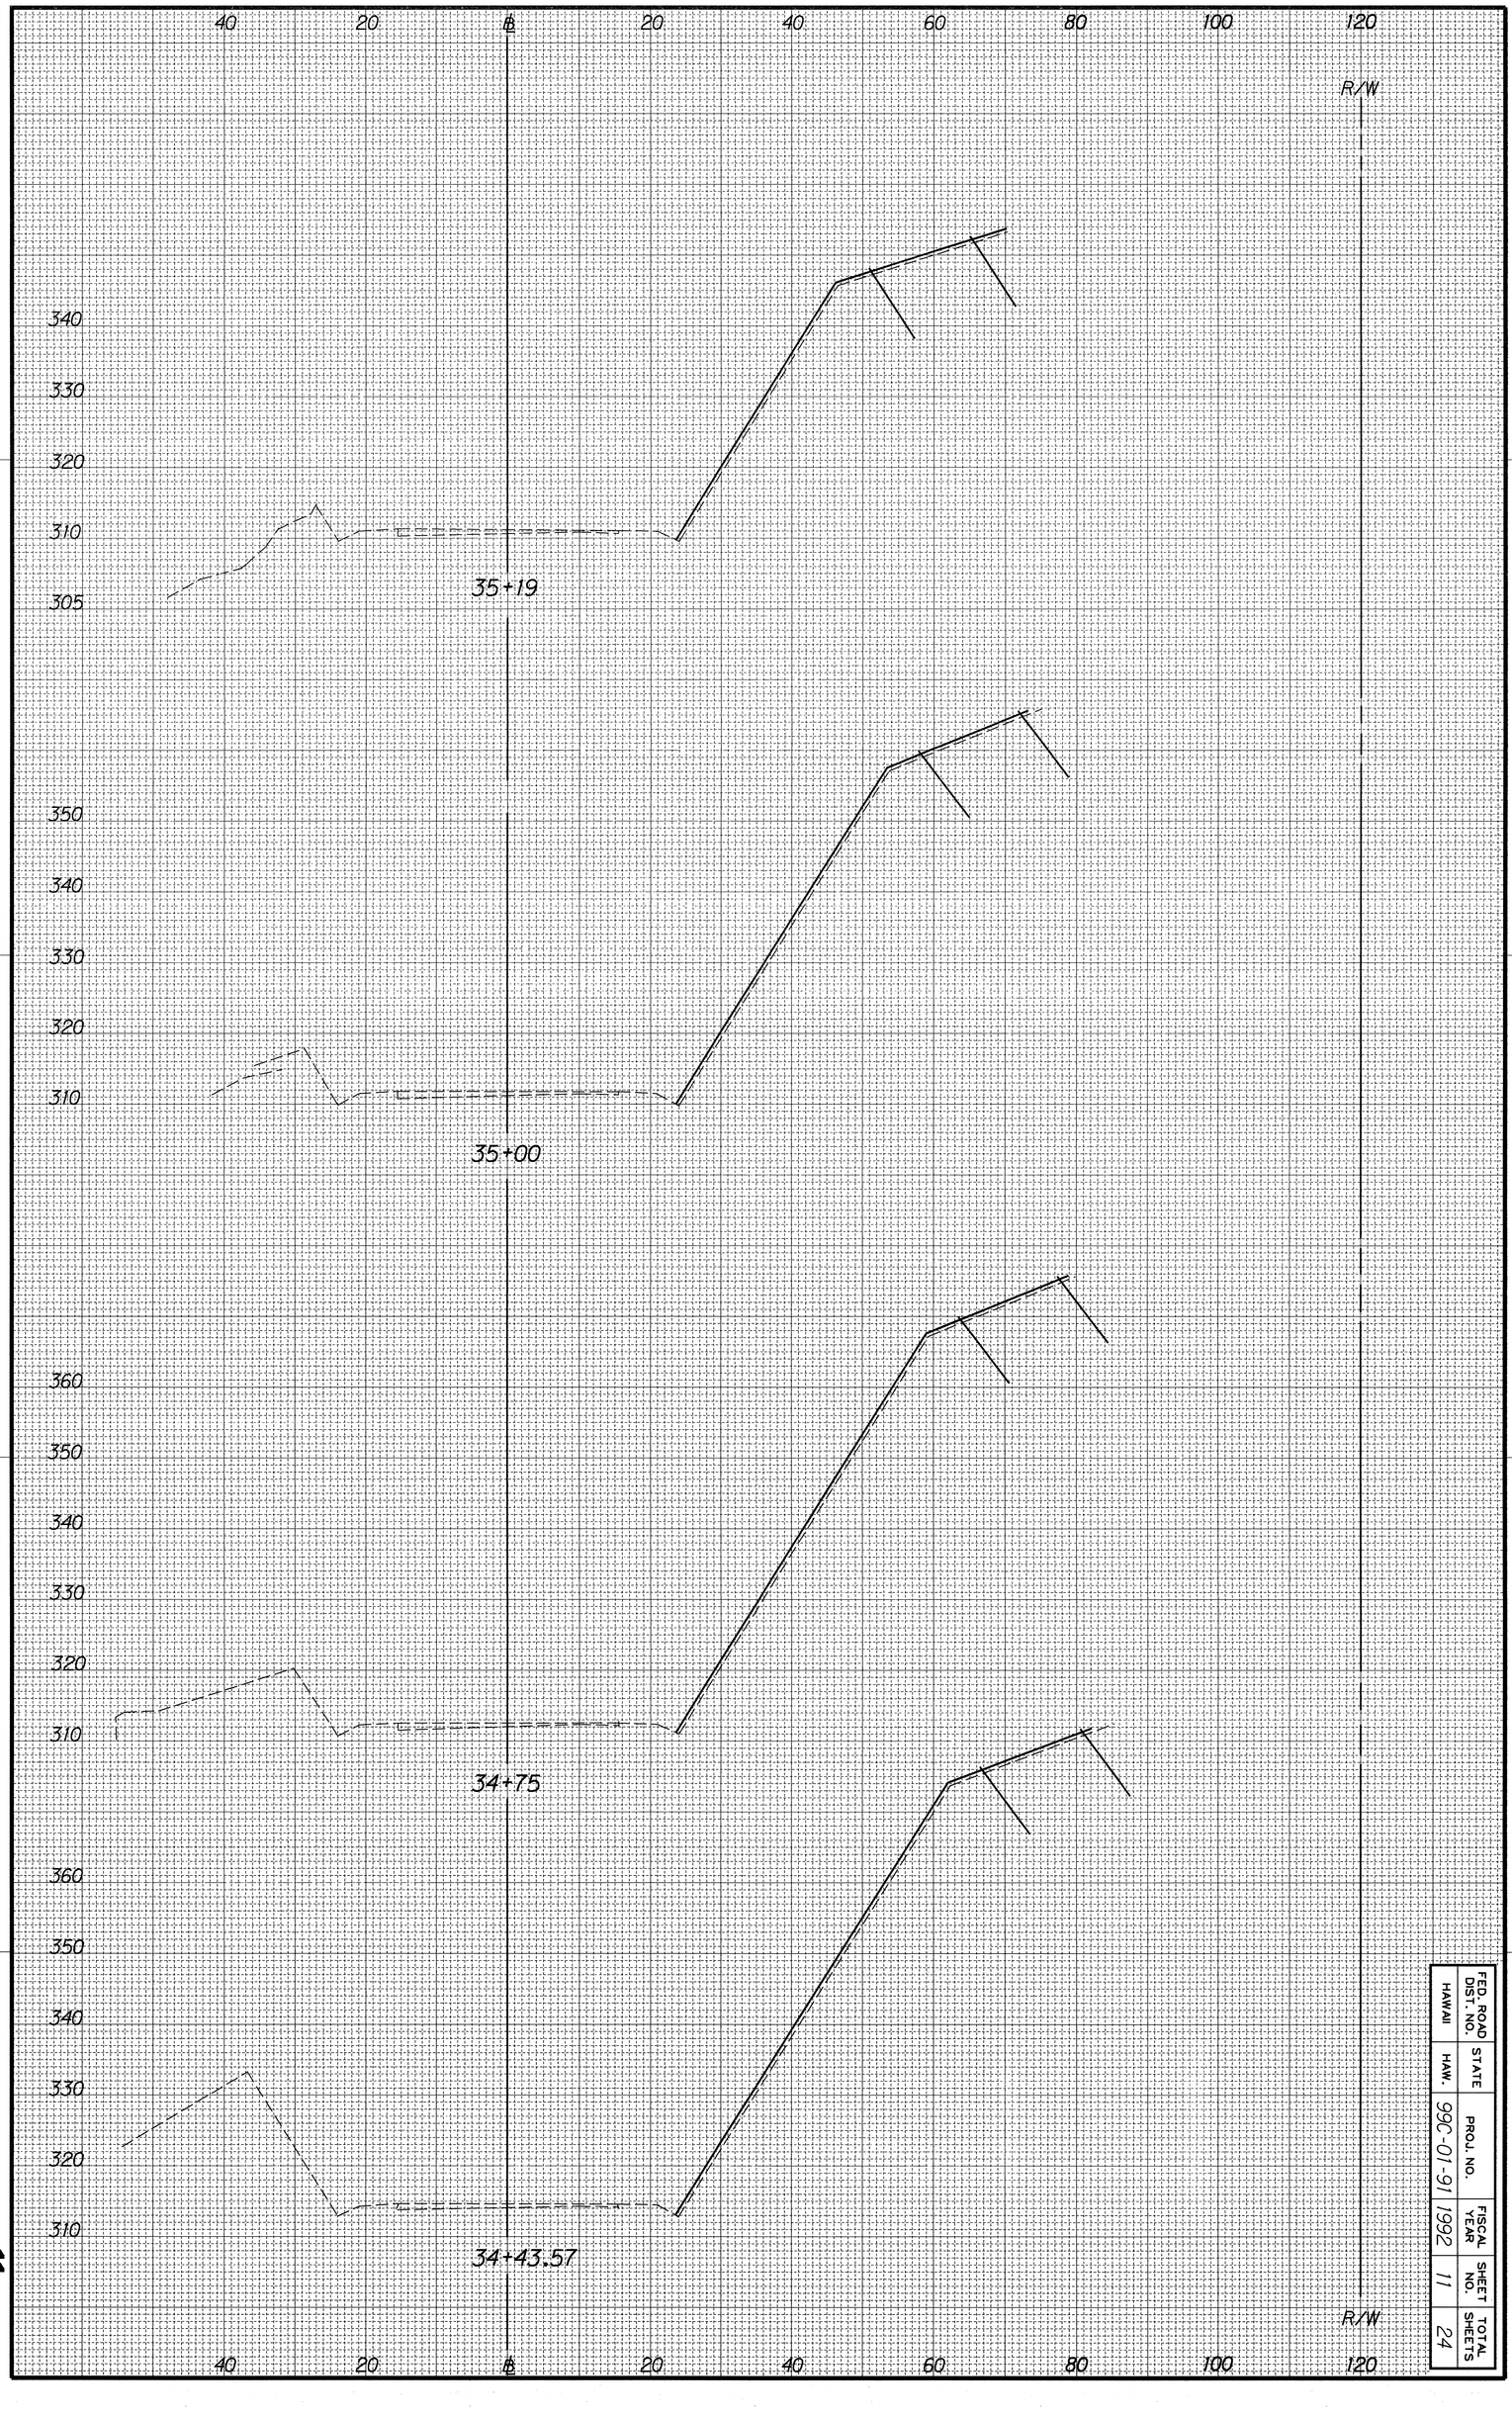

FED. ROAD DIST. NO.	STATE	PROJ. NO.	FISCAL YEAR	SHEET NO.	TOTAL SHEETS
HAWAII	HAW.	99C-01-91	1992	11	24

1kamdxs4.dgn 4/16/92

FED. ROAD DIST. NO.	STATE	PROJ. NO.	FISCAL YEAR	SHEET NO.	TOTAL SHEETS
HAWAII	HAW.	99C-01-91	1992	12	24

ORIGINAL PLAN	SURVEY PLOTTED BY _____ DATE
	DRAWN BY _____
	TRACED BY _____
NOTE BOOK	DESIGNED BY _____
	QUANTITIES BY _____
No. _____	CHECKED BY _____

1kamdxs5.dgn 4/16/92

FED. ROAD DIST. NO.	STATE	PROJ. NO.	FISCAL YEAR	SHEET NO.	TOTAL SHEETS
HAWAII	HAW.	99C-01-91	1992	13	24

ORIGINAL PLAN	SURVEY PLOTTED BY	DATE
	DRAWN BY	
NOTE BOOK	TRACED BY	
	DESIGNED BY	
	QUANTITIES BY	
No.	CHECKED BY	

1kamdxs6.dgn 4/16/92

FED. ROAD DIST. NO.	STATE	PROJ. NO.	FISCAL YEAR	SHEET NO.	TOTAL SHEETS
HAWAII	HAW.	99C-01-91	1992	14	24

ORIGINAL PLAN	SURVEY PLOTTED BY	DATE
	DRAWN BY	
NOTE BOOK	TRACED BY	
	DESIGNED BY	
	QUANTITIES BY	
No.	CHECKED BY	


1kamdxs7.dgn 4/16/92

FED. ROAD DIST. NO.	STATE	PROJ. NO.	FISCAL YEAR	SHEET NO.	TOTAL SHEETS
HAWAII	HAW.	99C-01-91	1992	15	24

ORIGINAL PLAN	SURVEY PLOTTED BY	DATE
	DRAWN BY	
	TRACED BY	
NOTE BOOK	DESIGNED BY	
	QUANTITIES BY	
No.	CHECKED BY	

1kamdxs8.dgn 4/16/92

ORIGINAL PLAN	SURVEY PLOTTED BY _____ DATE _____
	DRAWN BY _____ " _____
NOTE BOOK	TRACED BY _____ " _____
	DESIGNED BY _____ " _____
No. _____	QUANTITIES BY _____ " _____
	CHECKED BY _____ " _____

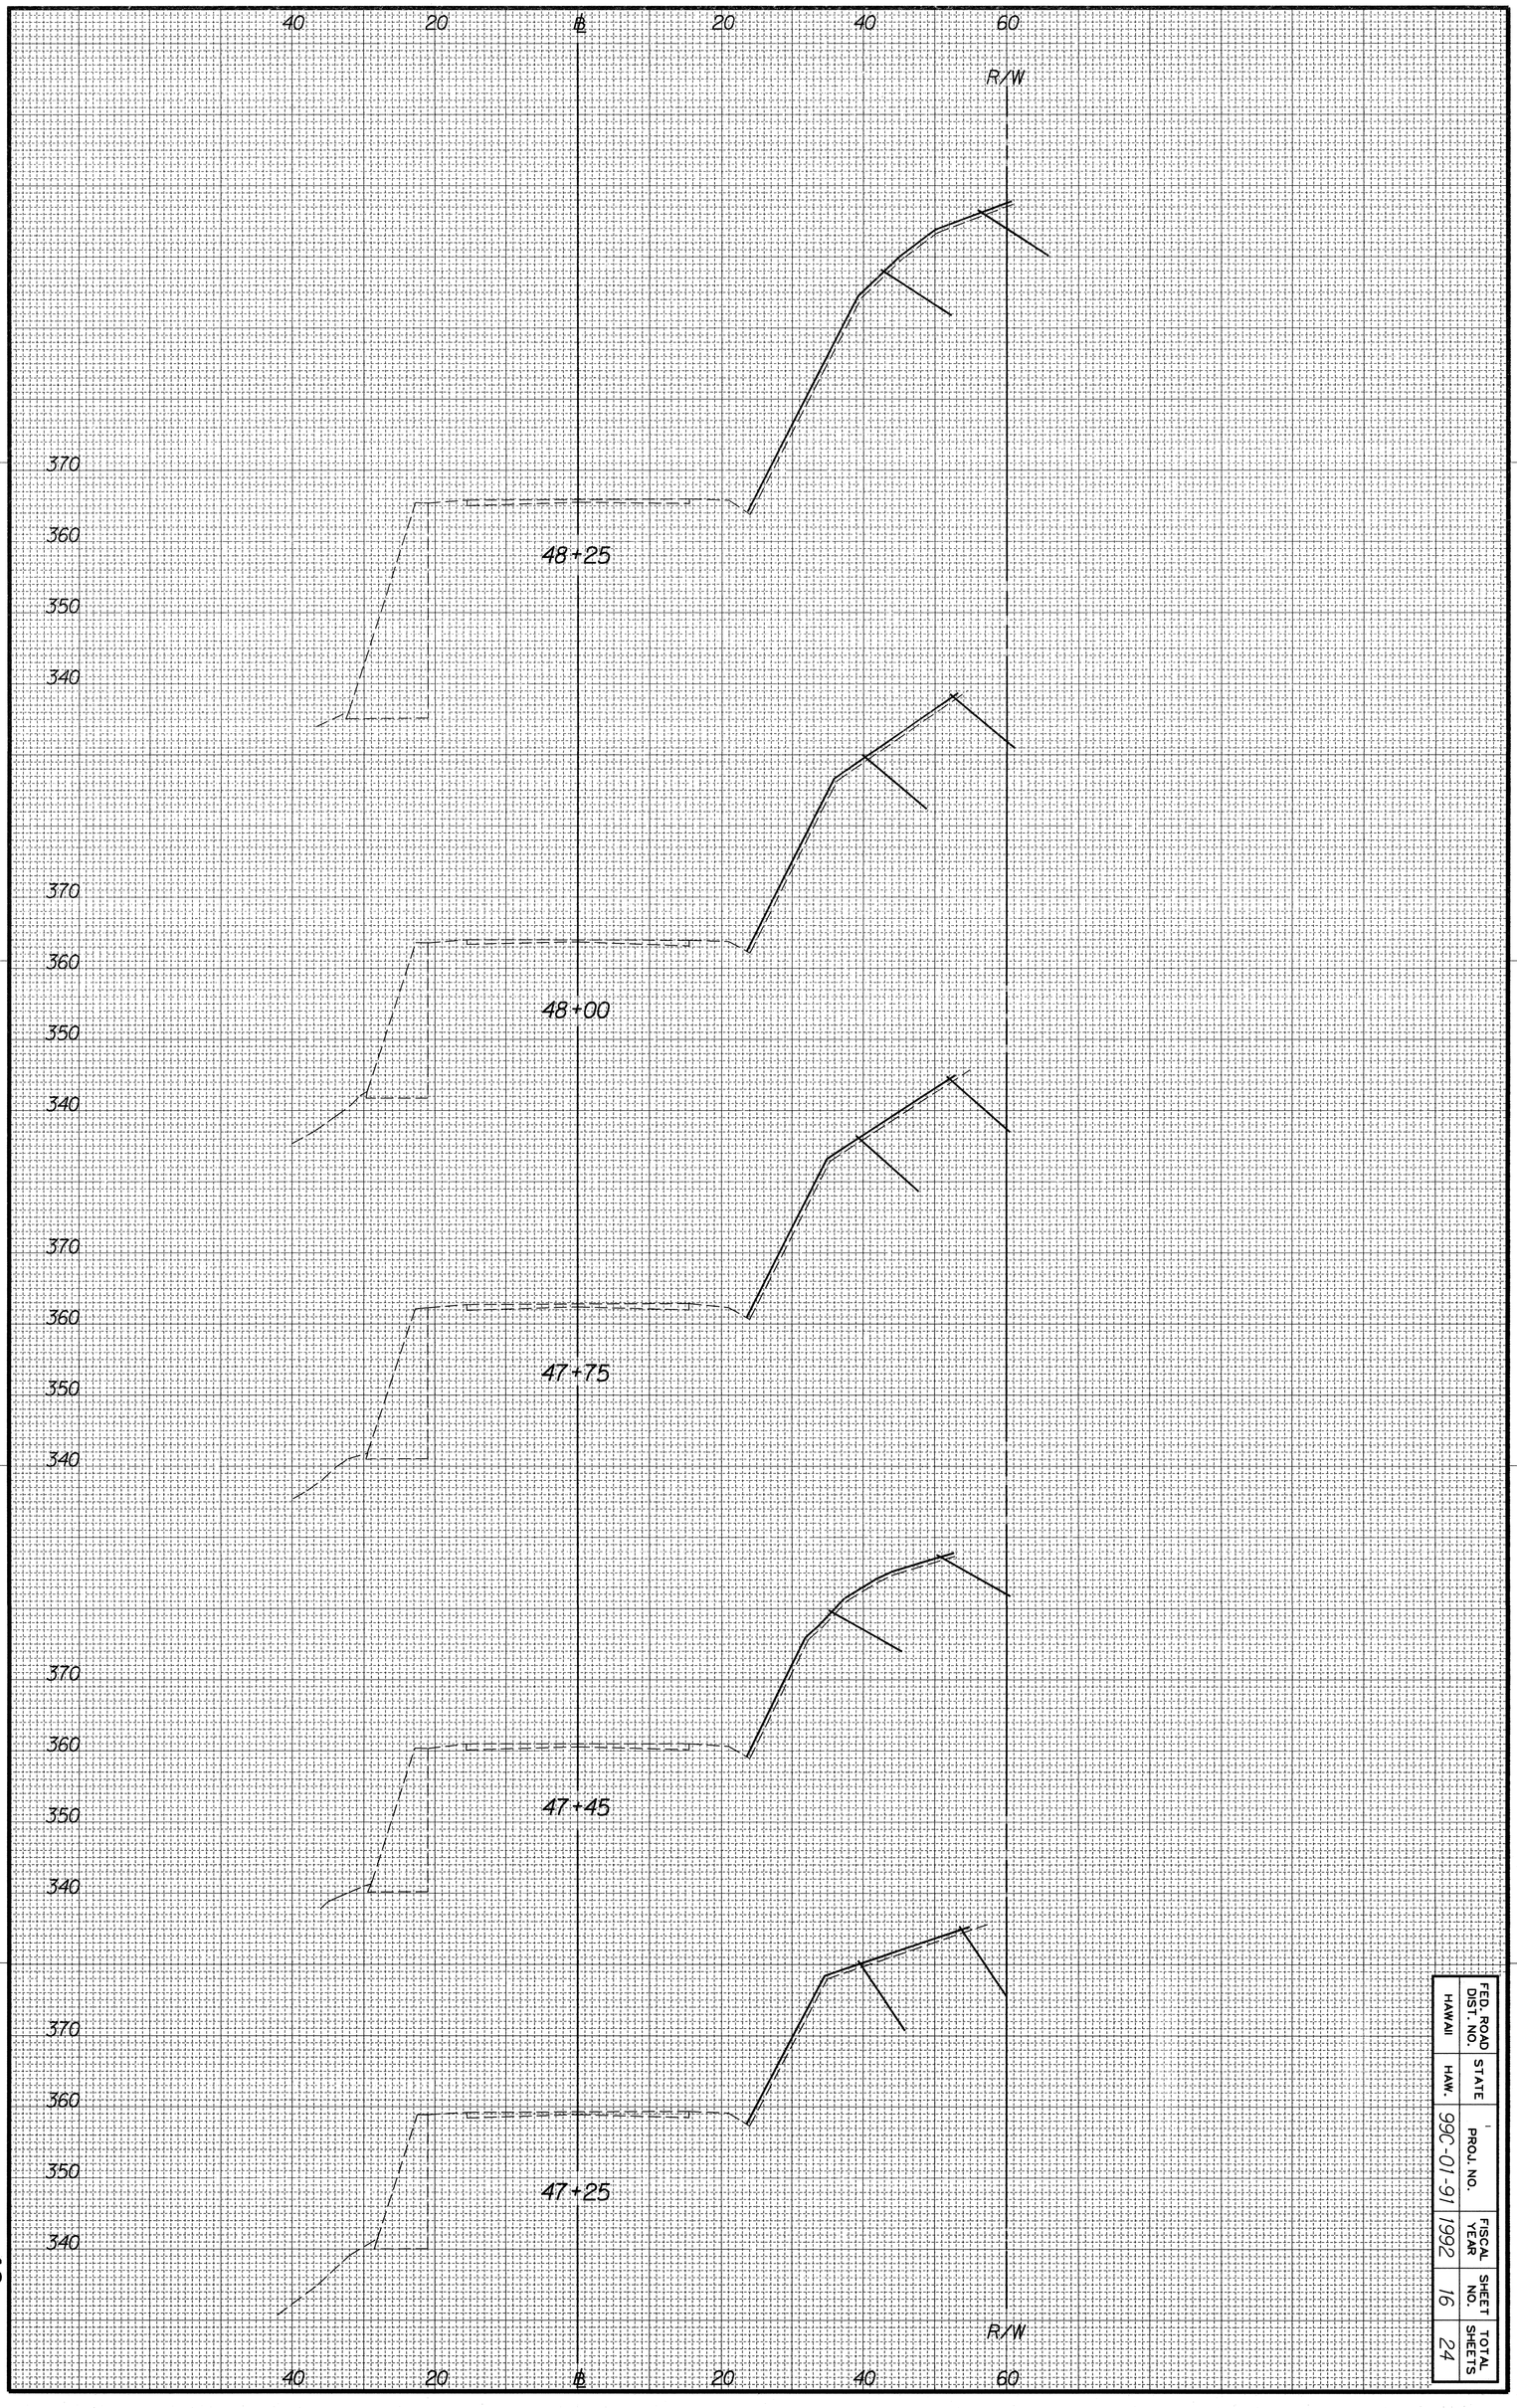

FED. ROAD DIST. NO.	STATE	PROJ. NO.	FISCAL YEAR	SHEET NO.	TOTAL SHEETS
HAWAII	HAW.	99C-01-91	1992	16	24


1kamdxs9.dgn 4/16/92

FED. ROAD DIST. NO.	STATE	PROJ. NO.	FISCAL YEAR	SHEET NO.	TOTAL SHEETS
HAWAII	HAW.	99C-01-91	1992	17	24

ORIGINAL PLAN	SURVEY PLOTTED BY	DATE
	DRAWN BY	
NOTE BOOK	TRACED BY	
	DESIGNED BY	
	QUANTITIES BY	
No.	CHECKED BY	

1kamdxs10.dgn 4/16/92

FED. ROAD DIST. NO.	STATE	PROJ. NO.	FISCAL YEAR	SHEET NO.	TOTAL SHEETS
HAWAII	HAW.	99C-01-91	1992	18	24

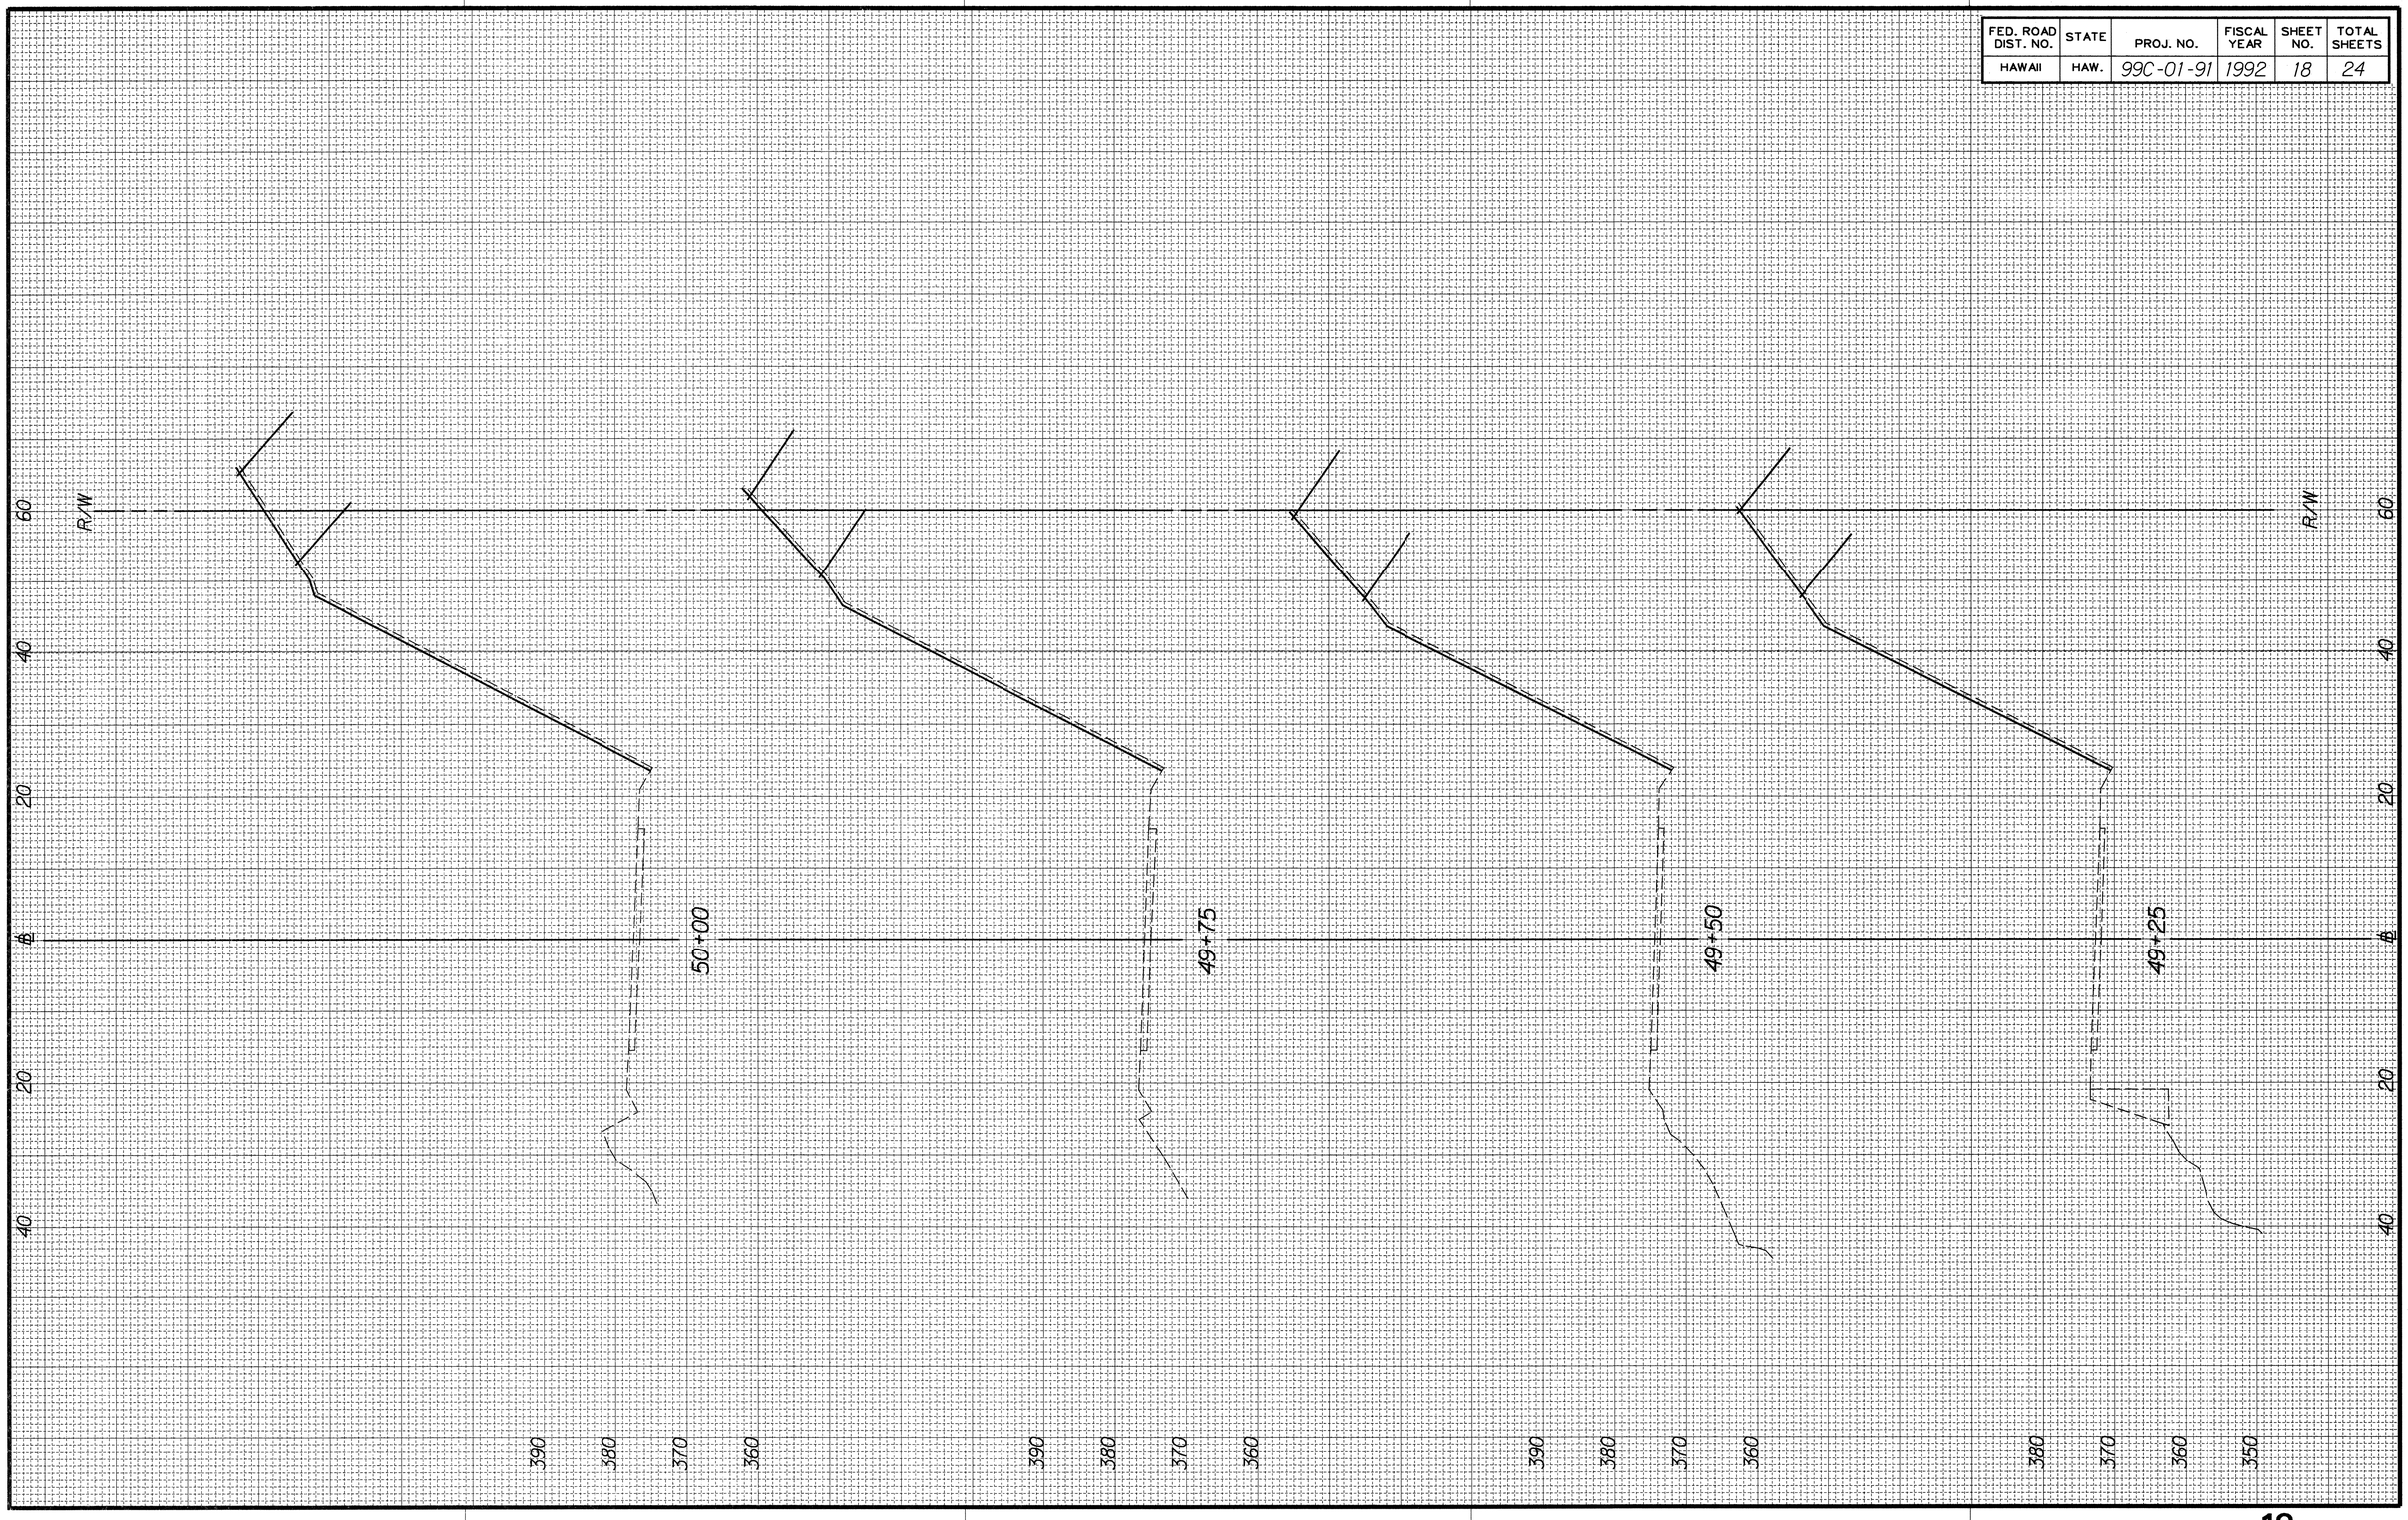

ORIGINAL PLAN	SURVEY PLOTTED BY	DATE
	DRAWN BY	
NOTE BOOK	TRACED BY	
	DESIGNED BY	
No.	QUANTITIES BY	
	CHECKED BY	


1kamdxs11.dgn 4/16/92

FED. ROAD DIST. NO.	STATE	PROJ. NO.	FISCAL YEAR	SHEET NO.	TOTAL SHEETS
HAWAII	HAW.	99C-01-91	1992	19	24

ORIGINAL PLAN	SURVEY PLOTTED BY	DATE
	DRAWN BY	
	TRACED BY	
NOTE BOOK	DESIGNED BY	
	QUANTITIES BY	
N.__	CHECKED BY	

1kamdxs12.dgn 4/16/92


ORIGINAL PLAN	SURVEY PLOTTED BY _____ DATE _____
	DRAWN BY _____ " _____
NOTE BOOK	TRACED BY _____ " _____
	DESIGNED BY _____ " _____
N. _____	QUANTITIES BY _____ " _____
	CHECKED BY _____ " _____

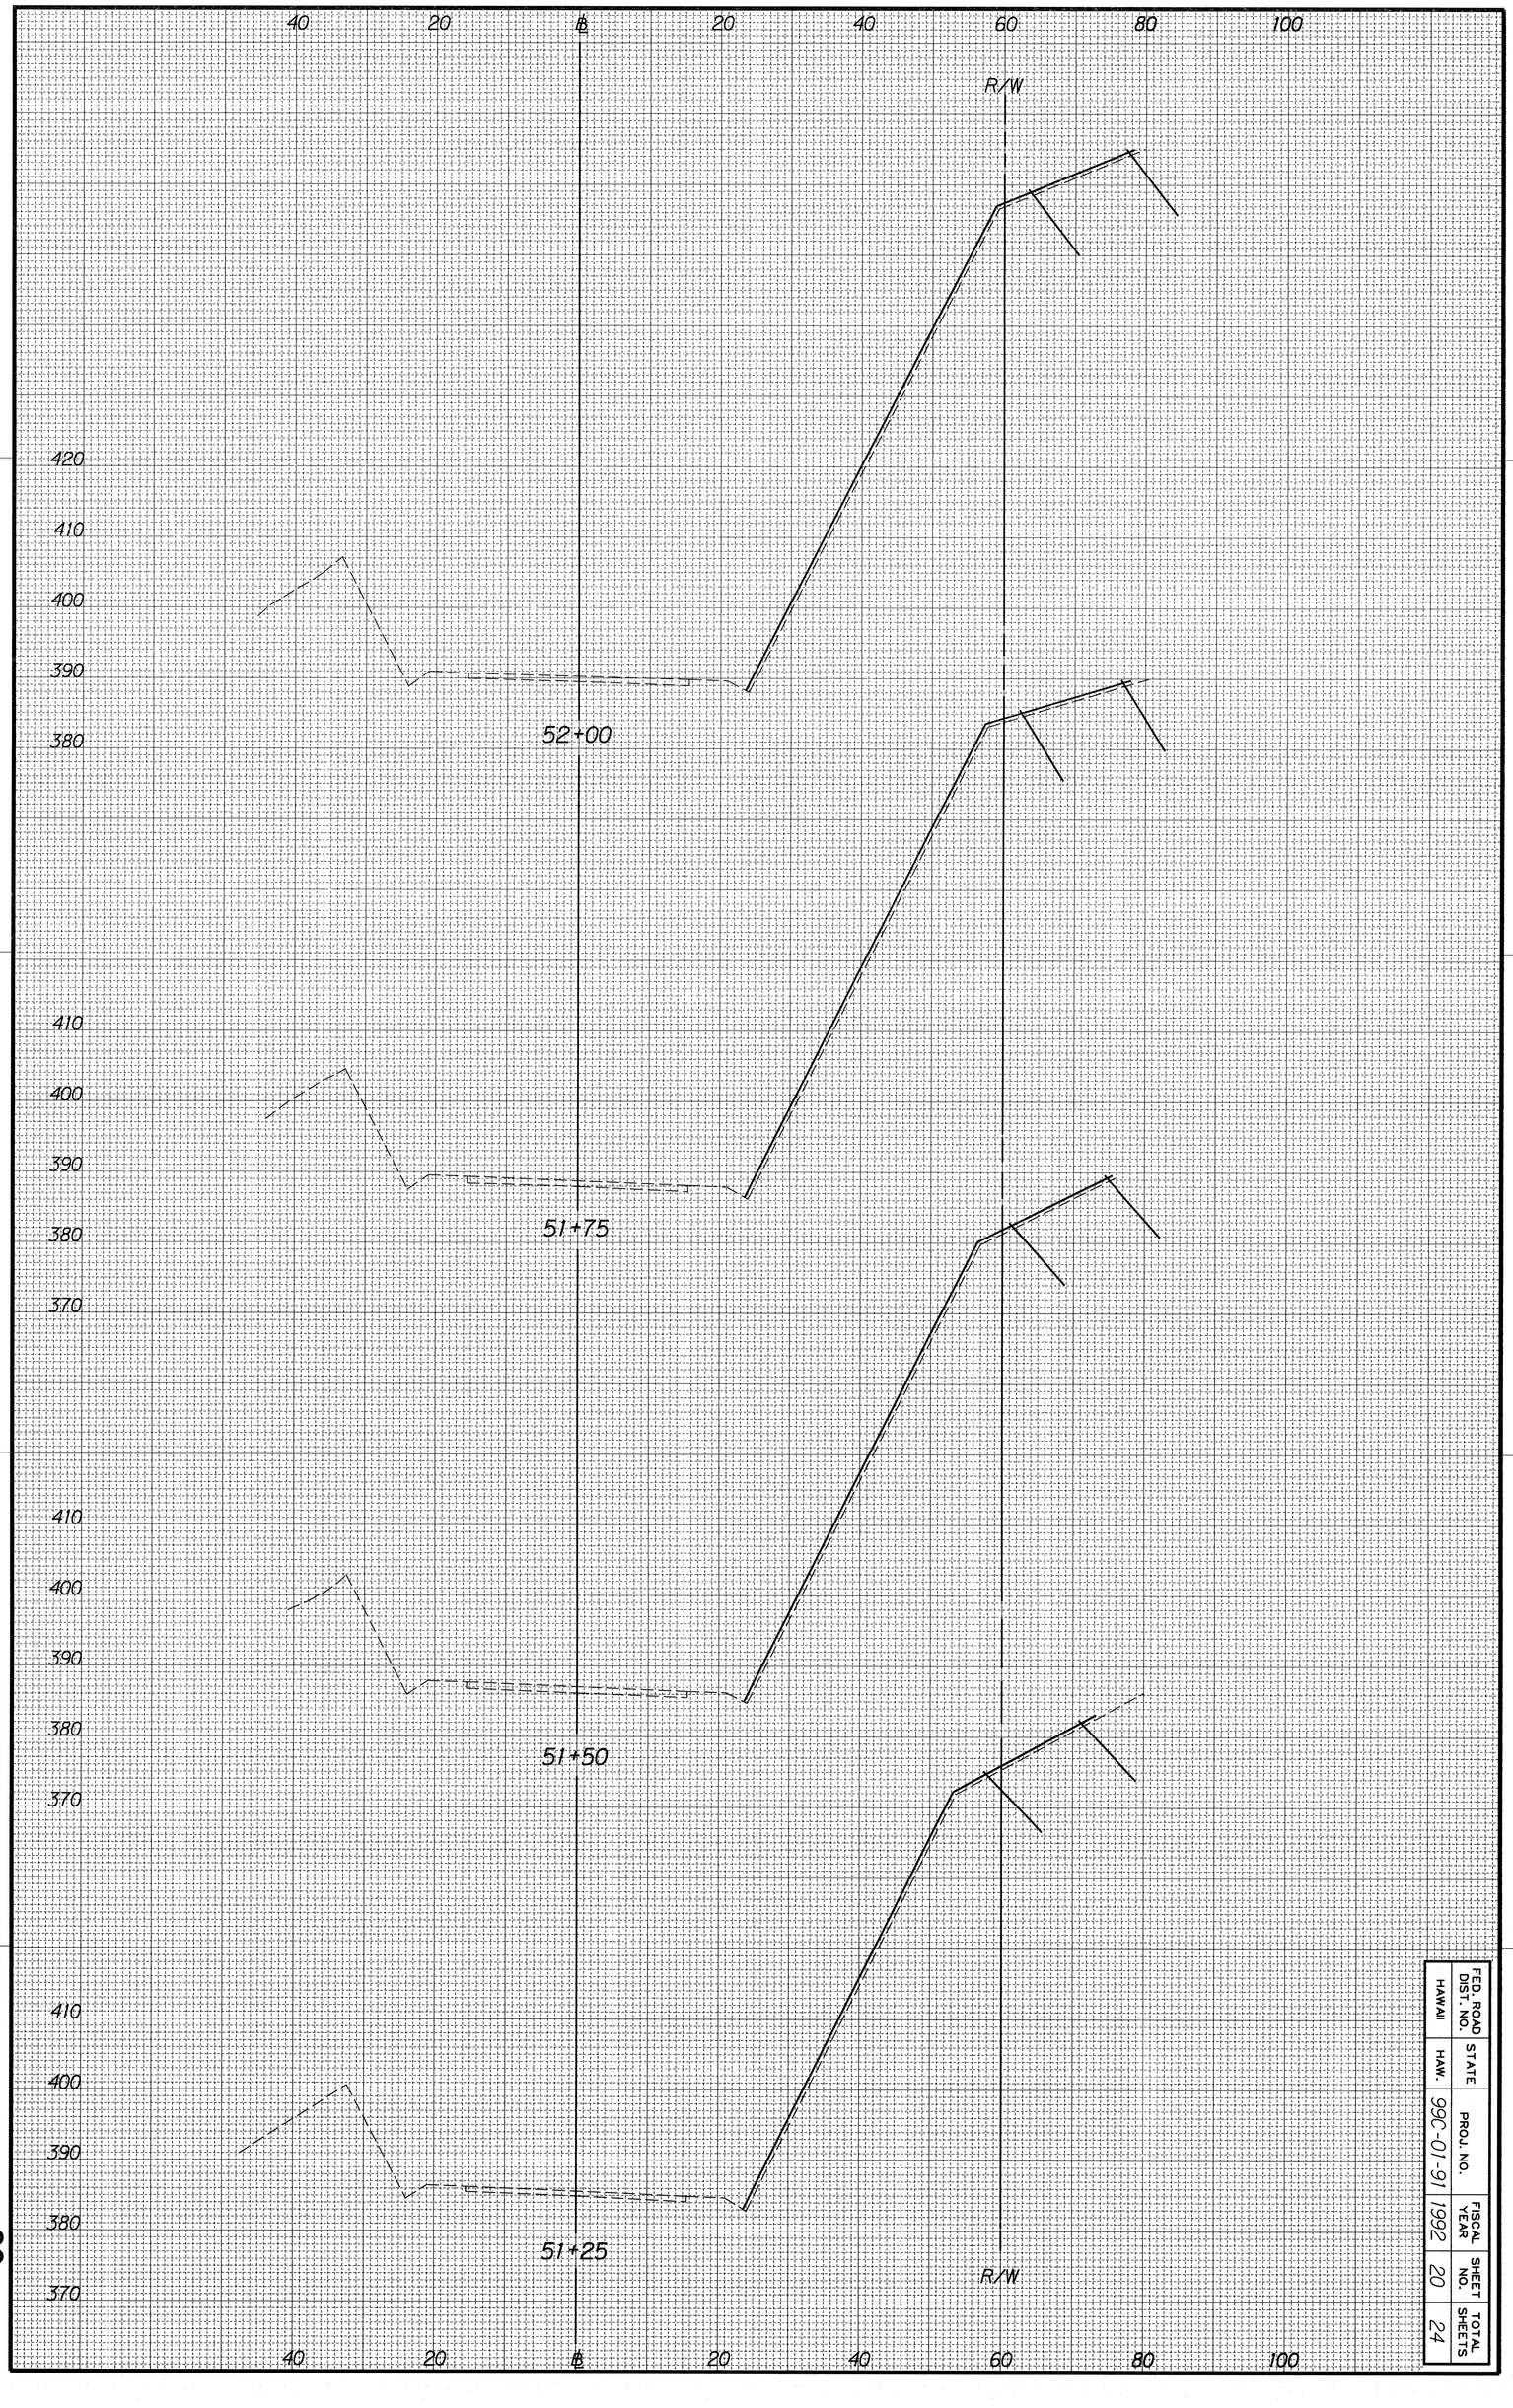

FED. ROAD DIST. NO.	STATE	PROJ. NO.	FISCAL YEAR	SHEET NO.	TOTAL SHEETS
HAWAII	HAW.	99C-01-91	1992	20	24

kamdxs13.dan 4/16/92


FED. ROAD DIST. NO.	STATE	PROJ. NO.	FISCAL YEAR	SHEET NO.	TOTAL SHEETS
HAWAII	HAW.	99C-01-91	1992	21	24

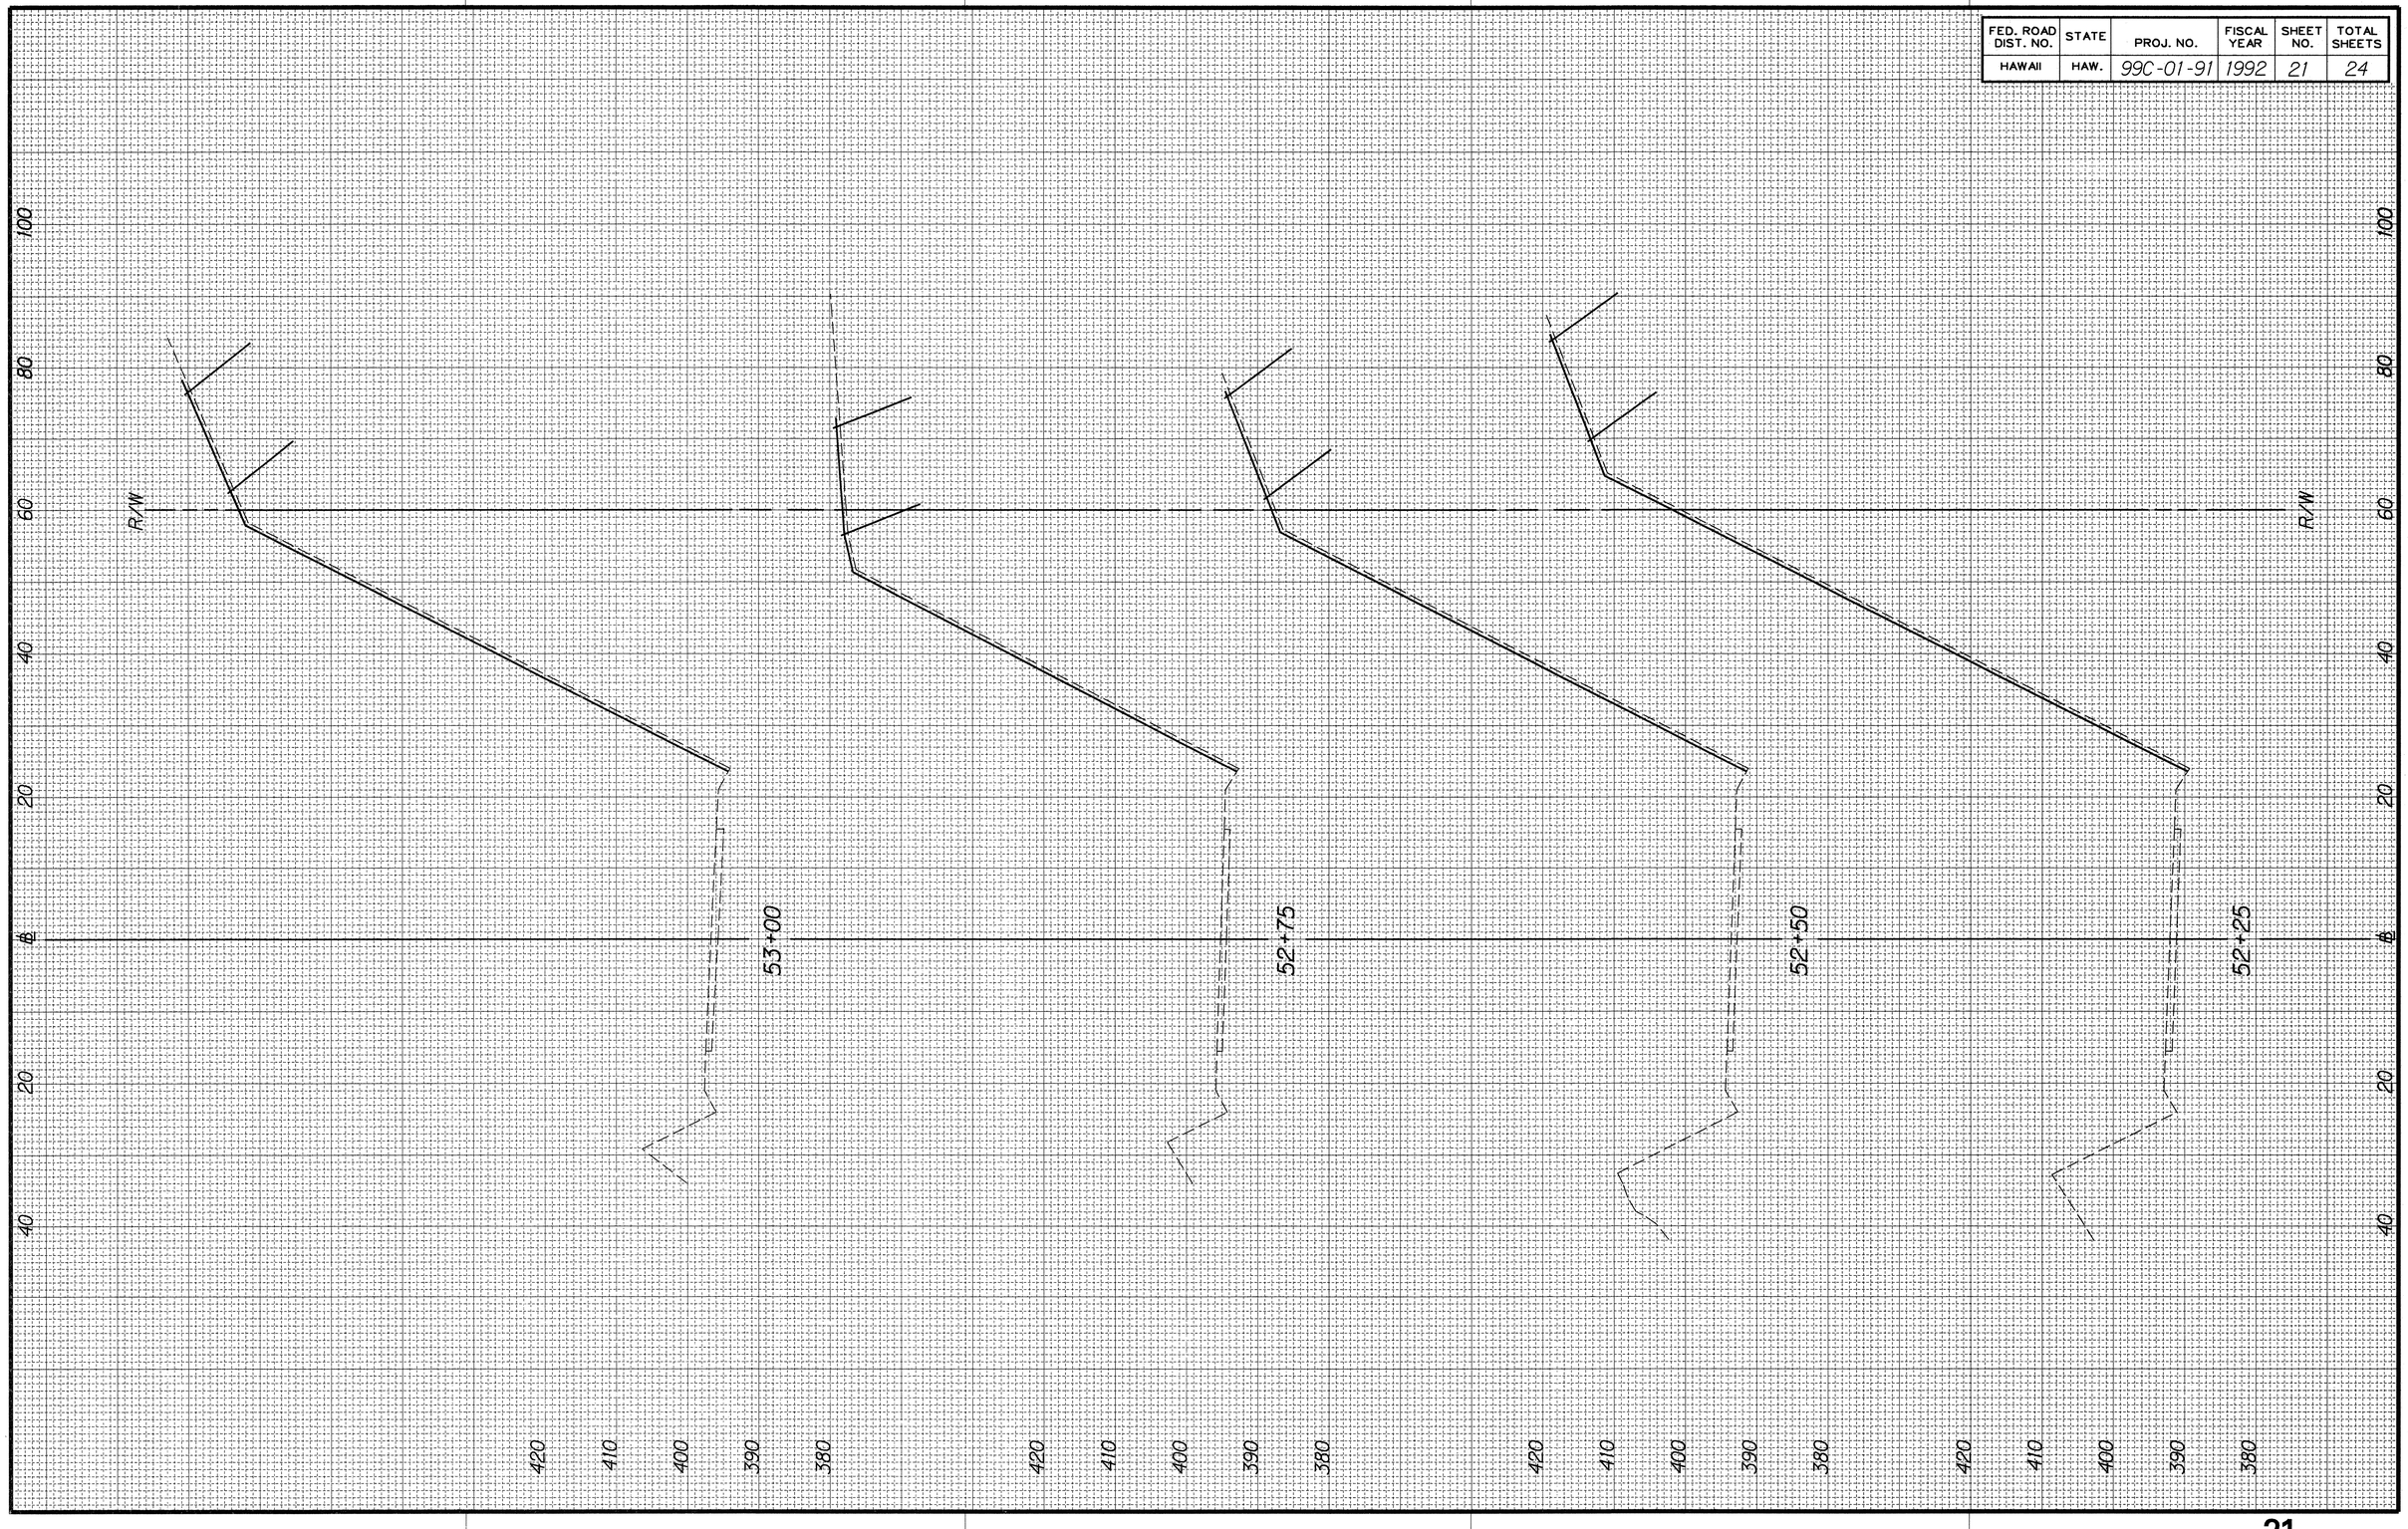

ORIGINAL PLAN	SURVEY PLOTTED BY	DATE
	DRAWN BY	
NOTE BOOK	TRACED BY	
	DESIGNED BY	
	QUANTITIES BY	
No.	CHECKED BY	

1kamdxs14.dgn 4/16/92


FED. ROAD DIST. NO.	STATE	PROJ. NO.	FISCAL YEAR	SHEET NO.	TOTAL SHEETS
HAWAII	HAW.	99C-01-91	1992	22	24

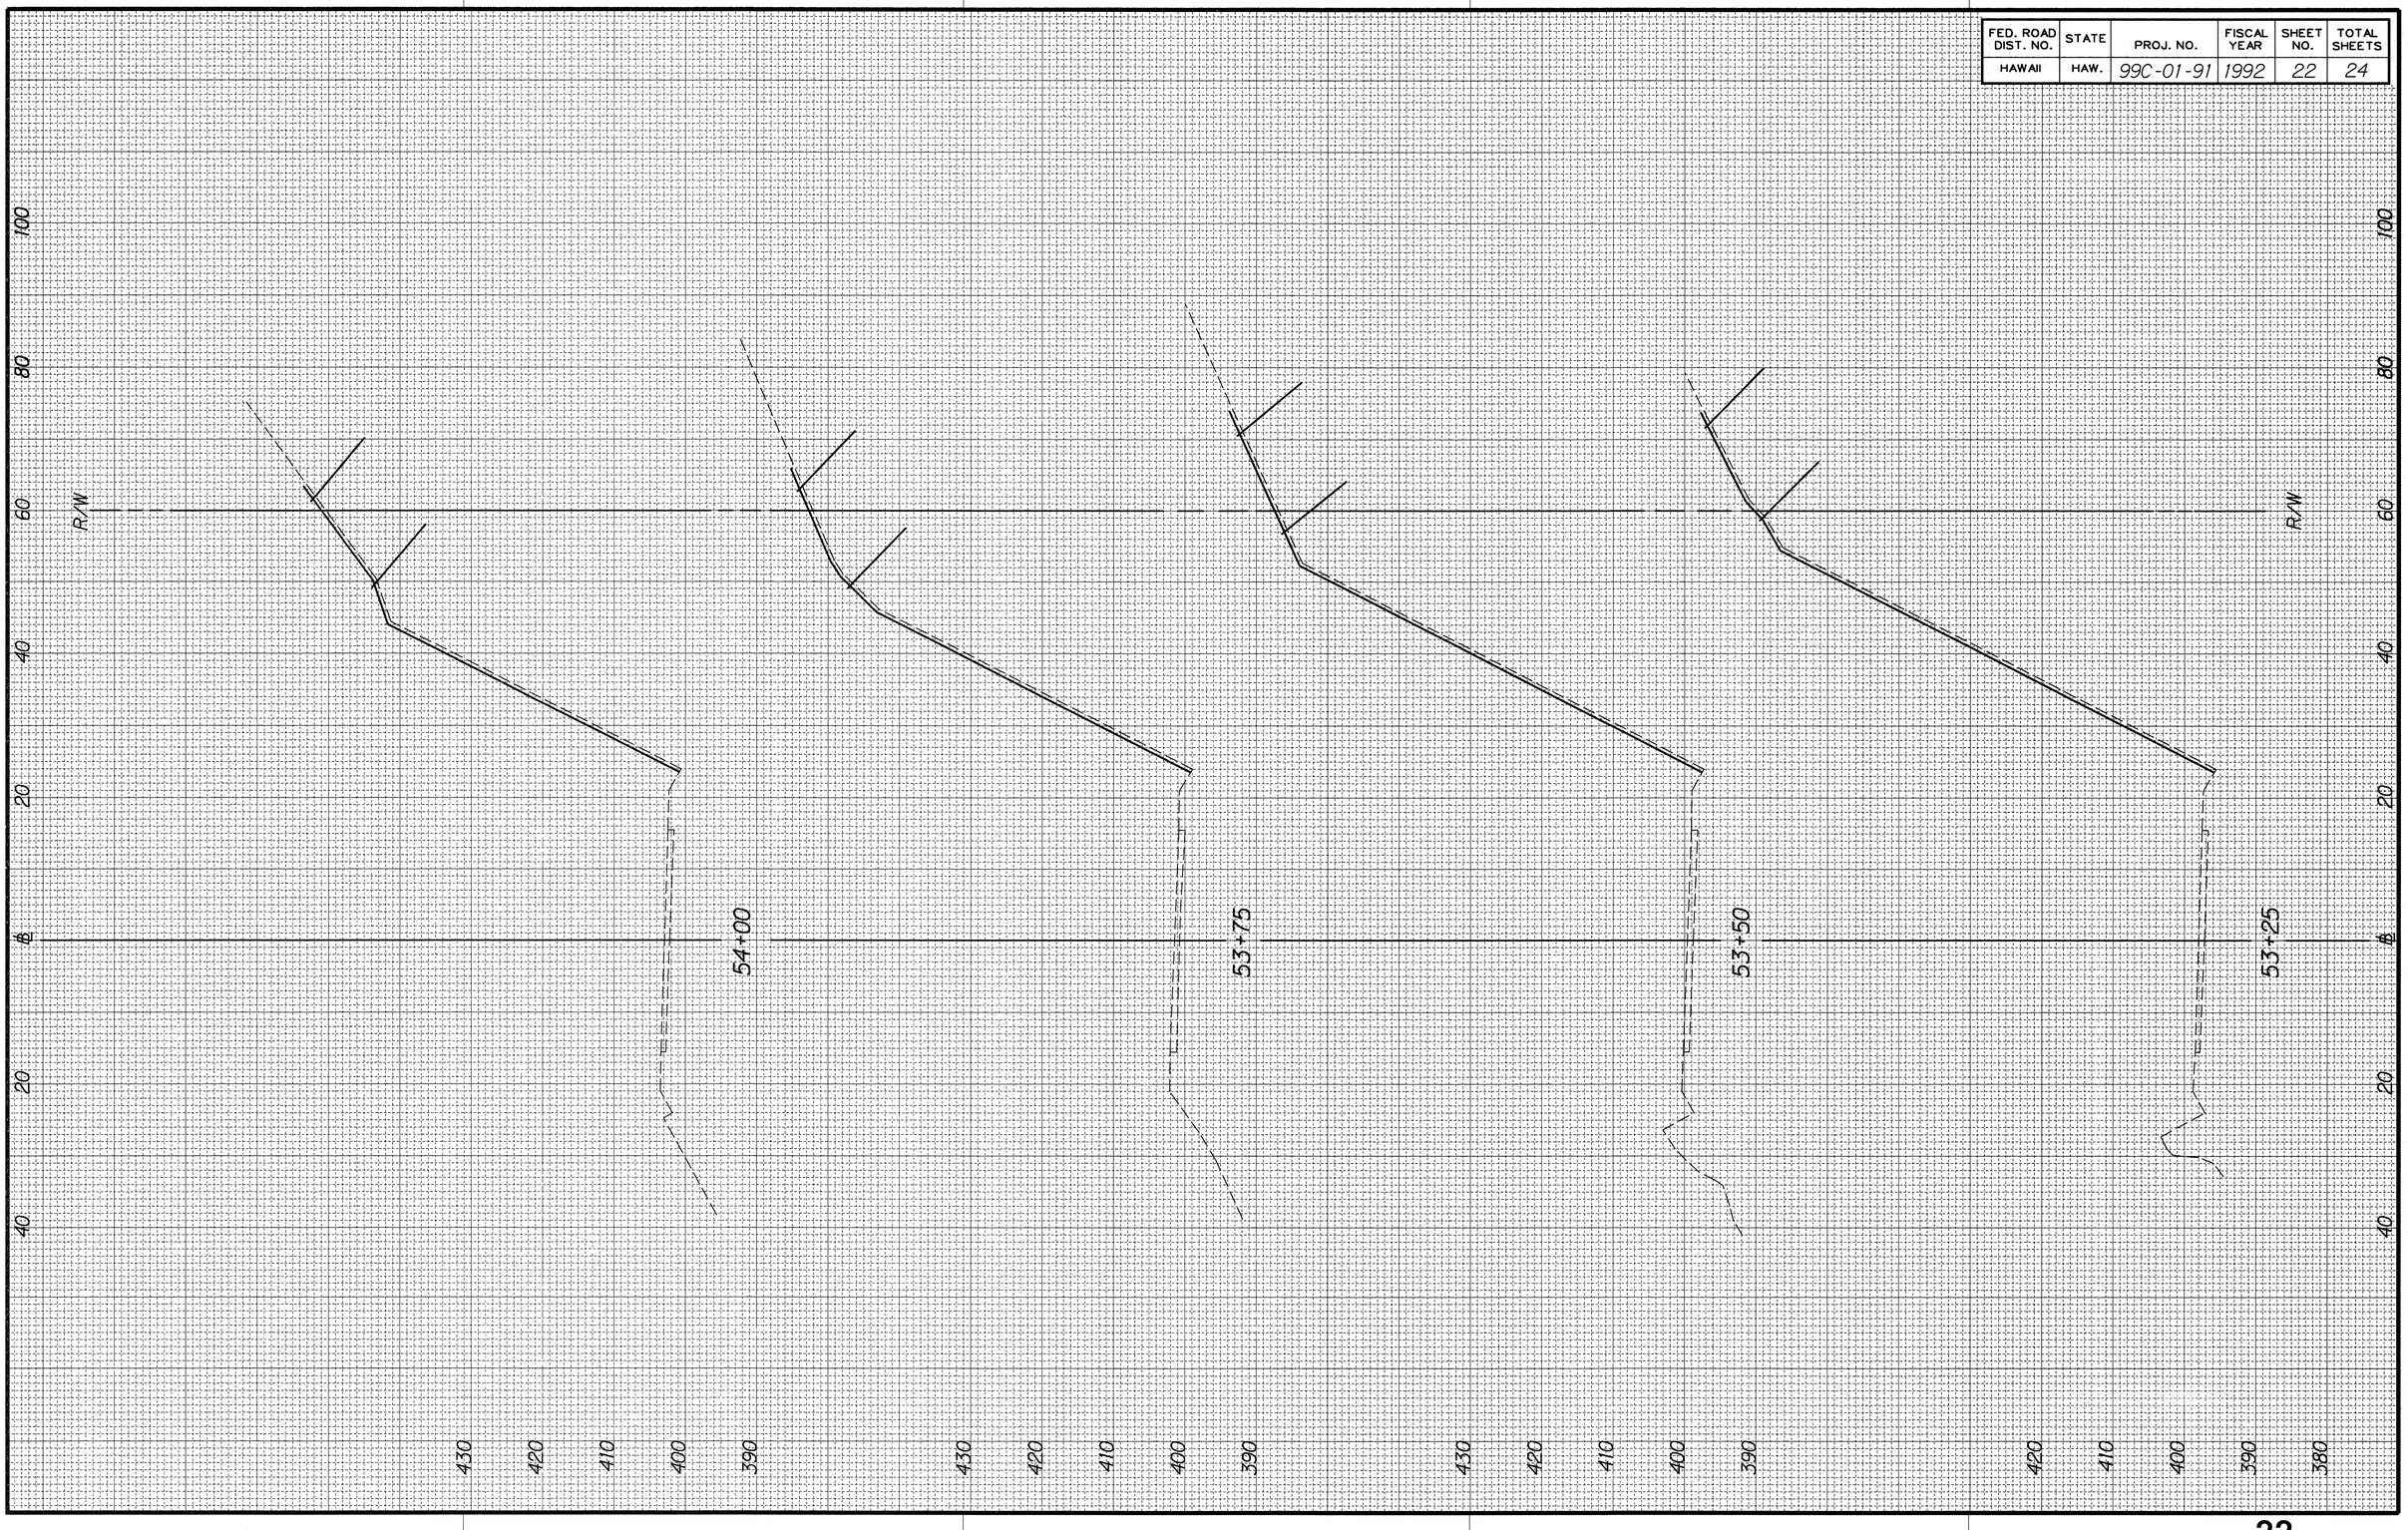

ORIGINAL PLAN	SURVEY PLOTTED BY	DATE
	DRAWN BY	
NOTE BOOK	TRACED BY	
	DESIGNED BY	
No.	QUANTITIES BY	
	CHECKED BY	

1kamdxs15.dgn 4/16/92


ORIGINAL PLAN	SURVEY PLOTTED BY _____ DATE _____
	DRAWN BY _____ " _____
NOTE BOOK	TRACED BY _____ " _____
	DESIGNED BY _____ " _____
	QUANTITIES BY _____ " _____
No. _____	CHECKED BY _____ " _____

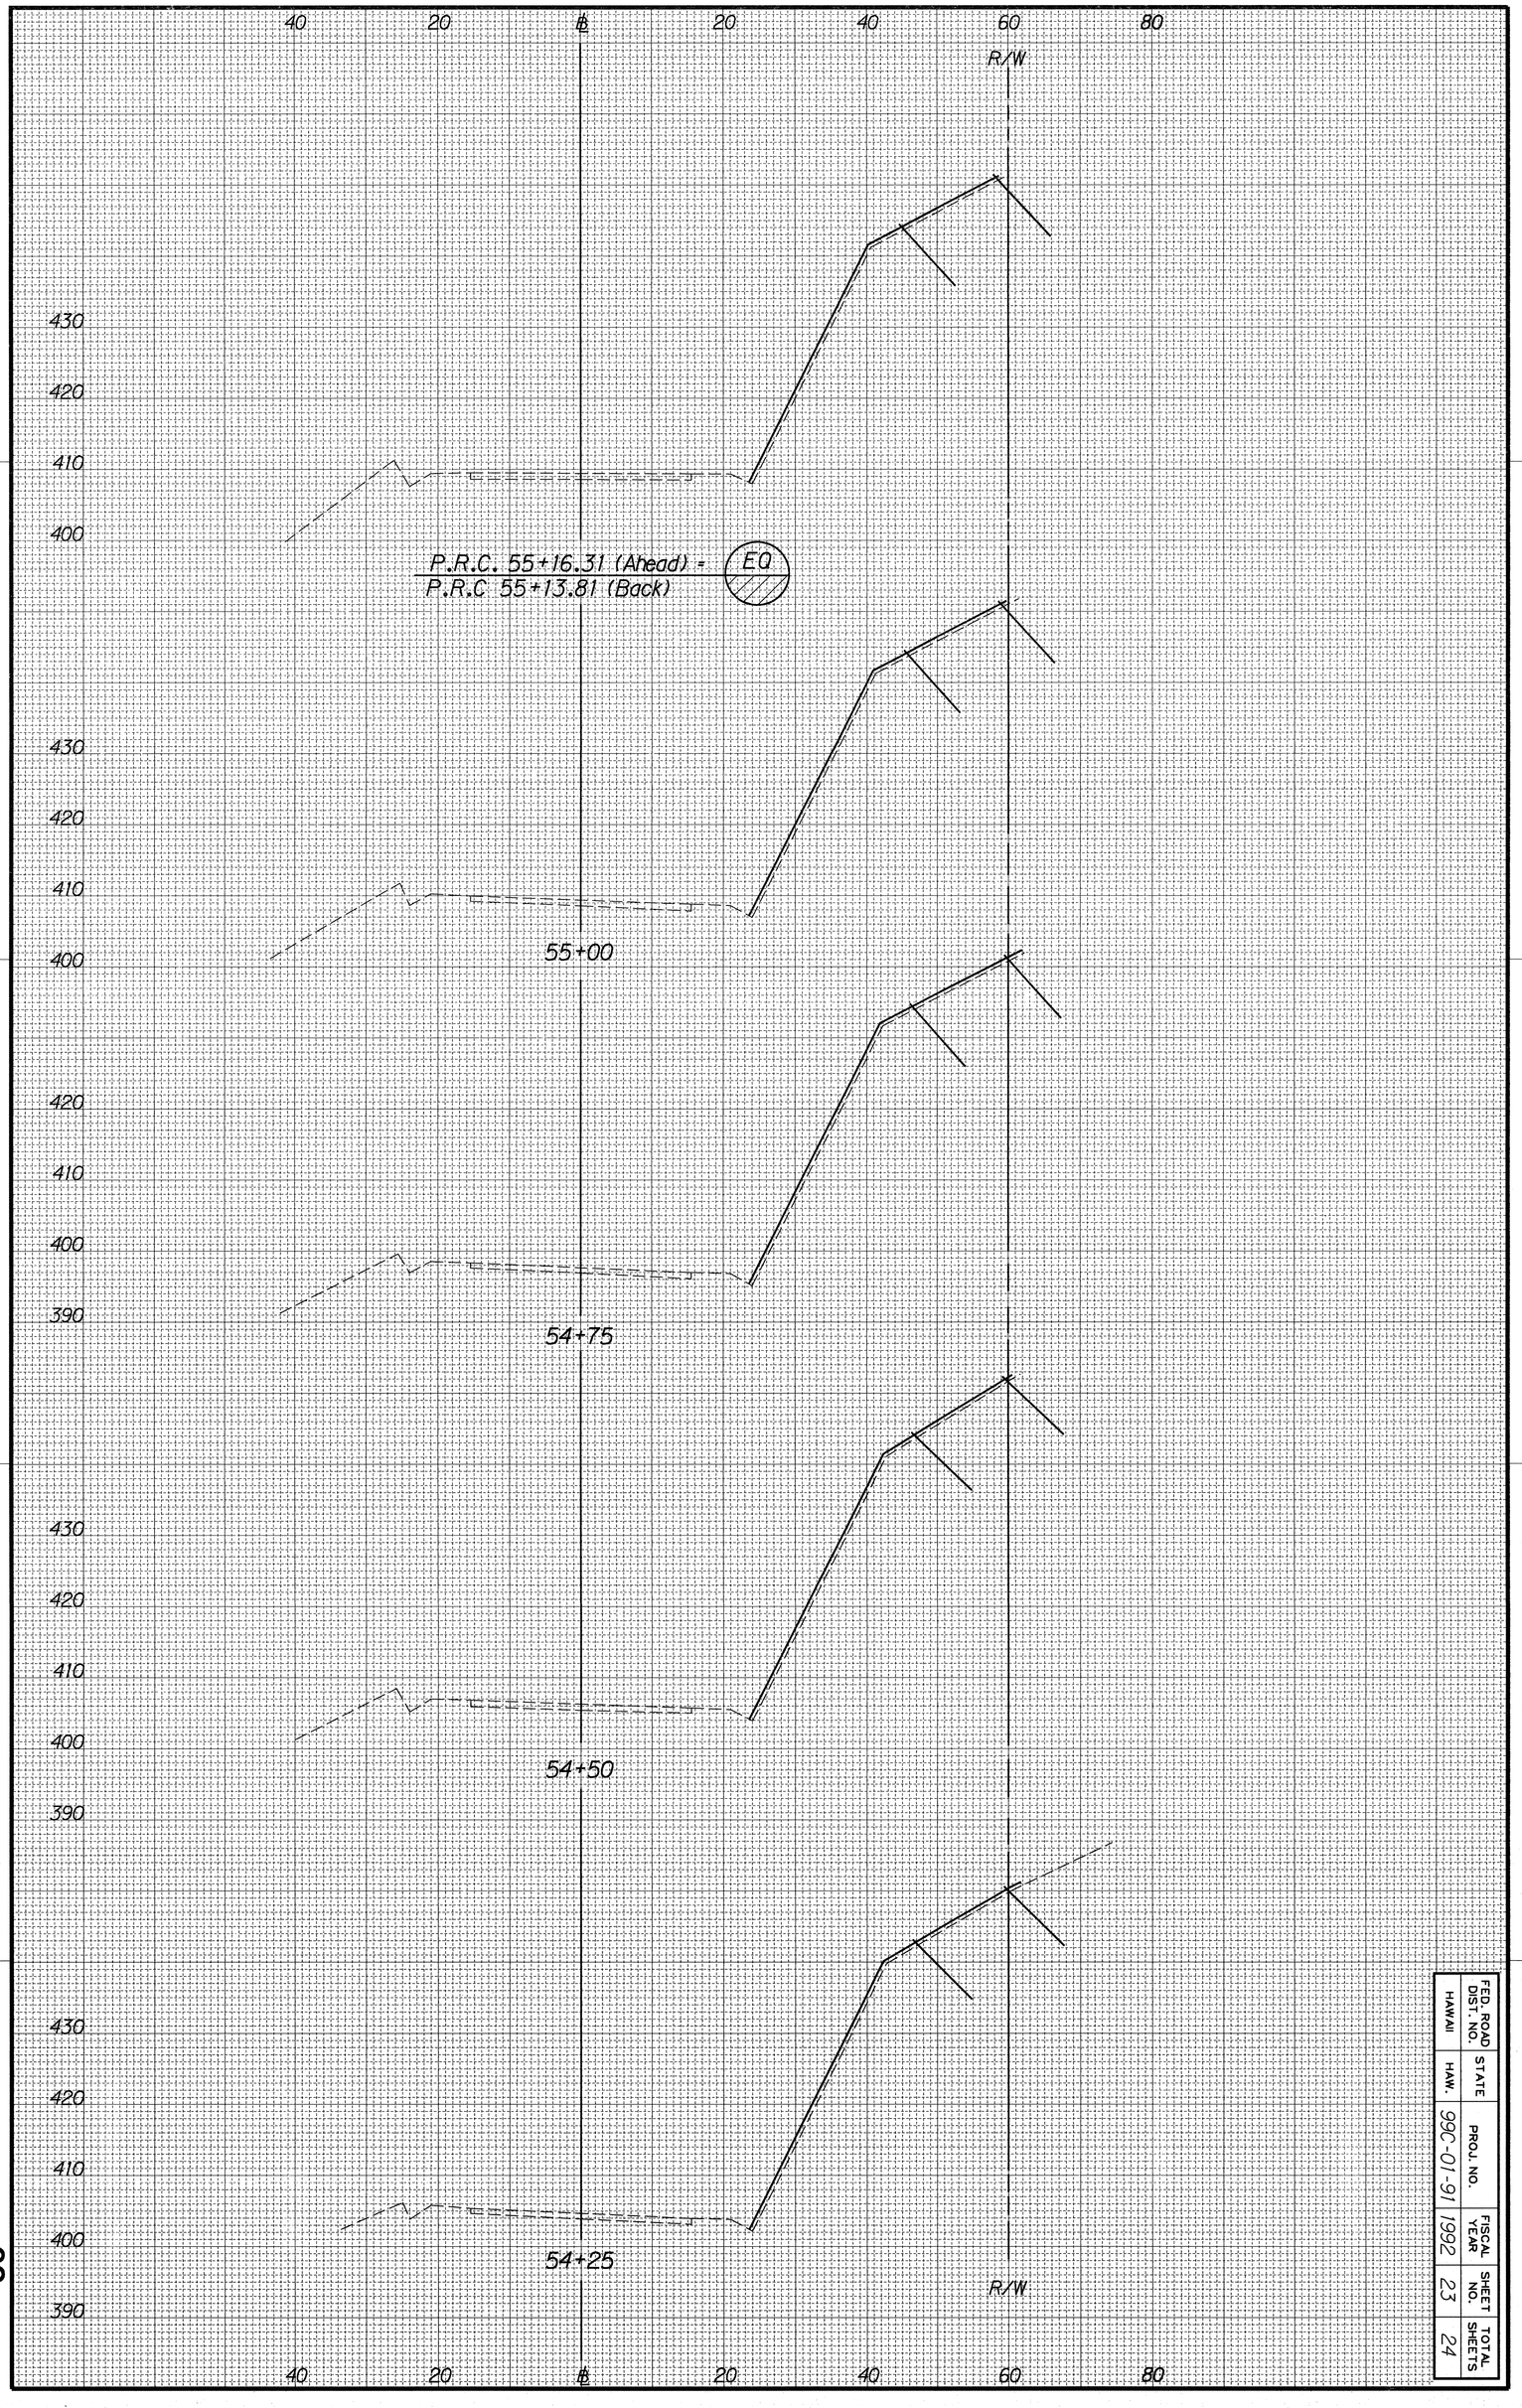

FED. ROAD DIST. NO.	STATE	PROJ. NO.	FISCAL YEAR	SHEET NO.	TOTAL SHEETS
HAWAII	HAW.	99C-01-91	1992	23	24

1kamdxs16.dgn 4/16/92

FED. ROAD DIST. NO.	STATE	PROJ. NO.	FISCAL YEAR	SHEET NO.	TOTAL SHEETS
HAWAII	HAW.	99C-01-91	1992	24	24

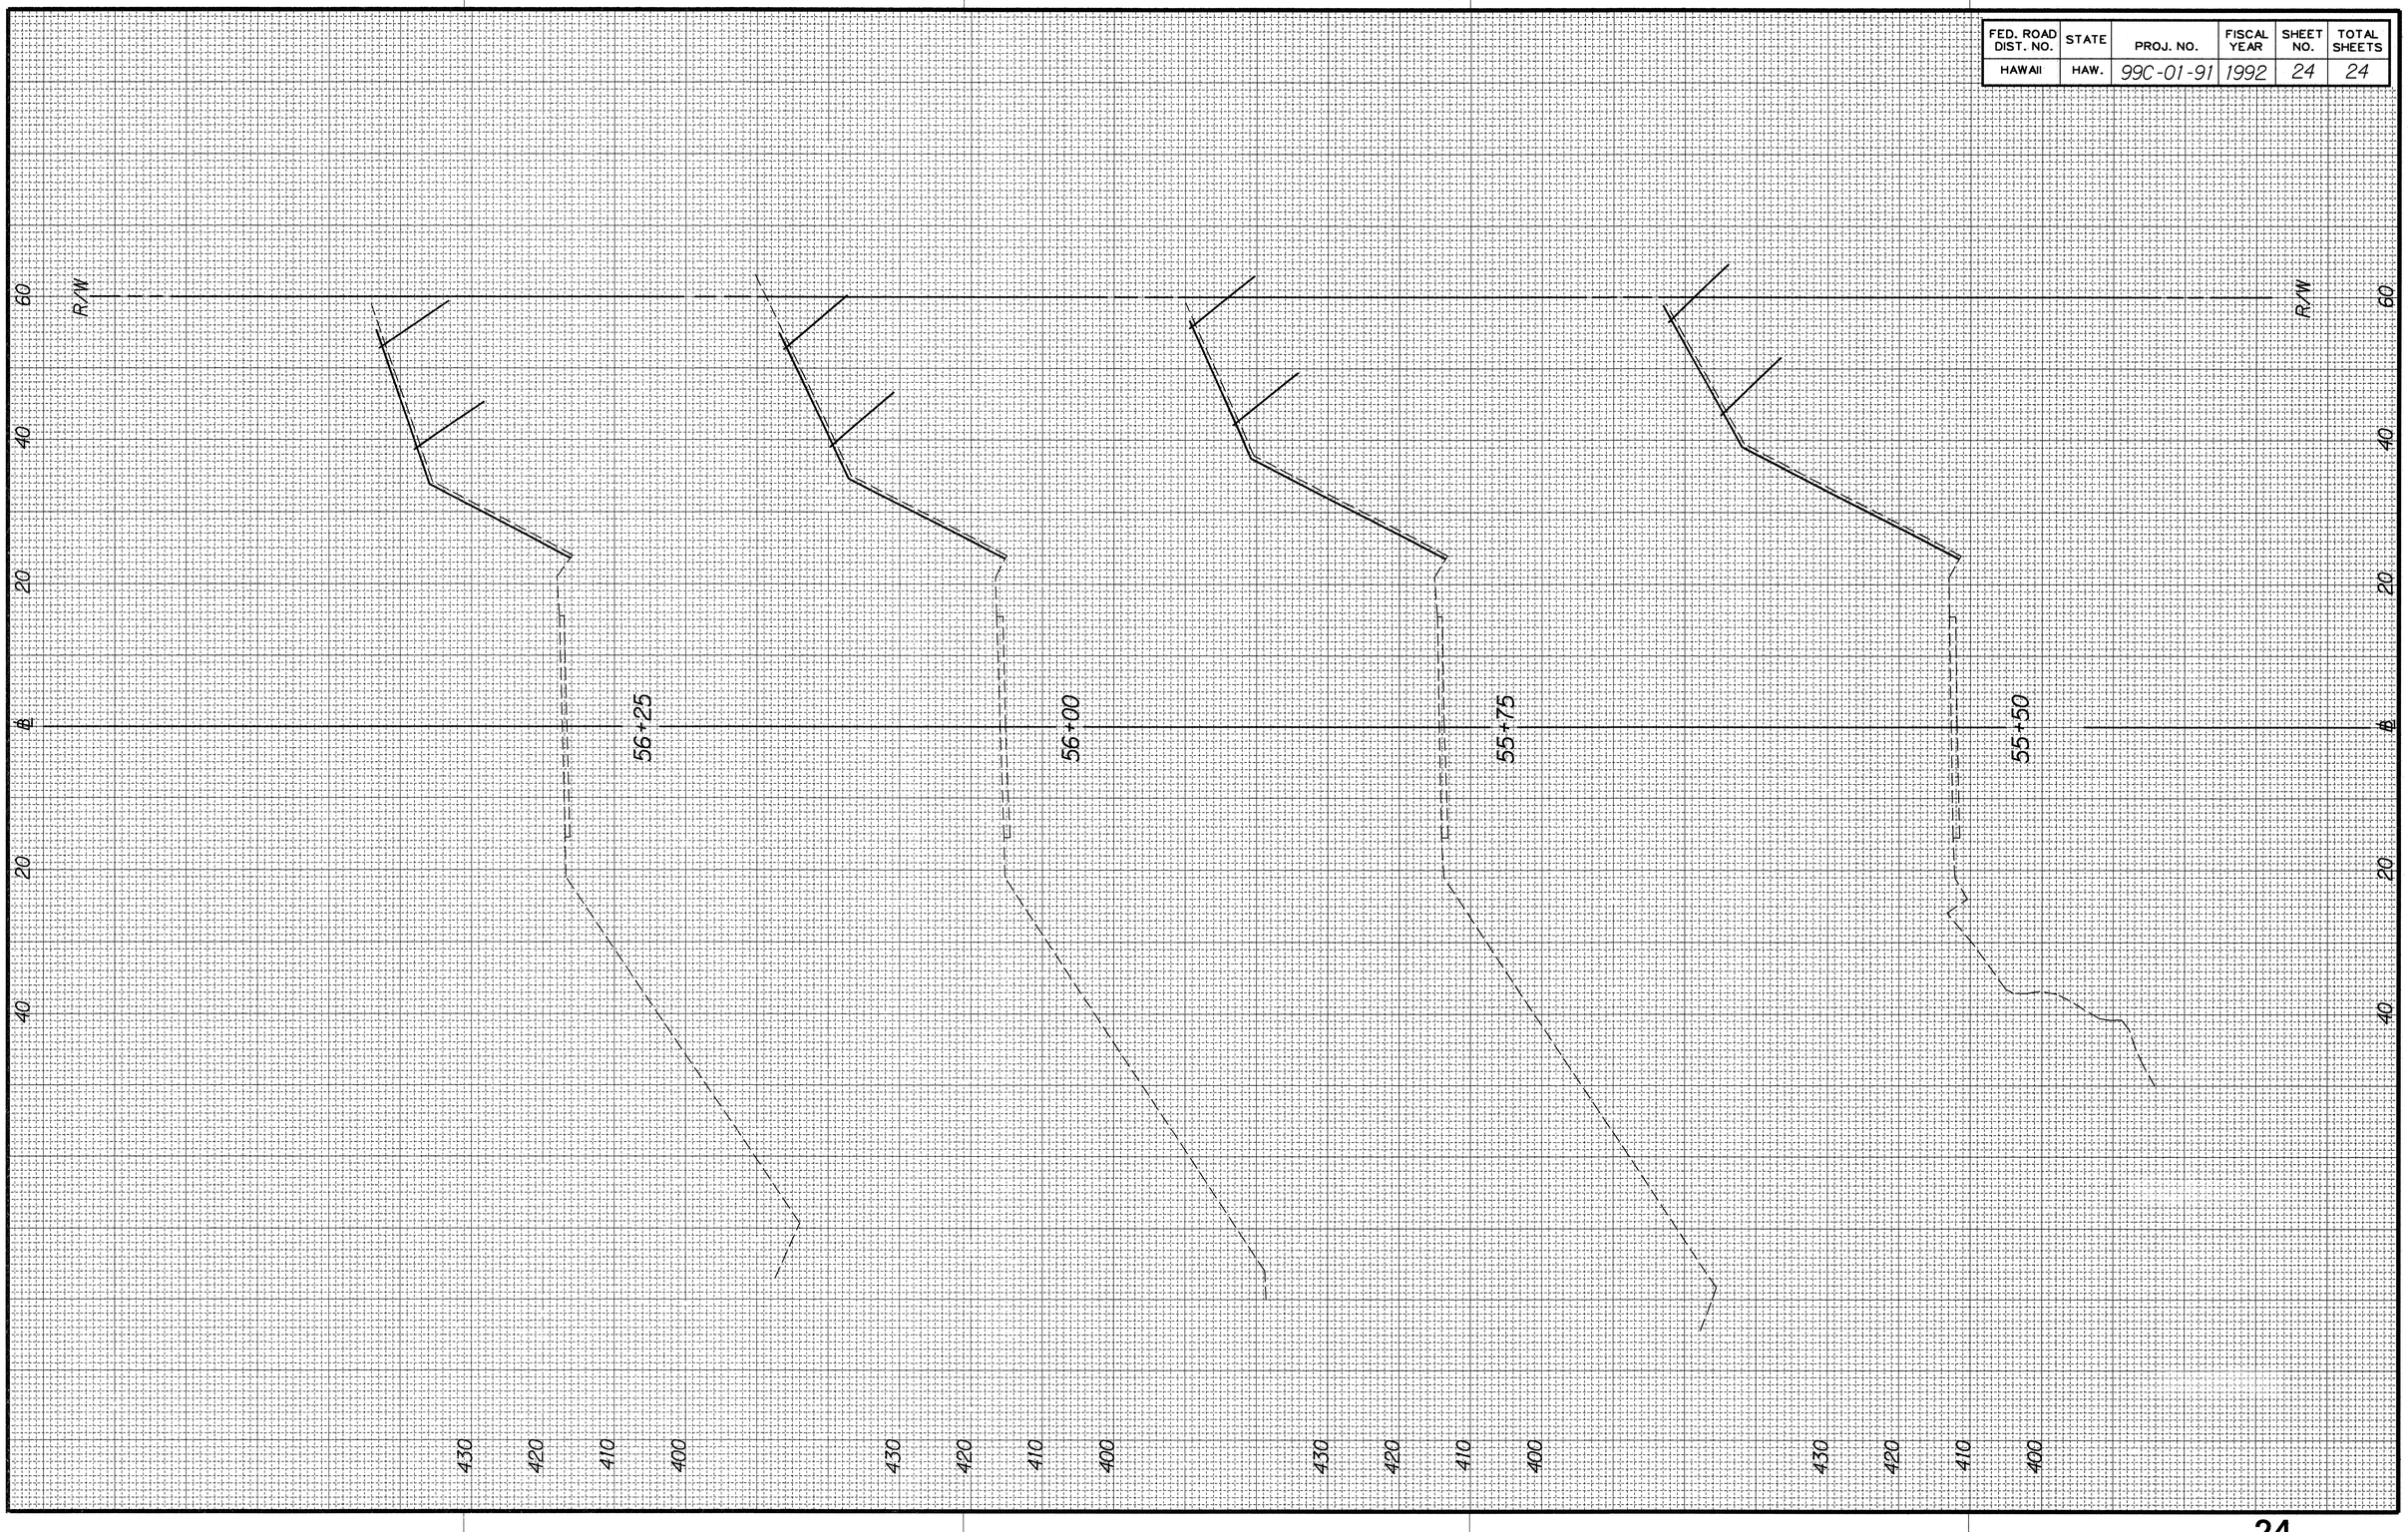

ORIGINAL PLAN	SURVEY PLOTTED BY	DATE
	DRAWN BY	
NOTE BOOK	TRACED BY	
	DESIGNED BY	
No.	QUANTITIES BY	
	CHECKED BY	

1kamdxs17.dgn 4/164/92