| FED. ROAD DIST. NO. | STATE | PROJ. NO. | FISCAL YEAR | SHEET NO. | TOTAL SHEETS |
|---|---|---|---|---|---|
| HAWAII | HAW. | 99C-01-91 | 1992 | 1 | 24 |

99

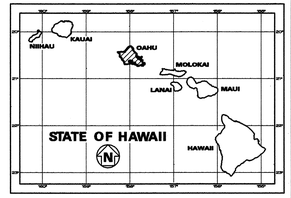


## INDEX TO DRAWINGS


| SHEET NO. | DESCRIPTION |
|---|---|
| 1 | TITLE SHEET |
| 2 | STANDARD PLANS SUMMARY SHEET |
| 3 – 4 | SAFETY IMPROVEMENT DETAILS AND GENERAL NOTES |
| 5 – 6 | ROCKFALL PROTECTION NETTING DETAILS |
| 7 – 8 | ROADWAY PLAN |
| 9 – 24 | CROSS SECTIONS |


STATE OF HAWAII

# DEPARTMENT OF TRANSPORTATION

HIGHWAYS DIVISION

HONOLULU, HAWAII

"AS-BUILT"

PLANS FOR

# KAMEHAMEHA HIGHWAY

## SAFETY IMPROVEMENTS
## KIPAPA GULCH TOWARDS MILILANI

## PROJECT NO. 99C–01–91

DISTRICT OF EWA

ISLAND OF OAHU

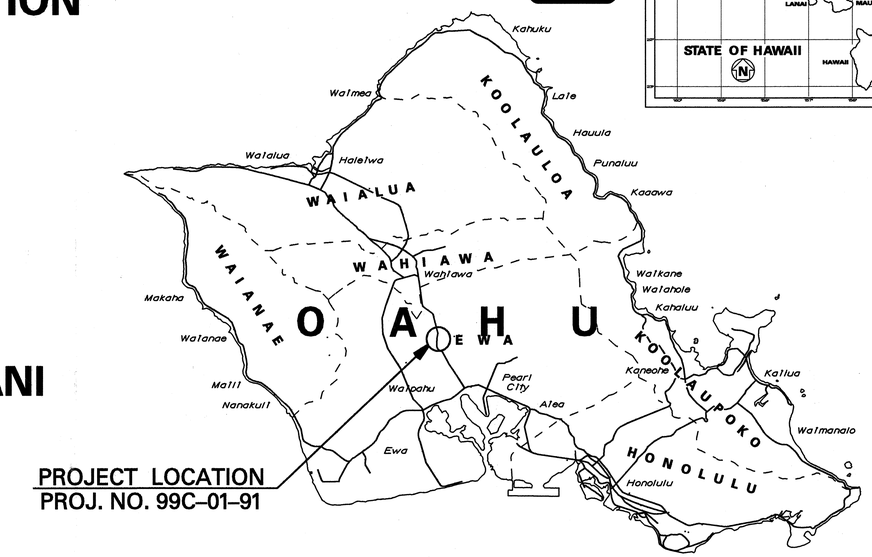


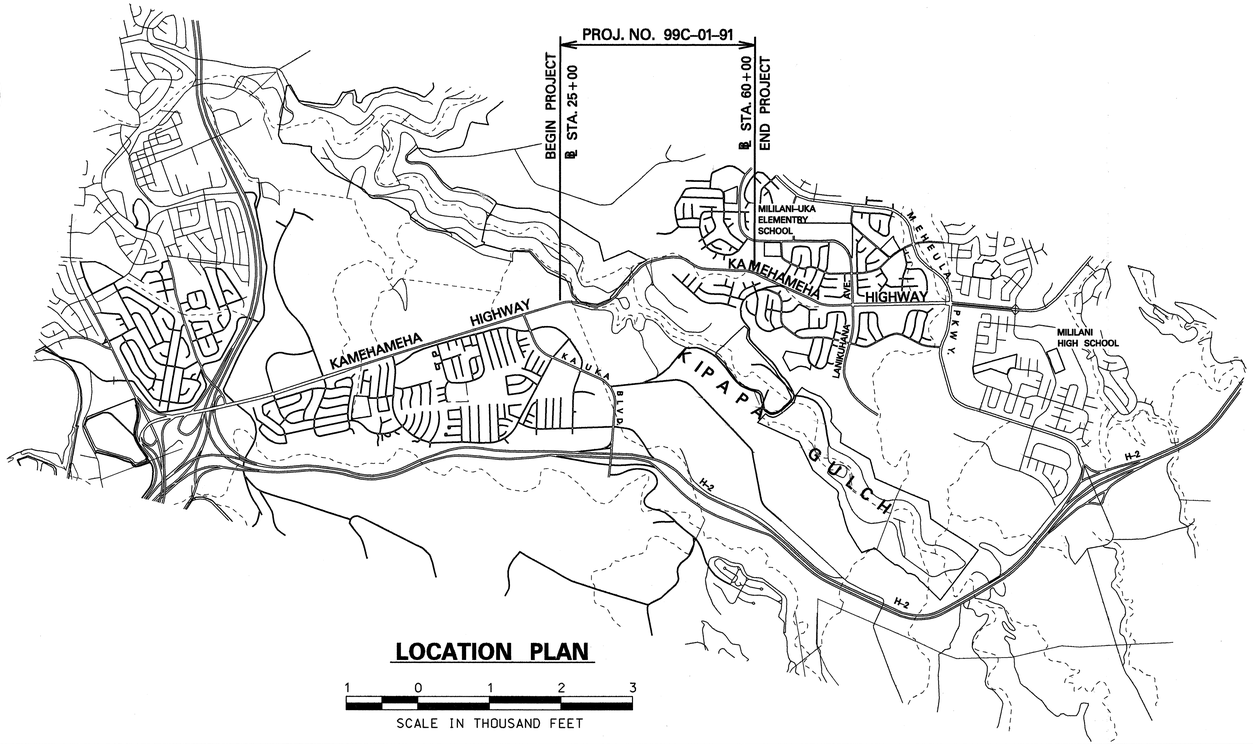


LOCATION PLAN

1 0 1 2 3

SCALE IN THOUSAND FEET

N

4 0 4 8

SCALE IN MILES

MILE POST 15.19 TO MILE POST 16.27

CHANGES MADE DURING CONSTRUCTION HAVE BEEN INCORPORATED ON THESE PLANS EXCEPT CHANGES IN THE ORIGINAL THEORETICAL QUANTITIES. FOR ACTUAL QUANTITIES REFER TO PROJECT LEDGER AND/OR COMPUTATION BOOK.

Kelvin Akazawa — 4-22-97

FOR RESIDENT ENGINEER — DATE

| | | | |
|---|---|---|---|
| UNIT "E" | R. TAKAESU | 587-2249 | AUG., 1991 |
| DESIGNED BY | P. S. & E. BY | PHONE | DATE |

DEPARTMENT OF TRANSPORTATION
STATE OF HAWAII

APPROVED:

F. Harano — 4/27/92

FOR DIR. OF TRANSPORTATION — DATE



Ikamatsu Ann 4-16-92