


FED. ROAD DIST. NO.	STATE	FED. AID PROJ. NO.	FISCAL YEAR	SHEET NO.	TOTAL SHEETS
HAWAII	HAW.	NH-099-1(14)	1995	11	22


ORIGINAL PLAN	SURVEY PLOTTED BY	DATE
NOTE BOOK	DRAWN BY	1/25/95
DESIGNED BY	DESIGNED BY	
QUANTITIES BY	QUANTITIES BY	
CHECKED BY	CHECKED BY	

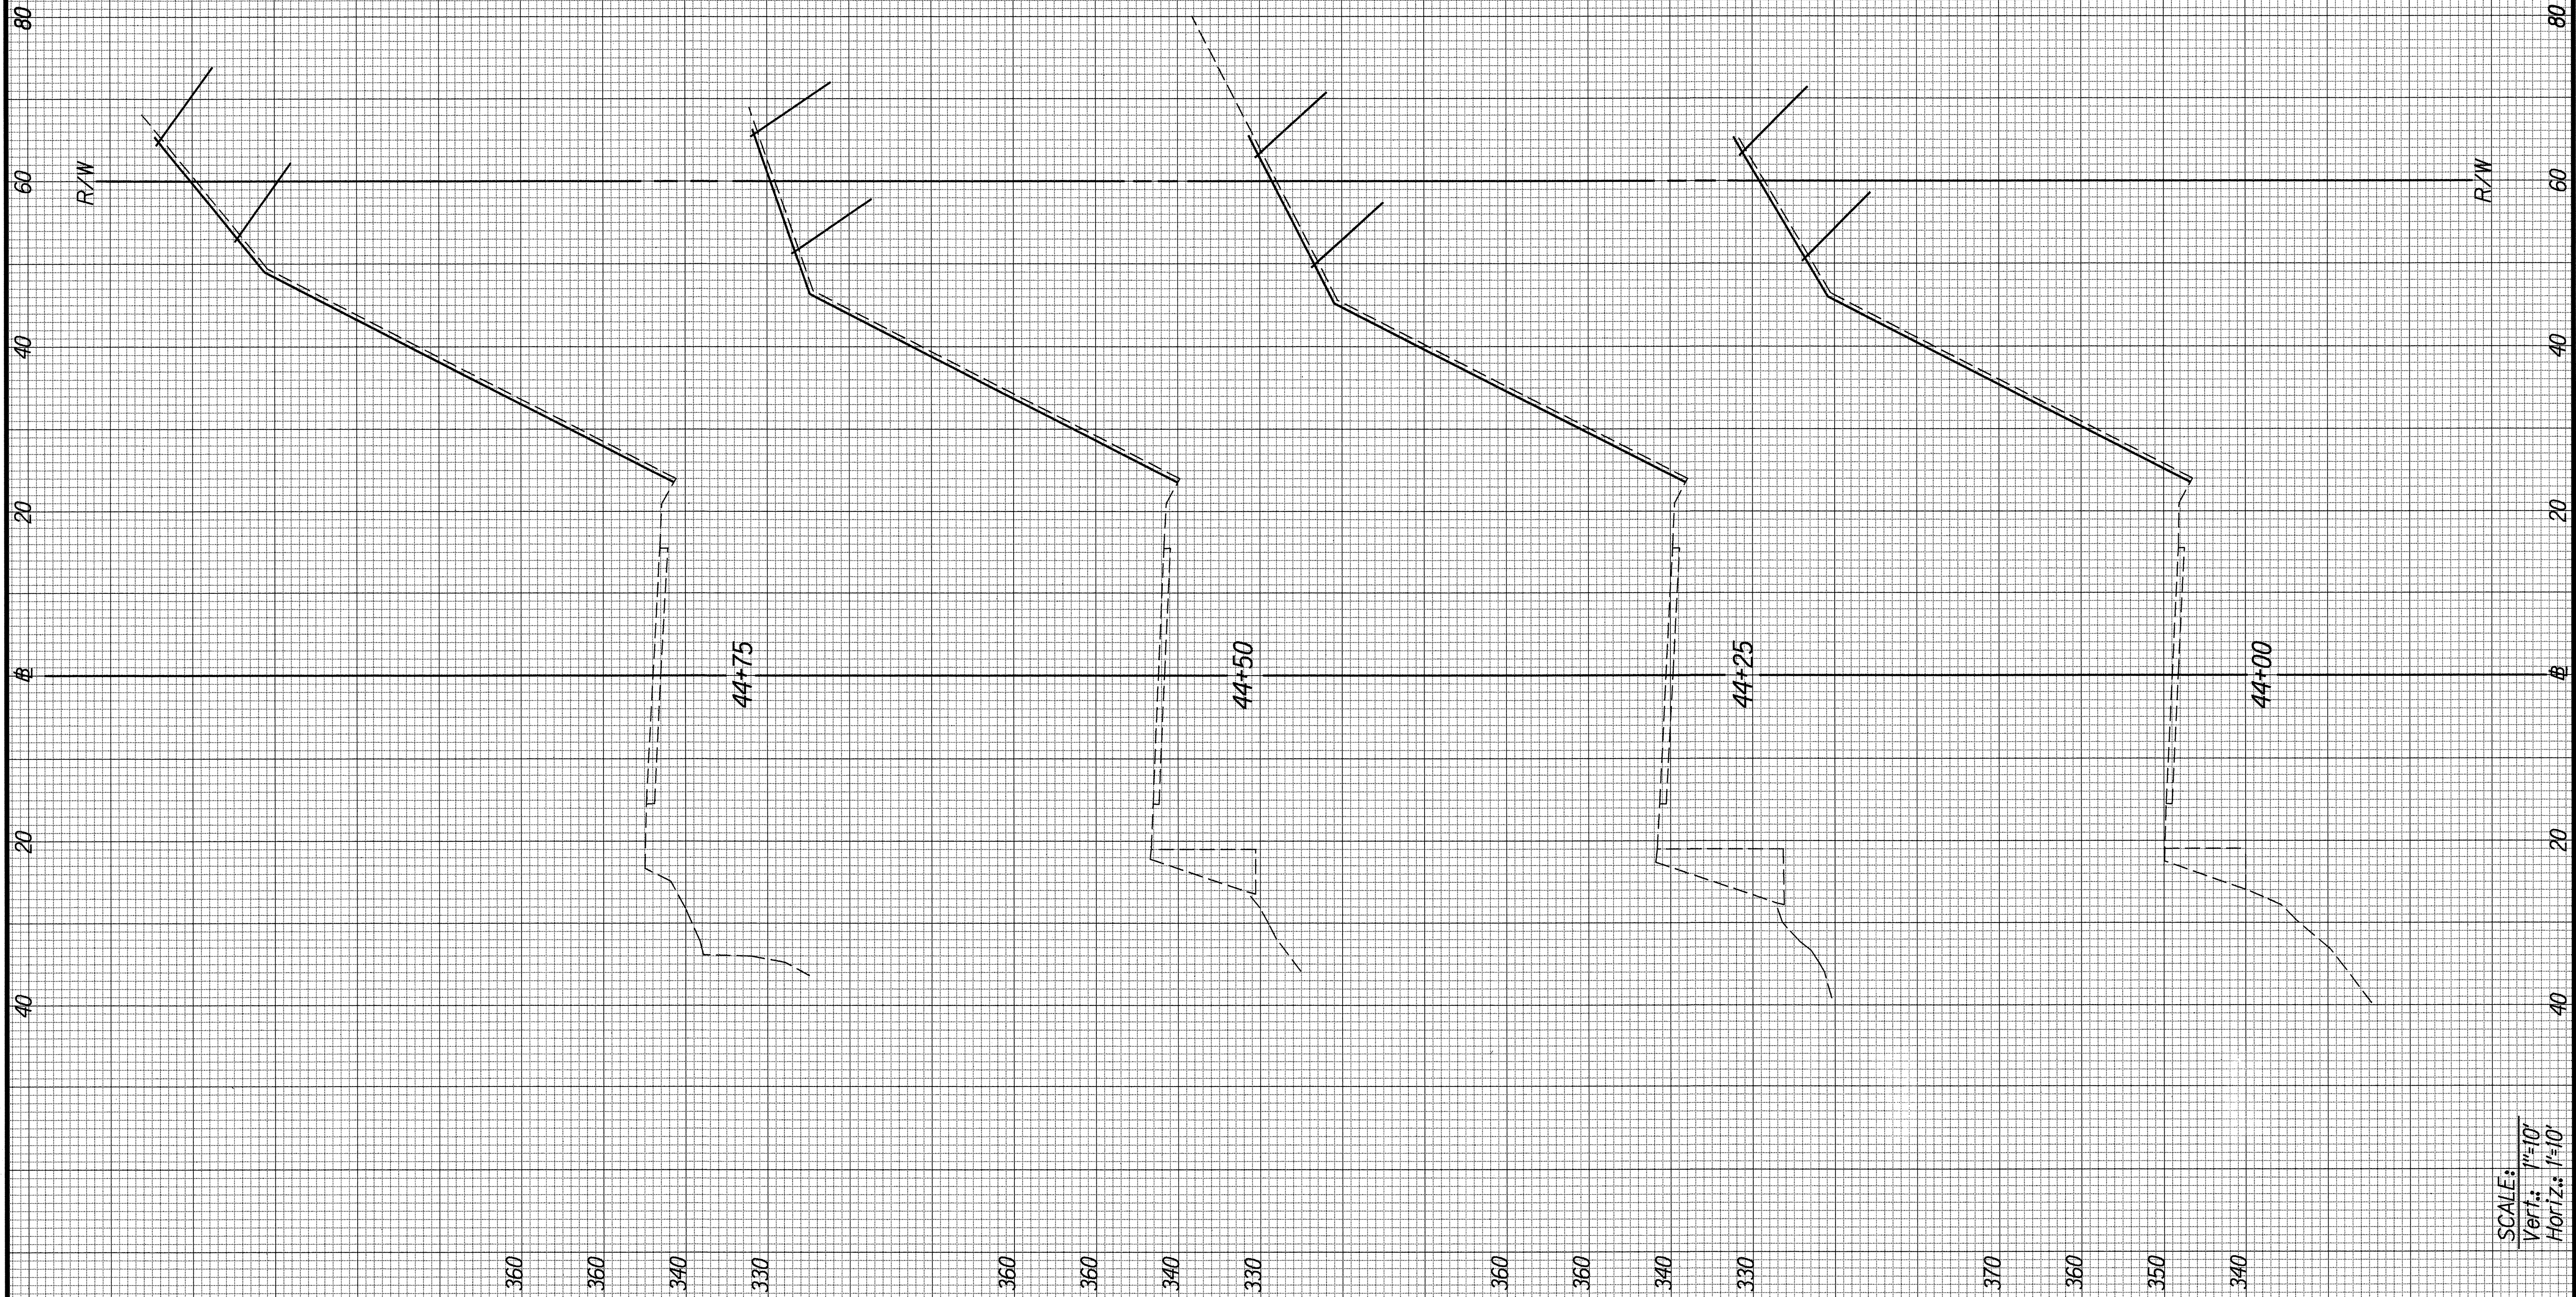

SCALE:
 Vert.: 1"=10'
 Horiz.: 1"=10'


ORIGINAL
PLAN
SURVEY PLOTTED BY
DATE
1/25/05
DESIGNED BY
J. Fujimoto
CHECKED BY
J. Fujimoto

FED. ROAD DIST. NO.	STATE	FED. AID PROJ. NO.	FISCAL YEAR	SHEET NO.	TOTAL SHEETS
HAWAII	HAW.	NH-099-1(14)	1995	12	22

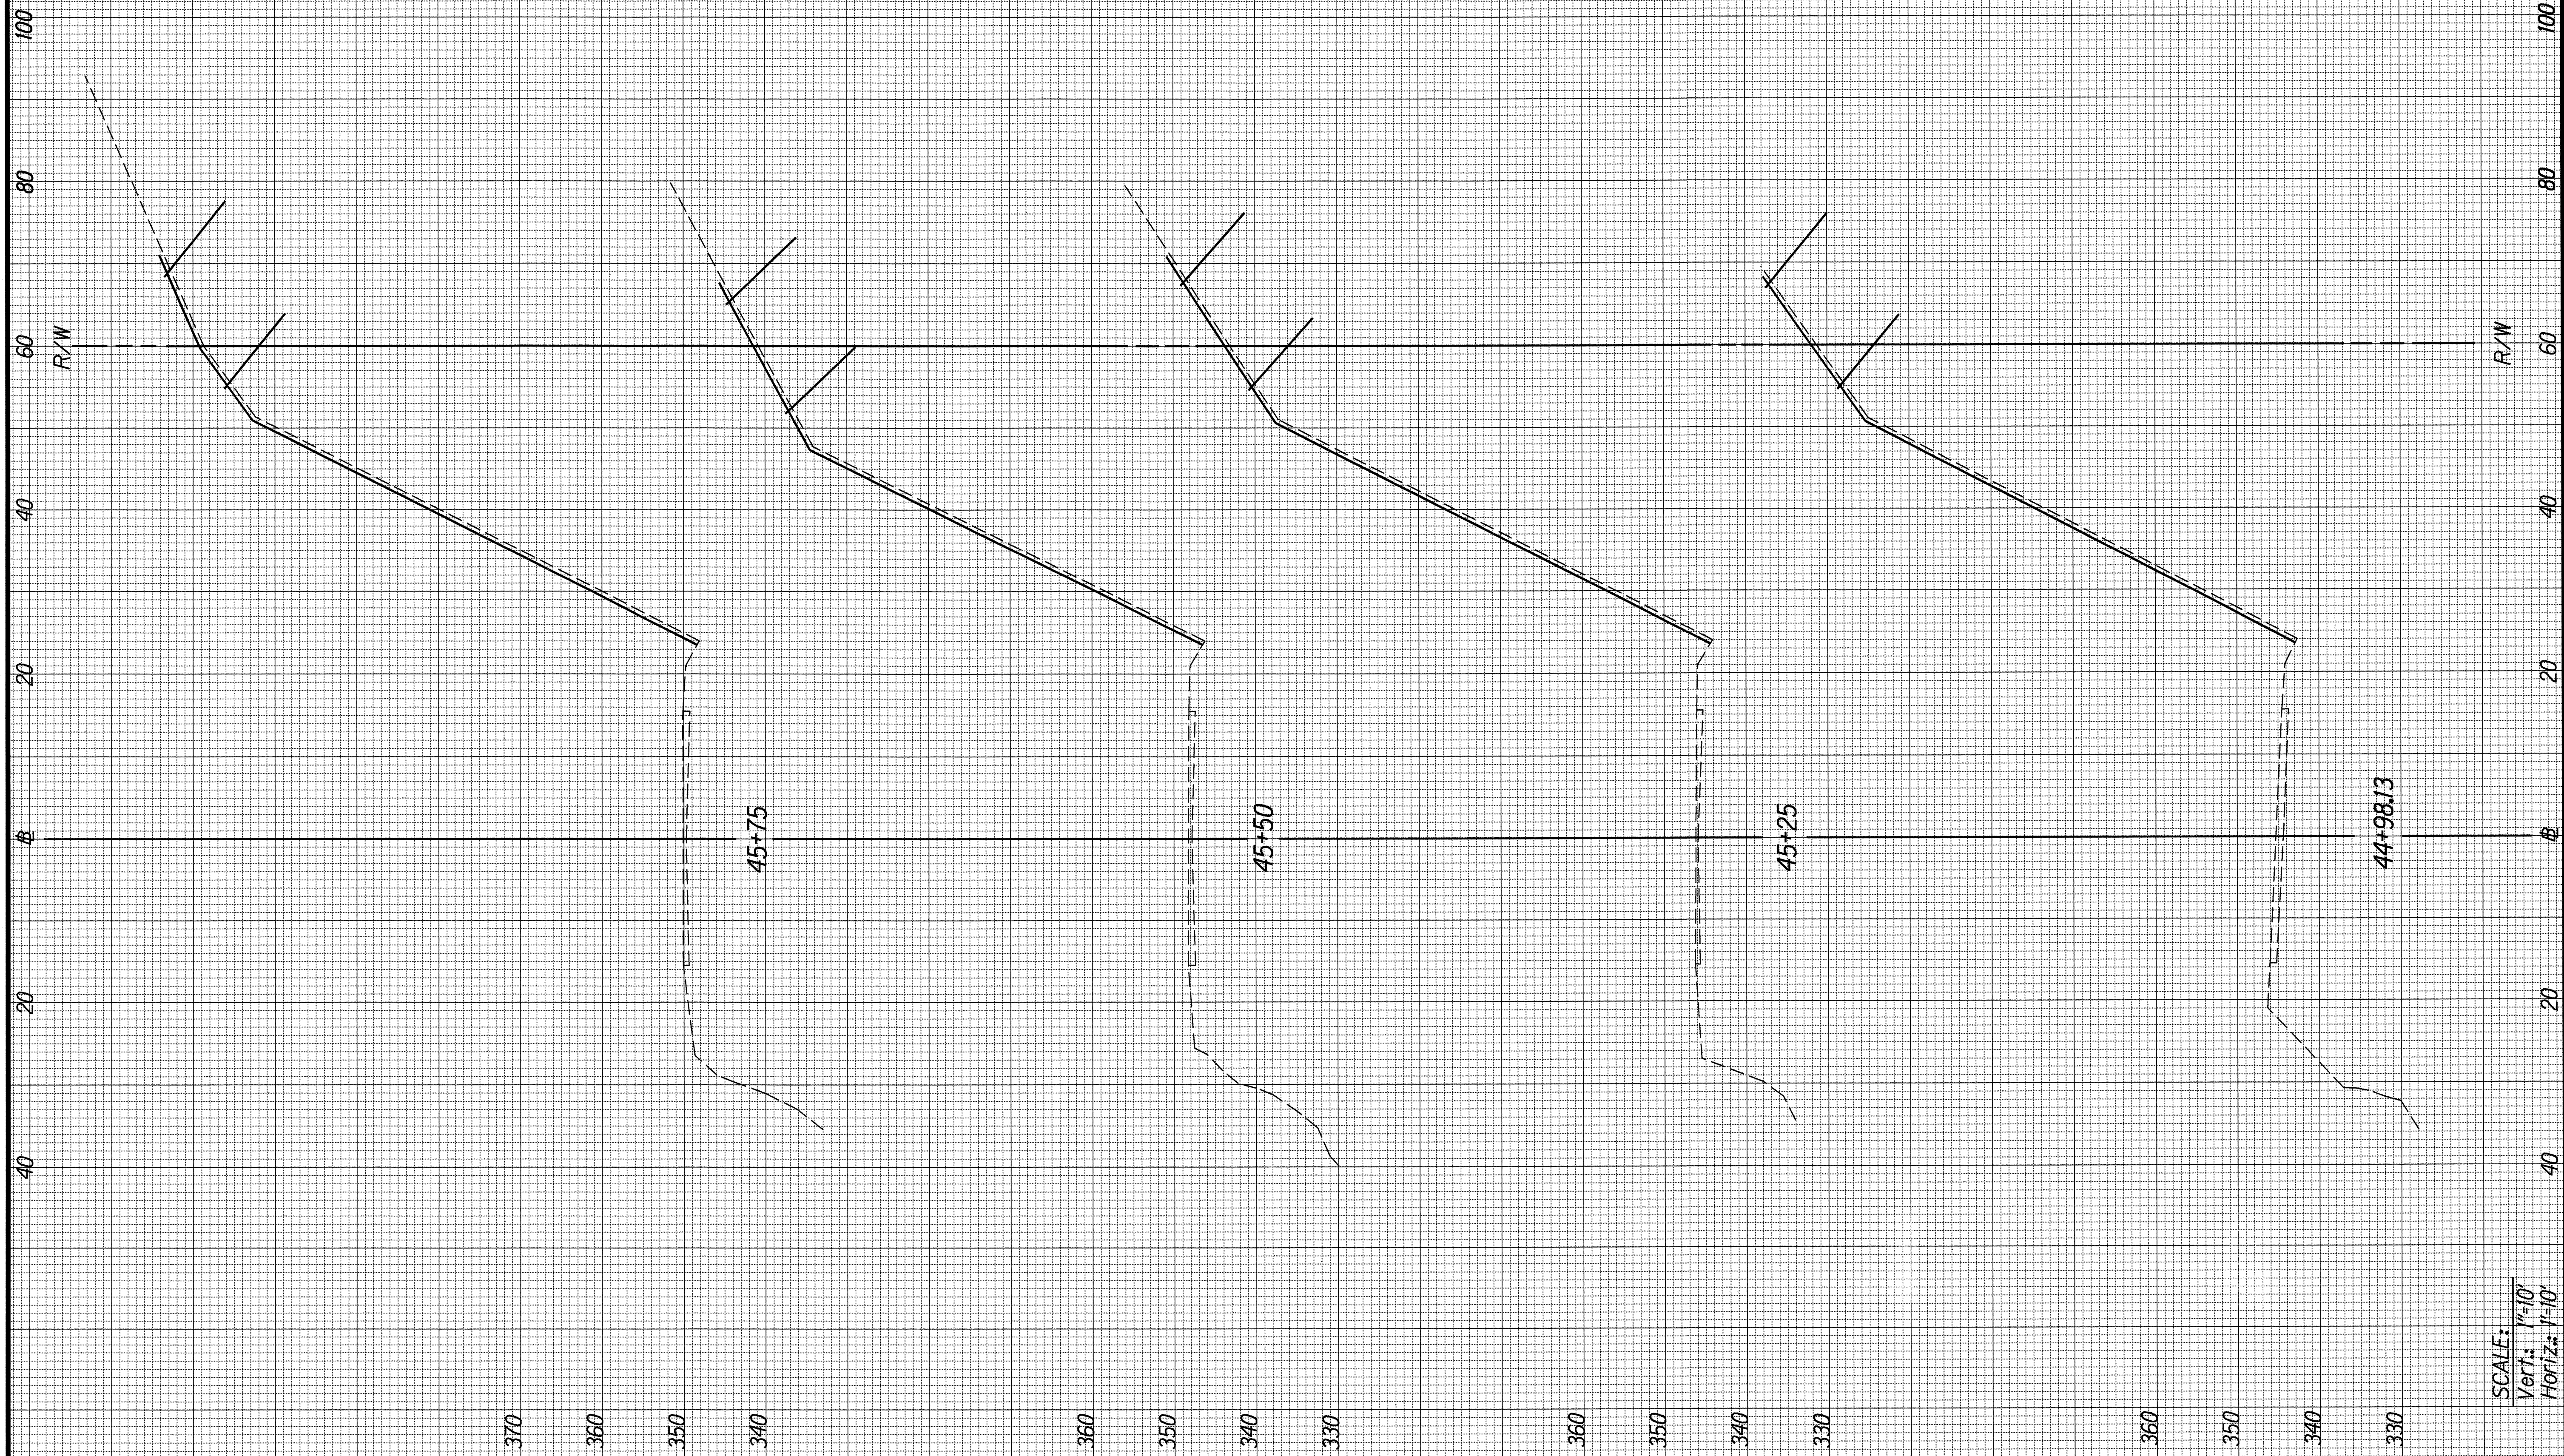

SCALE:
Vert.: 1"=10'
Horiz.: 1"=10'

ORIGINAL
PLAN
DATE: 1/25/95
DESIGNED BY: L. Lullimoch/Ch. Lantieri
CHECKED BY: J. Lantieri
NOTE BOOK
QUANTITIES BY: J. Lantieri
CHECKED BY: J. Lantieri

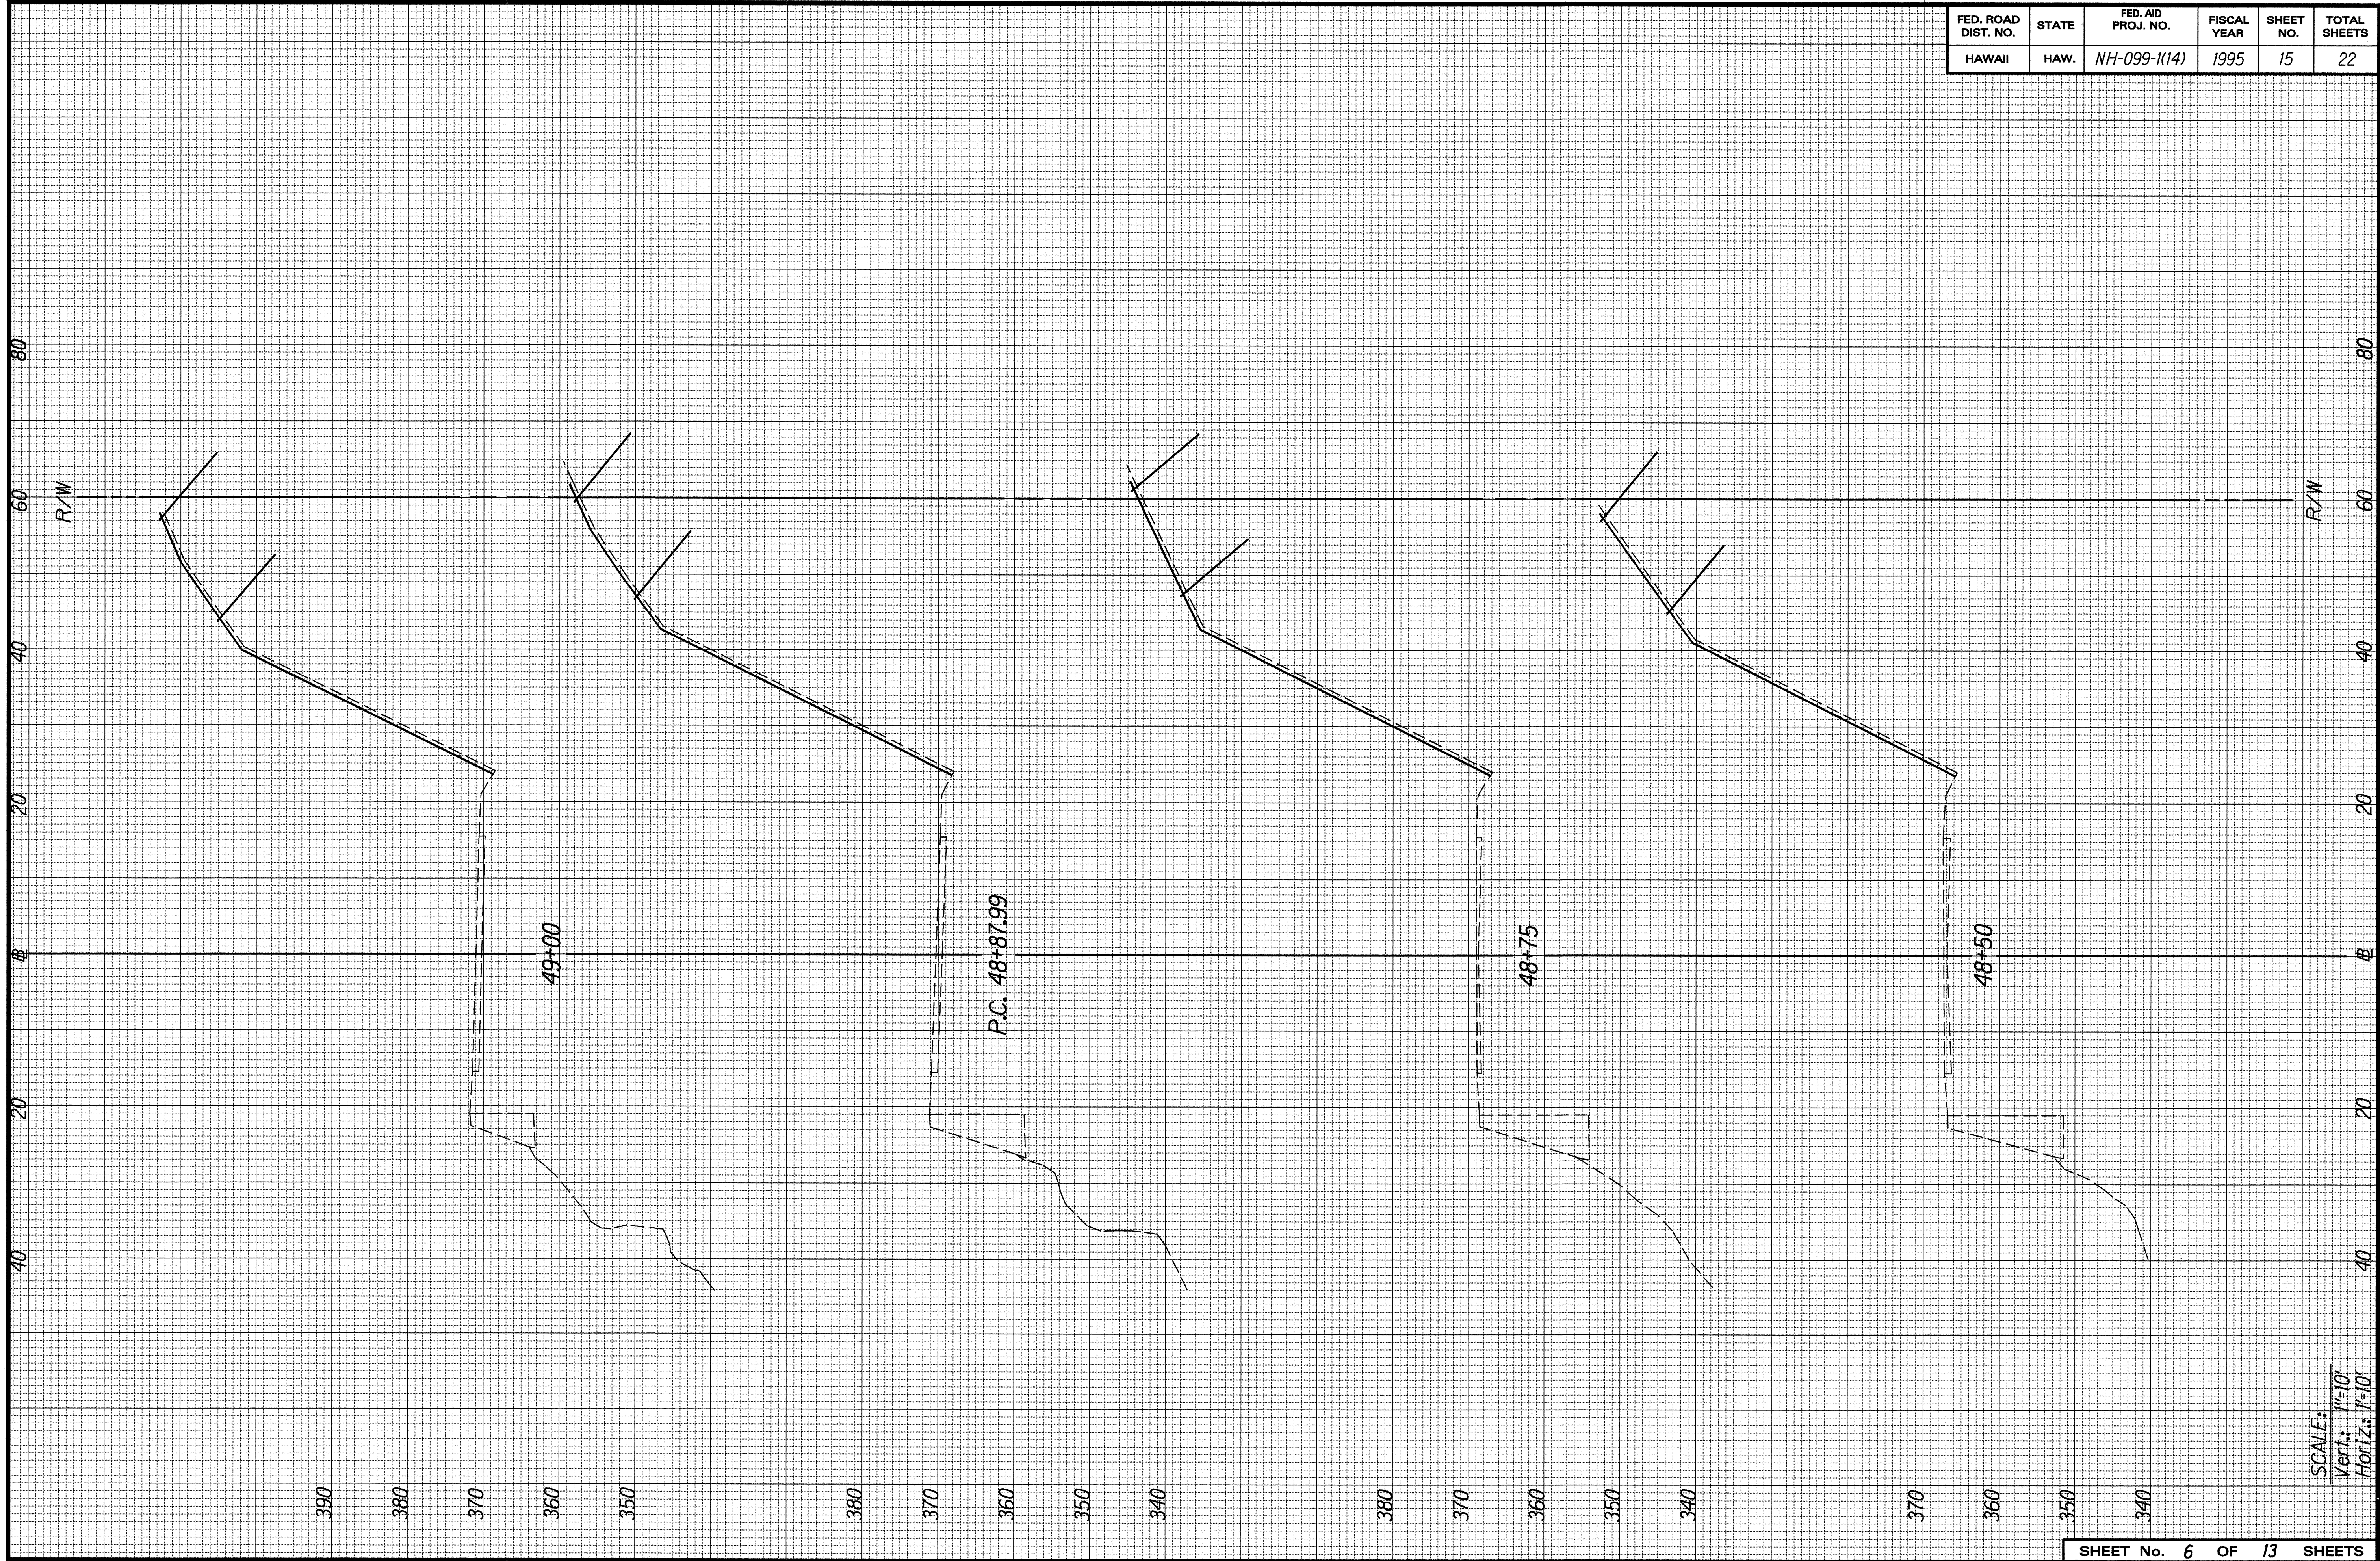


FED. ROAD DIST. NO.	STATE	FED. AID PROJ. NO.	FISCAL YEAR	SHEET NO.	TOTAL SHEETS
HAWAII	HAW.	NH-099-1(14)	1995	15	22

SCALE: 1"=10'
Vert.: 1"=10'
Horiz.: 1"=10'

ORIGINAL PLAN
DRAWN BY: JMEI
DATE: 1/25/95
NOTE BOOK
DESIGNED BY: L. Lullmoa/L. Iannouchi
QUANTITIES BY:
CHECKED BY:
dubgpo/ge
Hawmcs/ST.dgn


FED. ROAD DIST. NO.	STATE	FED. AID PROJ. NO.	FISCAL YEAR	SHEET NO.	TOTAL SHEETS
HAWAII	HAW.	NH-099-1(14)	1995	16	22

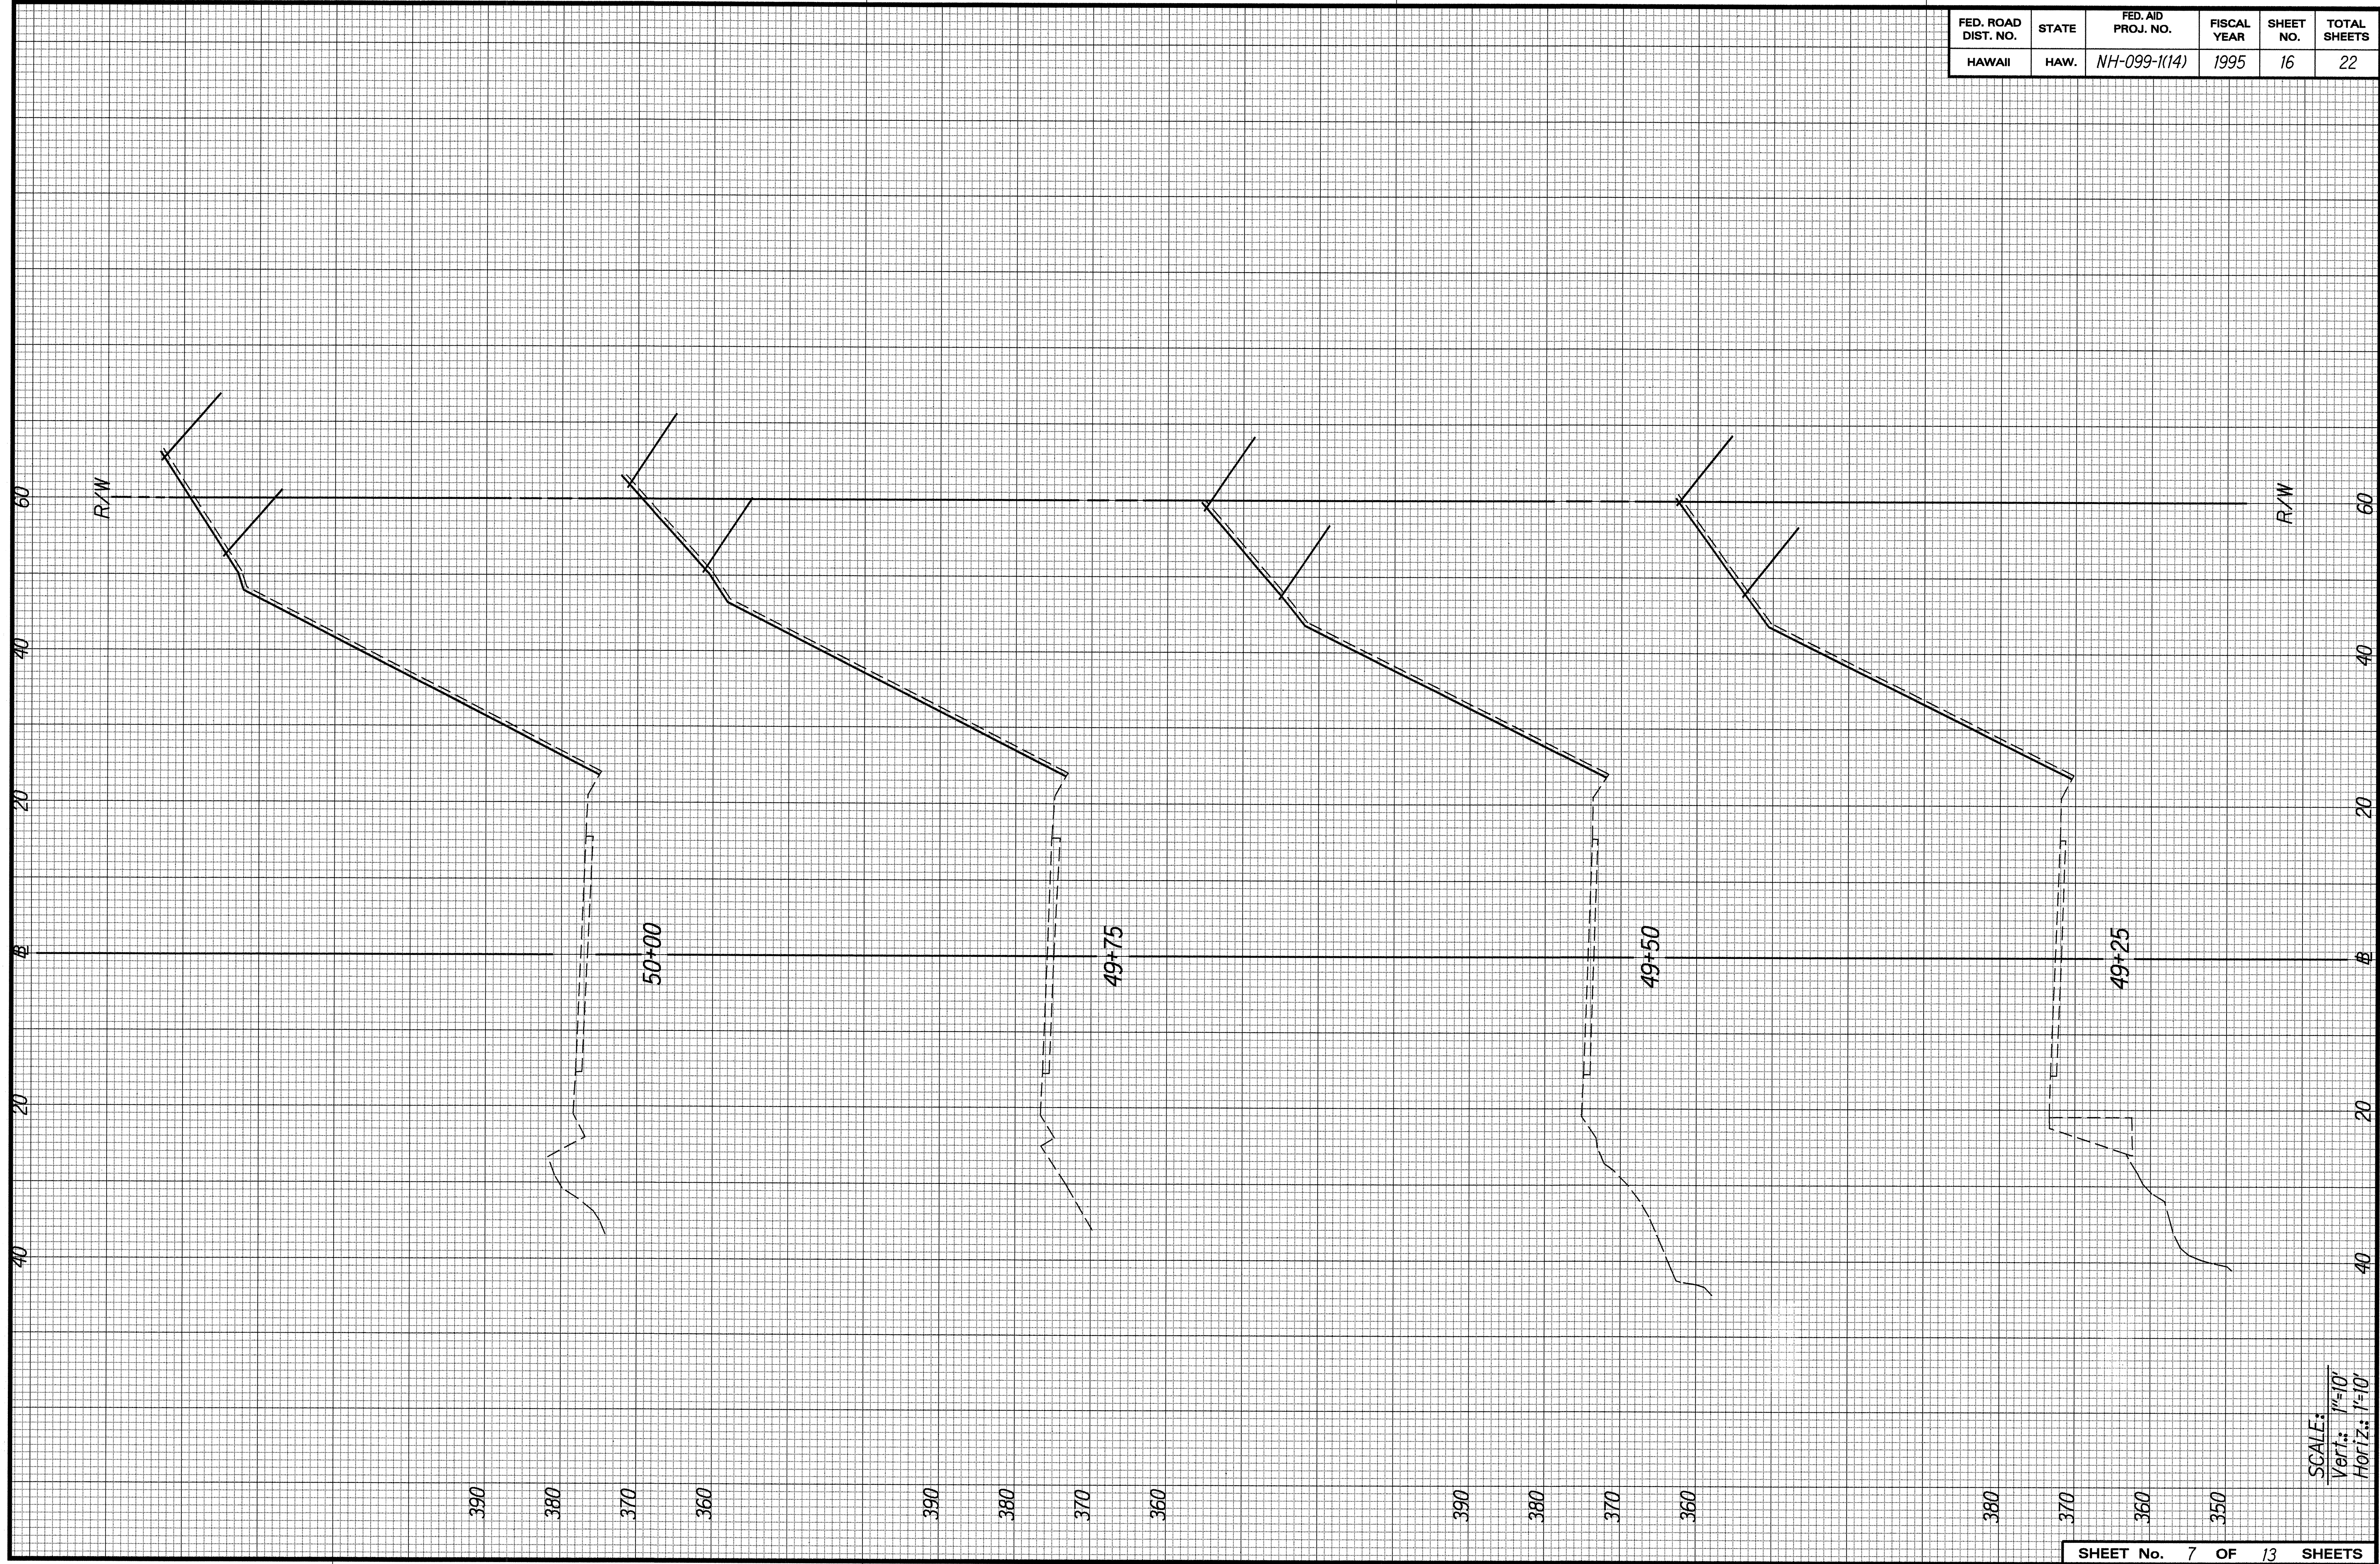

SCALE:
Vert: 1"=10'
Horiz: 1"=10'


ORIGINAL
PLAN
SURVEY PLOTTED BY _____ DATE: 1/25/95
DRAWN BY JMS
NOTED BY L. J. JAMES
DESIGNED BY L. J. JAMES
QUANTITIES BY _____
CHECKED BY _____

FED. ROAD DIST. NO.	STATE	FED. AID PROJ. NO.	FISCAL YEAR	SHEET NO.	TOTAL SHEETS

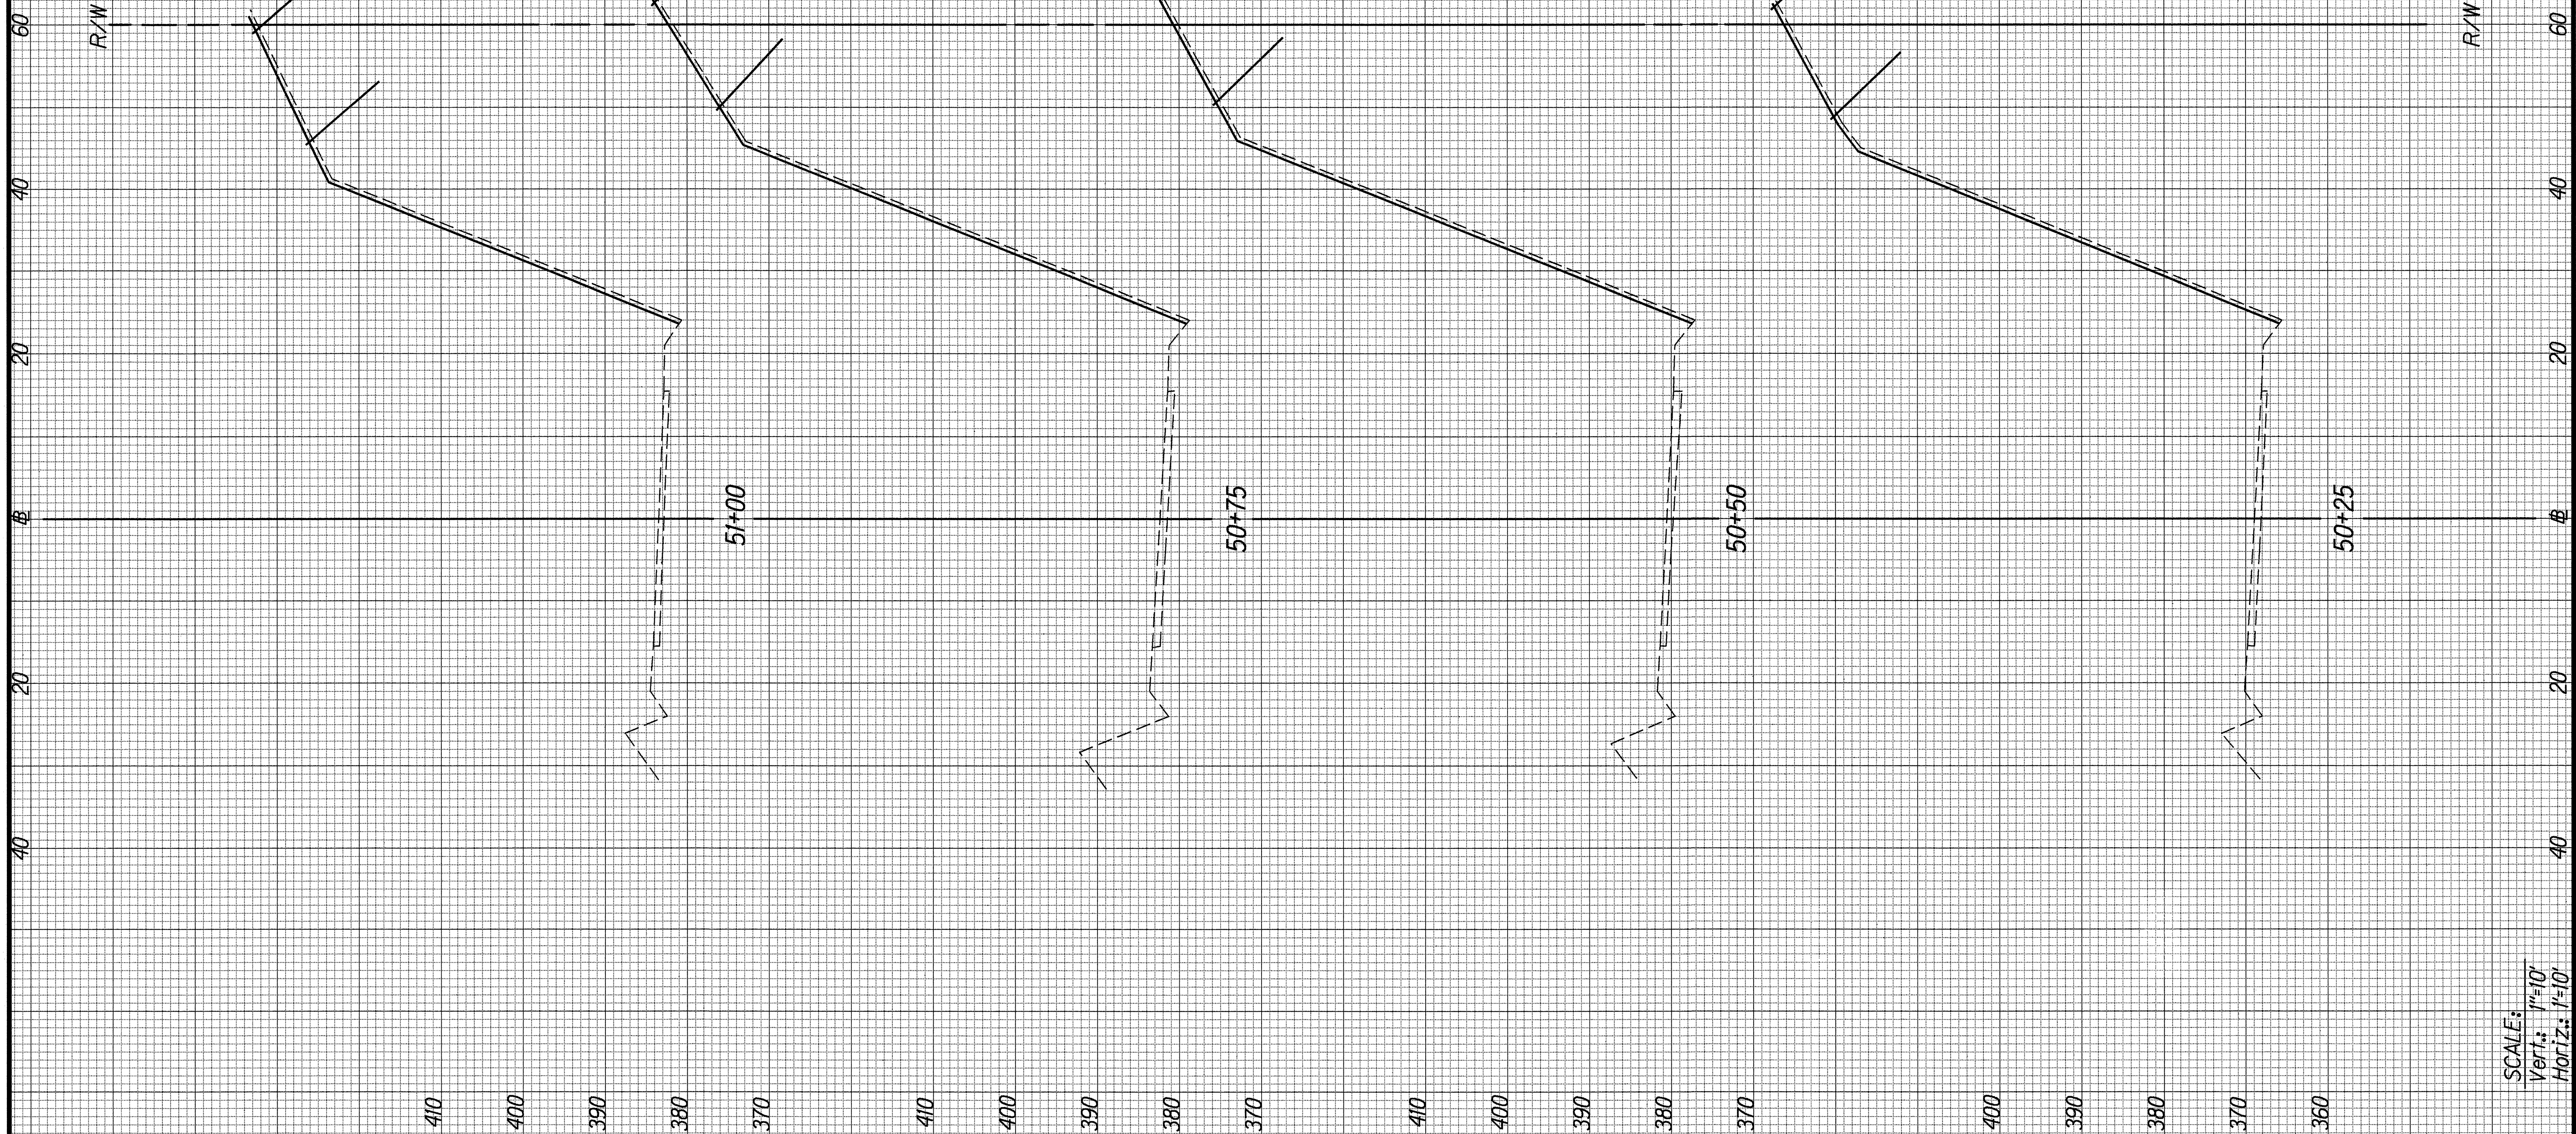

SCALE:
Vert: 1"=10'
Horiz: 1"=10'

FED. ROAD DIST. NO.	STATE	FED. AID PROJ. NO.	FISCAL YEAR	SHEET NO.	TOTAL SHEETS
HAWAII	HAW.	NH-099-1(14)	1995	18	22

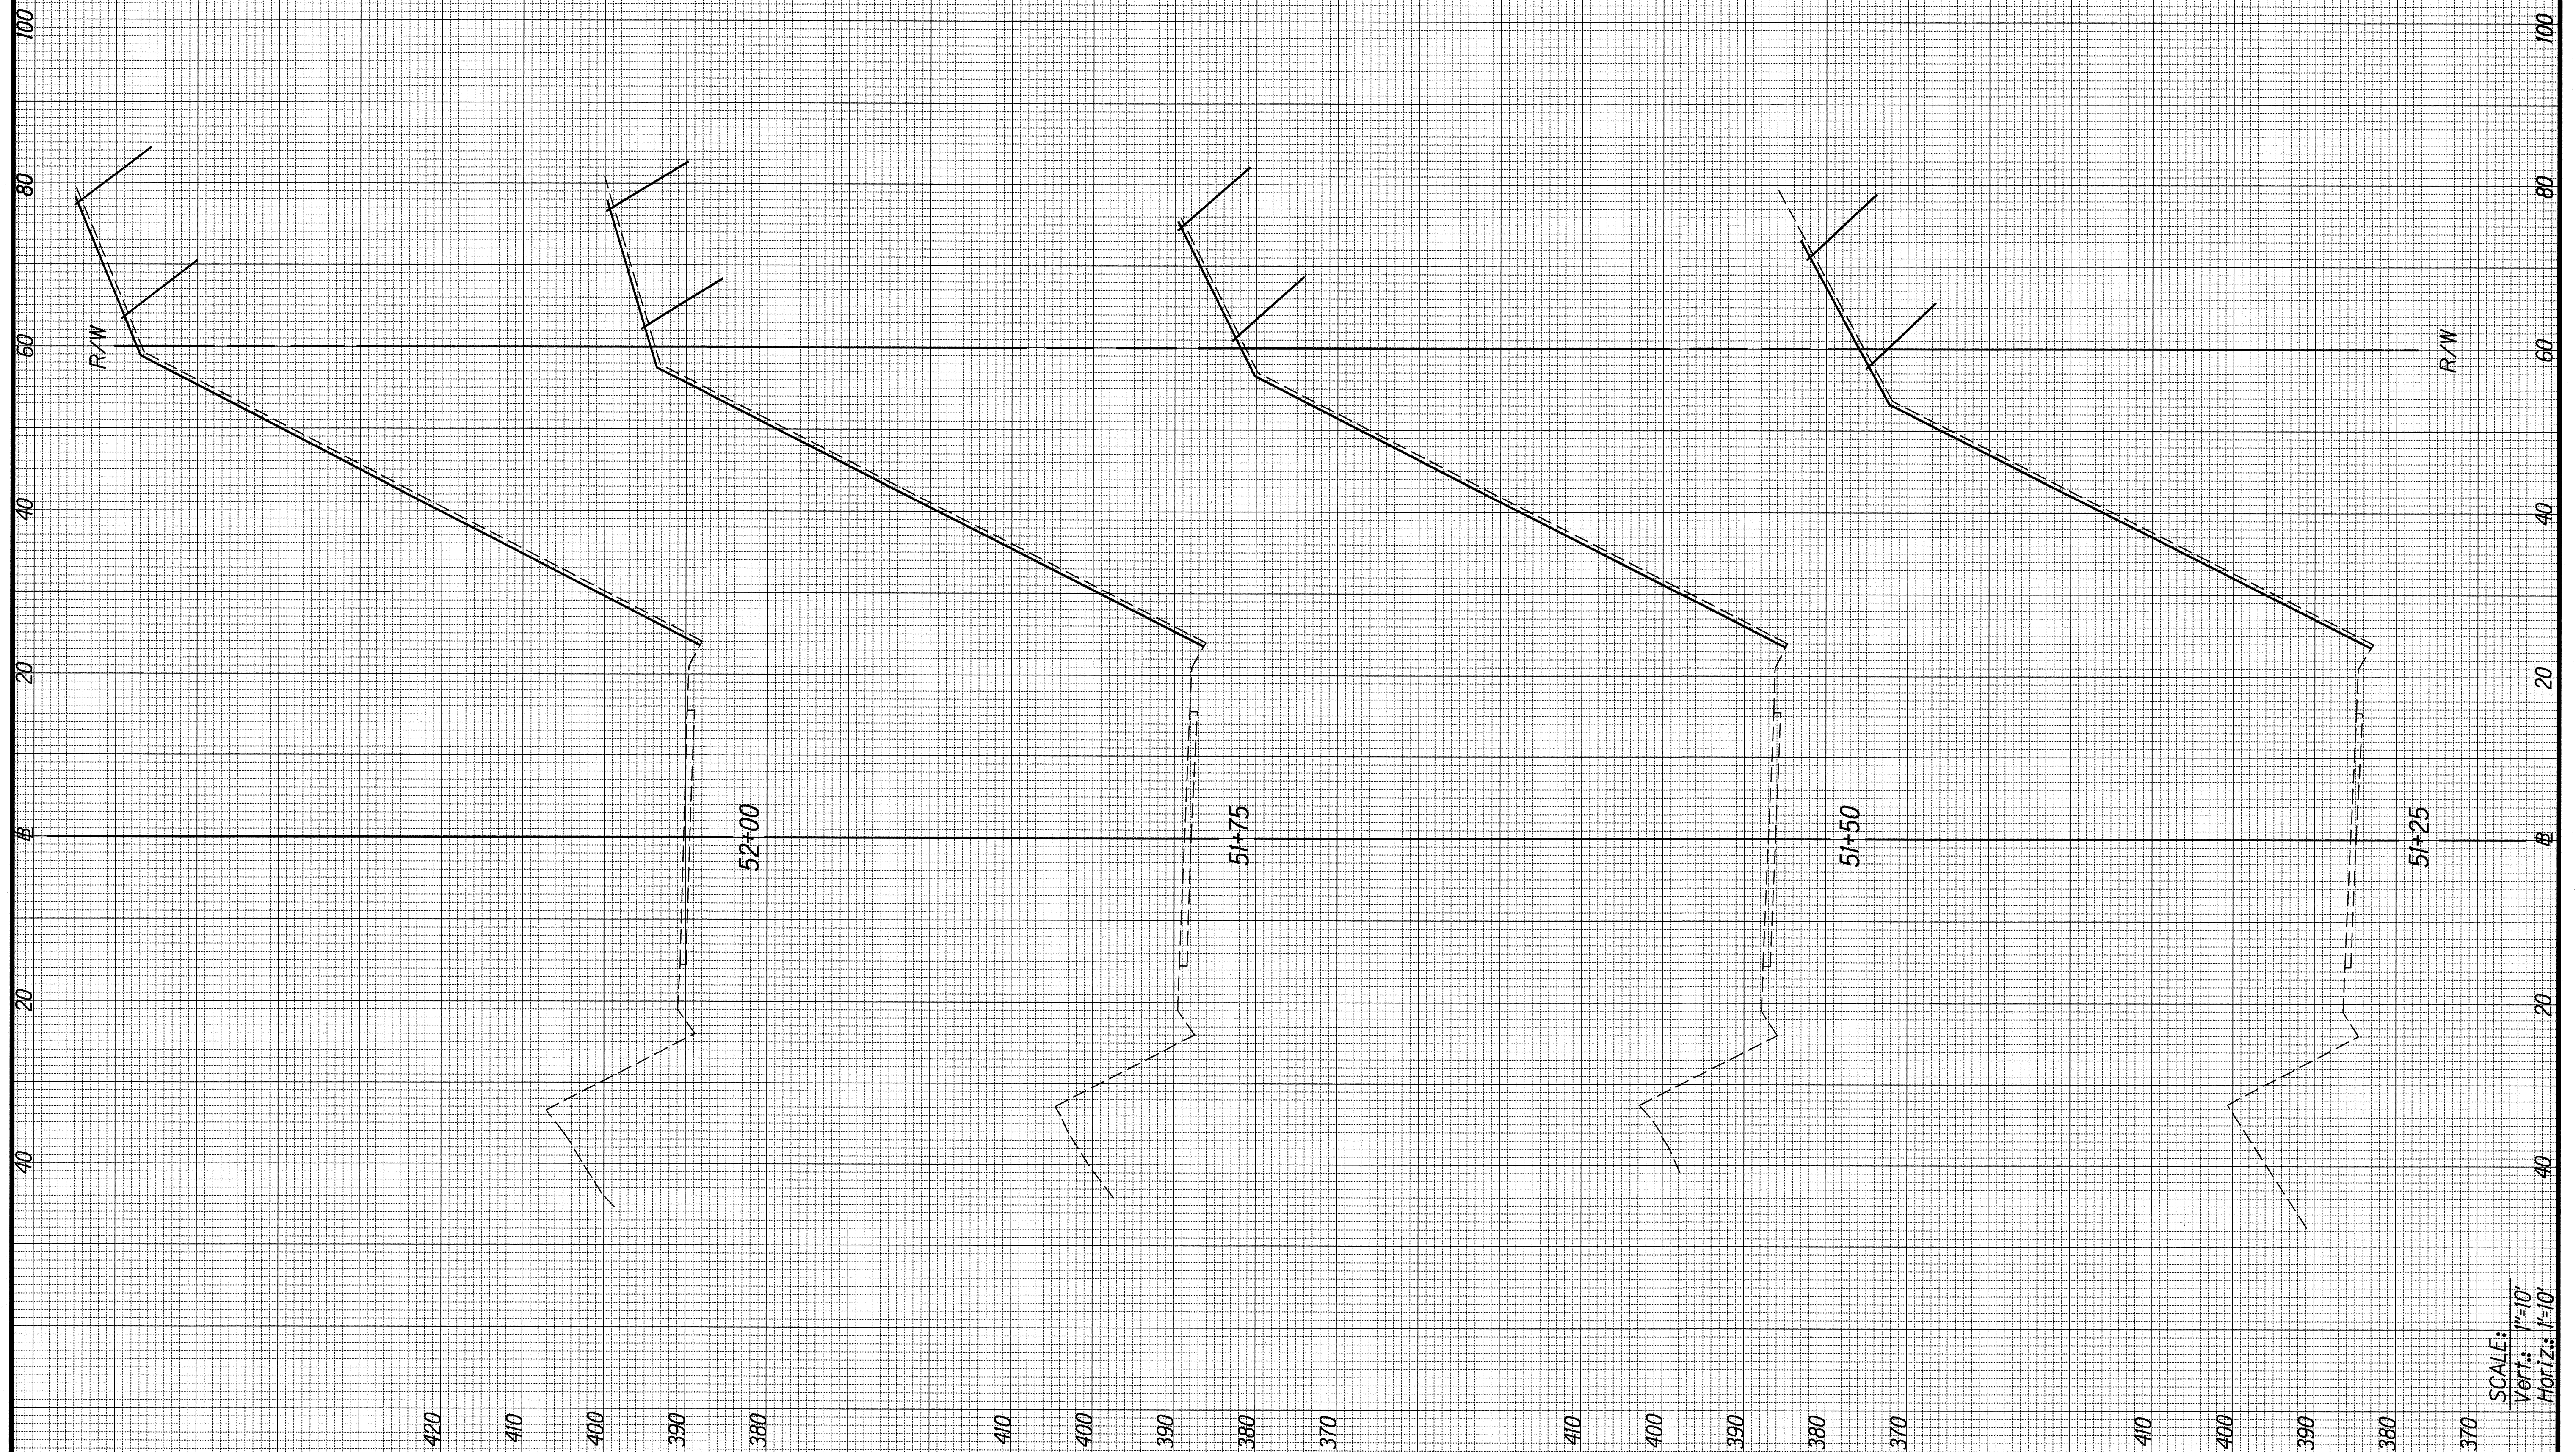


SCALE:	
Vert.:	1"=10'
Horiz.:	1"=10'

ORIGINAL PLAN	SURVEY PLOTTED BY	DATE
	DRAWN BY <i>given</i>	<i>1/25/95</i>
NOTE BOOK	TRACED BY	*
<i>dfs.george</i>	DESIGNED BY <i>J. Fujimoto/d. taniguchi</i>	*
<i>Nkandasa20gn</i>	QUANTITIES BY	*
	CHECKED BY	*


ORIGINAL
PLAN
DATE 1/25/95
DRAWN BY JMB
DESIGNED BY L. Lullimochi, L. Lullimochi
NOTE BOOK
QUANTITIES BY
CHECKED BY

FED. ROAD DIST. NO.	STATE	FED. AID PROJ. NO.	FISCAL YEAR	SHEET NO.	TOTAL SHEETS
HAWAII	HAW.	NH-099-1(14)	1995	20	22

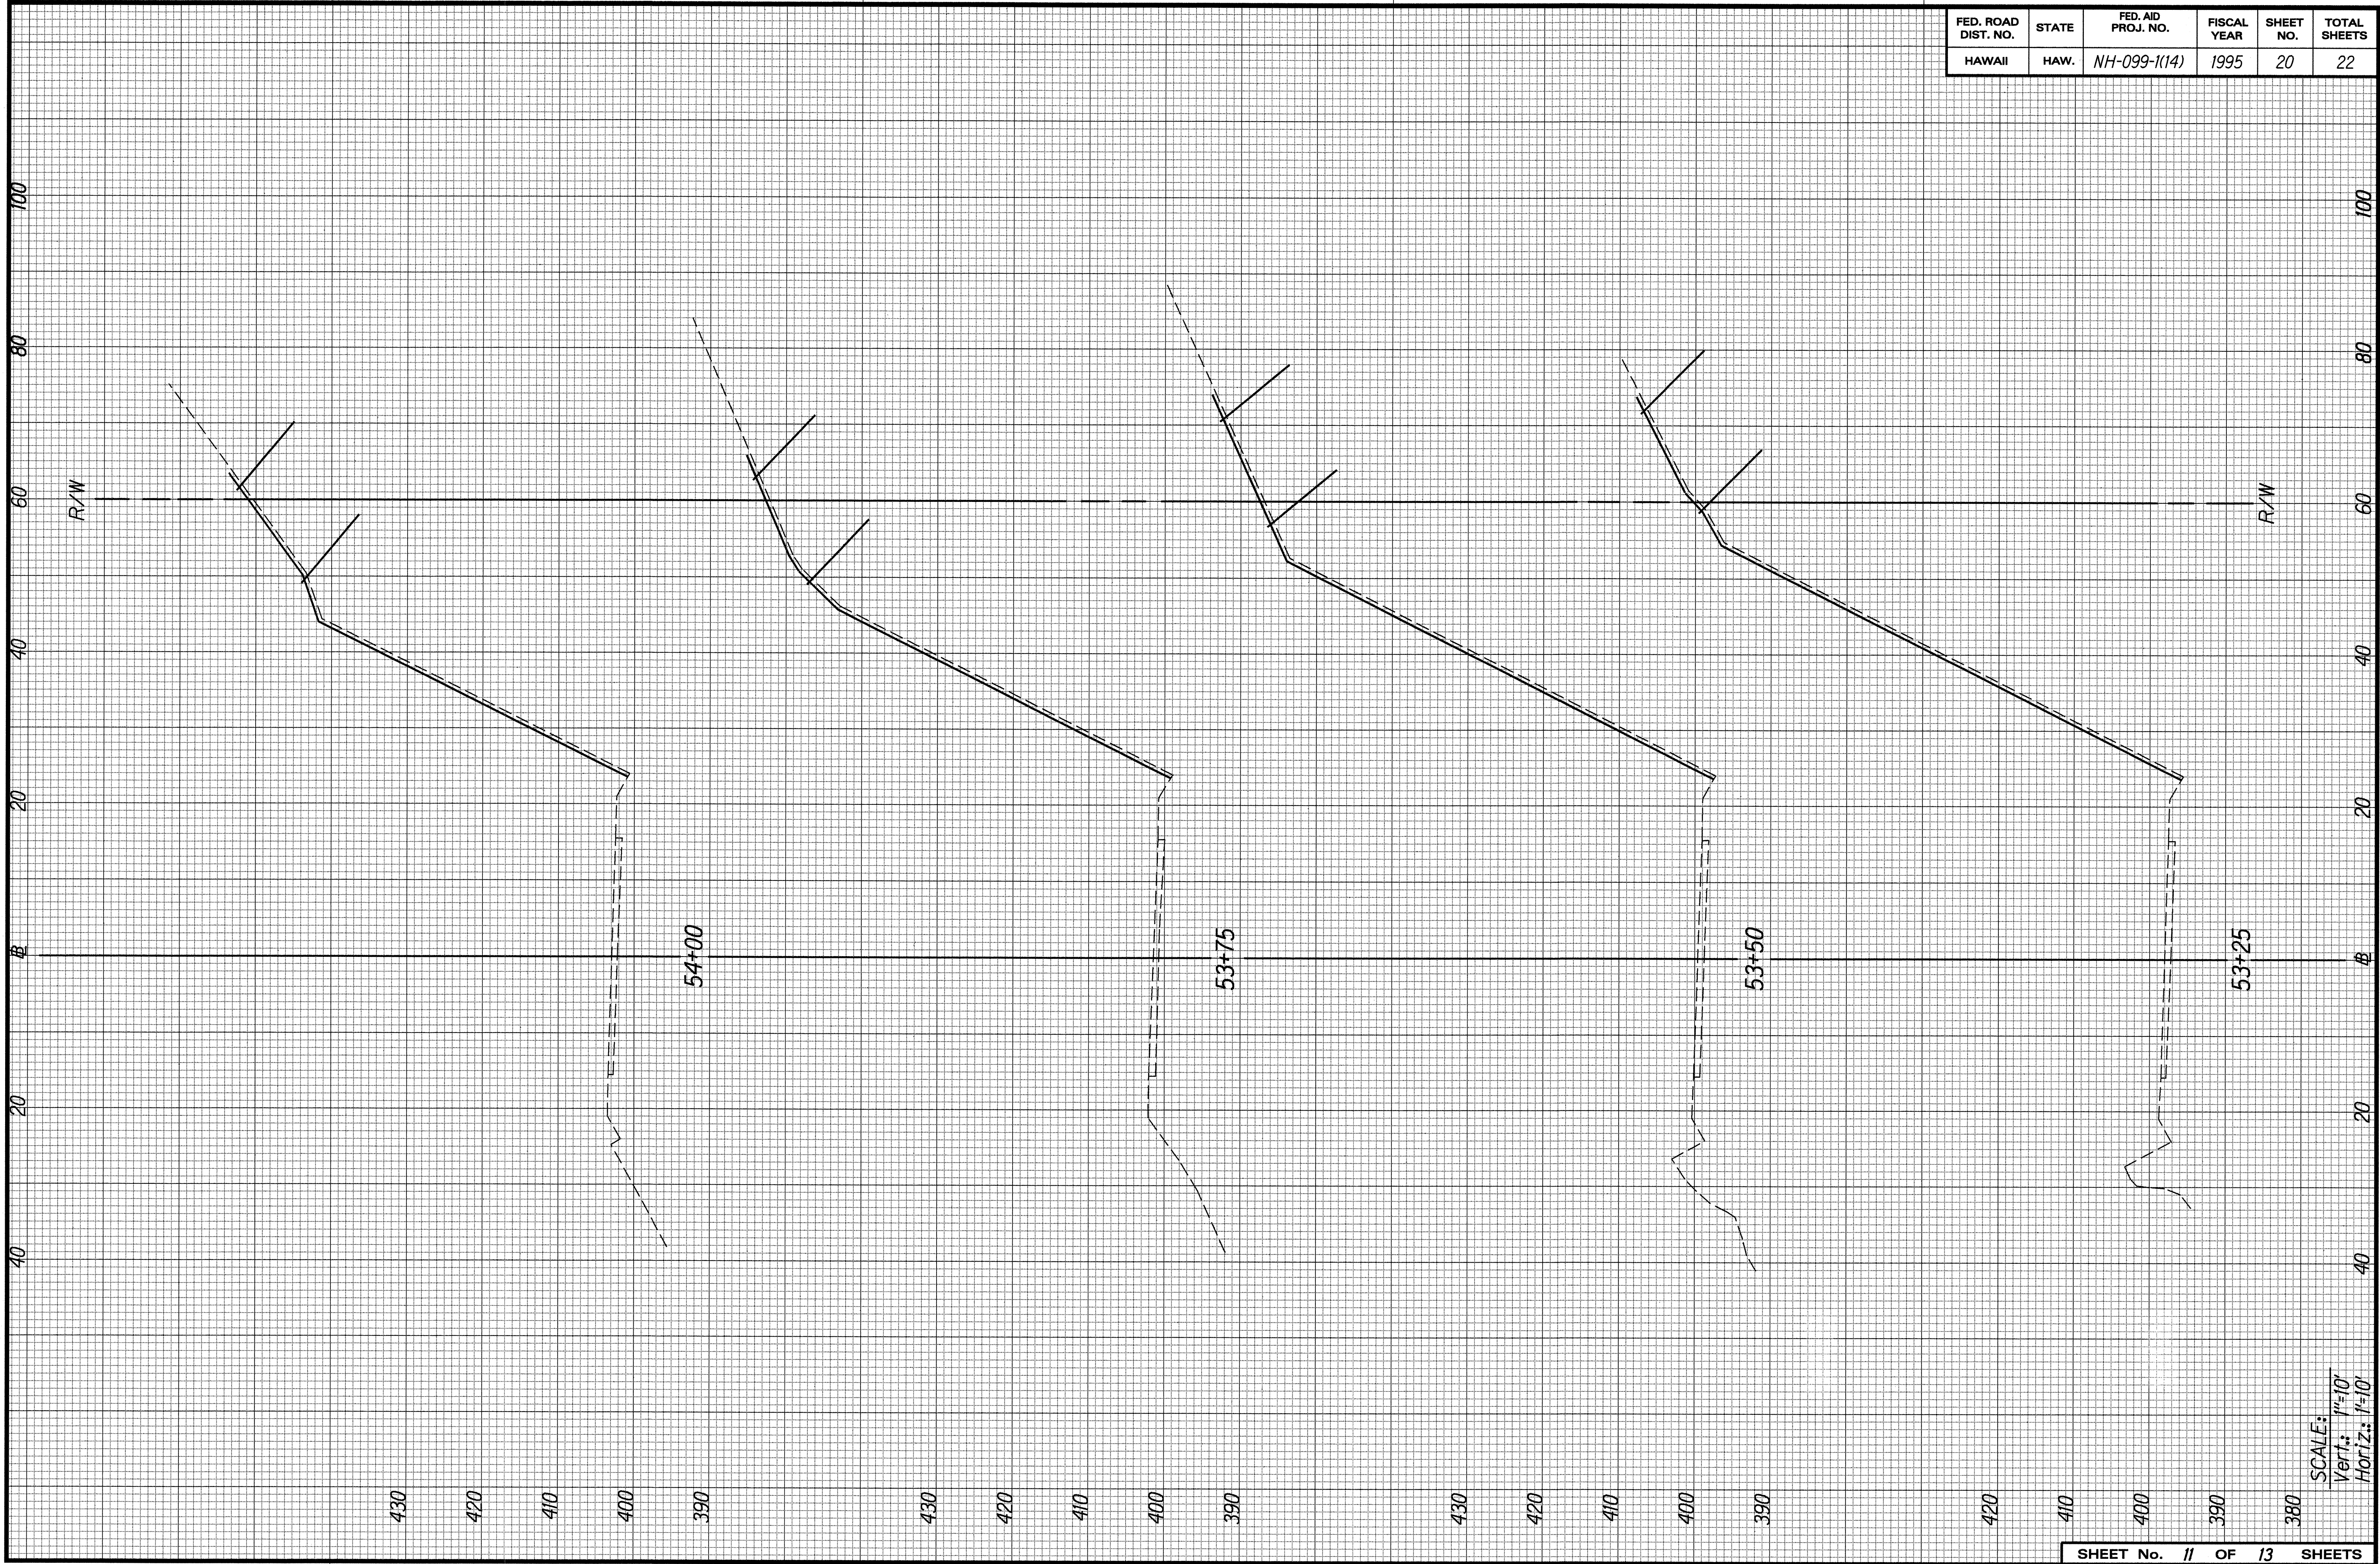


FED. ROAD DIST. NO.	STATE	FED. AID PROJ. NO.	FISCAL YEAR	SHEET NO.	TOTAL SHEETS
HAWAII	HAW.	NH-099-1(14)	1995	21	22

ORIGINAL PLAN	SURVEY PLOTTED BY	DATE
NOTE BOOK	DRAWN BY	1/25/95
DESIGNED BY	J. Williams	
QUANTITIES BY		
CHECKED BY		

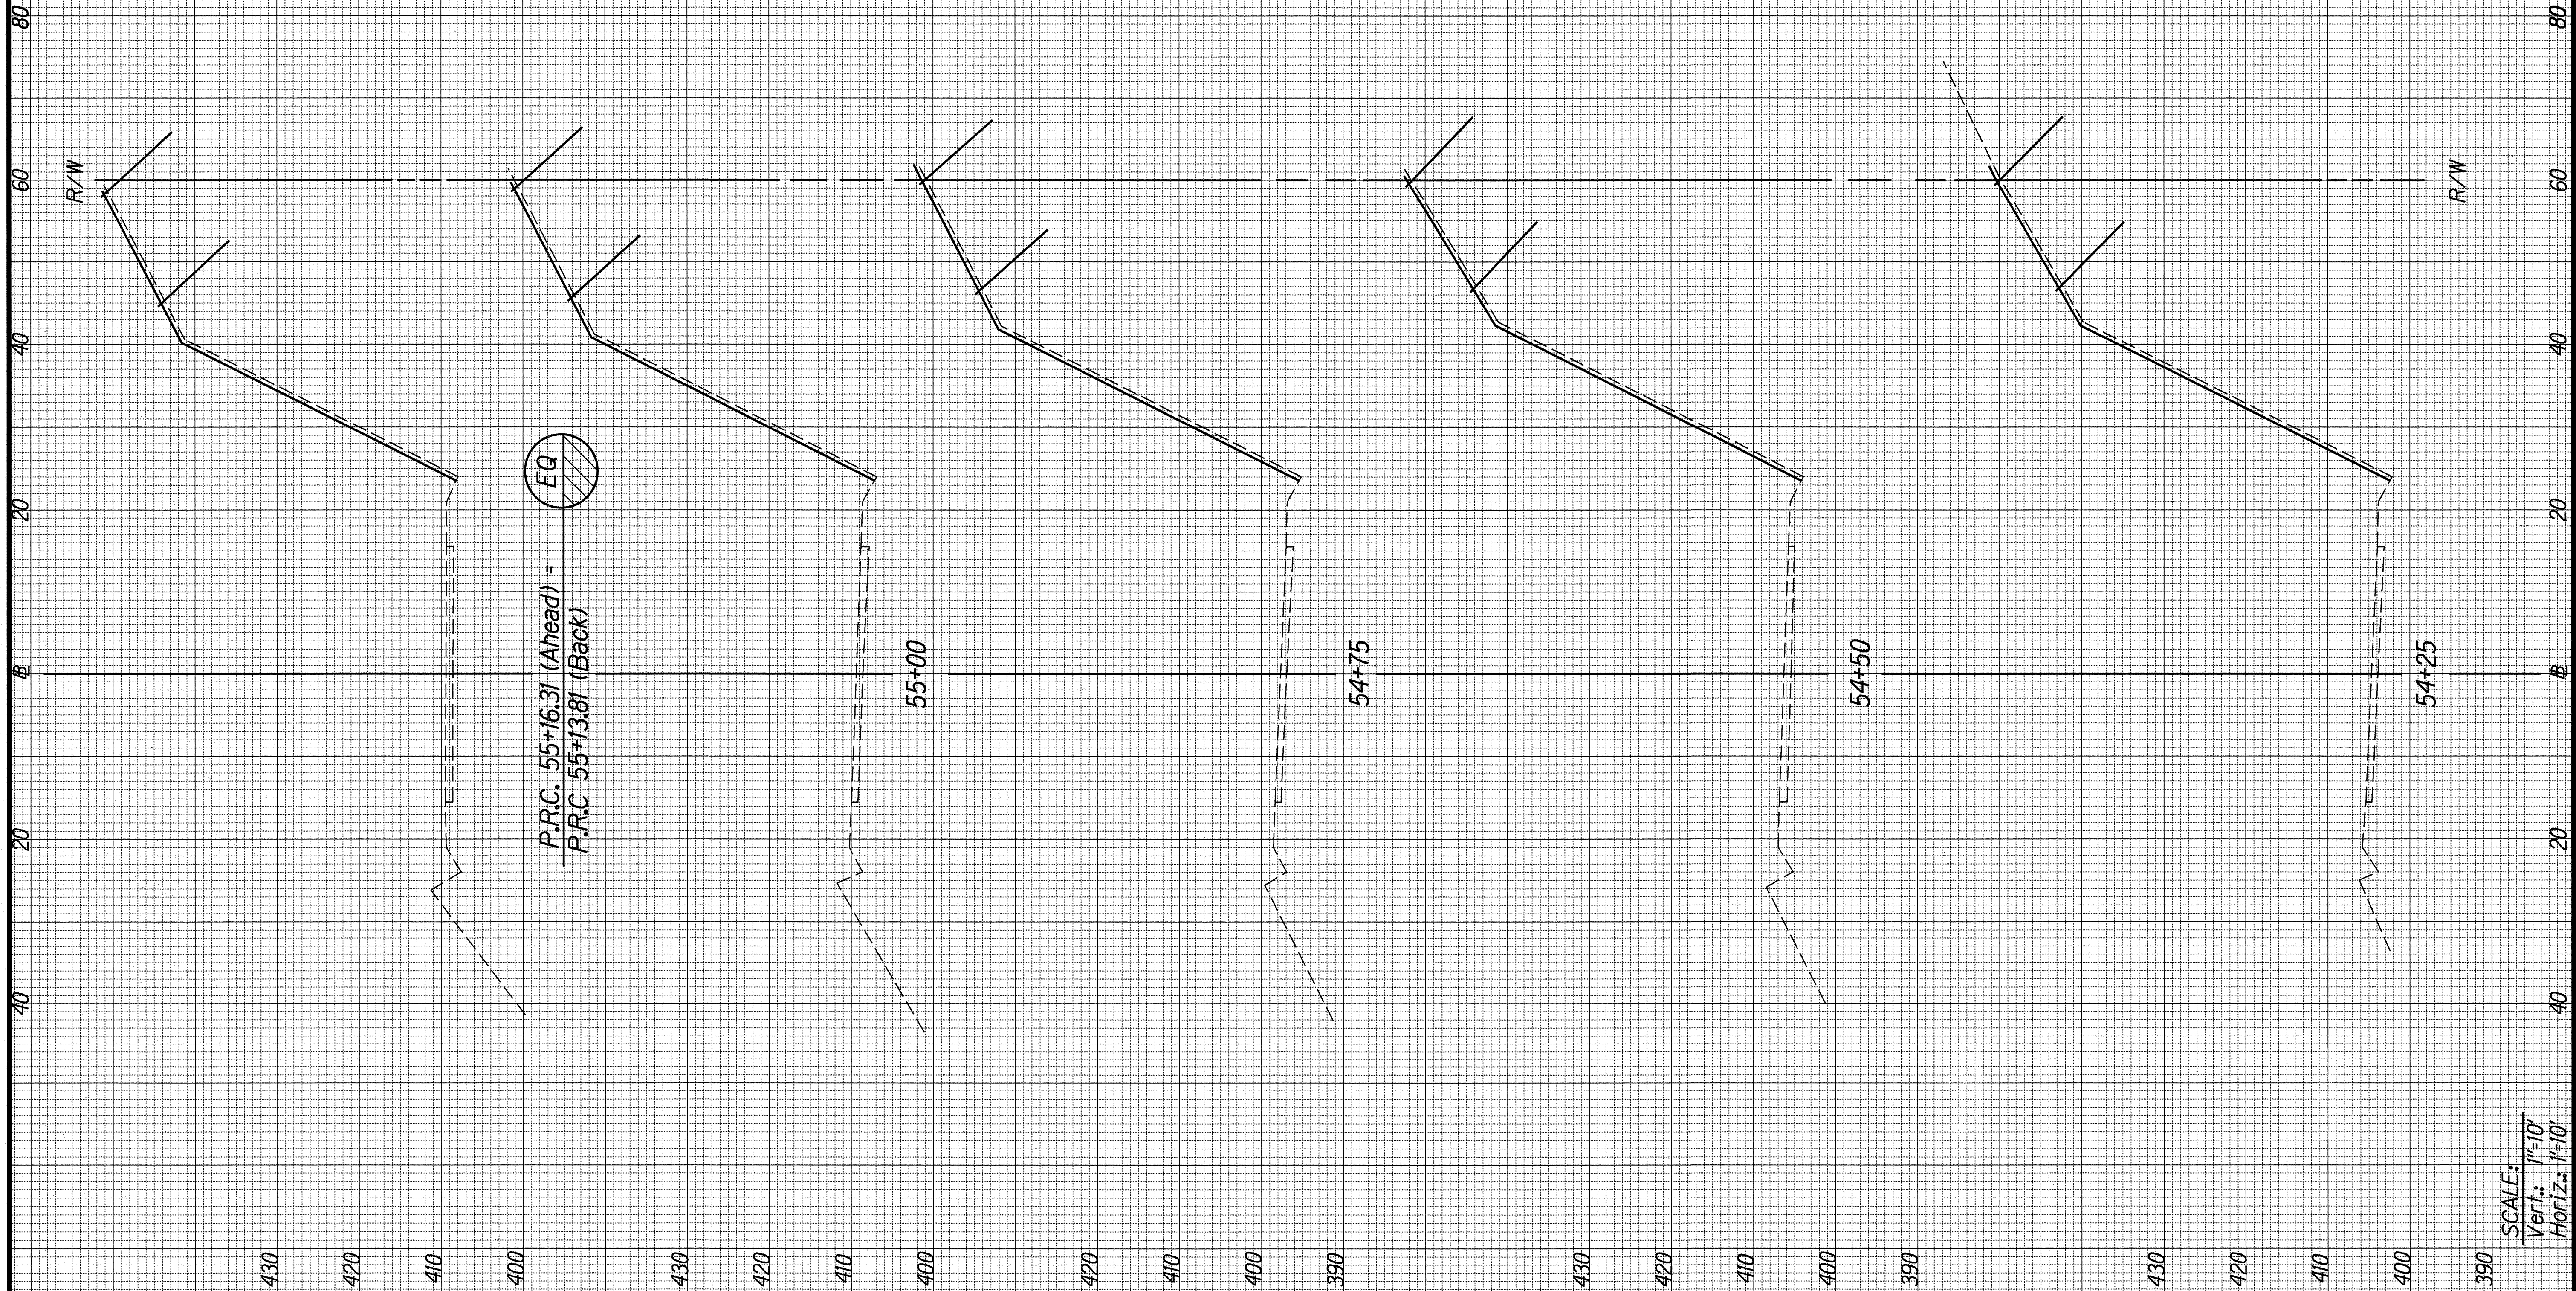

SCALE:
Vert: 1"=10'
Horiz: 1"=10'

FED. ROAD DIST. NO.	STATE	FED. AID PROJ. NO.	FISCAL YEAR	SHEET NO.	TOTAL SHEETS
HAWAII	HAW.	NH-099-1(14)	1995	22	22

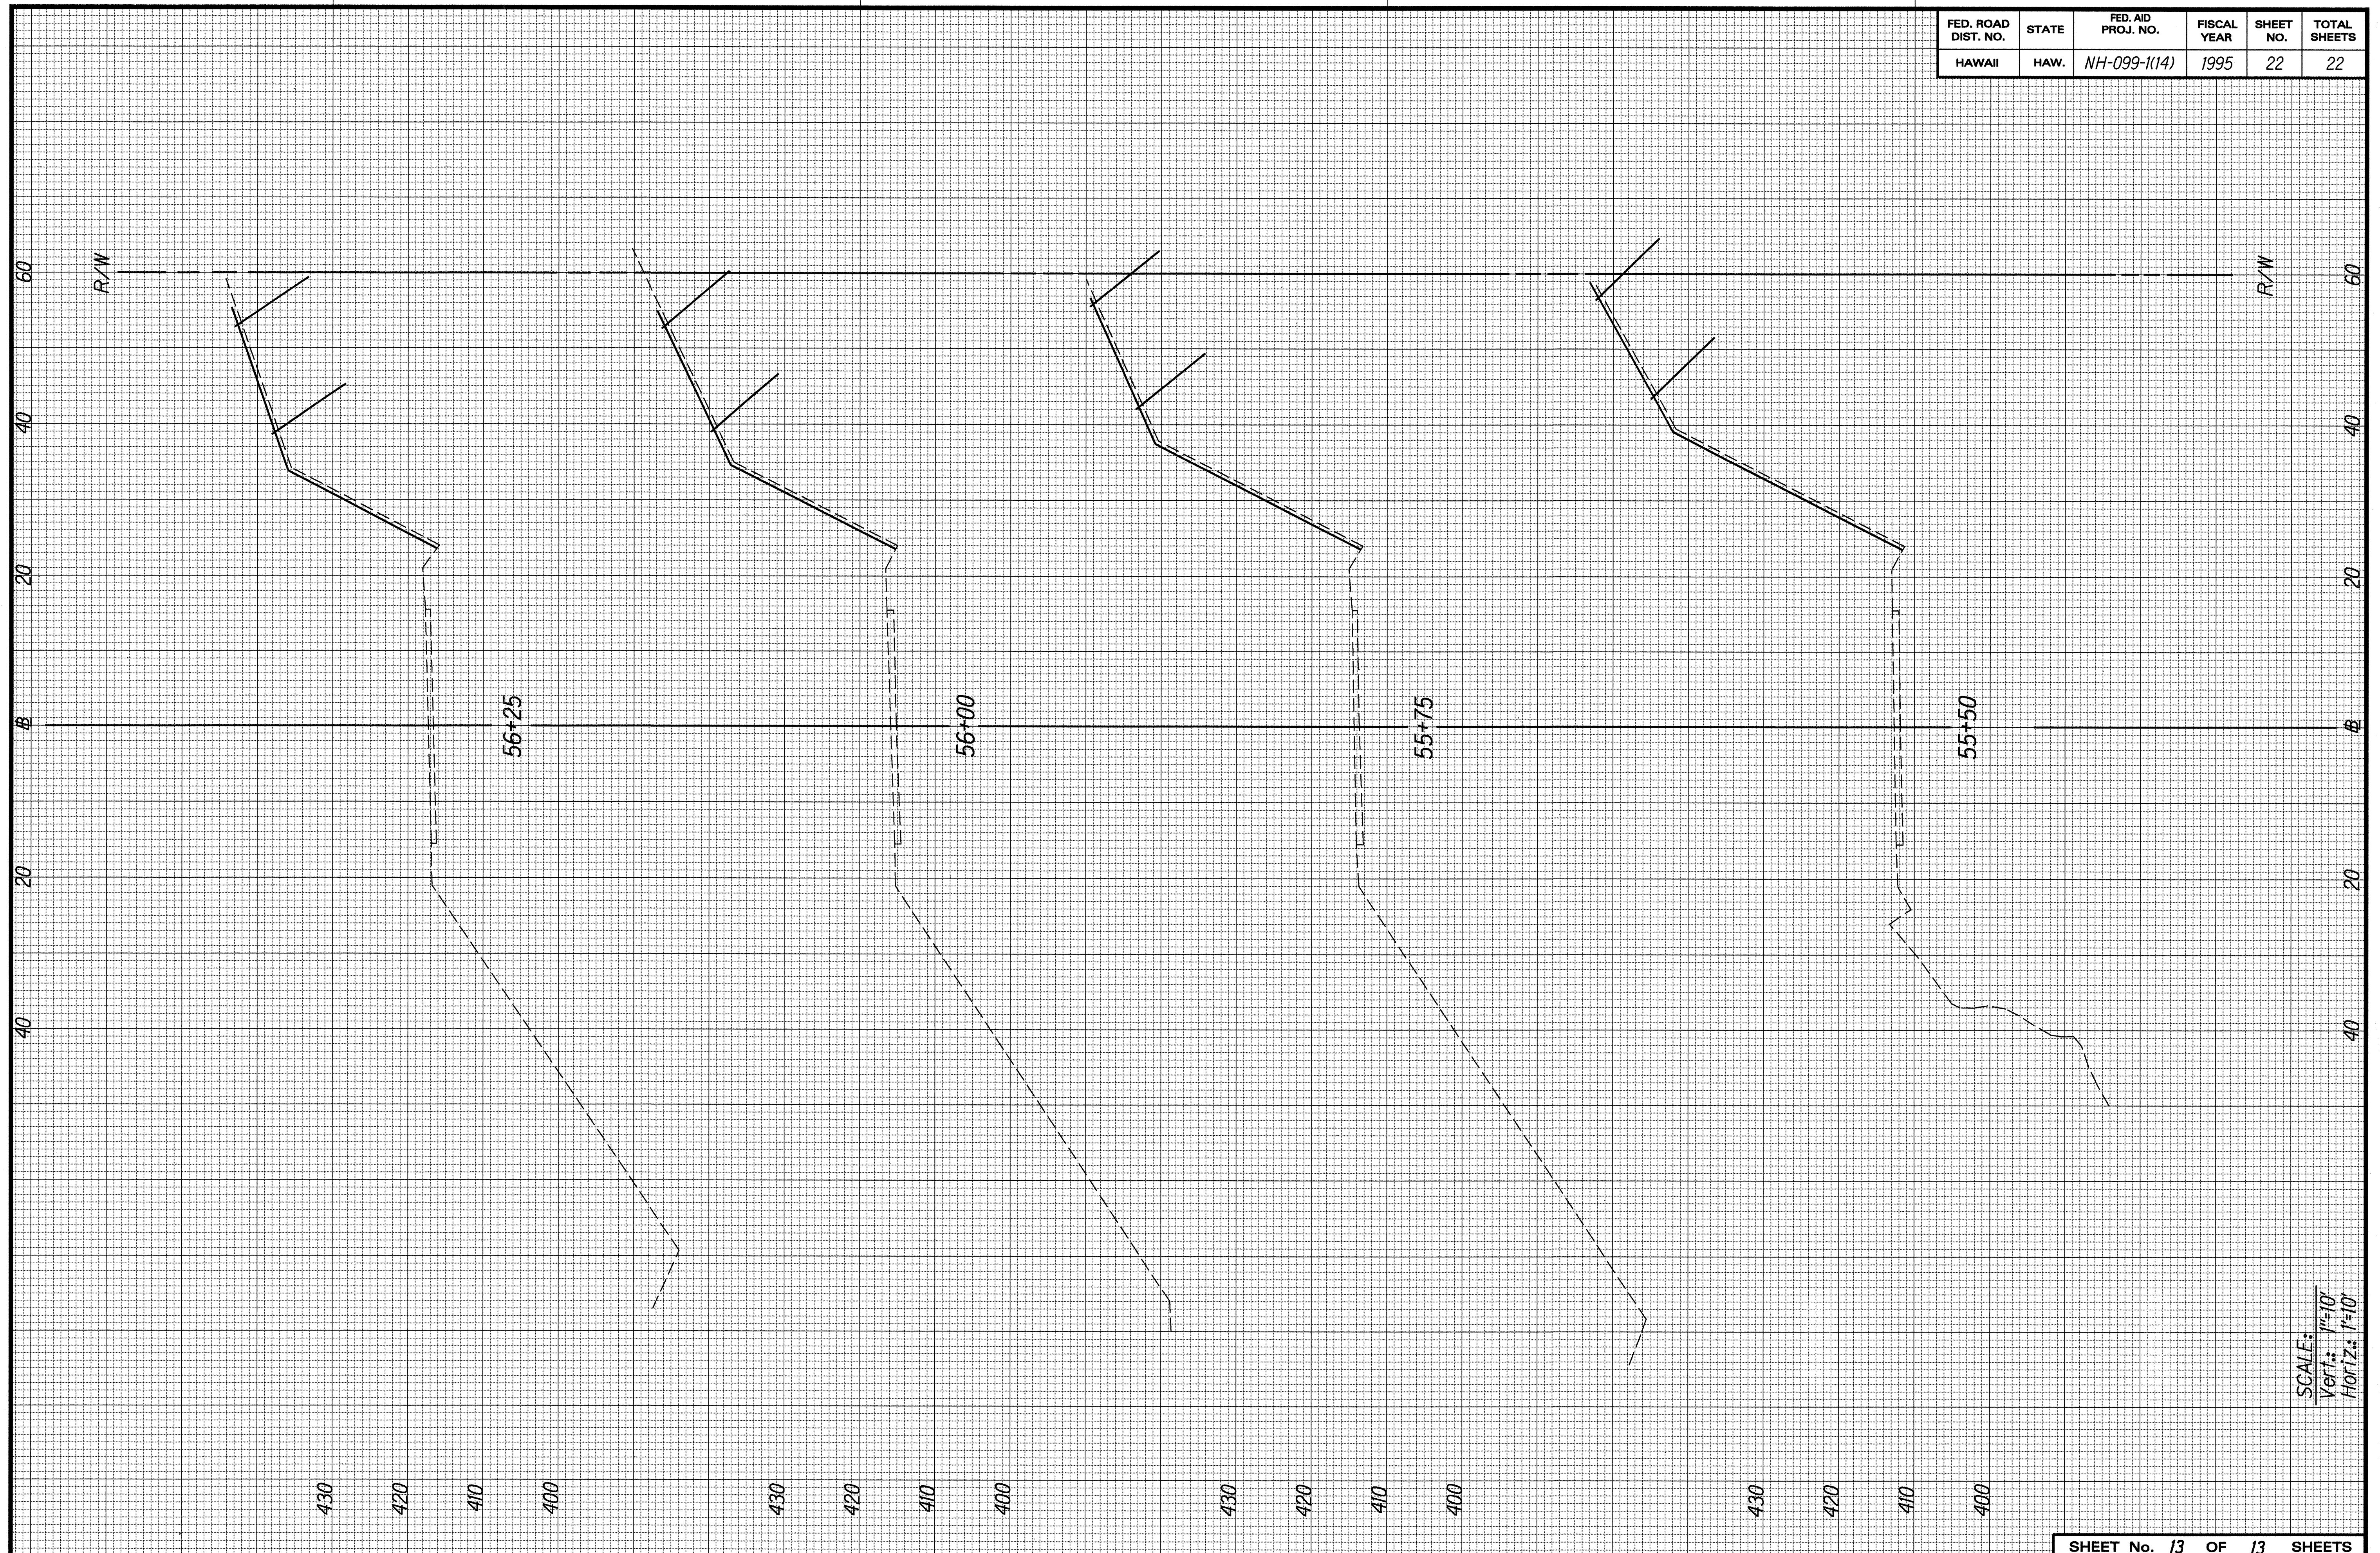

SCALE:

Vert.:	1"=10'
Horiz.:	1"=10'

ORIGINAL PLAN	SURVEY PLOTTED BY _____	DATE _____
	DRAWN BY <i>given</i>	_____
NOTE BOOK	TRACED BY _____	_____
<i>dd6.gee.ge</i>	DESIGNED BY <i>i.fuimato/d. tariquchi</i>	_____
	QUANTITIES BY _____	_____
<i>kgmdas13q1</i>	CHECKED BY _____	_____