FED. ROAD DIST. NO.	STATE	FED. AID PROJ. NO.	FISCAL YEAR	SHEET NO.	TOTAL SHEETS
HAWAII	HAW.	BR-099-1(19)	2001	17	105

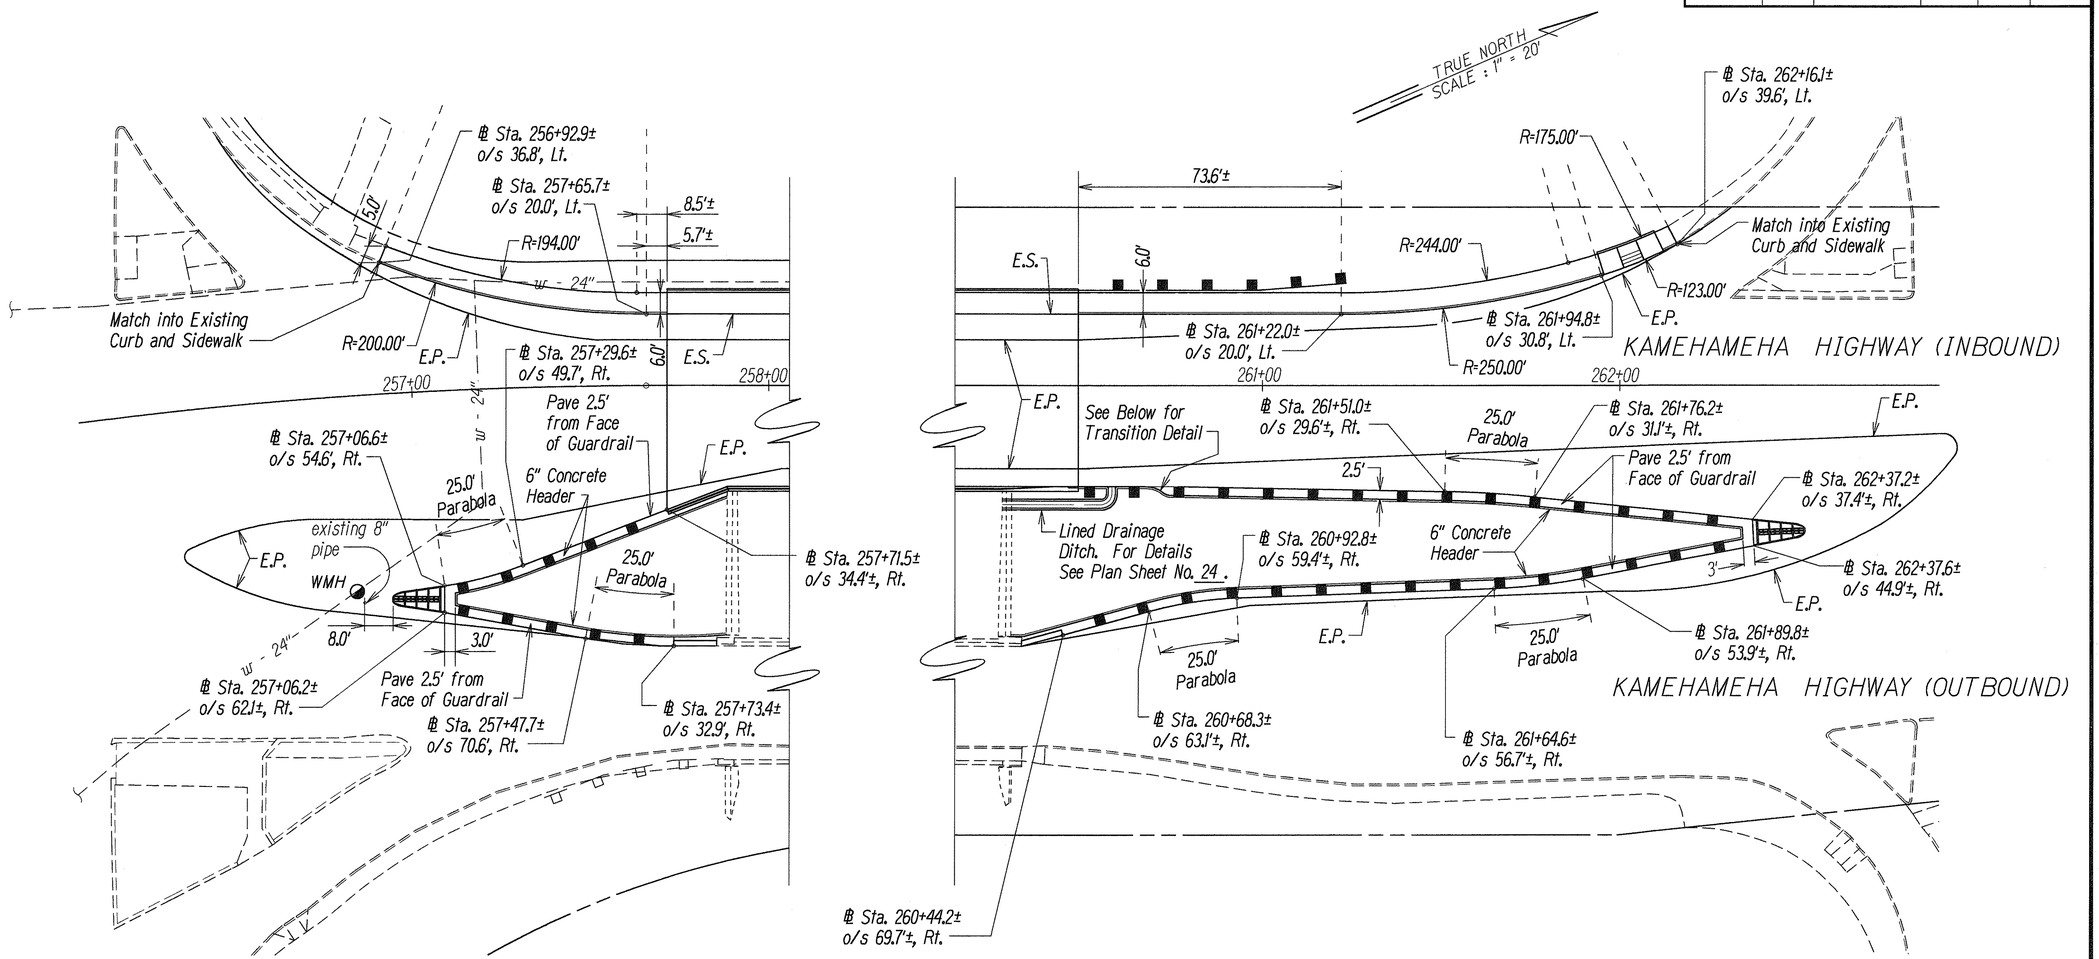

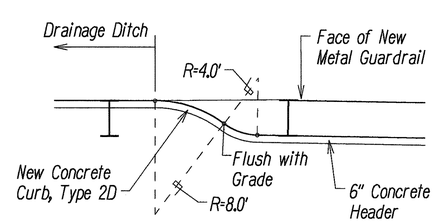

TRANSITION DETAIL
TYPE 2D CURB TO 6" CONCRETE HEADER
Scale: 1"=5'

STATE OF HAWAII
DEPARTMENT OF TRANSPORTATION
HIGHWAYS DIVISION

DETAIL ROADWAY
TRAILING AND APPROACHING ENDS
KAMEHAMEHA HIGHWAY
Halawa Stream Bridge (Inbound) Replacement
Federal Aid Project No. BR-099-1(19)

Scale: 1"=20' Date: Jan., 2001

SHEET No. 1 OF 1 SHEETS

ORIGINAL PLAN — SURVEY PLOTTED BY ____ DATE ____ PLANS BY ____ TRACED BY ____ DESIGNED BY ____ QUANTITIES BY ____ CHECKED BY ____
REVISED PLAN — NOTE BOOK ____ DESIGNED BY ____ QUANTITIES BY ____ CHECKED BY ____