FED. ROAD DIST. NO.	STATE	FED. AID PROJ. NO.	FISCAL YEAR	SHEET NO.	TOTAL SHEETS
HAWAII	HAW.	DE-0200(803)	2000	13	79

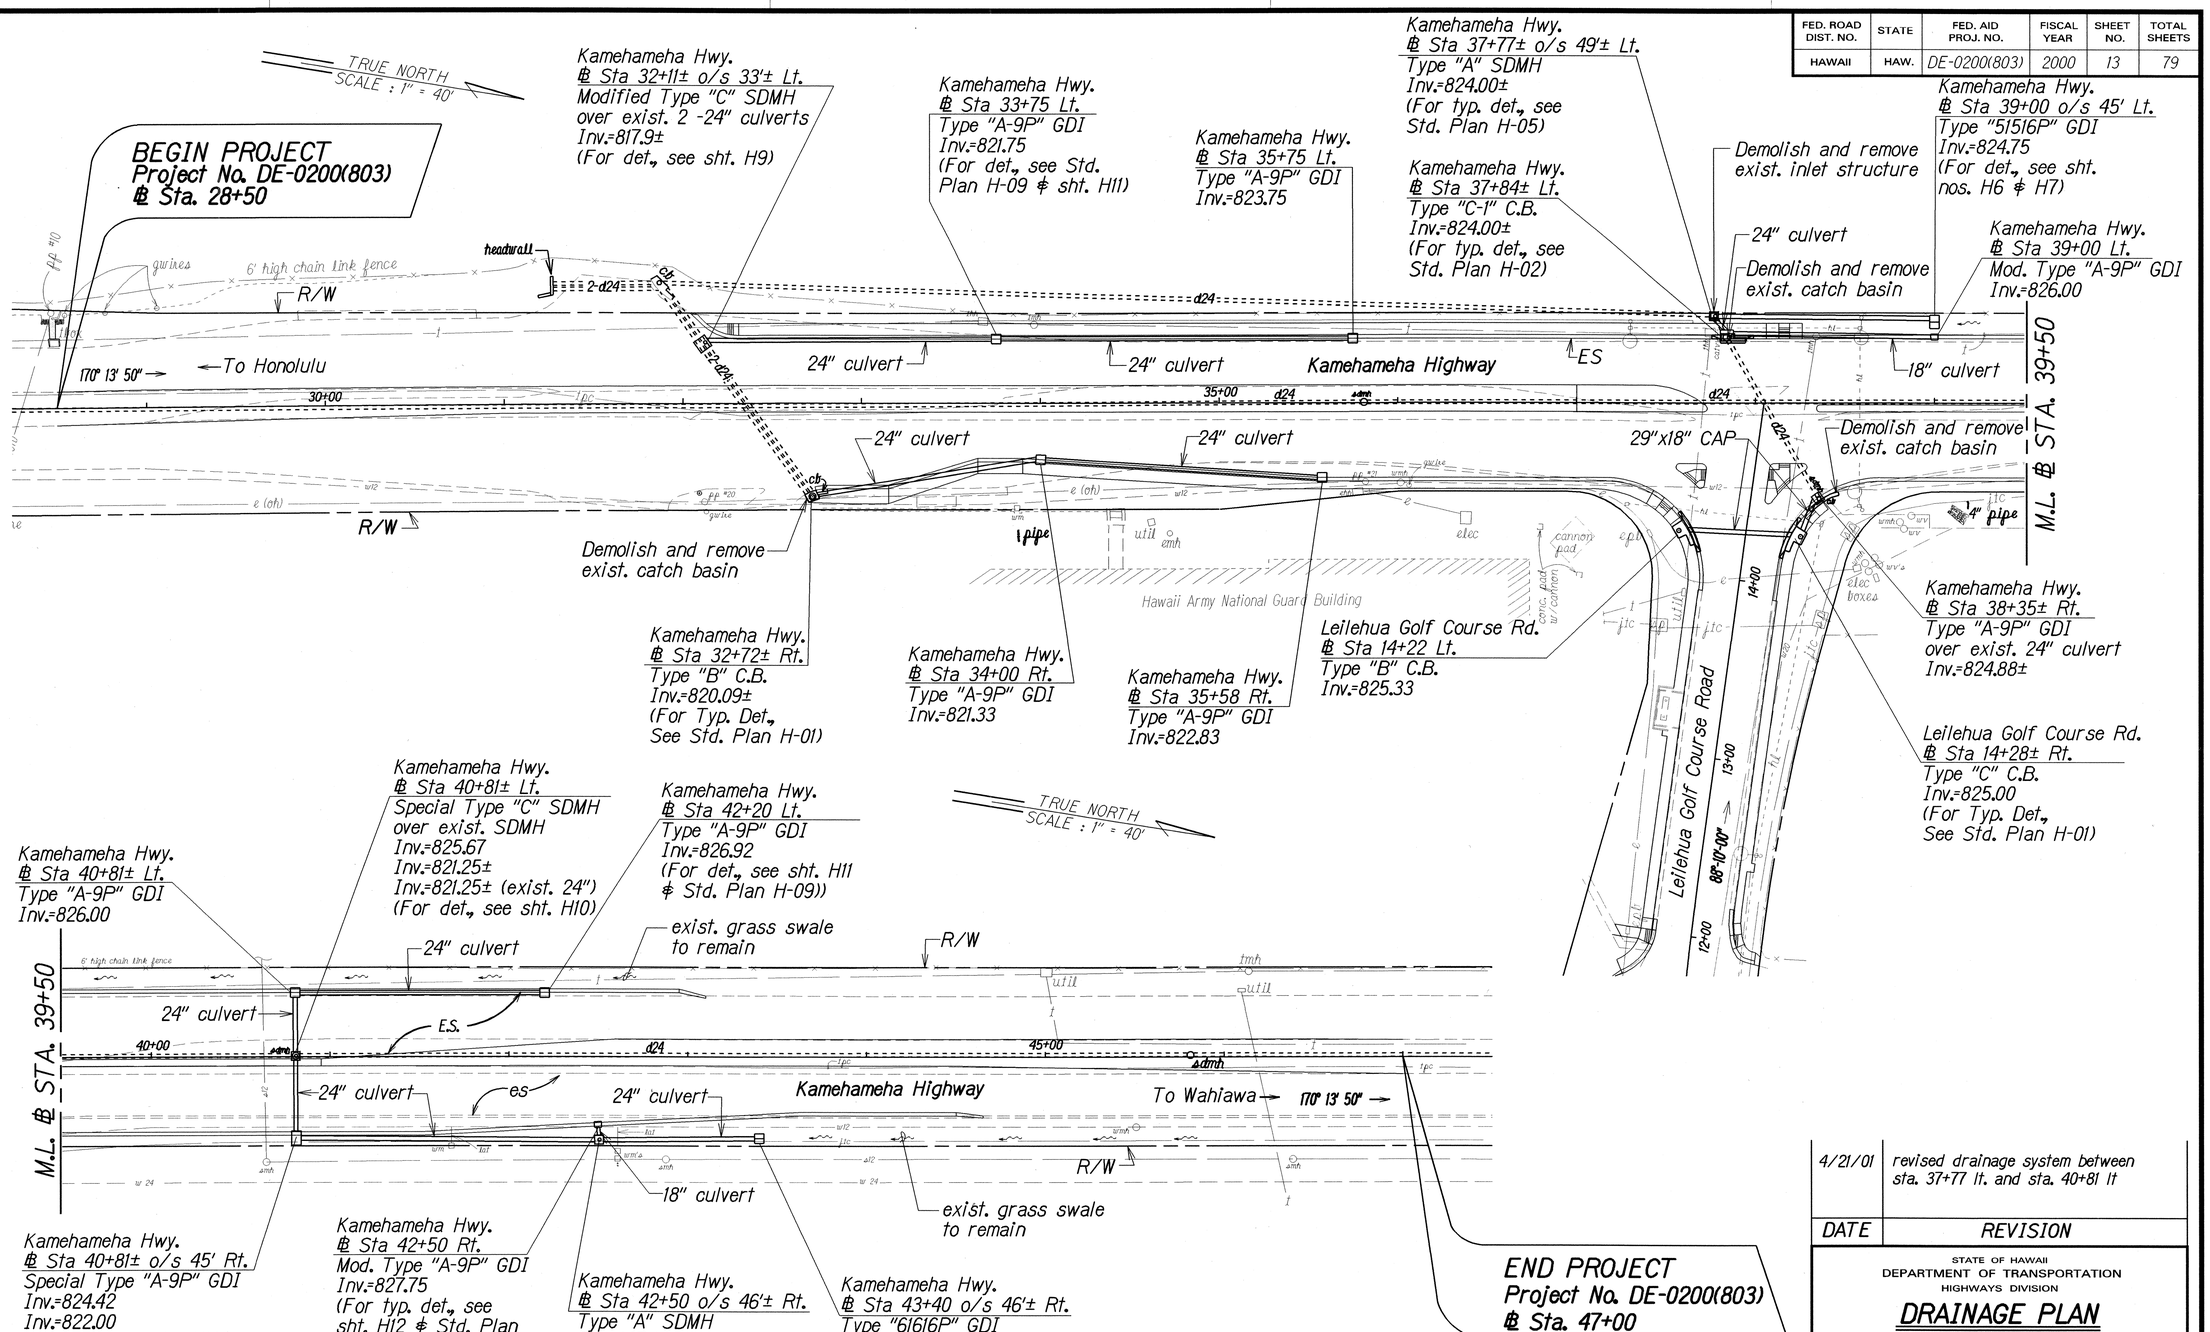

DATE	REVISION
4/21/01	revised drainage system between sta. 37+77 lt. and sta. 40+81 lt

STATE OF HAWAII
DEPARTMENT OF TRANSPORTATION
HIGHWAYS DIVISION

DRAINAGE PLAN

KAMEHAMEHA HIGHWAY INTERSECTION IMPROVEMENTS AT LEILEHUA GOLF COURSE ROAD

Fed. Aid Proj. No. DE-0200(803)

Scale: 1" = 40' Date: May, 2000

SHEET No. H2 OF 14 SHEETS

C.O. 13

ORIGINAL PLAN | SURVEY PLOTTED BY | DRAWN BY | TRACED BY | DESIGNED BY | QUANTITIES BY | CHECKED BY | DATE 4-23-99 | NOTE BOOK | Kamehameha Hwy.