FED. ROAD DIST. NO.	STATE	PROJ. NO.	FISCAL YEAR	SHEET NO.	TOTAL SHEETS
HAWAII	HAW.	99C–01–00	2002	1	21

INDEX TO DRAWINGS

SHEET NO.	DESCRIPTION
1	TITLE SHEET
2	STANDARD PLANS SUMMARY
3	GENERAL NOTES AND LEGEND
4 – 5	WATER POLLUTION AND EROSION CONTROL NOTES
6	PAVEMENT RESTORATION DETAIL
7 – 10	SIGNING AND PAVEMENT MARKING PLANS
11 – 18	TRAFFIC SIGNAL PLANS AND DETAILS
19 – 21	CONSTRUCTION PHASING PLANS

STATE OF HAWAII

DEPARTMENT OF TRANSPORTATION

HIGHWAYS DIVISION

HONOLULU, HAWAII

"AS-BUILT"

PLANS FOR

KAMEHAMEHA HIGHWAY

INTERSECTION IMPROVEMENTS AT KAMANANUI ROAD

PROJECT NO. 99C–01–00

DISTRICT OF WAHIAWA

ISLAND OF OAHU

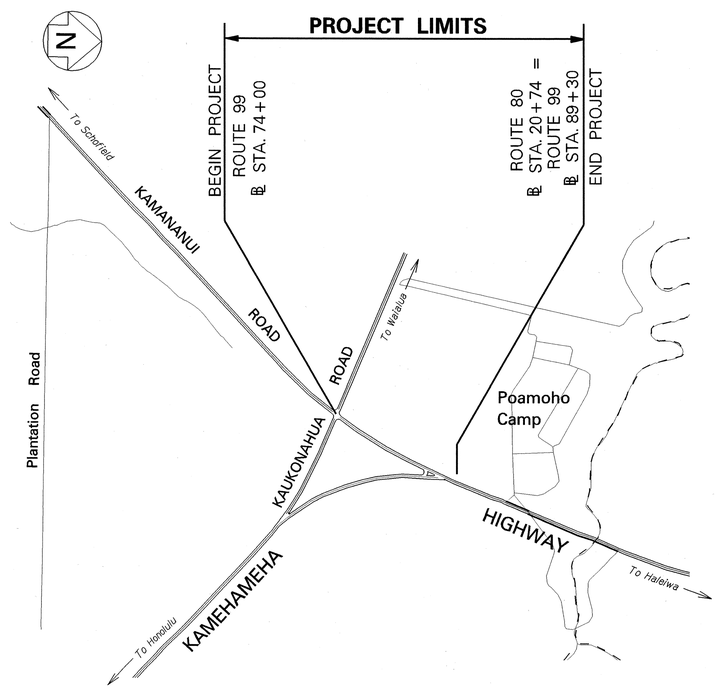

LAYOUT PLAN

GROSS LENGTH OF PROJECT. . . . . 0.58 MILES

NET LENGTH OF PROJECT. . . . . 0.58 MILES

7.5 0.0 7.5 15.0 22.5

SCALE IN HUNDRED FEET

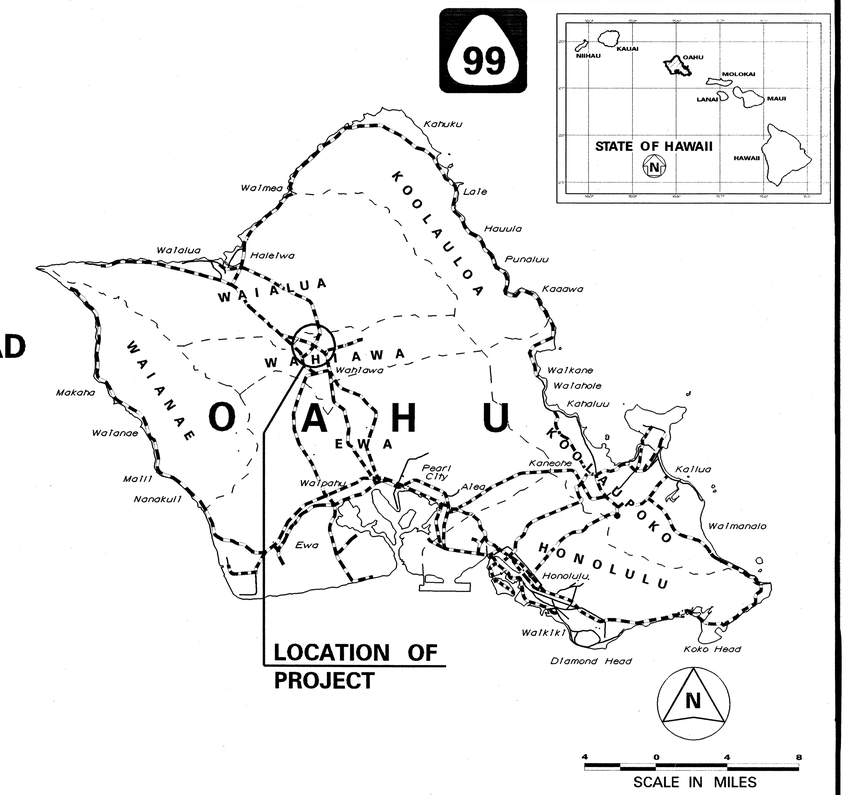

FEDERAL AID PROJECTS PREVIOUSLY CONSTRUCTED OR UNDER CONSTRUCTION

ROUTE 80: MILE POST 1.65 TO MILE POST 1.88

ROUTE 99: MILE POST 6.53 TO MILE POST 6.78

CHANGES MADE DURING CONSTRUCTION HAVE BEEN INCORPORATED ON THESE PLANS EXCEPT CHANGES IN THE ORIGINAL TABULATED QUANTITIES. FOR ACTUAL QUANTITIES, REFER TO PROJECT LEDGER AND/OR CONSULTANT ENGINEER.

RESIDENT ENGINEER — DATE 3/1/03

UNIT "C"	R. HIRONAKA	692–7575	JUNE 2001
DESIGNED BY	P. S. & E. BY	PHONE	DATE

DEPARTMENT OF TRANSPORTATION
STATE OF HAWAII

APPROVED:

for DIR. OF TRANSPORTATION — DATE 12-7-01

7kmhdtsht.dgn/kmi

9kamdtsht.dgn/grace