FED. ROAD DIST. NO.	STATE	PROJ. NO.	FISCAL YEAR	SHEET NO.	TOTAL SHEETS
HAWAII	HAW.	750A-01-79	1981	1	2

INDEX TO DRAWINGS

SHEET NO.	DESCRIPTION
1	TITLE SHEET
2	PLAN AND DETAILS

STATE OF HAWAII

DEPARTMENT OF TRANSPORTATION

HIGHWAYS DIVISION
HONOLULU, HAWAII

"AS BUILT"

PLANS FOR

KUNIA ROAD HIGHWAY LIGHTING

H-1 TOWARDS WILIKINA DRIVE (KUNIA ROAD AT KUNIA VILLAGE)

PROJECT NO. 750A-01-79

DISTRICT OF EWA
ISLAND OF OAHU

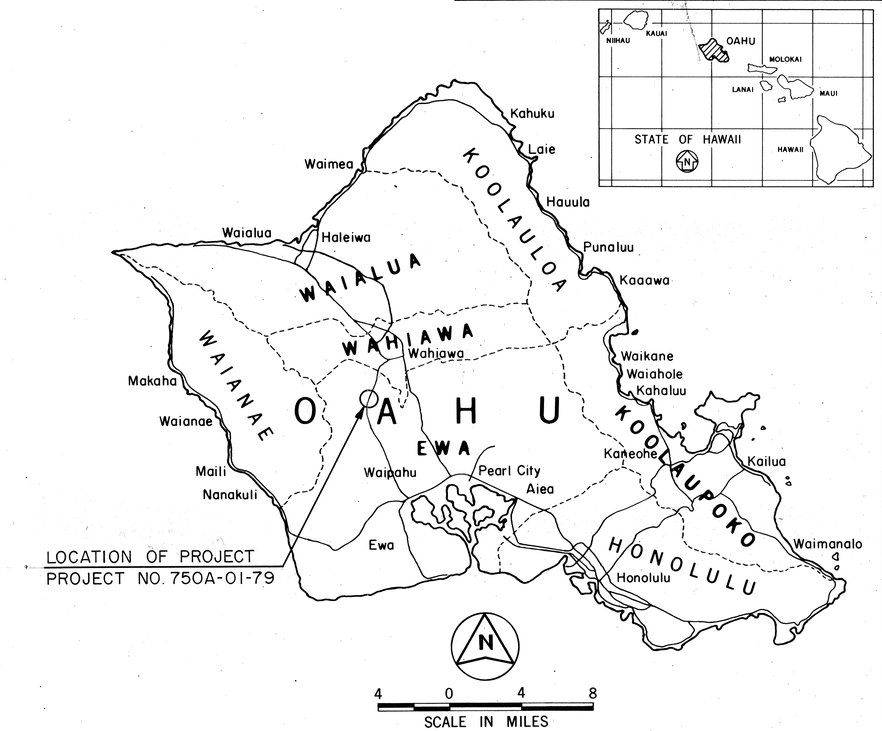

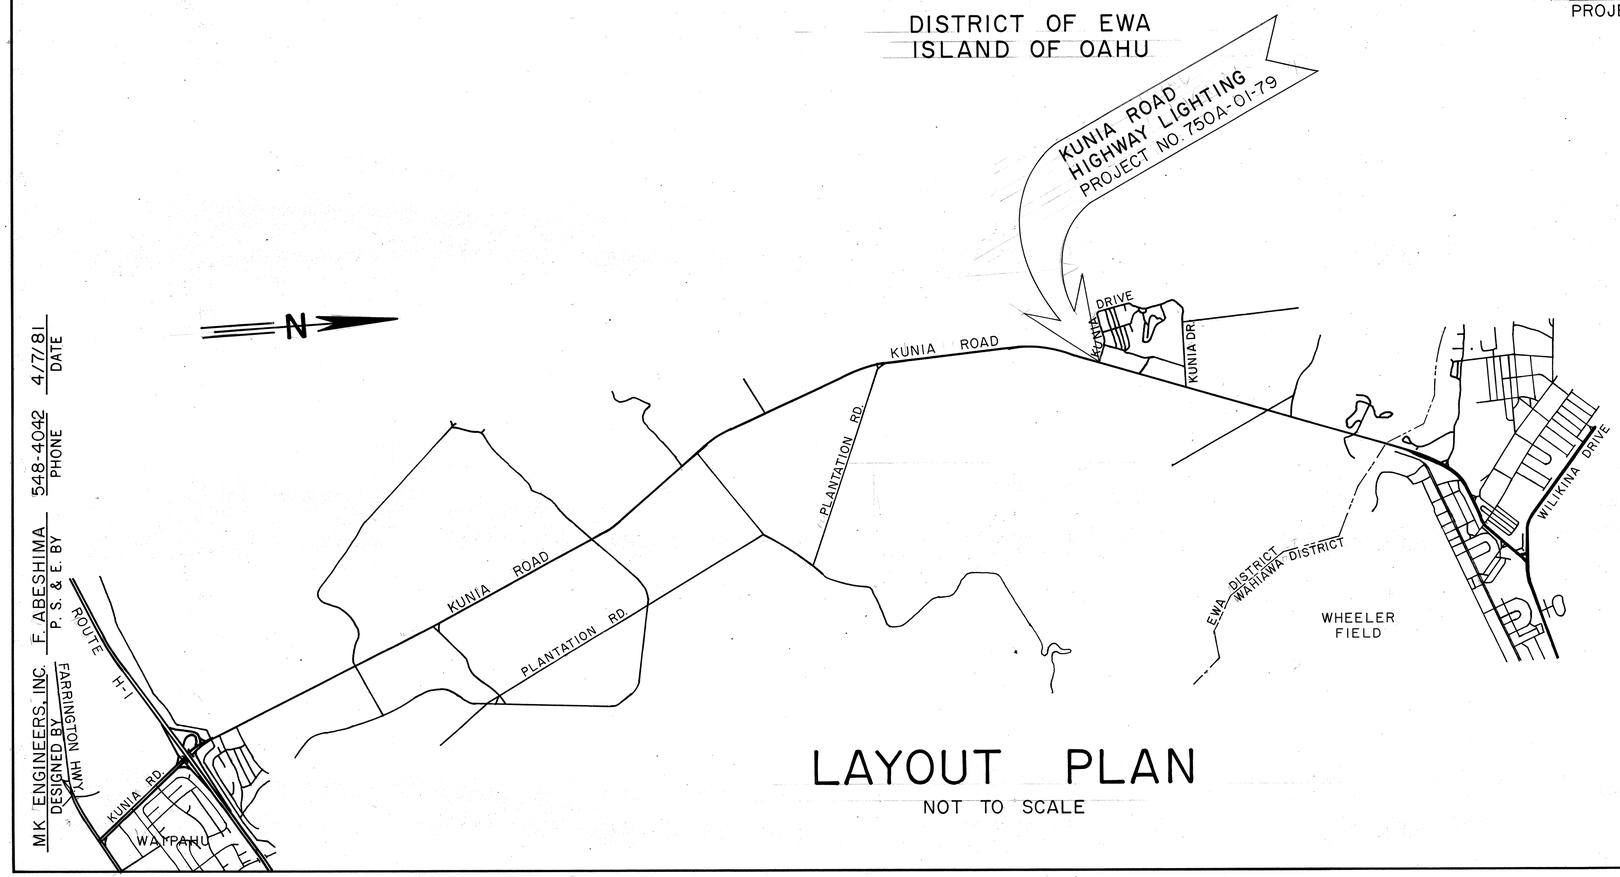

LAYOUT PLAN
NOT TO SCALE

THERE WERE NO AS BUILT CHANGES MADE DURING CONSTRUCTION.

Robert Y. Omai — RESIDENT ENGINEER — 12/7/81 DATE

DEPARTMENT OF TRANSPORTATION
STATE OF HAWAII
APPROVED:
James R. Carras — DIR. OF TRANSPORTATION — 4/7/81 DATE

MK ENGINEERS, INC. — DESIGNED BY
F. ABESHIMA — P. S. & E. BY
548-4042 — PHONE
4/7/81 — DATE

2307-2/122

0-4-8