FED. ROAD DIST. NO.	STATE	FED. AID PROJ. NO.	FISCAL YEAR	SHEET NO.	TOTAL SHEETS
HAWAII	HAW.	RS-0750(7)	1984	1	32

INDEX TO DRAWINGS

SHEET NO.	DESCRIPTION
1	TITLE SHEET
2	GENERAL NOTES
3-4	TYPICAL SECTIONS & DETAILS
5-6	PLANS
7	DRAINAGE DETAILS
8-15	GUARD RAIL & BARRICADE STANDARD DETAILS
16-32	SIGNING & PAVEMENT MARKINGS PLANS AND STANDARD DETAILS

STATE OF HAWAII

DEPARTMENT OF TRANSPORTATION

HIGHWAYS DIVISION

"AS-BUILT"

PLANS FOR

KUNIA ROAD RESURFACING

H-1 TOWARDS WILIKINA DRIVE

(VICINITY OF KUNIA DRIVE TO URBAN BOUNDARY)

F.A. PROJECT NO. RS-0750(7)

DISTRICT OF EWA

ISLAND OF OAHU

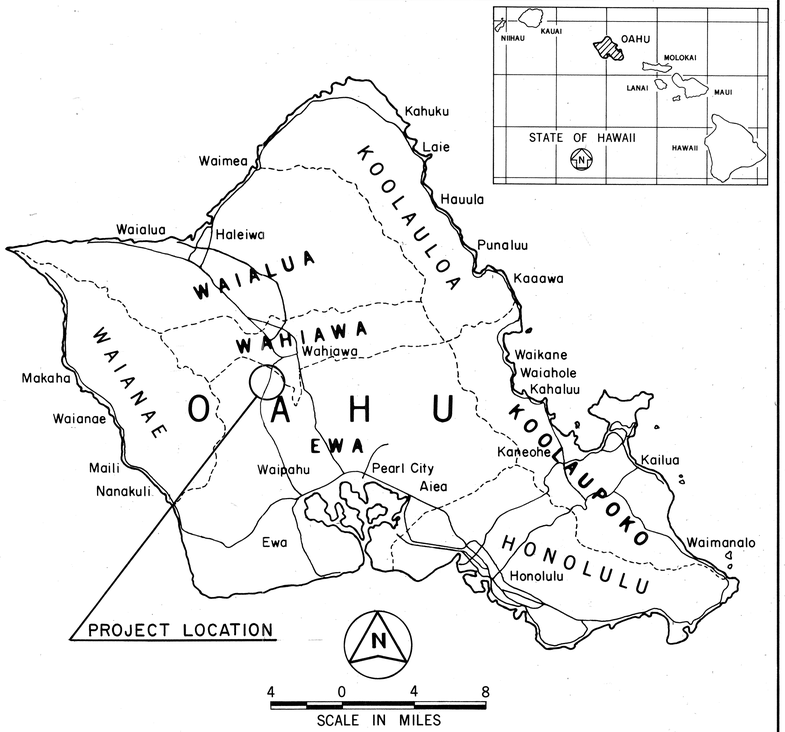

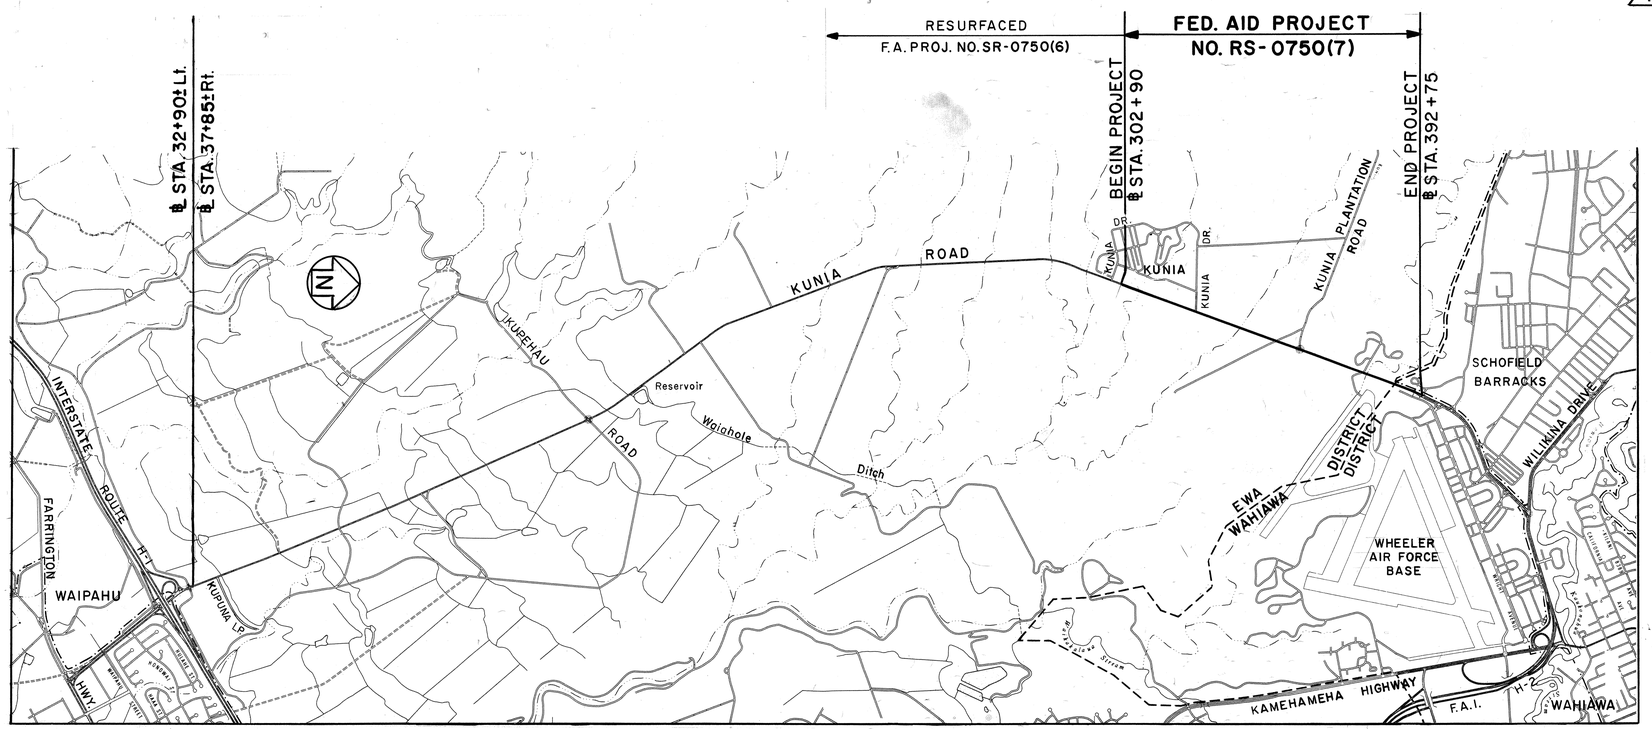

LAYOUT PLAN

GROSS LENGTH OF PROJECT ..... 1.702 MI.
NET LENGTH OF PROJECT ..... 1.702 MI.

DESIGN DESIGNATION

CURRENT ADT (1984) 6,880
DESIGN ADT (2004) 11,230
DHV 1,010
D 60/40
T ..... 2.5 %
V ..... 60 MPH

CHANGES MADE DURING CONSTRUCTION HAVE BEEN INCORPORATED ON THESE PLANS EXCEPT CHANGES IN THE ORIGINAL THEORETICAL QUANTITIES. FOR ACTUAL QUANTITIES, REFER TO PROJECT LEDGER AND/OR COMPUTATION BOOK.

Ronald M. Kan — 7/14/88
RESIDENT ENGINEER — DATE

DEPARTMENT OF TRANSPORTATION
STATE OF HAWAII
APPROVED:
for DIR. OF TRANSPORTATION — 5/21/84 DATE

R. TSUZUKI — DESIGNED BY
R. TSUZUKI — P. S. & E. BY
548-2456 — PHONE
MAY, 1984 — DATE

DD-13-1-3