FED. ROAD DIST. NO.	STATE	FED. AID PROJ. NO.	FISCAL YEAR	SHEET NO.	TOTAL SHEETS
HAWAII	HAW.	STP-0750(8)	1993	1	26

750

INDEX TO DRAWINGS

SHEET NO.	DESCRIPTION
1	TITLE SHEET
2	STANDARD PLAN SUMMARY SHEET
3	GENERAL NOTES
4 & 5	TYPICAL SECTIONS
6 – 13	ROADWAY PLAN
14 – 26	TRAFFIC LEGEND, PAVEMENT MARKING, SIGNING & SUMMARY

STATE OF HAWAII

DEPARTMENT OF TRANSPORTATION

HIGHWAYS DIVISION

HONOLULU, HAWAII

"AS-BUILT"

PLANS FOR

KUNIA ROAD RESURFACING

H-1 FREEWAY TO VICINITY OF DRIVING RANGE

FEDERAL AID PROJECT NO. STP-0750(8)

DISTRICT OF EWA

ISLAND OF OAHU

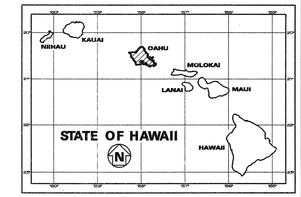

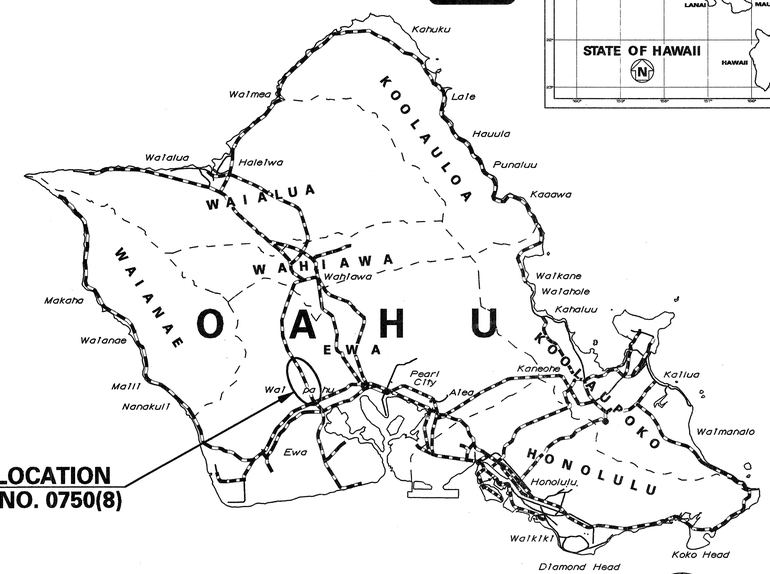

PROJECT LOCATION
F.A. PROJ. NO. 0750(8)

N

4 0 4 8
SCALE IN MILES

FEDERAL AID PROJECT NO. STP-0750(8)

LENGTH OF PROJECT = 4.00 MILES

BEGIN PROJECT ⓑ STA. 13+00±

END PROJECT ⓑ STA. 224+20±

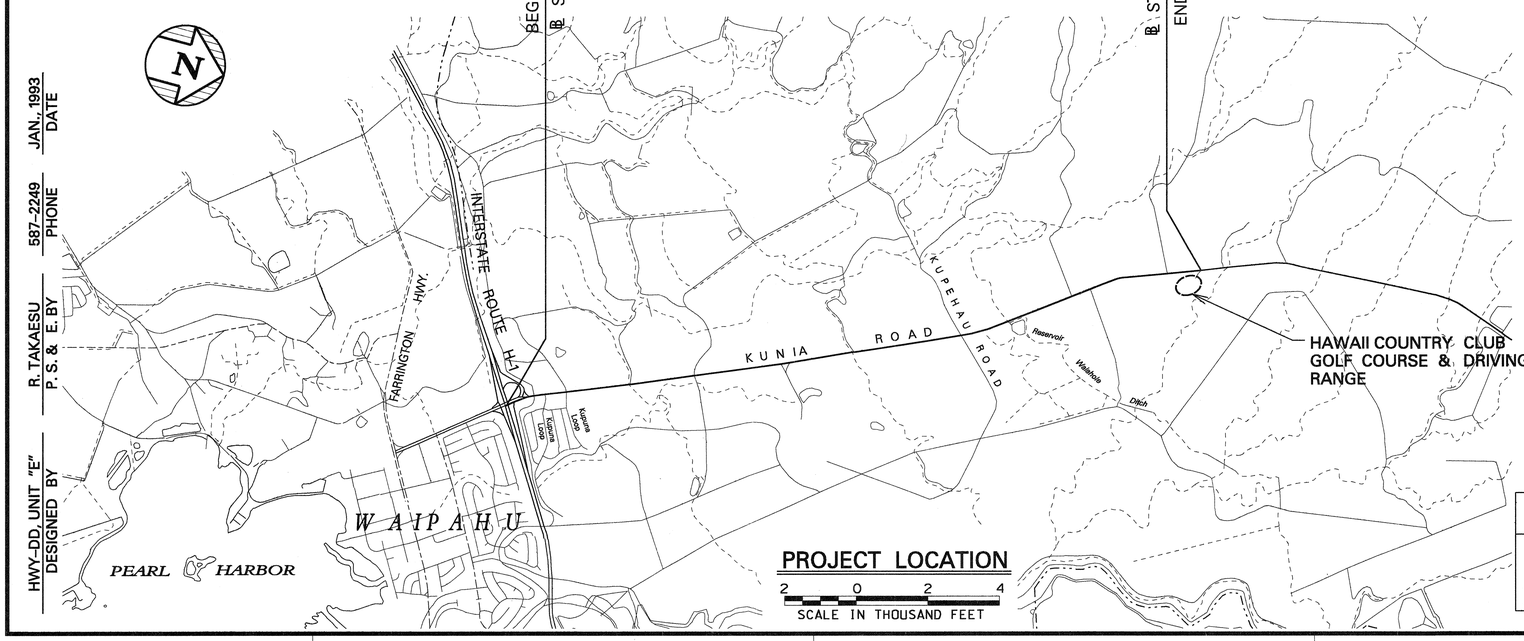

PROJECT LOCATION

2 0 2 4
SCALE IN THOUSAND FEET

FEDERAL AID PROJECTS PREVIOUSLY CONSTRUCTED OR UNDER CONSTRUCTION

MILE POST 0.00 TO MILE POST 4.00

DESIGN DESIGNATION

ADT (1993) 8,500
ADT (2013) 9,980
DHV 1,000
D 60/40
T_{24} ..... 4.0 %
V ..... 55 M.P.H.

CHANGES MADE DURING CONSTRUCTION HAVE BEEN INCORPORATED ON THESE PLANS EXCEPT CHANGES IN THE ORIGINAL THEORETICAL QUANTITIES. FOR ACTUAL QUANTITIES, REFER TO PROJECT LEDGER AND/OR COMPUTATION BOOK.

Robert Oki — RESIDENT ENGINEER — 1-02-01 DATE

DEPARTMENT OF TRANSPORTATION FEDERAL HIGHWAY ADMINISTRATOR	
APPROVED: Graham Wong	5/25/93
DIVISION ADMINISTRATOR	DATE

DEPARTMENT OF TRANSPORTATION STATE OF HAWAII	
APPROVED: A. Harano	5/19/93
DIR. OF TRANSPORTATION	DATE

HWY-DD, UNIT "E" DESIGNED BY — R. TAKAESU P. S. & E. BY — 587-2249 PHONE — JAN., 1993 DATE

1kundtsht.dgn login: george

1kundtsht.dgn login: george 5-17-93