



FED. ROAD DIST. NO.	STATE	FED. AID PROJ. NO.	FISCAL YEAR	SHEET NO.	TOTAL SHEETS
HAWAII	HAW.	IM-STP-0750(10)	1999	74	97

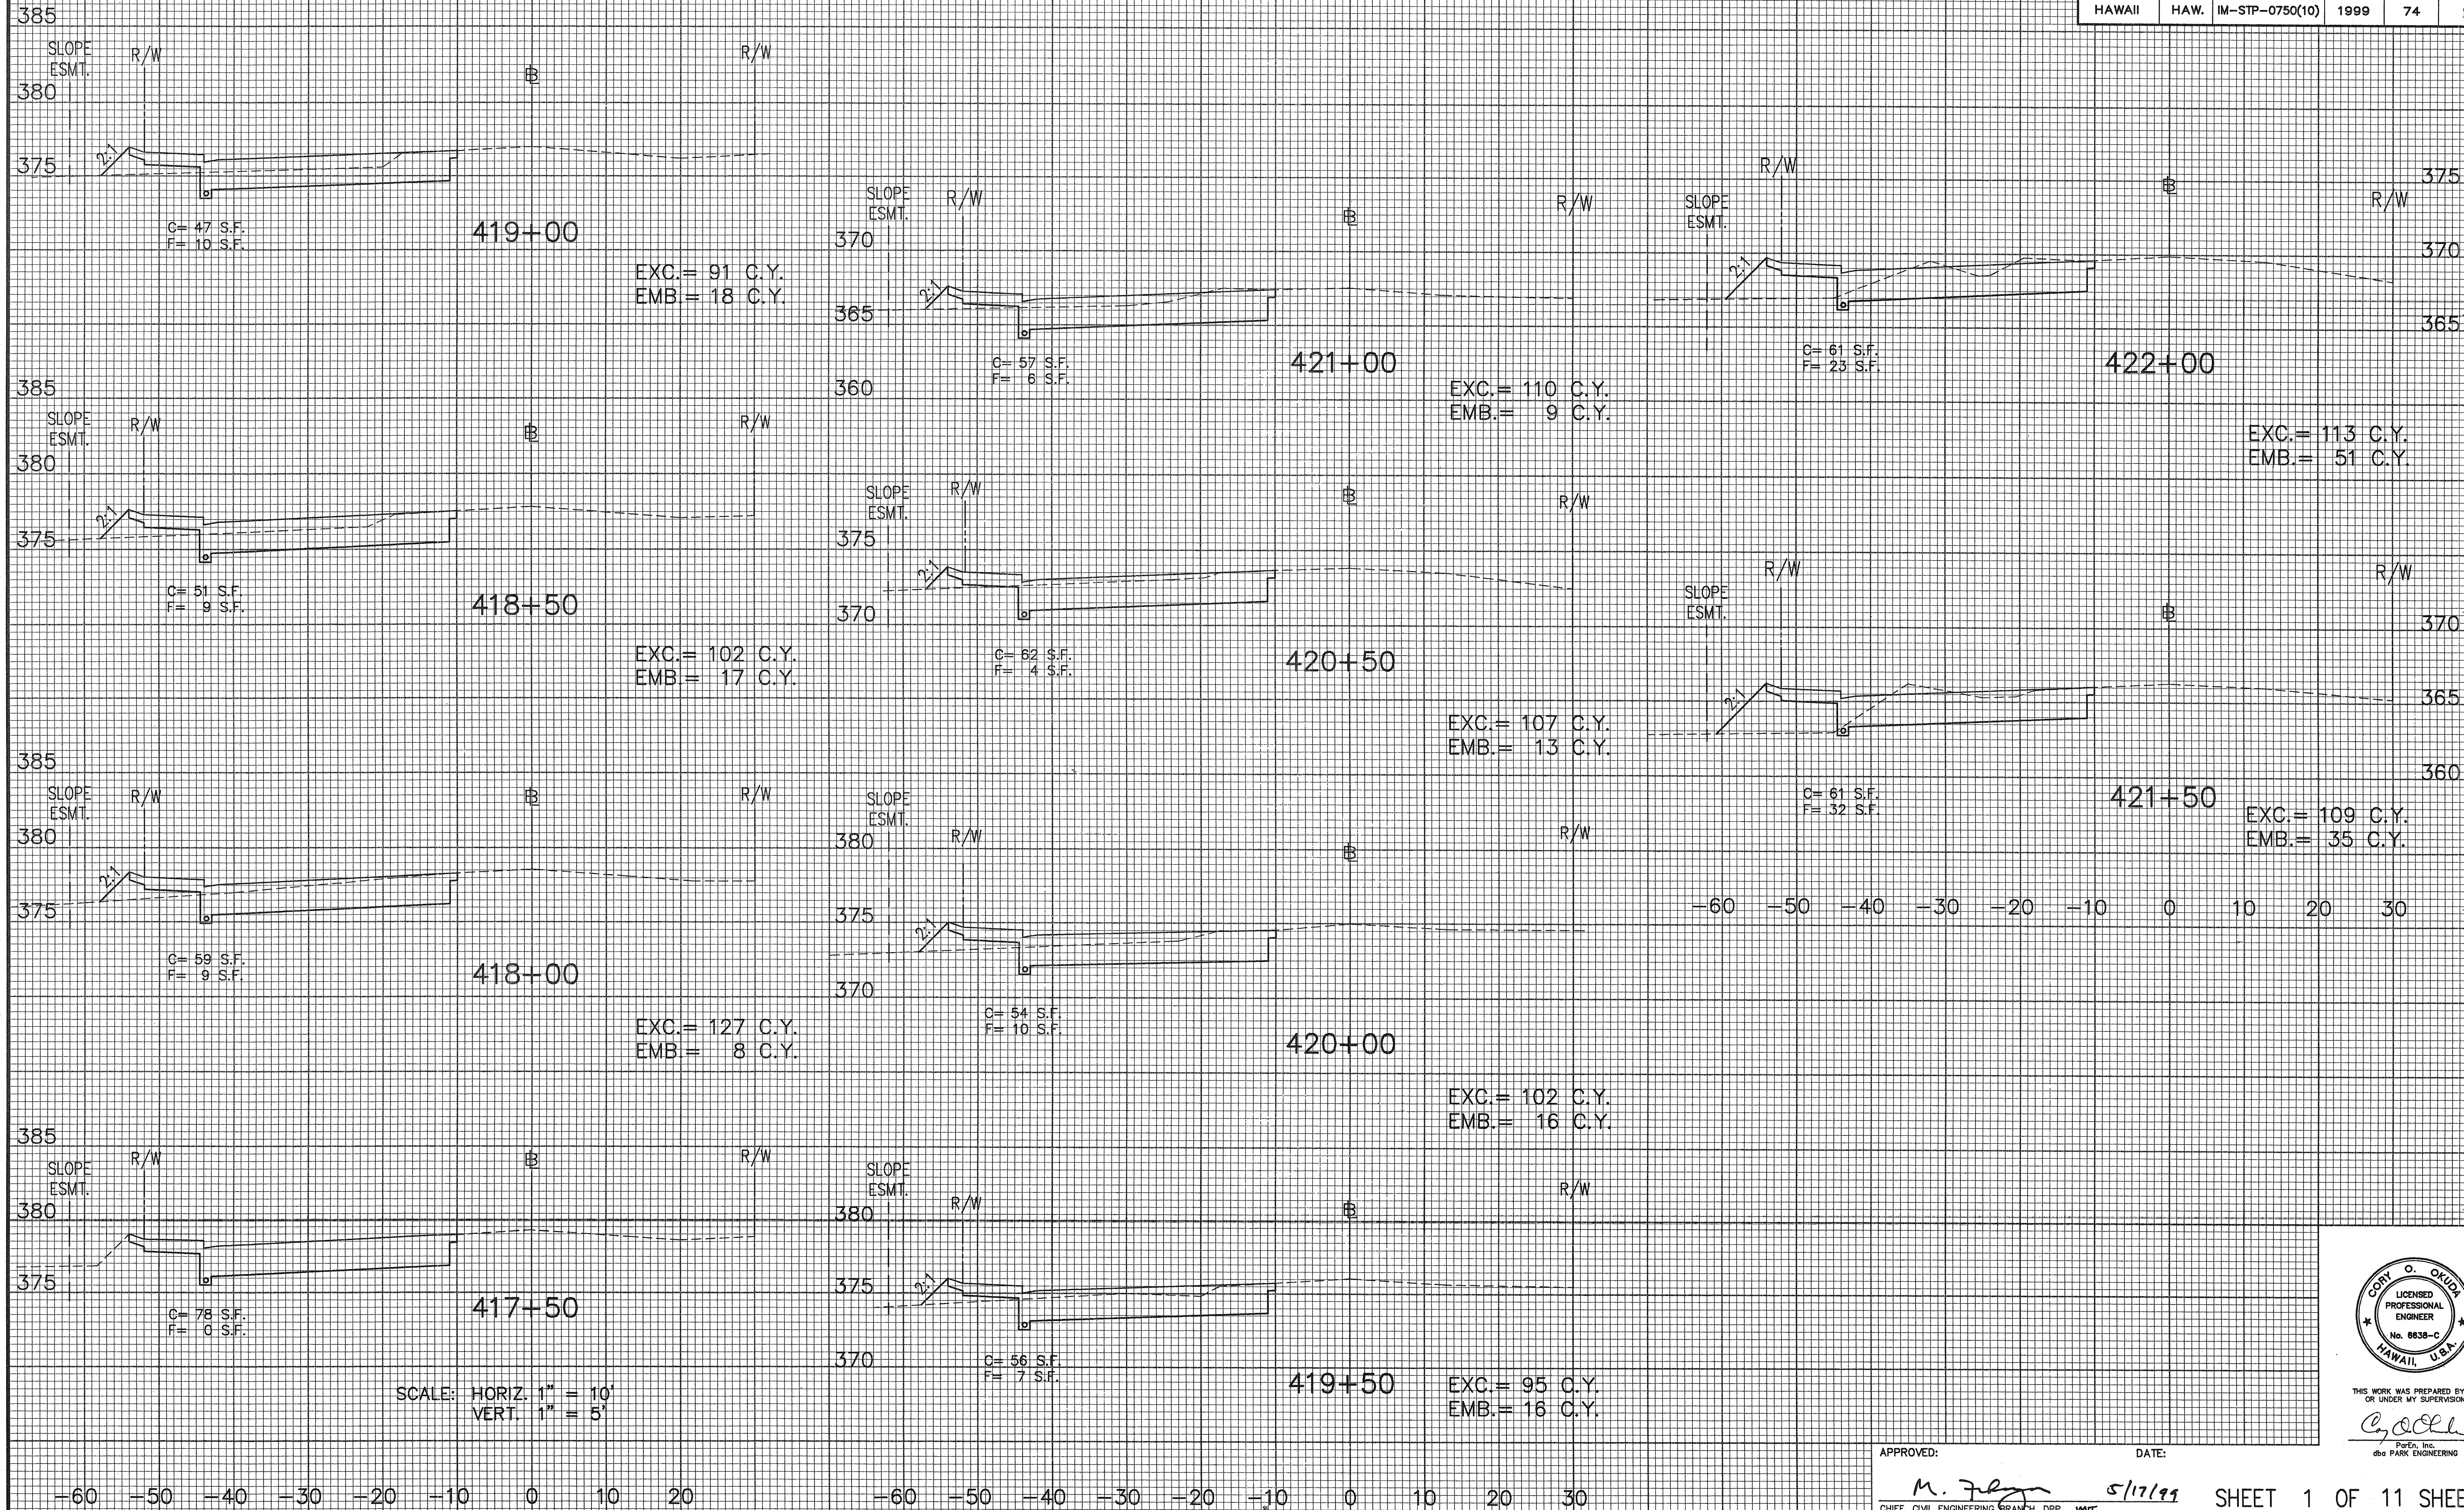

DATE: _____
SURVEY PLOTTED BY: _____
DRAWN BY: _____
CHECKED BY: _____
DESIGNED BY: _____
NOTED BY: _____
ORIGINAL PLAN: _____
NOTES: _____

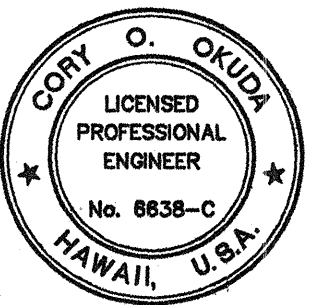


THIS WORK WAS PREPARED BY ME
OR UNDER MY SUPERVISION
C. Okuda
Park Engineering, Inc.
dba PARK ENGINEERING

APPROVED: *M. F. Fagan* 5/17/99
CHIEF, CIVIL ENGINEERING BRANCH, DPP
DATE: 5/17/99
SHEET 1 OF 11 SHEETS

FED. ROAD DIST. NO.	STATE	FED. AID PROJ. NO.	FISCAL YEAR	SHEET NO.	TOTAL SHEETS
HAWAII	HAW.	IM-STP-0750(10)	1999	75	97


ORIGINAL PLAN
DATE
SURVEY PLOTTED BY
DRAWN BY
DESIGNED BY
CHECKED BY

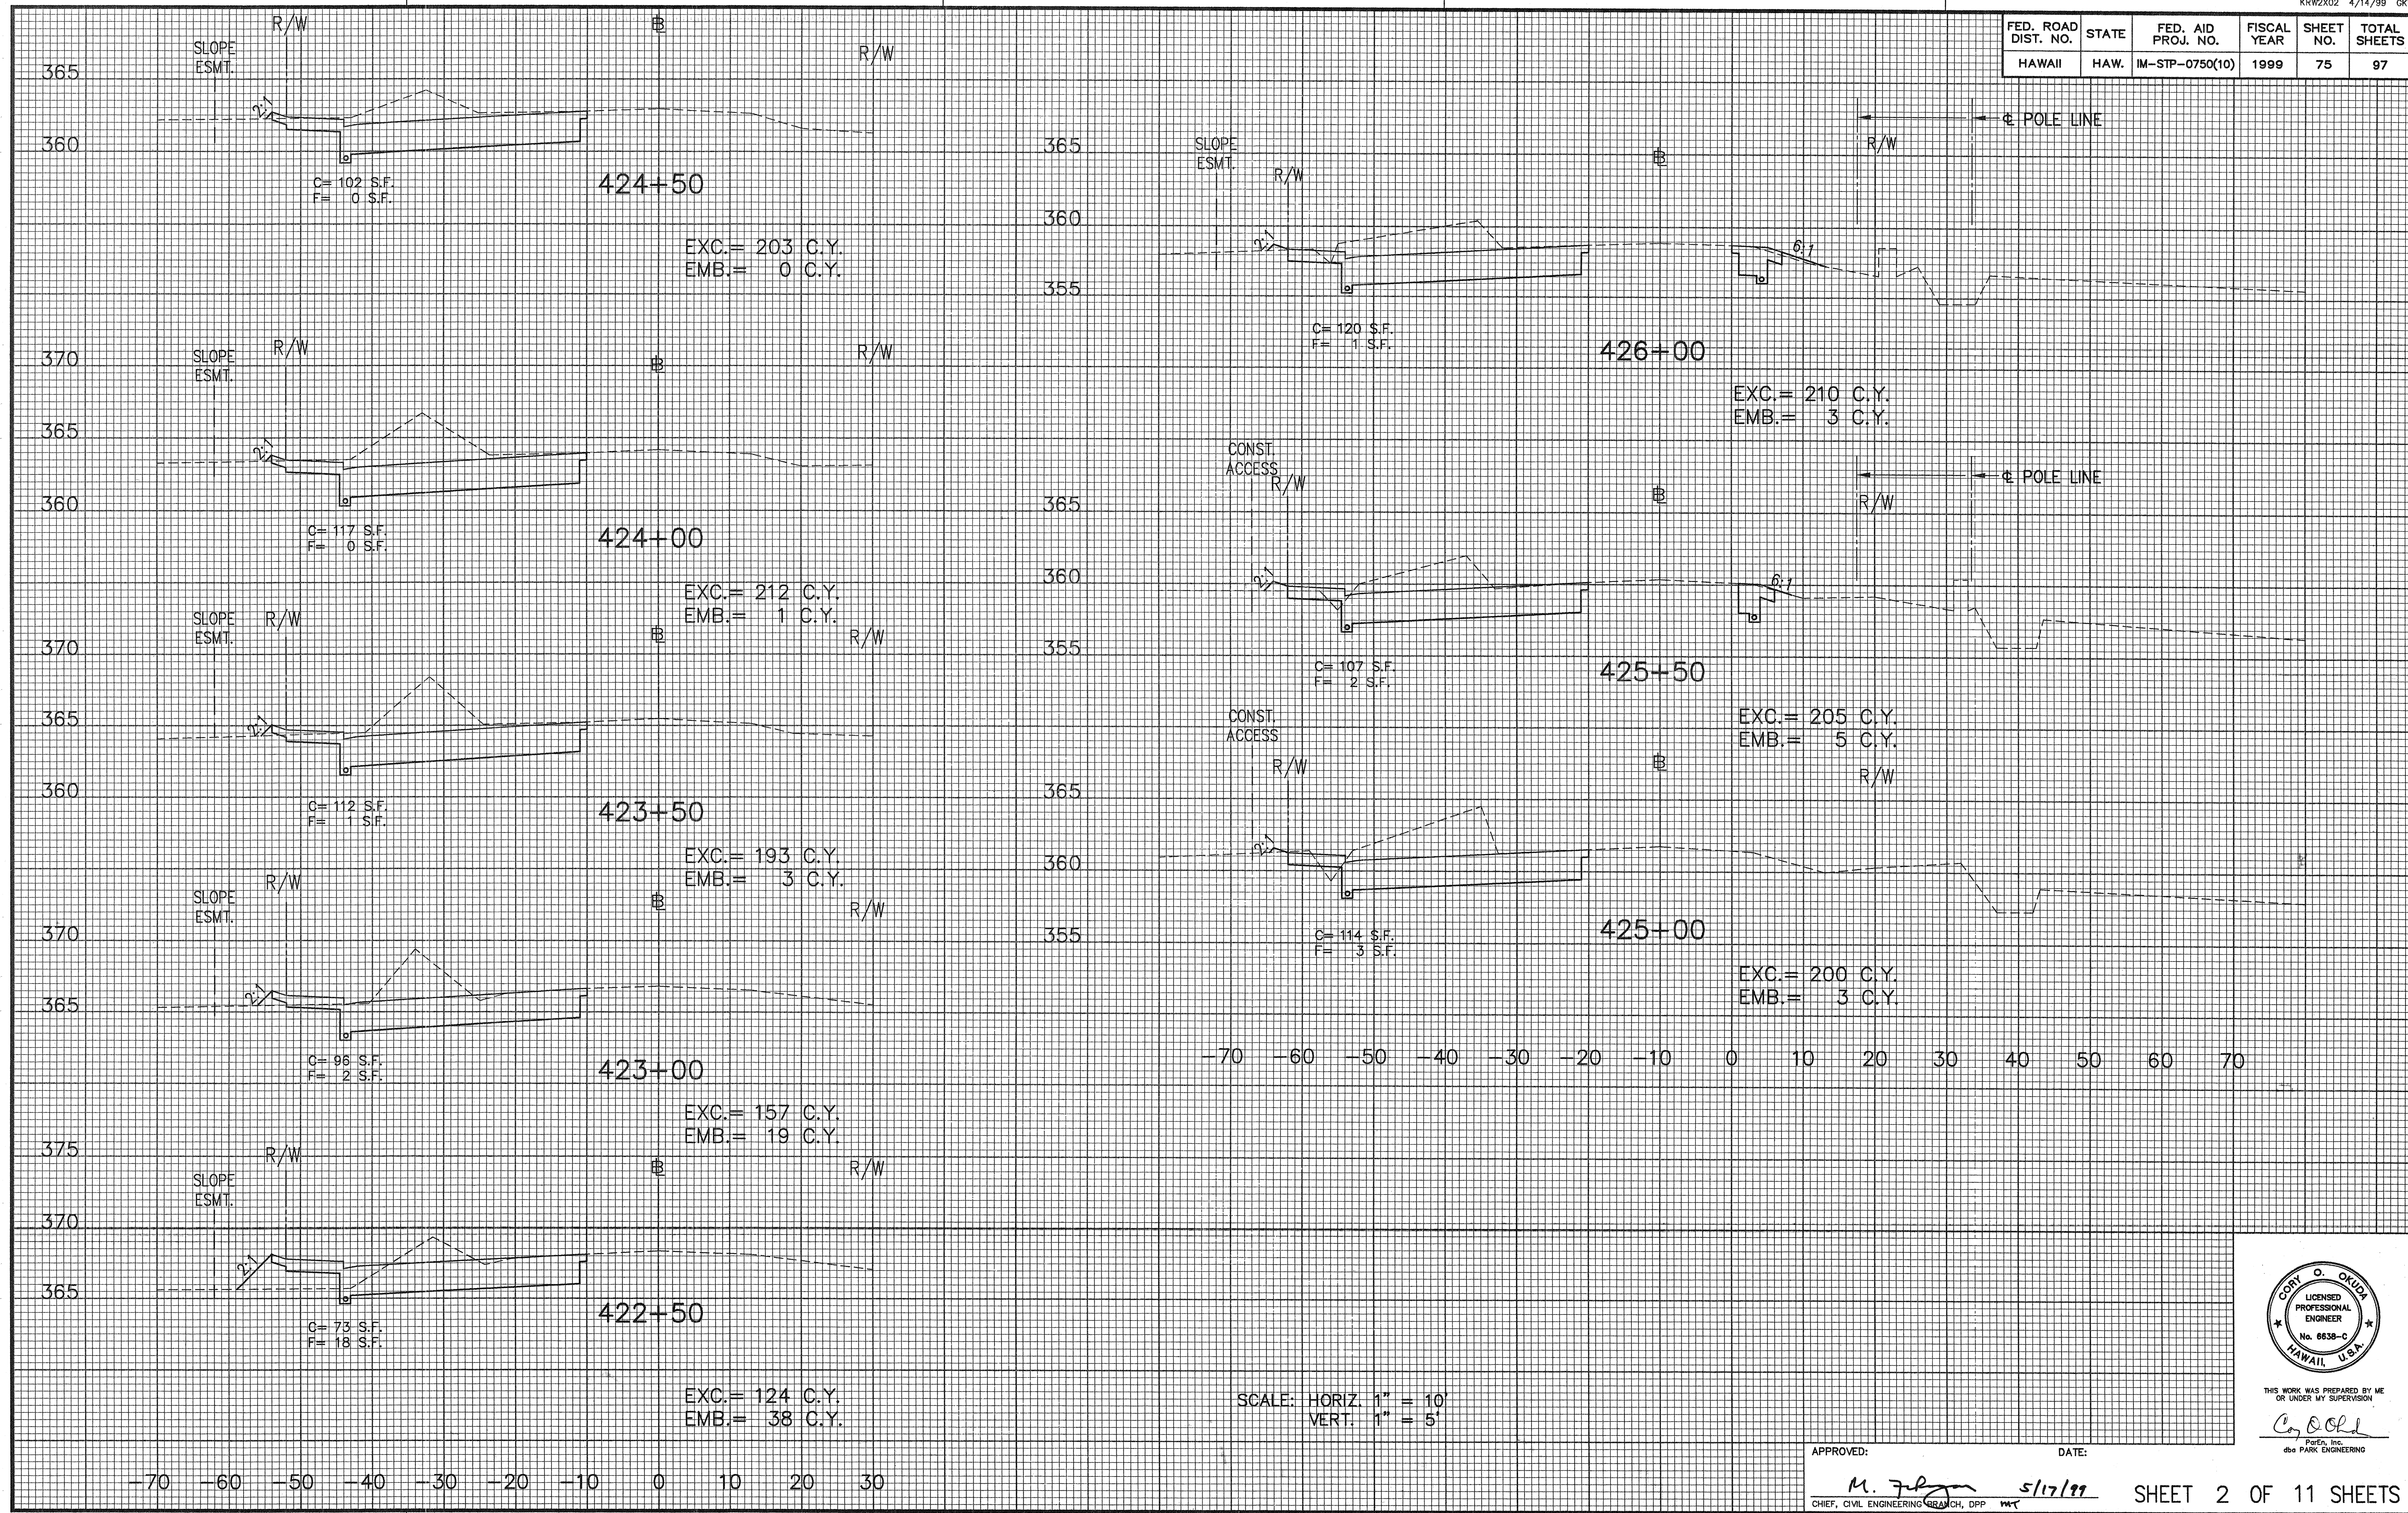

SCALE: HORIZ. 1" = 10'
VERT. 1" = 5'


APPROVED: *M. J. [Signature]* 5/17/99
DATE: 5/17/99
CHIEF, CIVIL ENGINEERING BRANCH, DPP

SHEET 2 OF 11 SHEETS

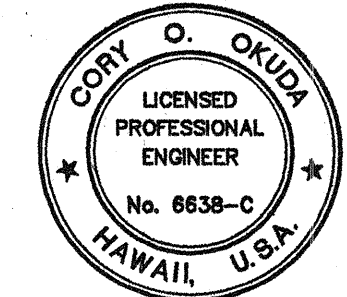


THIS WORK WAS PREPARED BY ME OR UNDER MY SUPERVISION
Cory O. Okuda
P.E., Inc.
dba PARK ENGINEERING

FED. ROAD DIST. NO.	STATE	FED. AID PROJ. NO.	FISCAL YEAR	SHEET NO.	TOTAL SHEETS
HAWAII	HAW.	IM-STP-0750(10)	1999	76	97

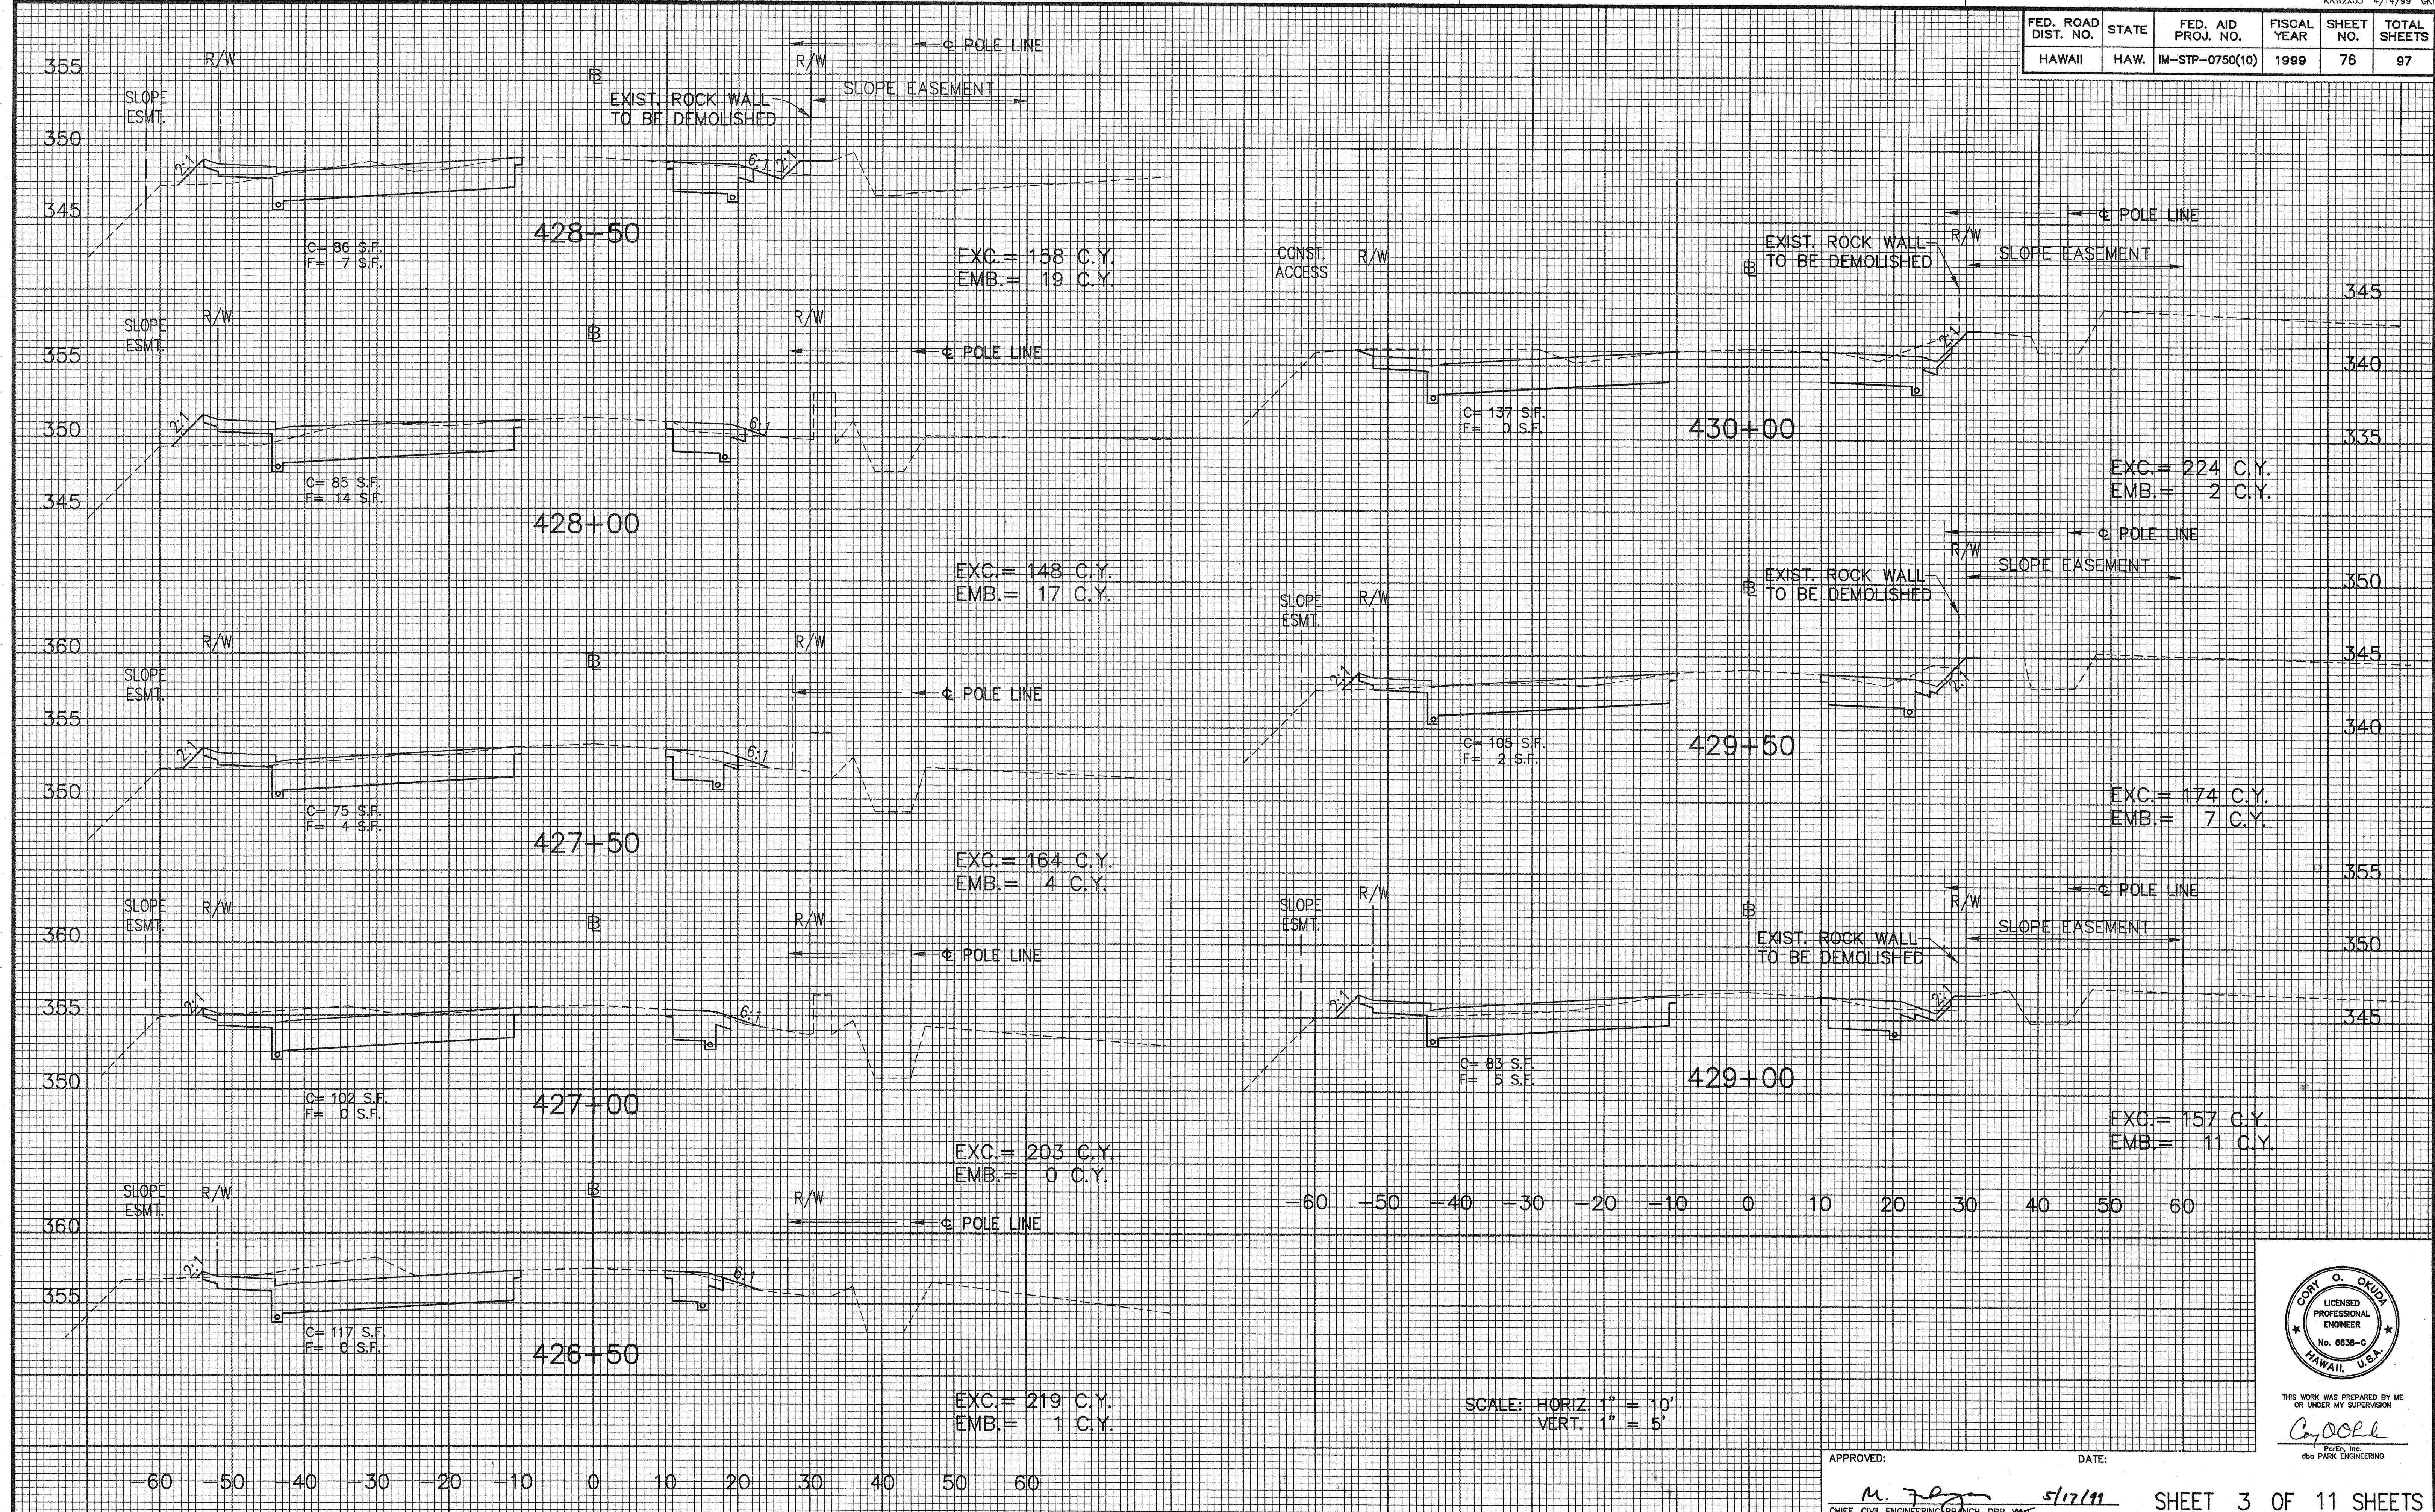


DATE _____
 SURVEY PLOTTED BY _____
 DRAWN BY _____
 CHECKED BY _____
 ORIGINAL _____
 PLAN _____
 NOTEBOOK _____
 No. _____

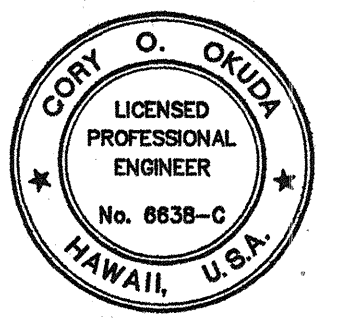


THIS WORK WAS PREPARED BY ME
 OR UNDER MY SUPERVISION
 Cory O. Orda
 Park, Inc.
 680 PARK ENGINEERING

APPROVED: M. J. [Signature] 5/17/99
 CHIEF, CIVIL ENGINEERING BRANCH, DPP
 DATE: _____
 SHEET 3 OF 11 SHEETS

FED. ROAD DIST. NO.	STATE	FED. AID PROJ. NO.	FISCAL YEAR	SHEET NO.	TOTAL SHEETS

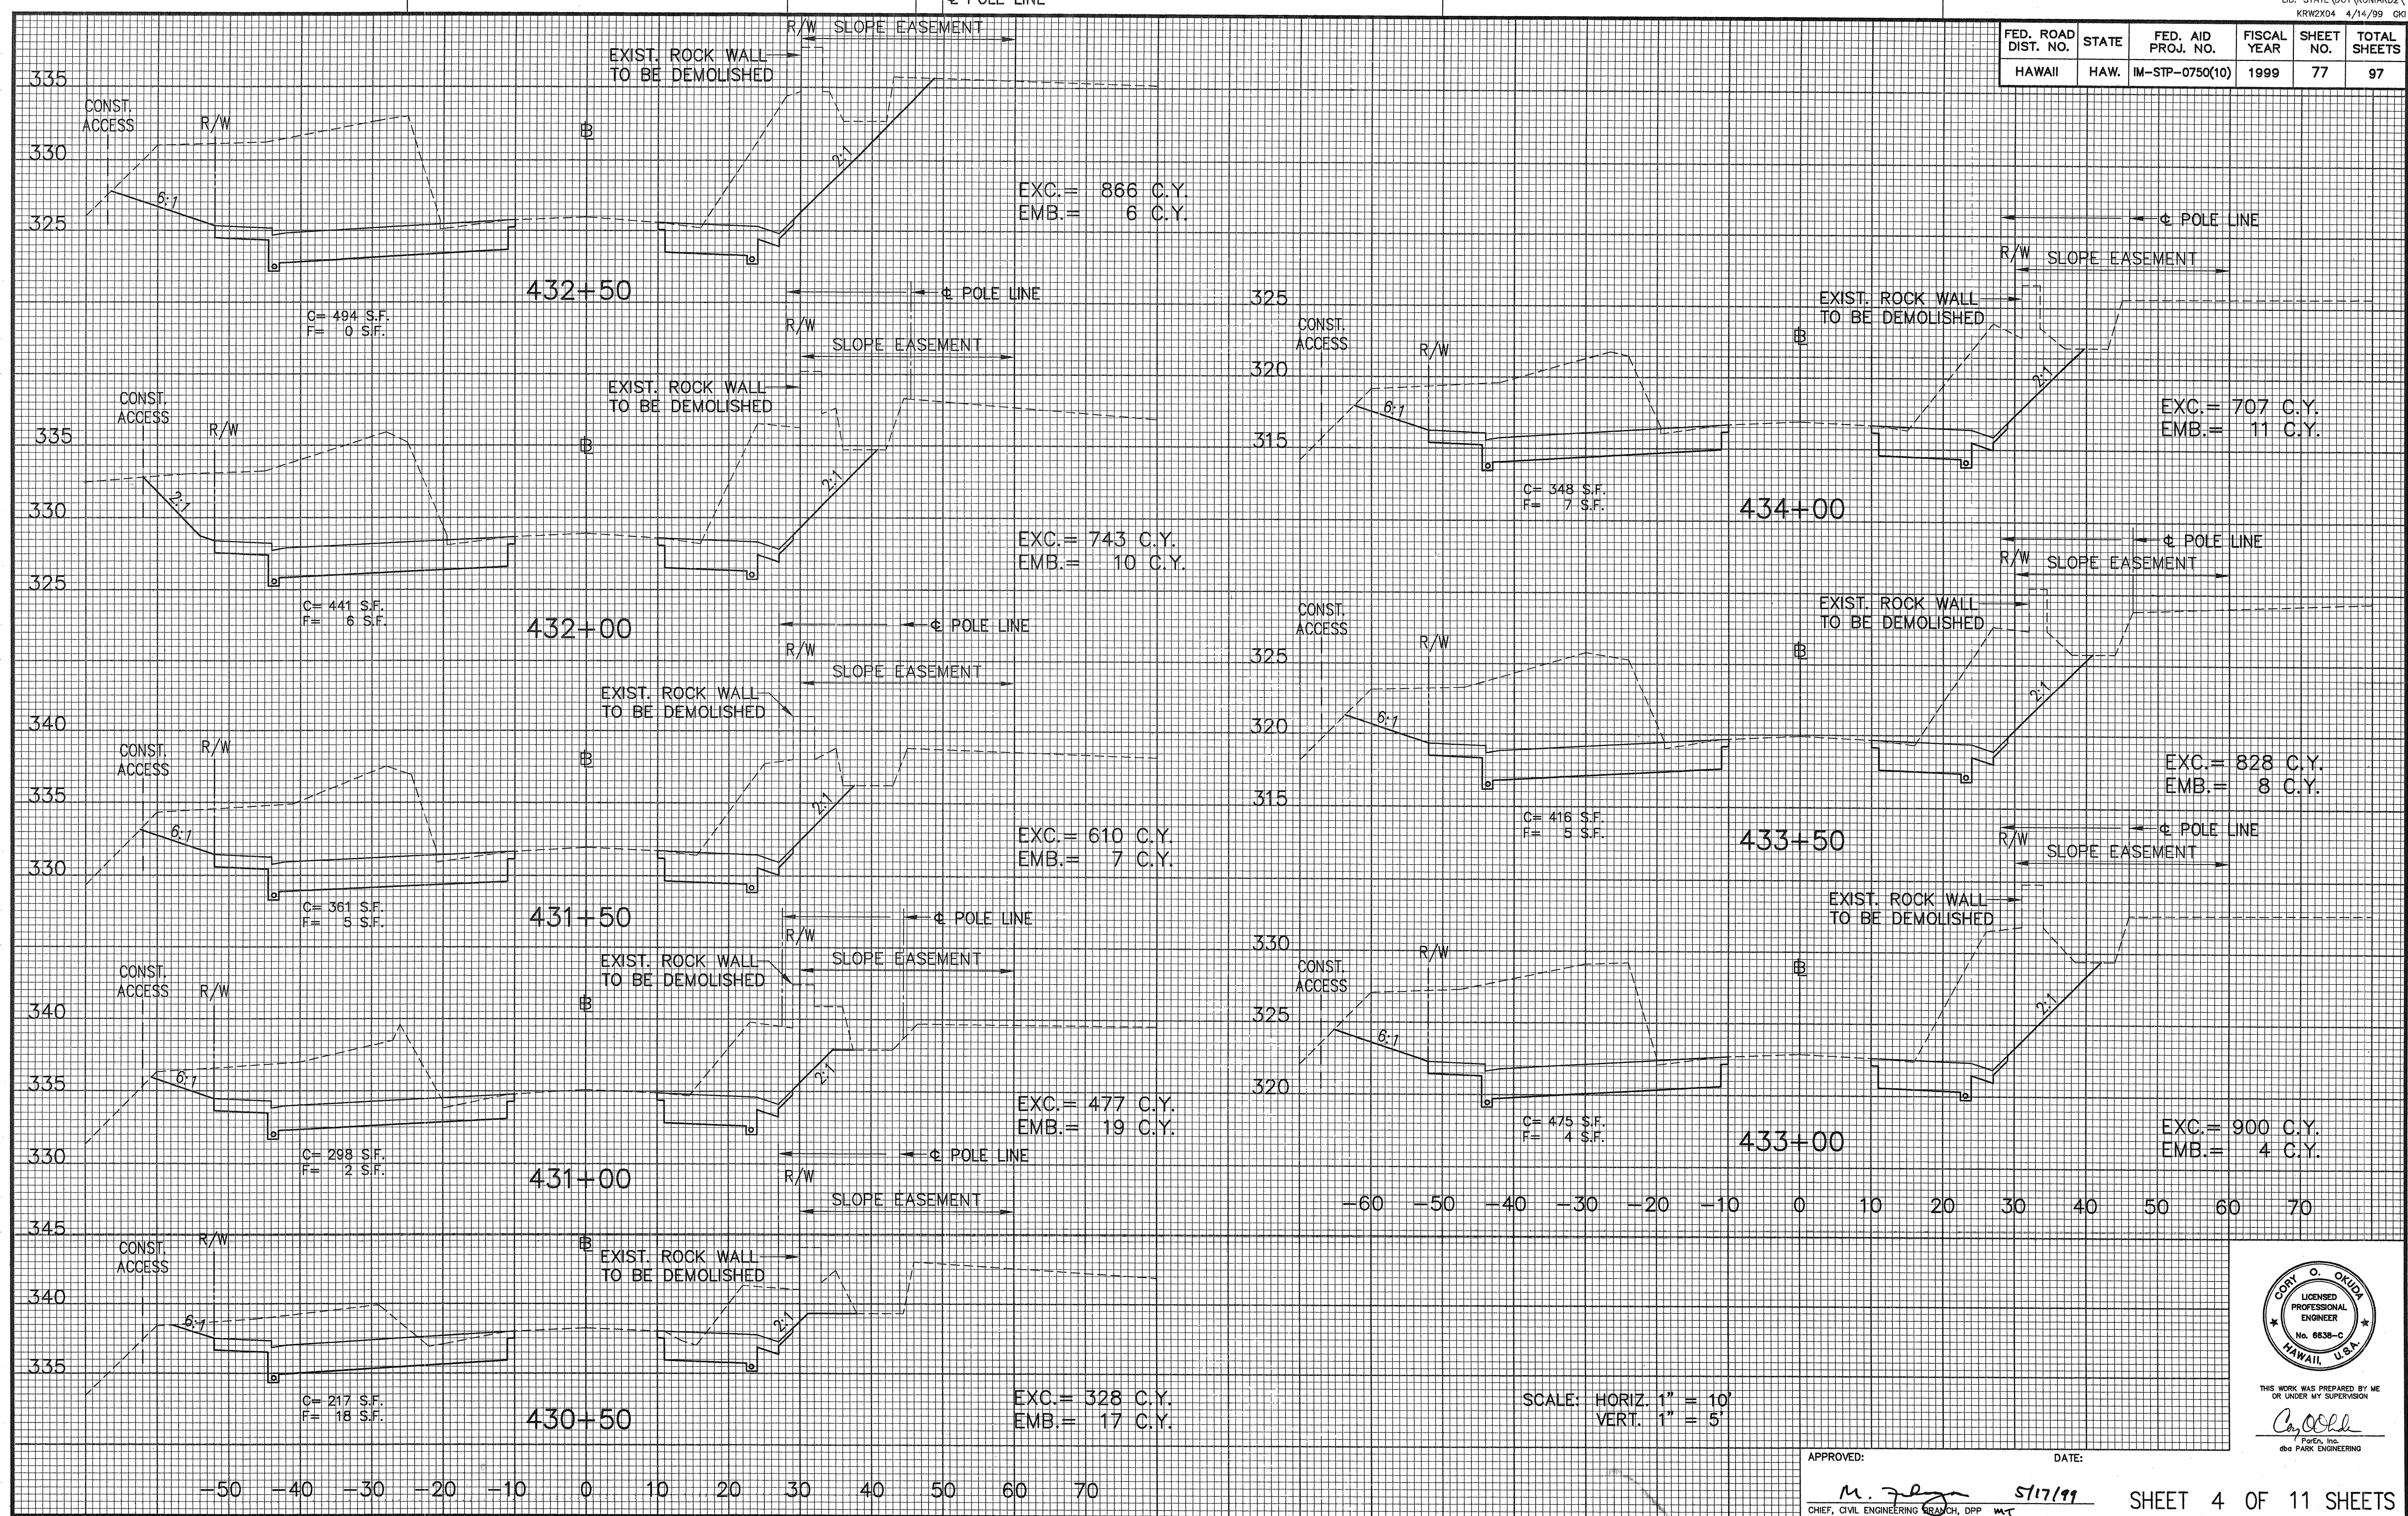


DATE	_____
SURVEY PLOTTED BY	_____
DRAWN BY	_____
DESIGNED BY	_____
CHECKED BY	_____
ORIGINAL PLAN	_____
NOTES	_____

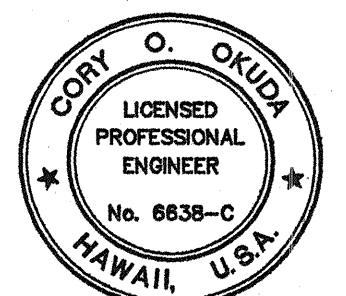


THIS WORK WAS PREPARED BY ME OR UNDER MY SUPERVISION
Cory O. Okida
 Cory O. Okida
 dba PARK ENGINEERING

APPROVED: *M. J. [Signature]* 5/17/99
 CHIEF, CIVIL ENGINEERING BRANCH, DPP MT

FED. ROAD DIST. NO.	STATE	FED. AID PROJ. NO.	FISCAL YEAR	SHEET NO.	TOTAL SHEETS


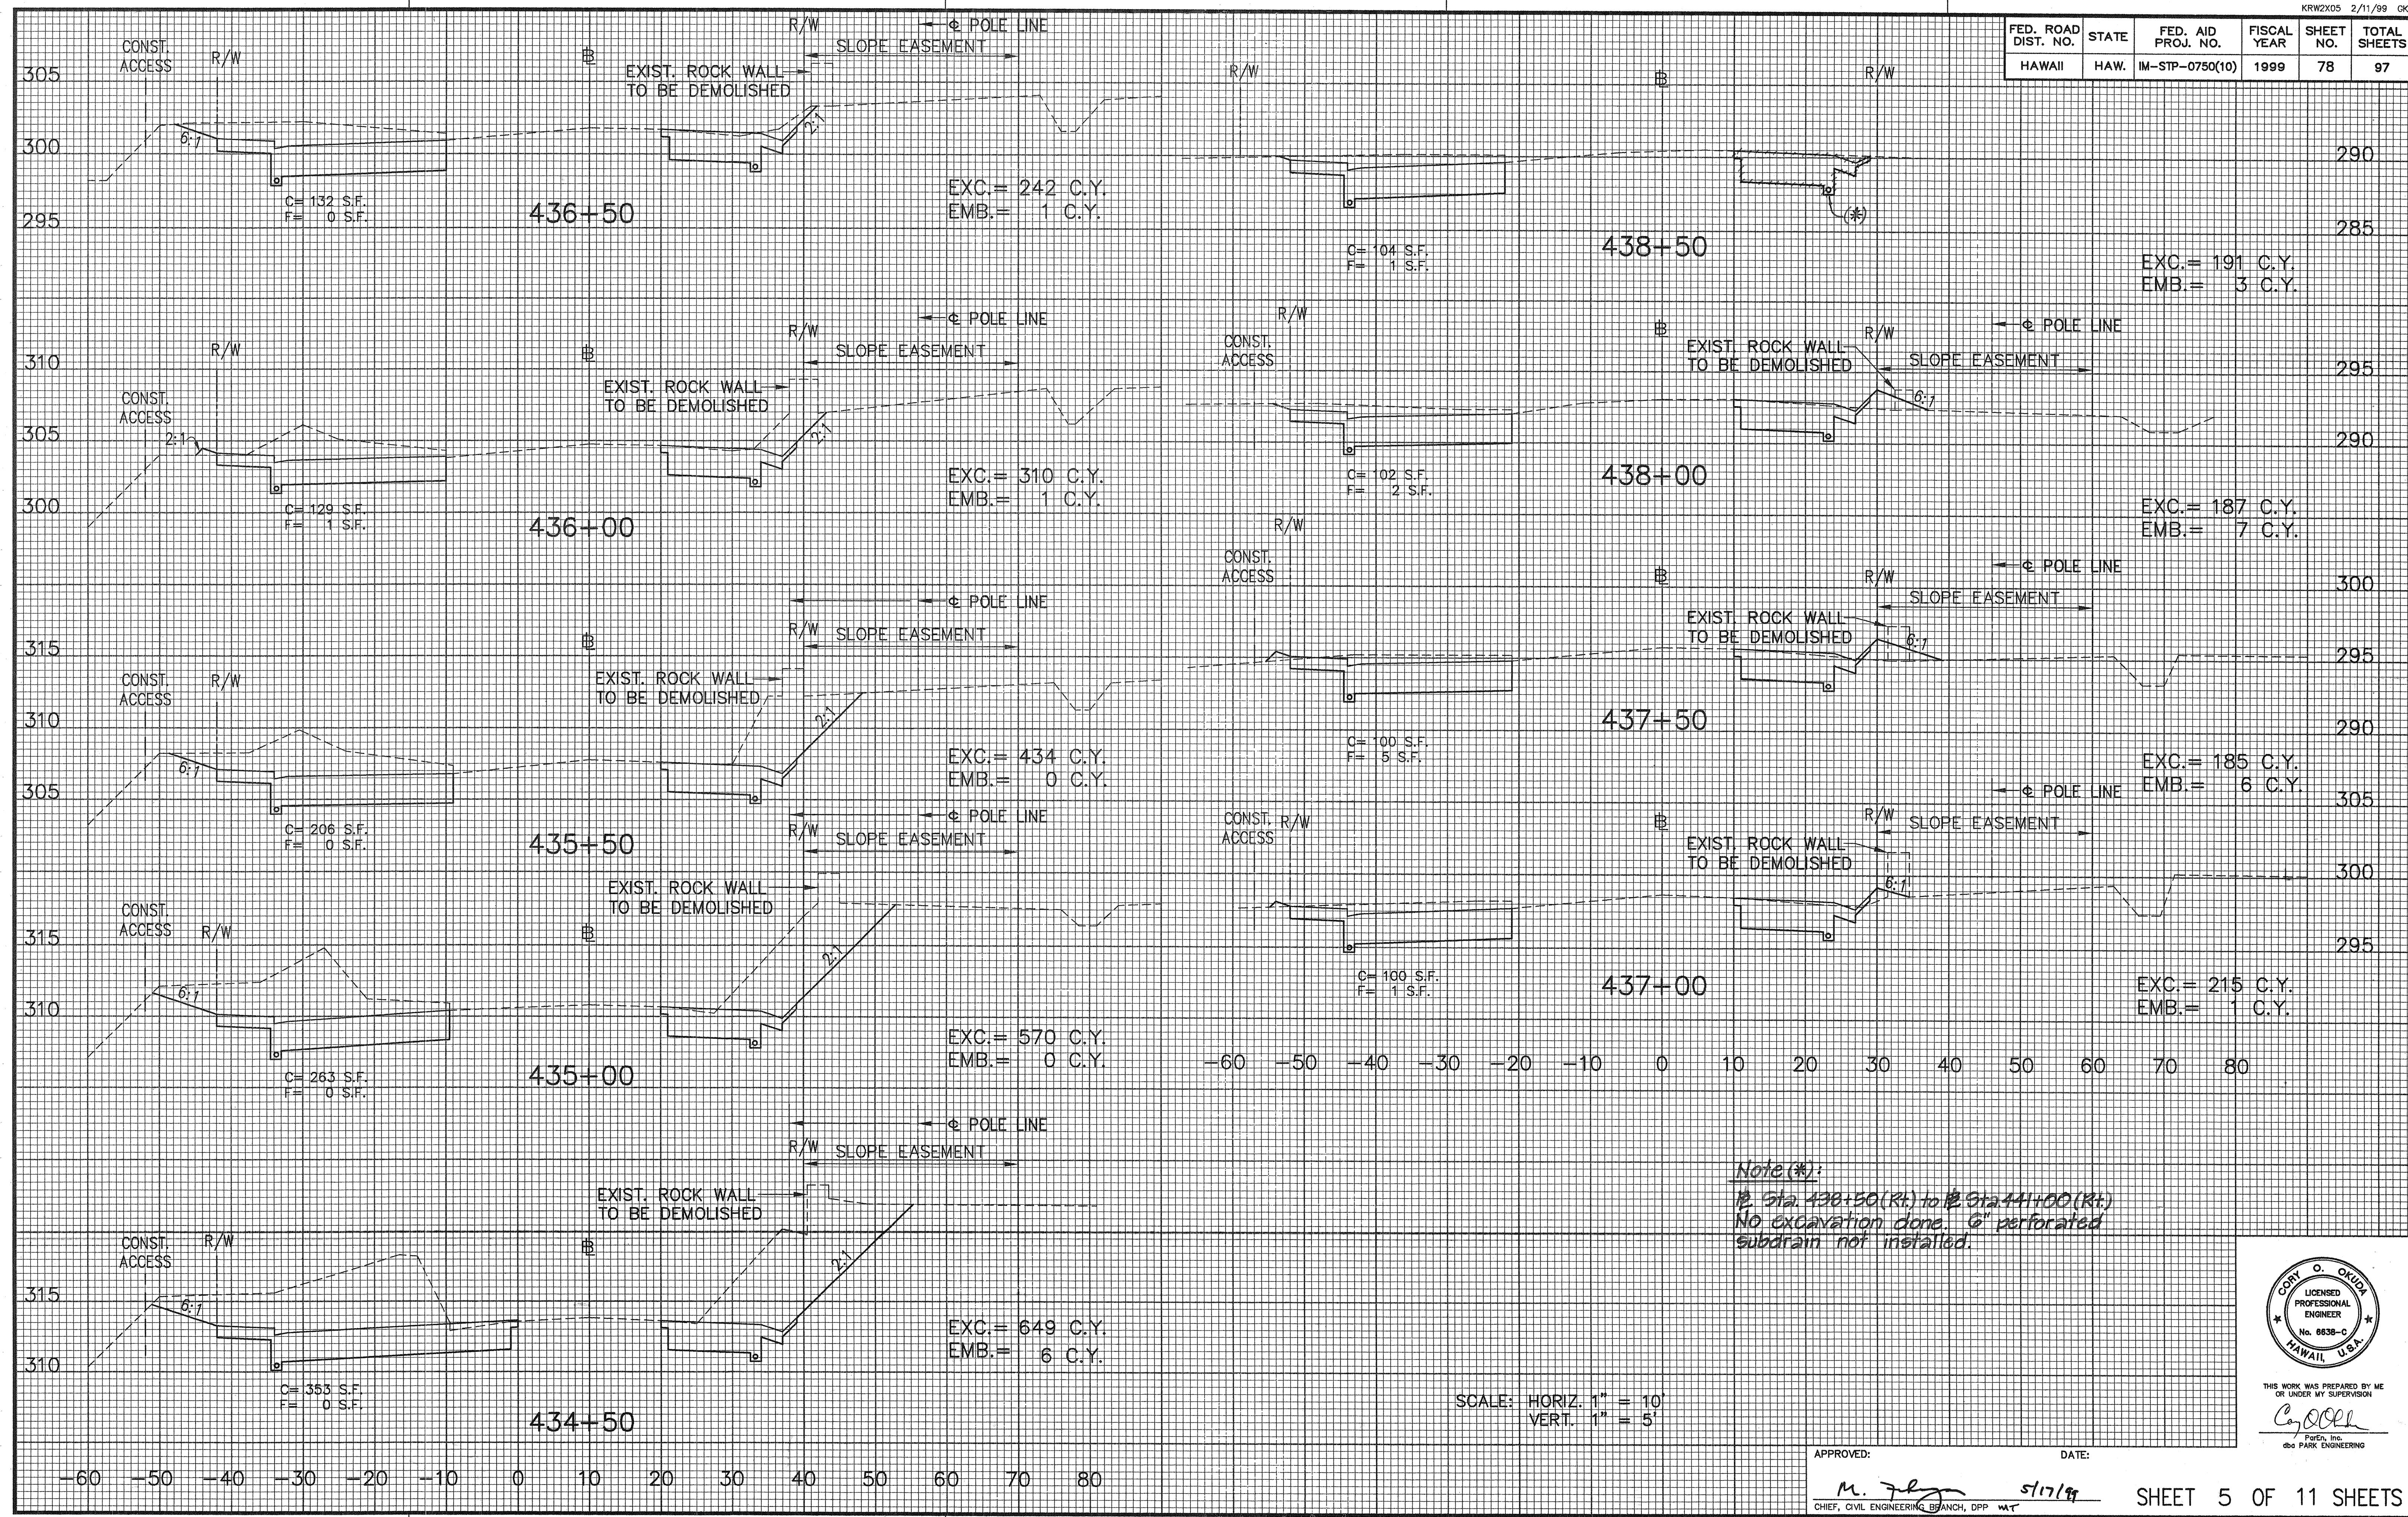


DATE	_____
SURVEY PLANNED BY	_____
DRAWN BY	_____
DESIGNED BY	_____
QUANTITIES BY	_____
CHECKED BY	_____
ORIGINAL PLAN	_____
NOTES	_____

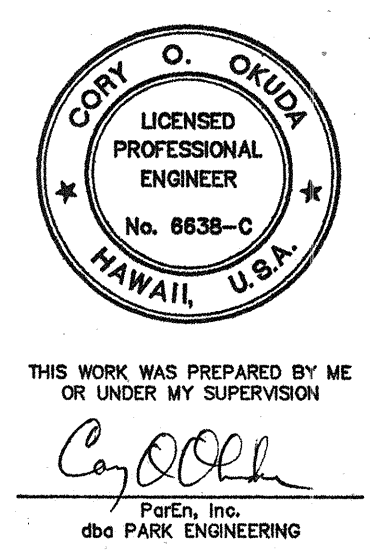

APPROVED: M. J. [Signature] 5/17/99 DATE: _____
CHIEF, CIVIL ENGINEERING BRANCH, DPP MAT SHEET 5 OF 11 SHEETS

FED. ROAD DIST. NO.	STATE	FED. AID PROJ. NO.	FISCAL YEAR	SHEET NO.	TOTAL SHEETS
HAWAII	HAW.	IM-STP-0750(10)	1999	79	97

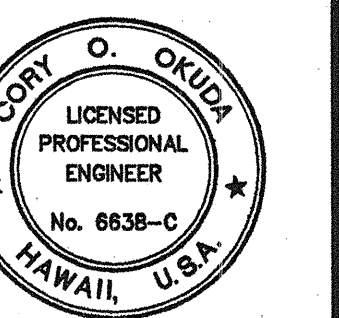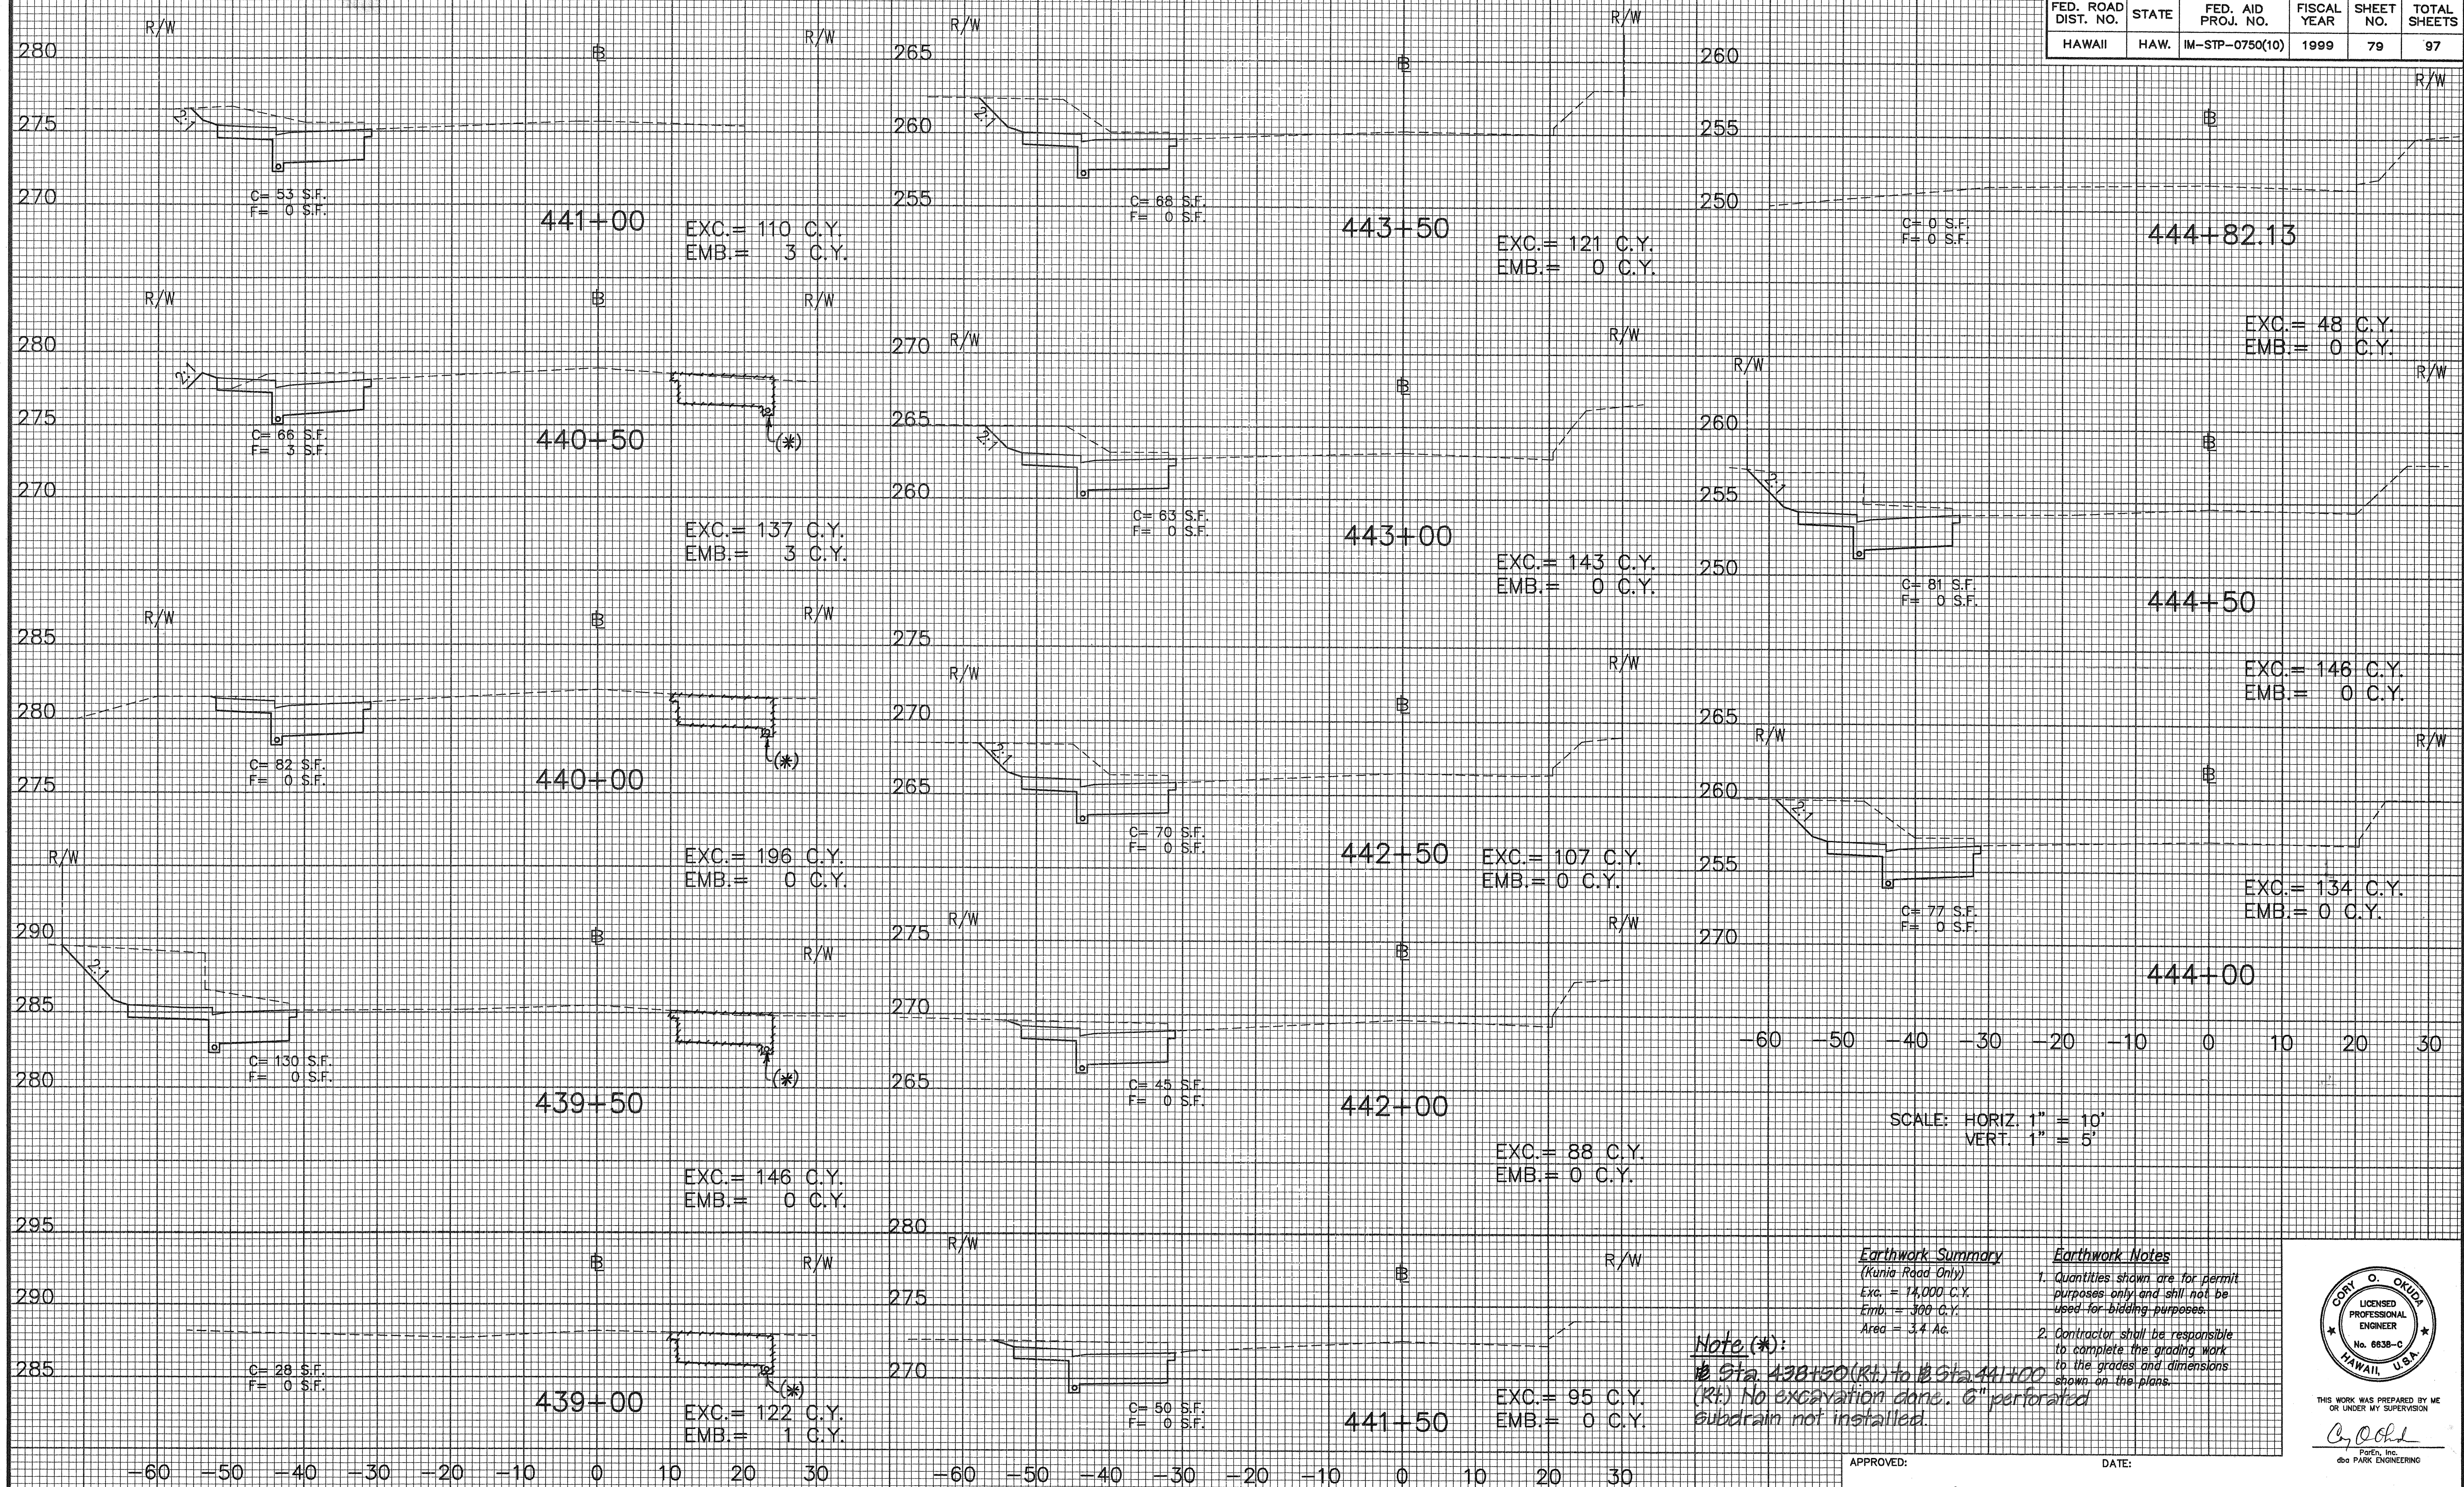


THIS WORK WAS PREPARED BY ME OR UNDER MY SUPERVISION


Cory O. Okuda
P.E., Inc.
dba PARK ENGINEERINGAPPROVED: M. J. [Signature] 5/17/99
CHIEF, CIVIL ENGINEERING BRANCH, DPP

SHEET 6 OF 11 SHEETS

FED. ROAD DIST. NO.	STATE	FED. AID PROJ. NO.	FISCAL YEAR	SHEET NO.	TOTAL SHEETS
HAWAII	HAW.	IM-STP-0750(10)	1999	80	97

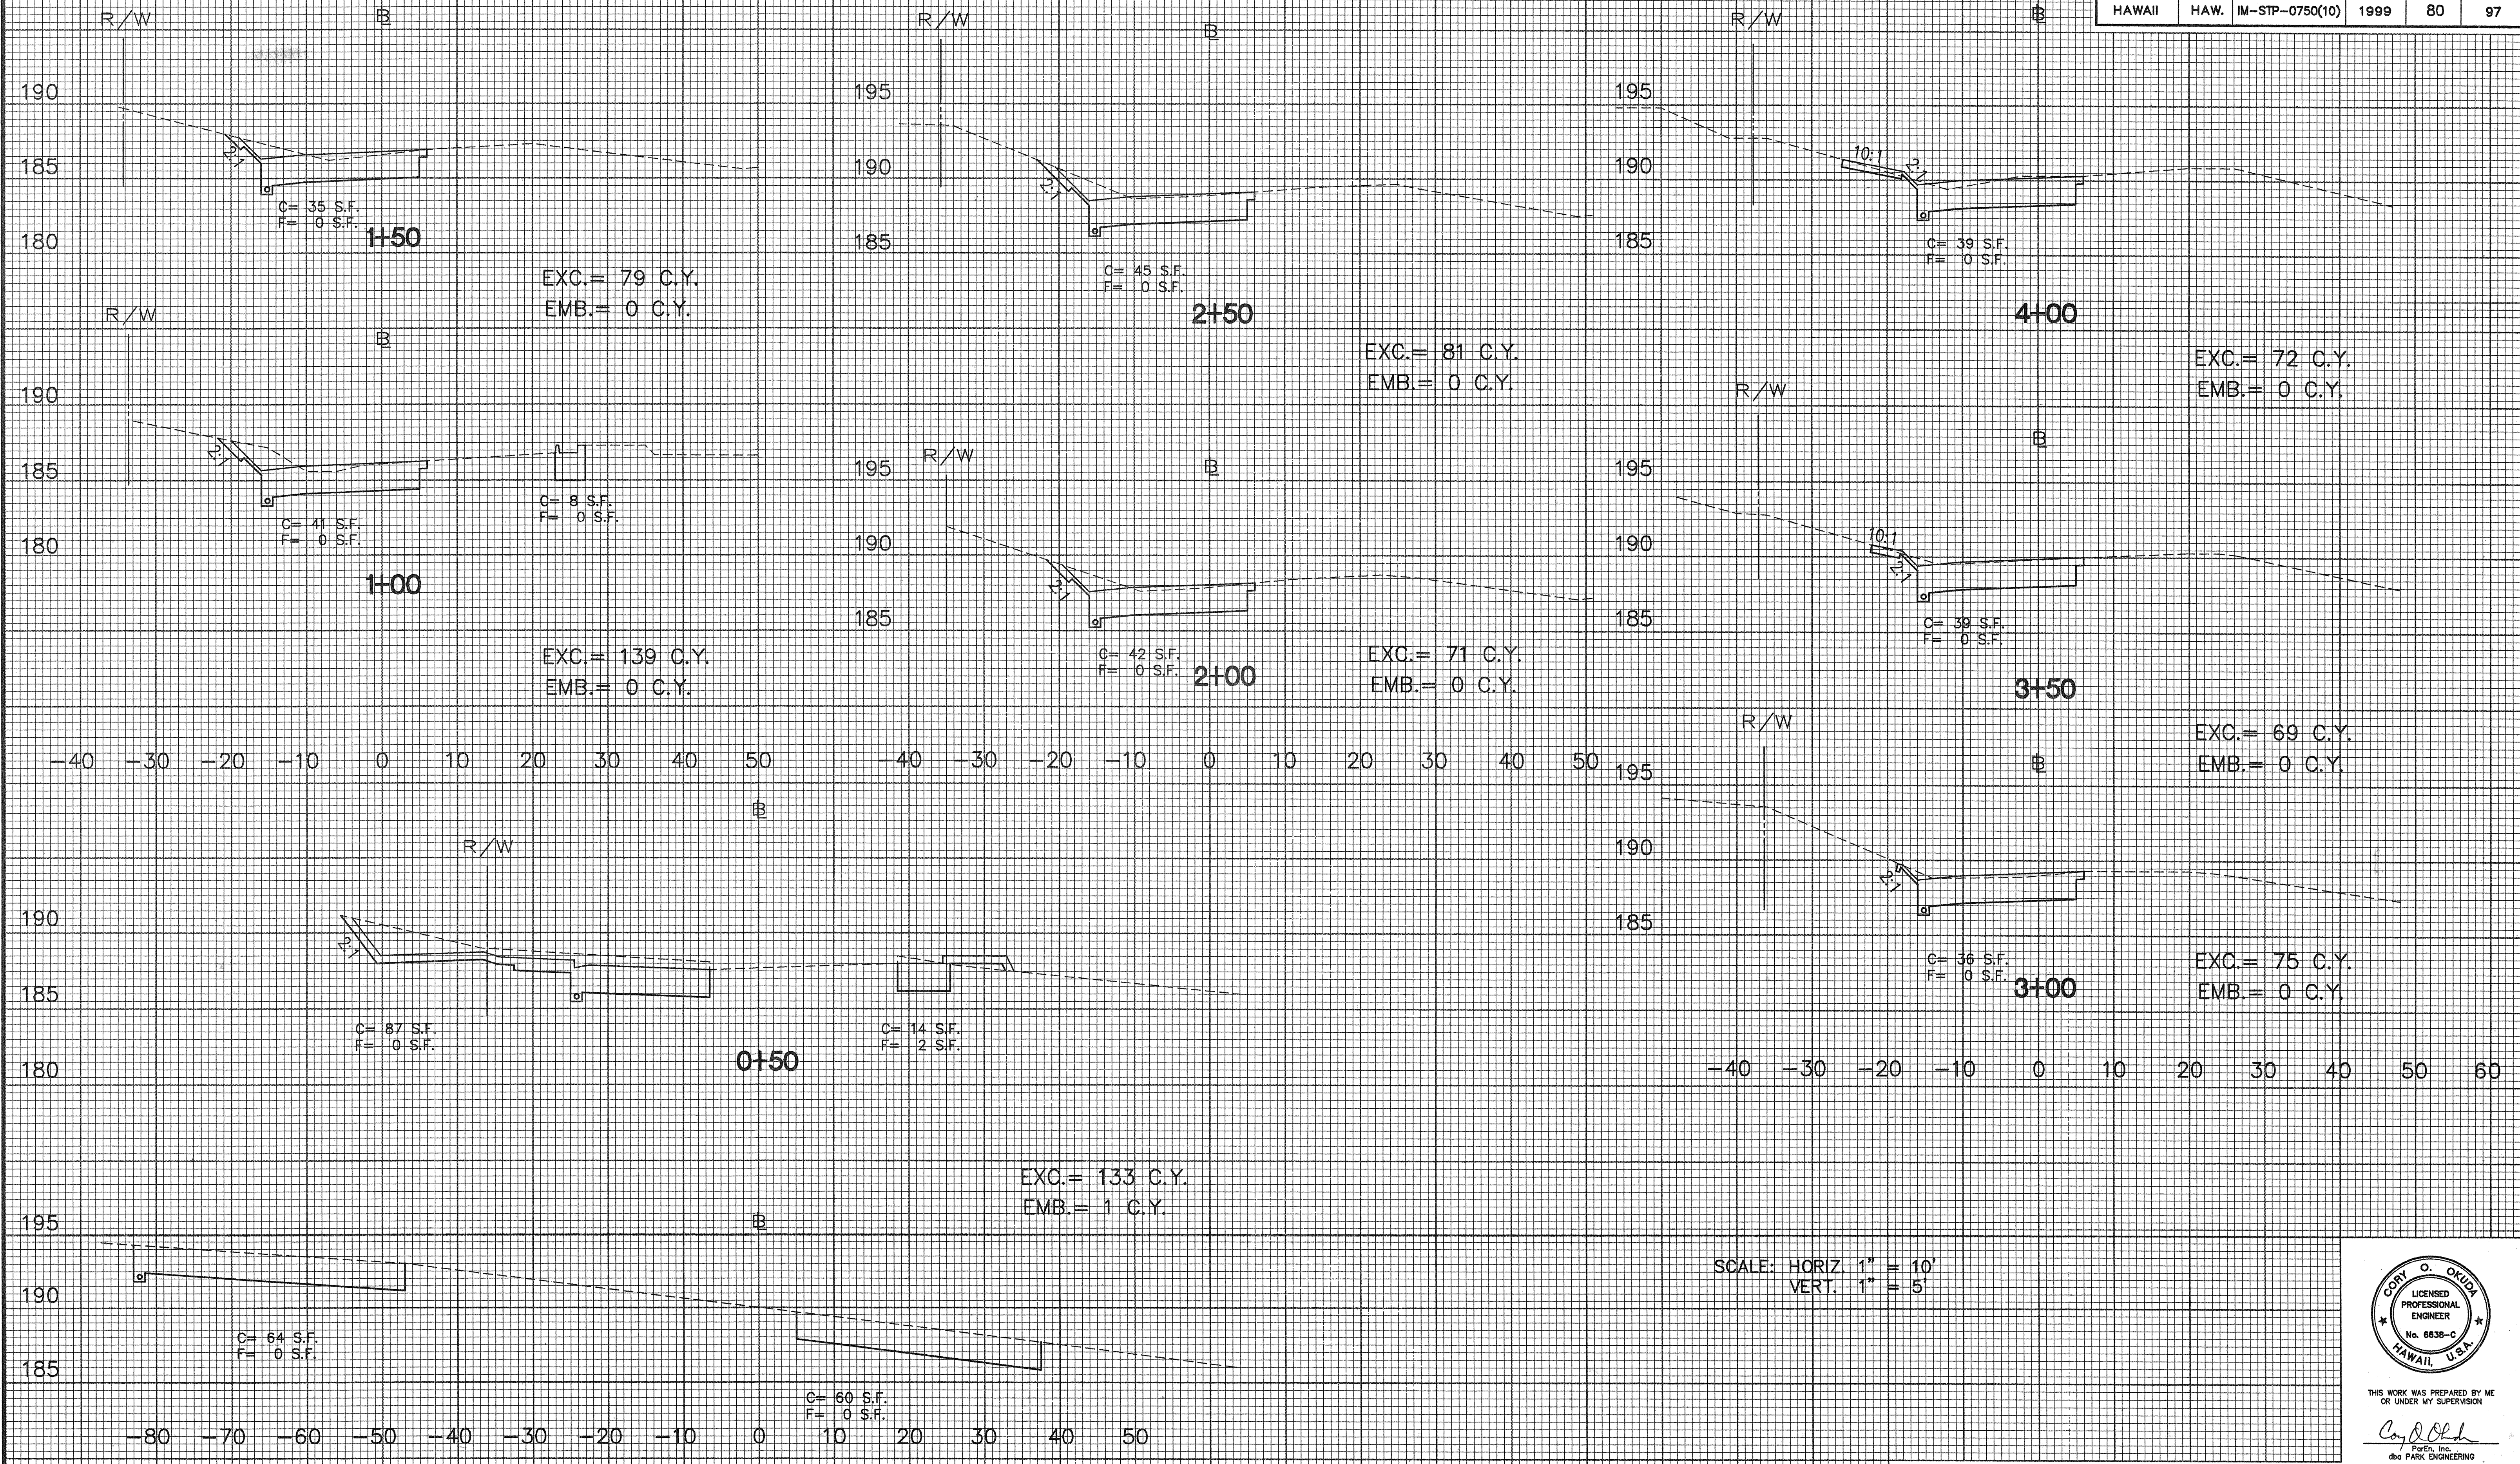



ORIGINAL PLAN
NO. _____
DESIGNED BY _____
CHECKED BY _____
DATE _____

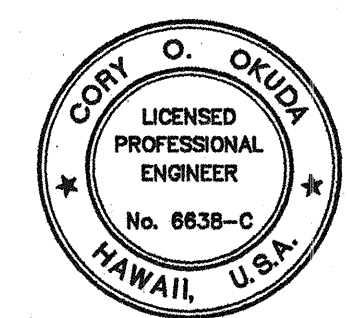

THIS WORK WAS PREPARED BY ME
OR UNDER MY SUPERVISION
Cory O. Oruda
Cory O. Oruda
dba PARK ENGINEERING


APPROVED: *M. J. [Signature]* 5/17/99
CHIEF, CIVIL ENGINEERING BRANCH, DPP
DATE: _____
SHEET 7 OF 11 SHEETS

FED. ROAD DIST. NO.	STATE	FED. AID PROJ. NO.	FISCAL YEAR	SHEET NO.	TOTAL SHEETS
HAWAII	HAW.	IM-STP-0750(10)	1999	81	97

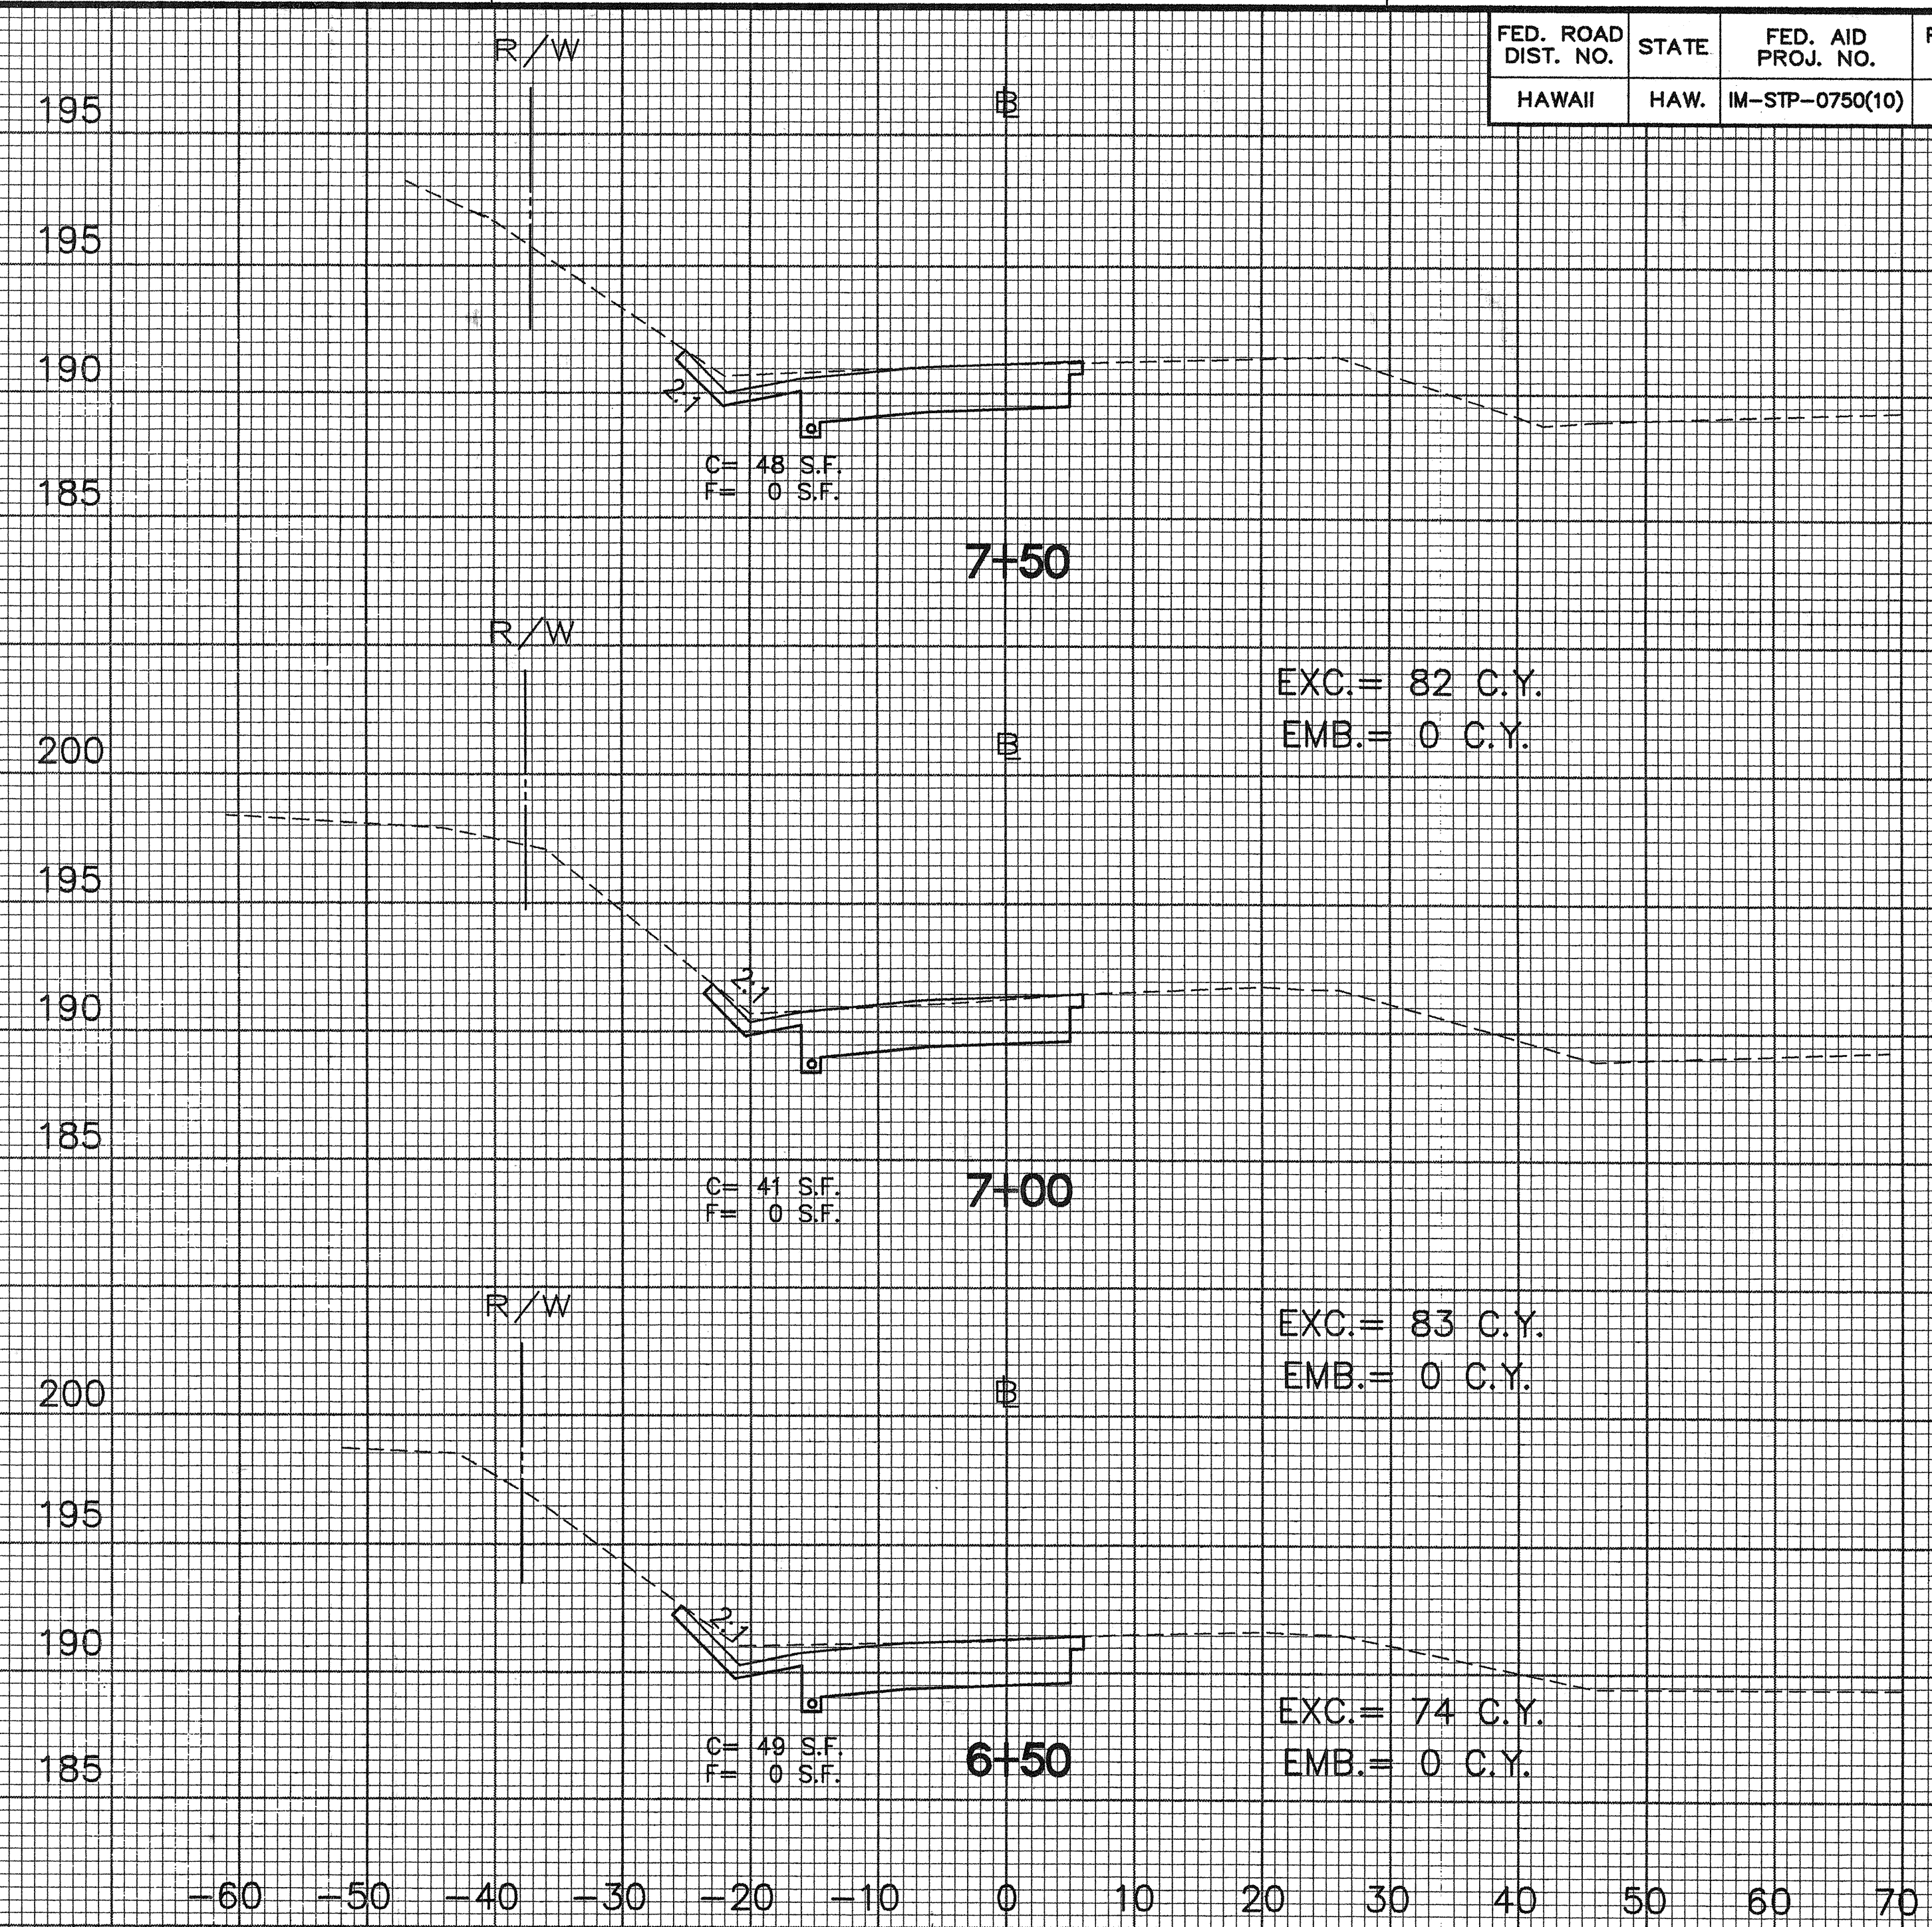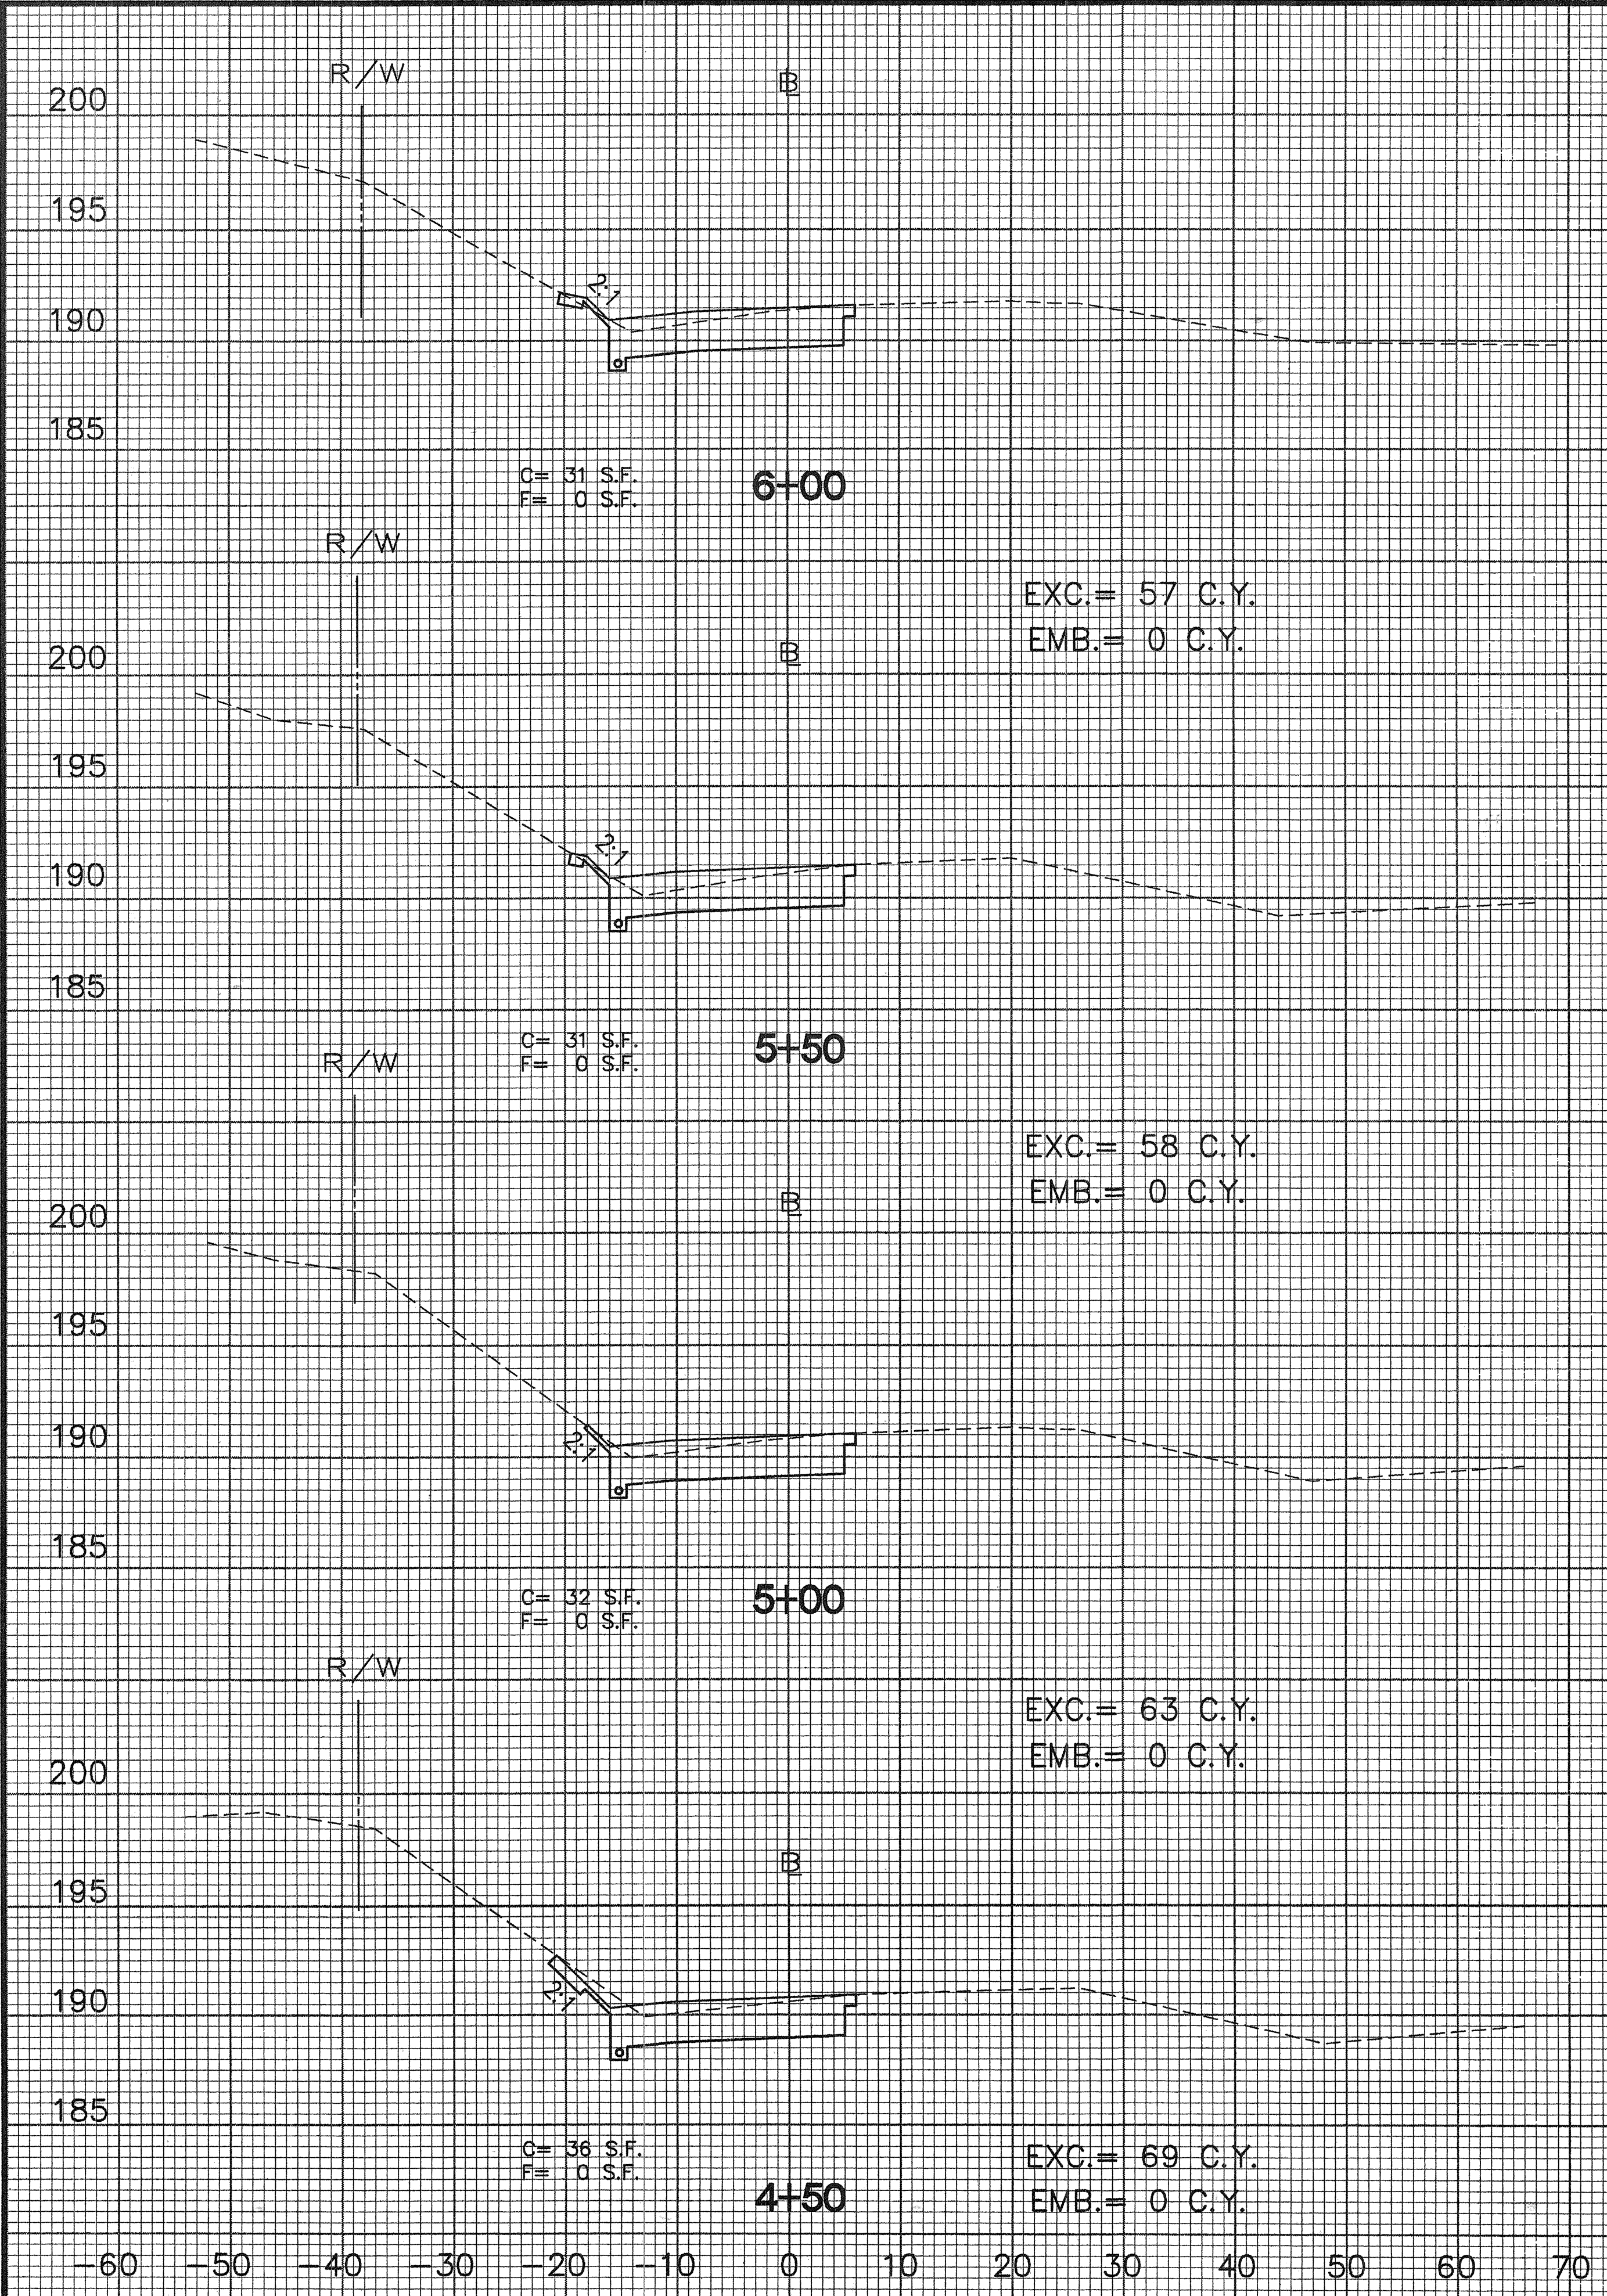


SCALE: HORIZ. 1" = 10'
VERT. 1" = 5'

ORIGINAL PLAN
DESIGNED BY
CHECKED BY

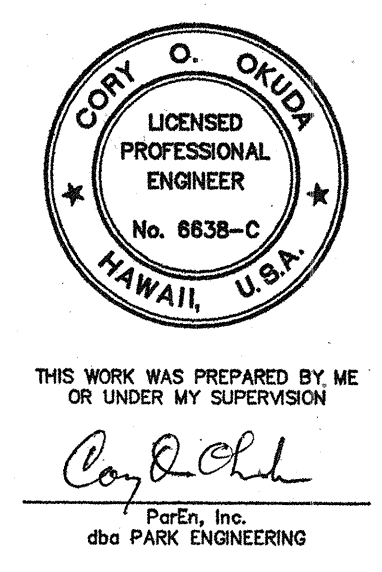


APPROVED: M. 7/2/99 5/17/99
CHIEF, CIVIL ENGINEERING BRANCH, DPP MT

FED. ROAD DIST. NO.	STATE	FED. AID PROJ. NO.	FISCAL YEAR	SHEET NO.	TOTAL SHEETS
HAWAII	HAW.	IM-STP-0750(10)	1999	82	97

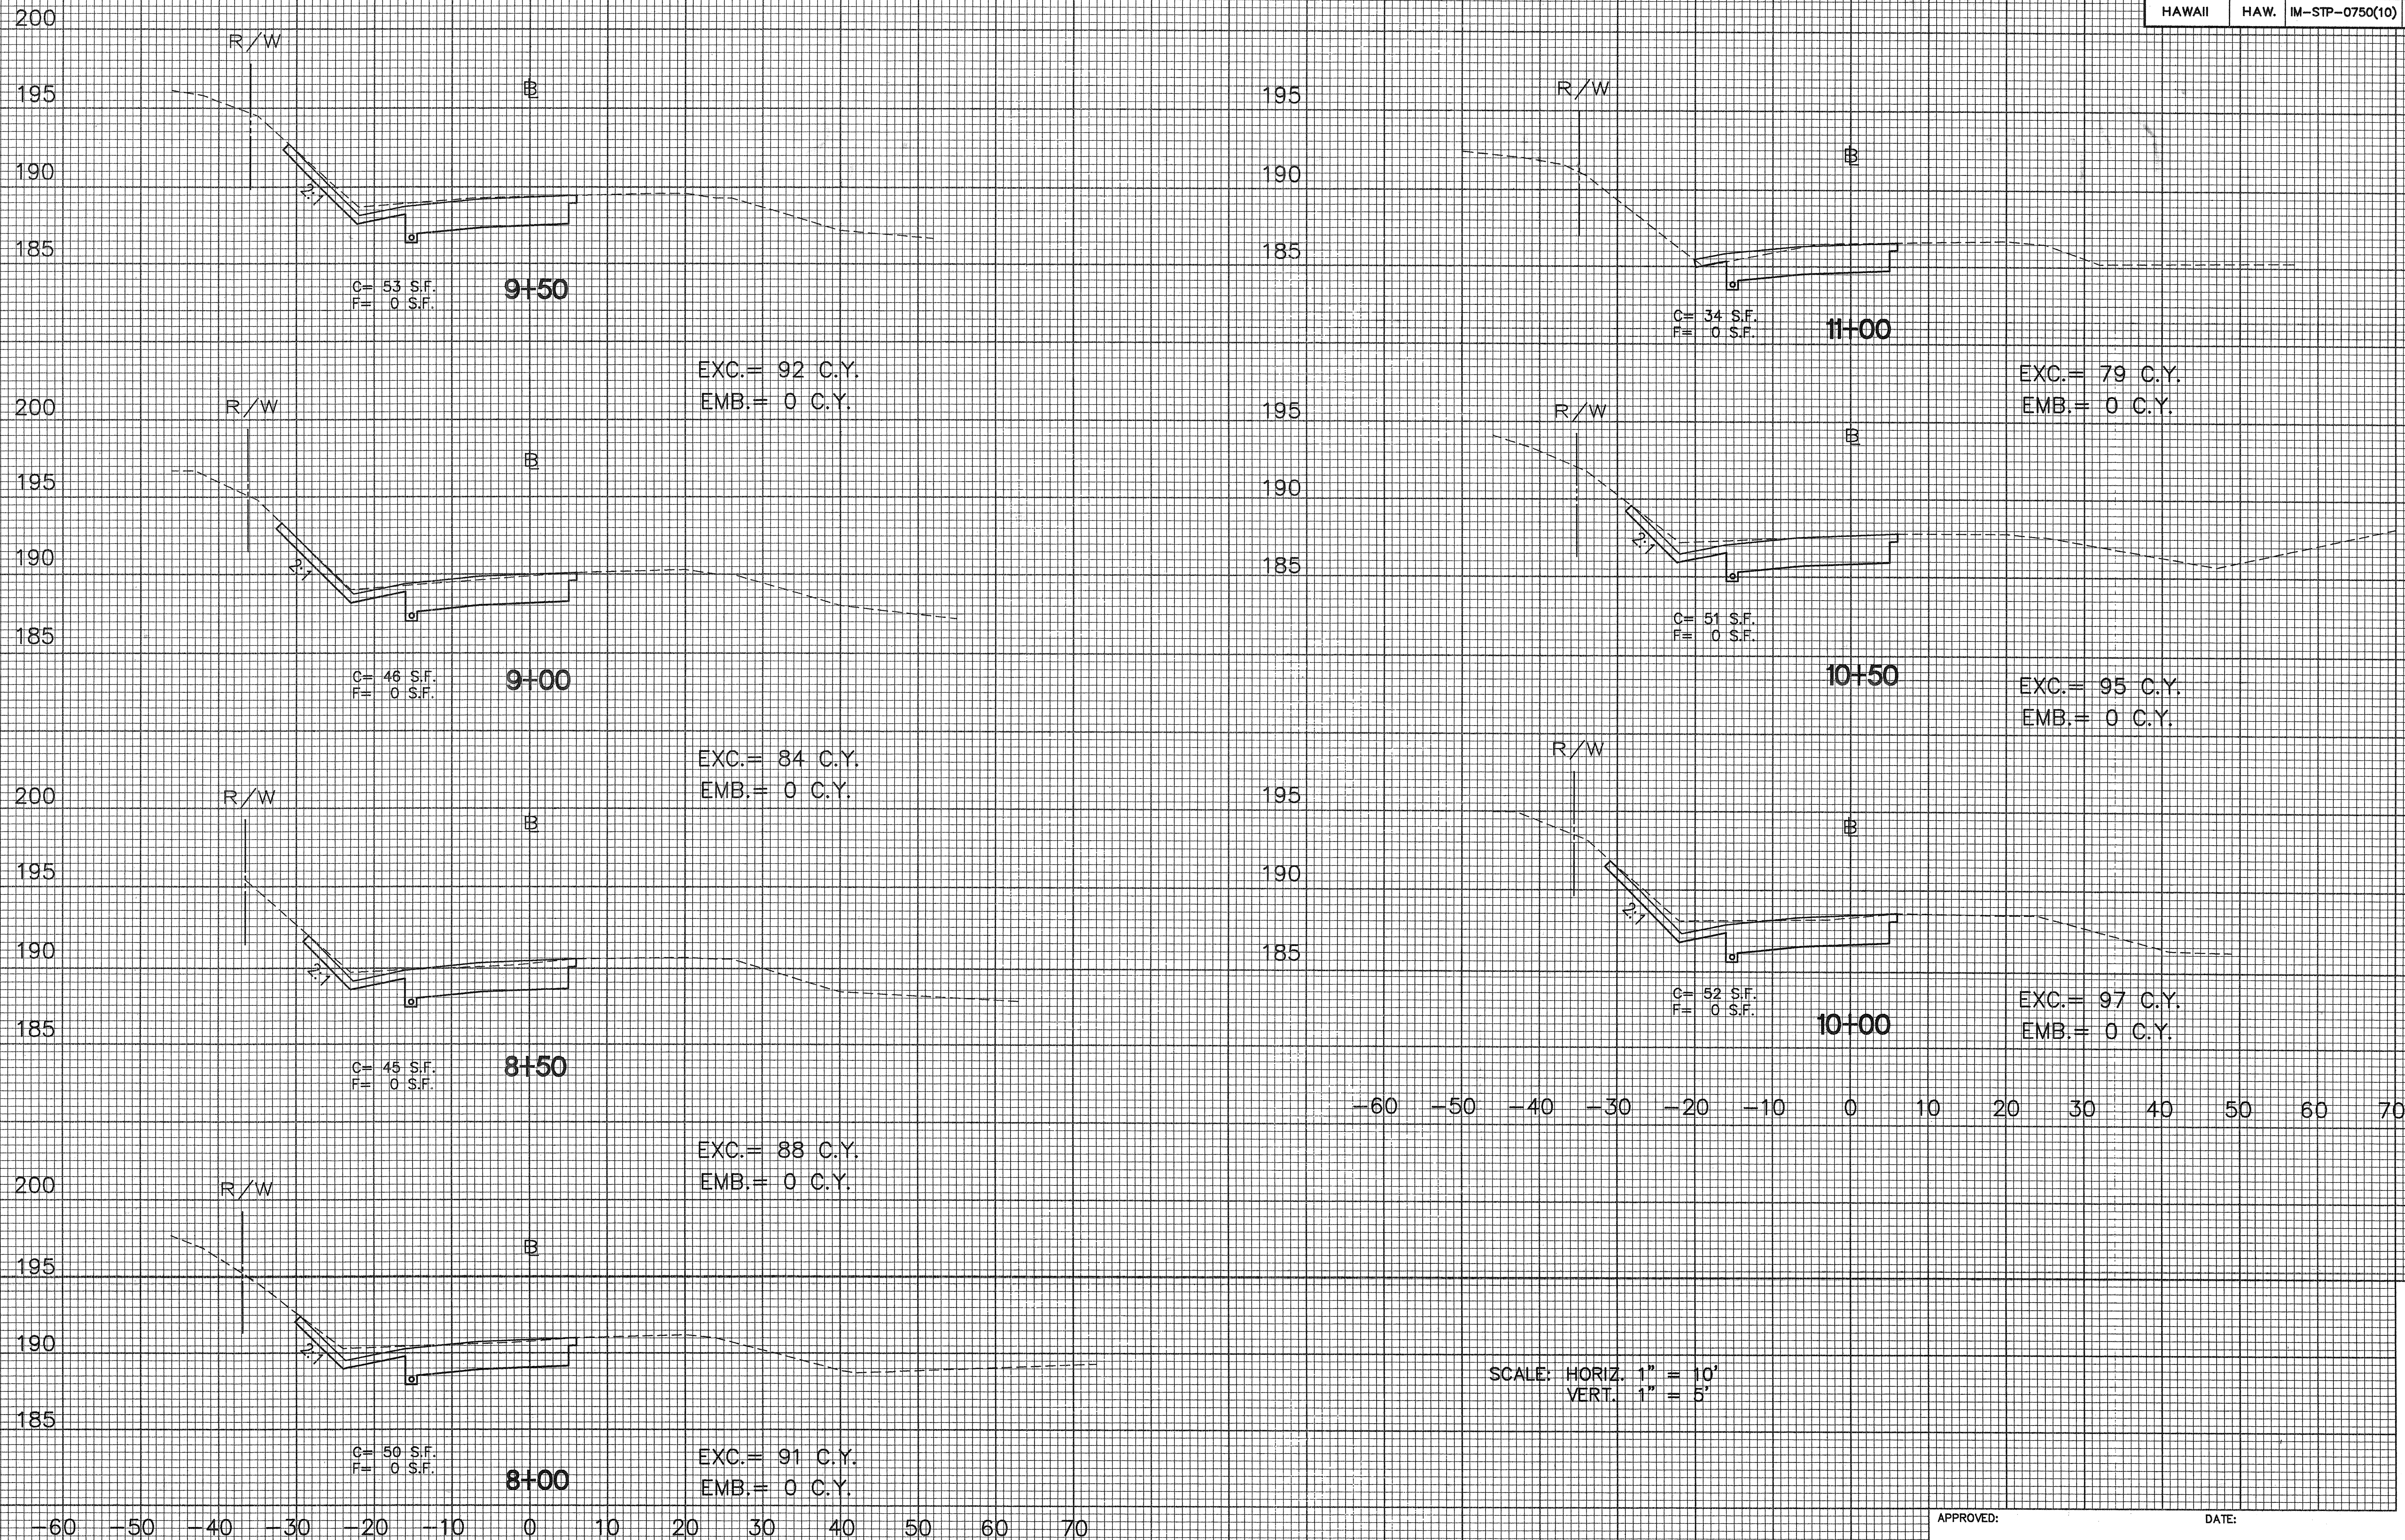

SURVEY PLOTTED BY	DATE
DRAWN BY	
DESIGNED BY	
CHECKED BY	
ORIGINAL PLAN	
NOTES	

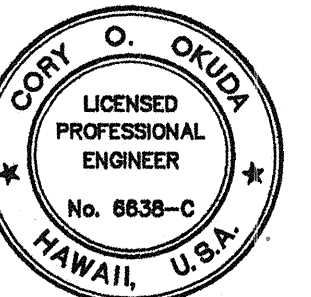


THIS WORK WAS PREPARED BY ME
OR UNDER MY SUPERVISION
Cory O. Okida
Cory O. Okida
dba PARK ENGINEERING

APPROVED: *M. T. Ryan* 5/17/99
CHIEF, CIVIL ENGINEERING BRANCH, DPP


DATE: SHEET 9 OF 11 SHEETS

FED. ROAD DIST. NO.	STATE	FED. AID PROJ. NO.	FISCAL YEAR	SHEET NO.	TOTAL SHEETS
HAWAII	HAW.	IM-STP-0750(10)	1999	83	97

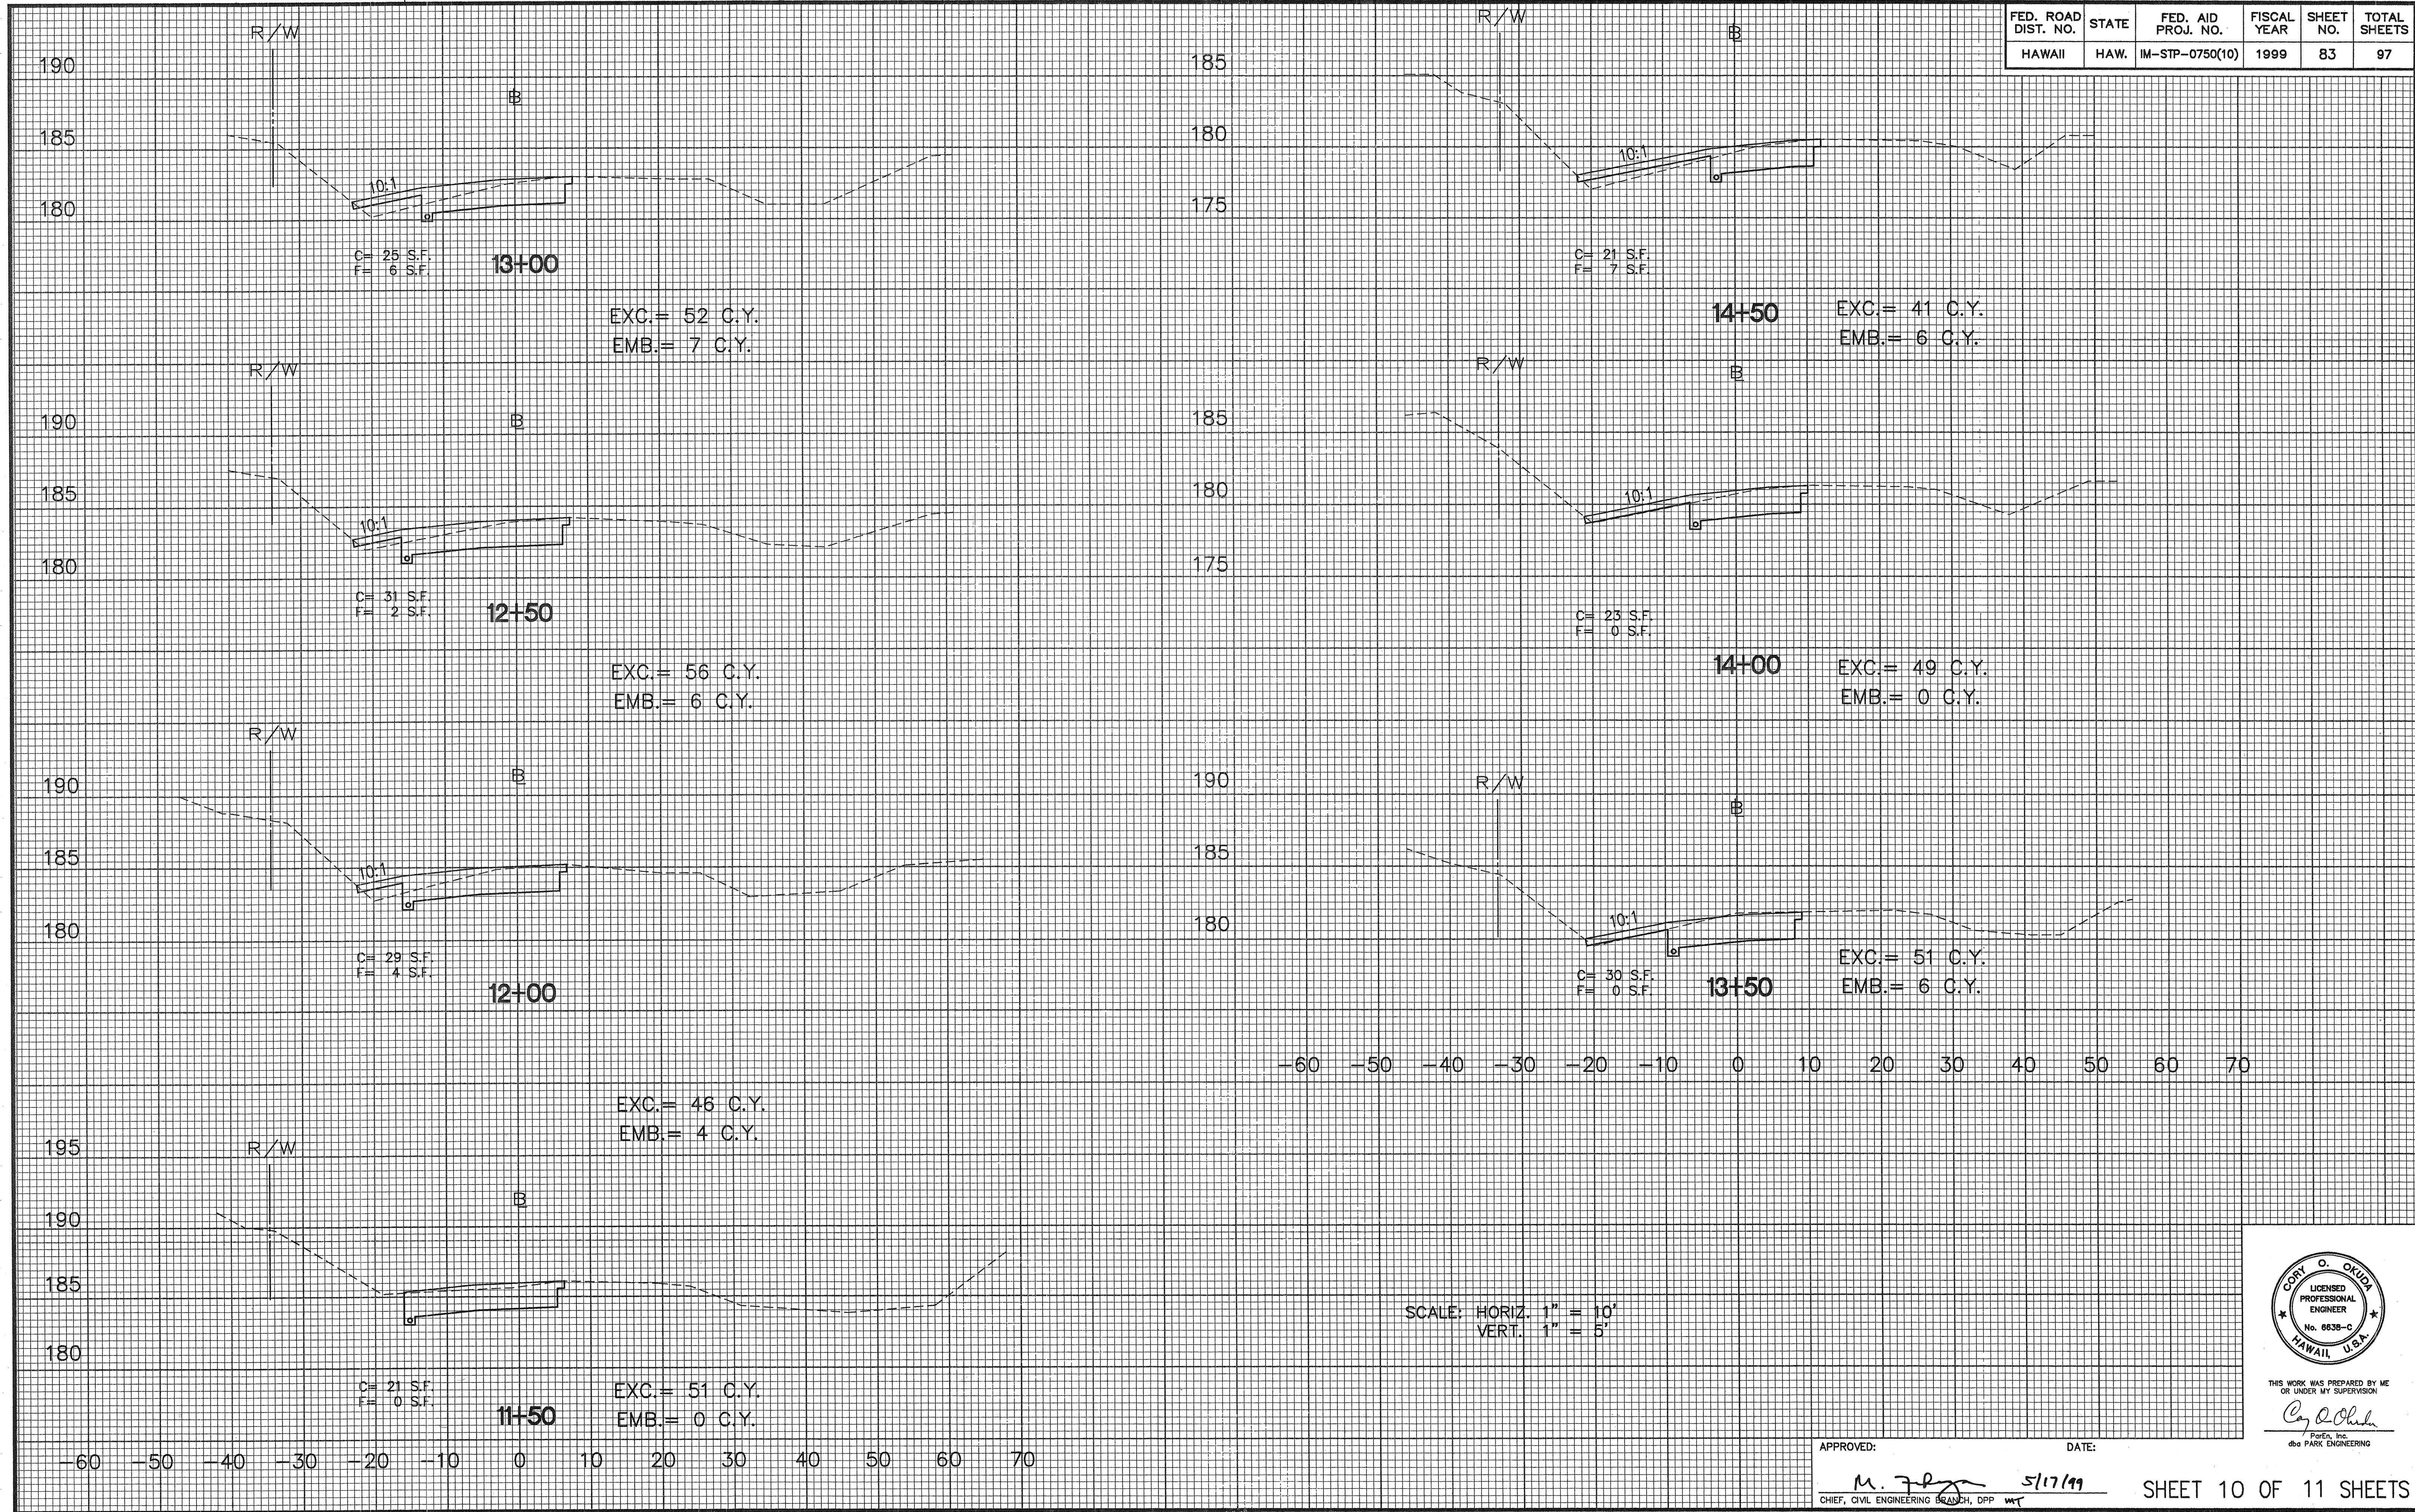

SURVEY PLOTTED BY	DATE
DRAWN BY	
DESIGNED BY	
QUANTITIES BY	
CHECKED BY	


ORIGINAL PLAN	NO.
NOTED	

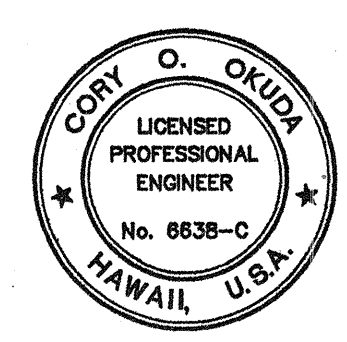

THIS WORK WAS PREPARED BY ME OR UNDER MY SUPERVISION
Cory O. Okuda
P.E., Inc.
dba PARK ENGINEERING

APPROVED: *M. J. [Signature]* 5/17/99
CHIEF, CIVIL ENGINEERING BRANCH, DPP

FED. ROAD DIST. NO.	STATE	FED. AID PROJ. NO.	FISCAL YEAR	SHEET NO.	TOTAL SHEETS
HAWAII	HAW.	IM-STP-0750(10)	1999	84	97

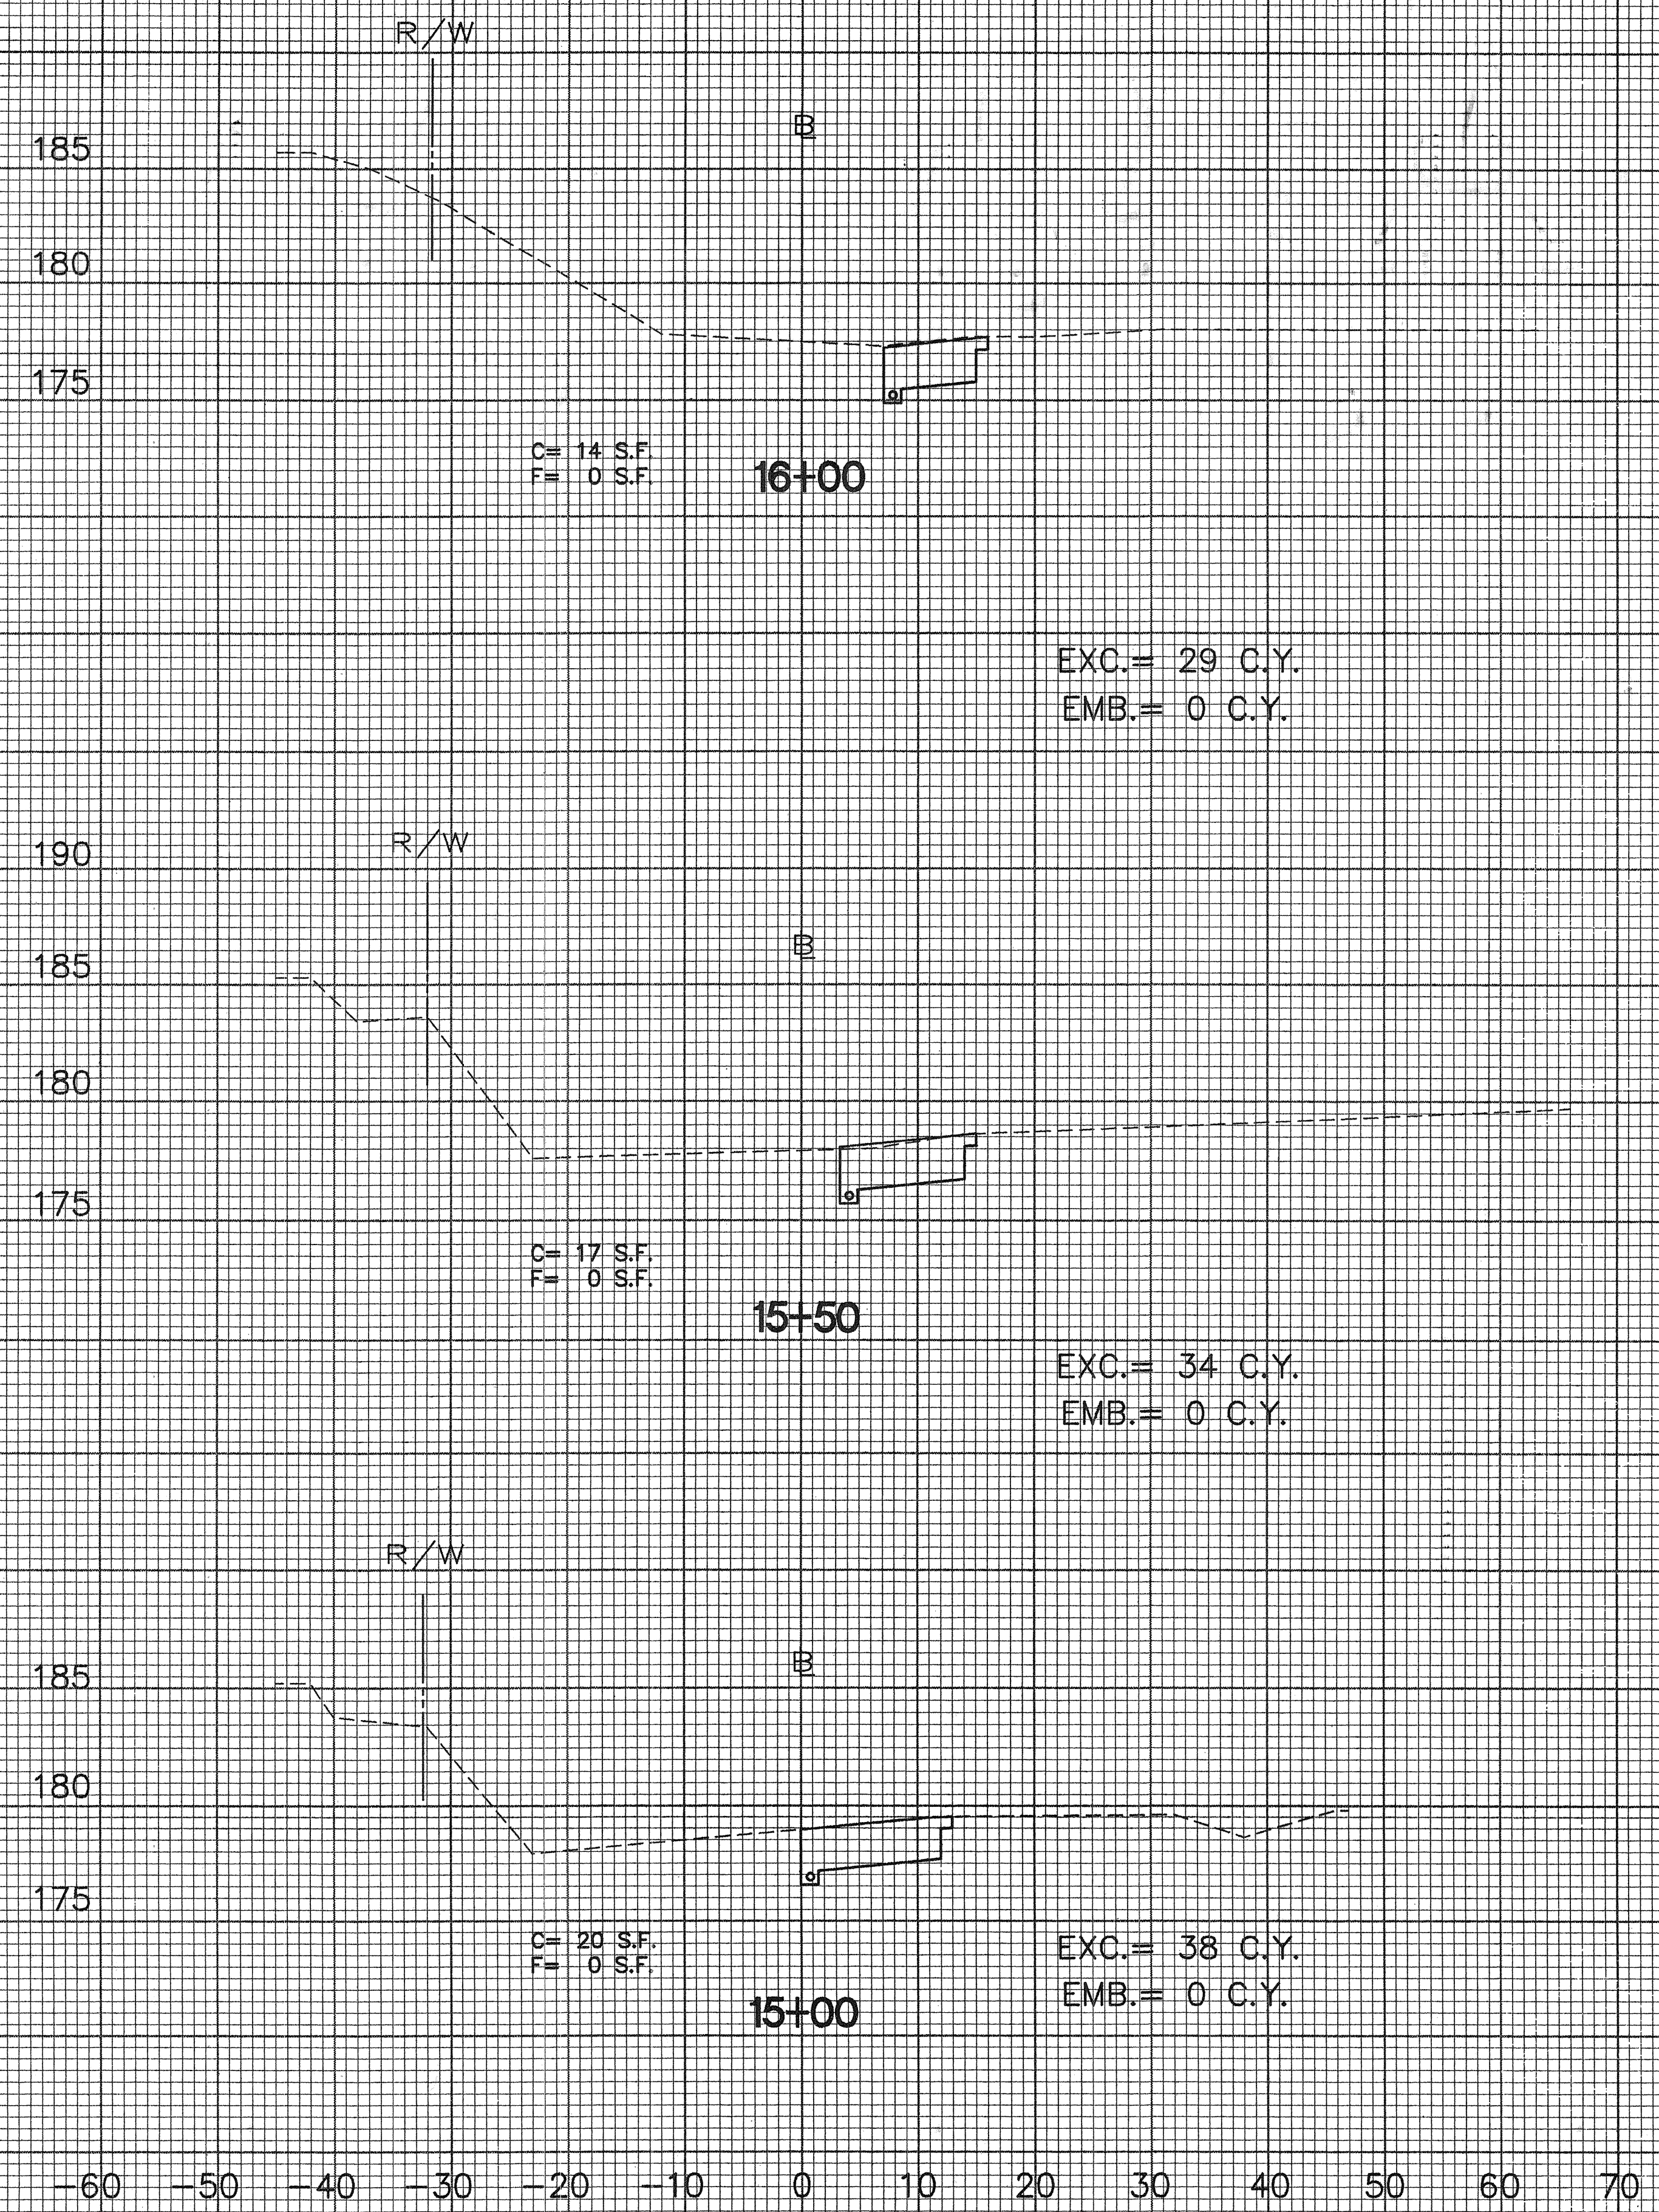

Earthwork Notes


- Quantities shown are for permit purposes only and shall not be used for bidding purposes.
- Contractor shall be responsible to complete the grading work to the grades and dimensions shown on the plans.

Earthwork Summary

(Ramp KO Only)	(Kuniu Road - Sht. 79)
Exc. = 2,300 C.Y.	Exc. = 14,000 C.Y.
Emb. = 30 C.Y.	Emb. = 300 C.Y.
Area = 1.0 Ac.	Area = 3.4 Ac.

(Earthwork Totals)

Exc. = 16,300 C.Y.
Emb. = 330 C.Y.
Area = 4.4 Ac.

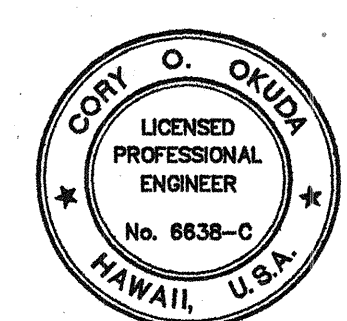

THIS WORK WAS PREPARED BY ME OR UNDER MY SUPERVISION
dba PARK ENGINEERING

APPROVED: *M. J. [Signature]* 5/17/99
CHIEF, CIVIL ENGINEERING BRANCH, DPP