FED. ROAD DIST. No.	STATE	FED. AID PROJ. No.	FISCAL YEAR	SHEET No.	TOTAL SHEETS
HAWAII	HAW	D-AD-1(2)	1958	11	29

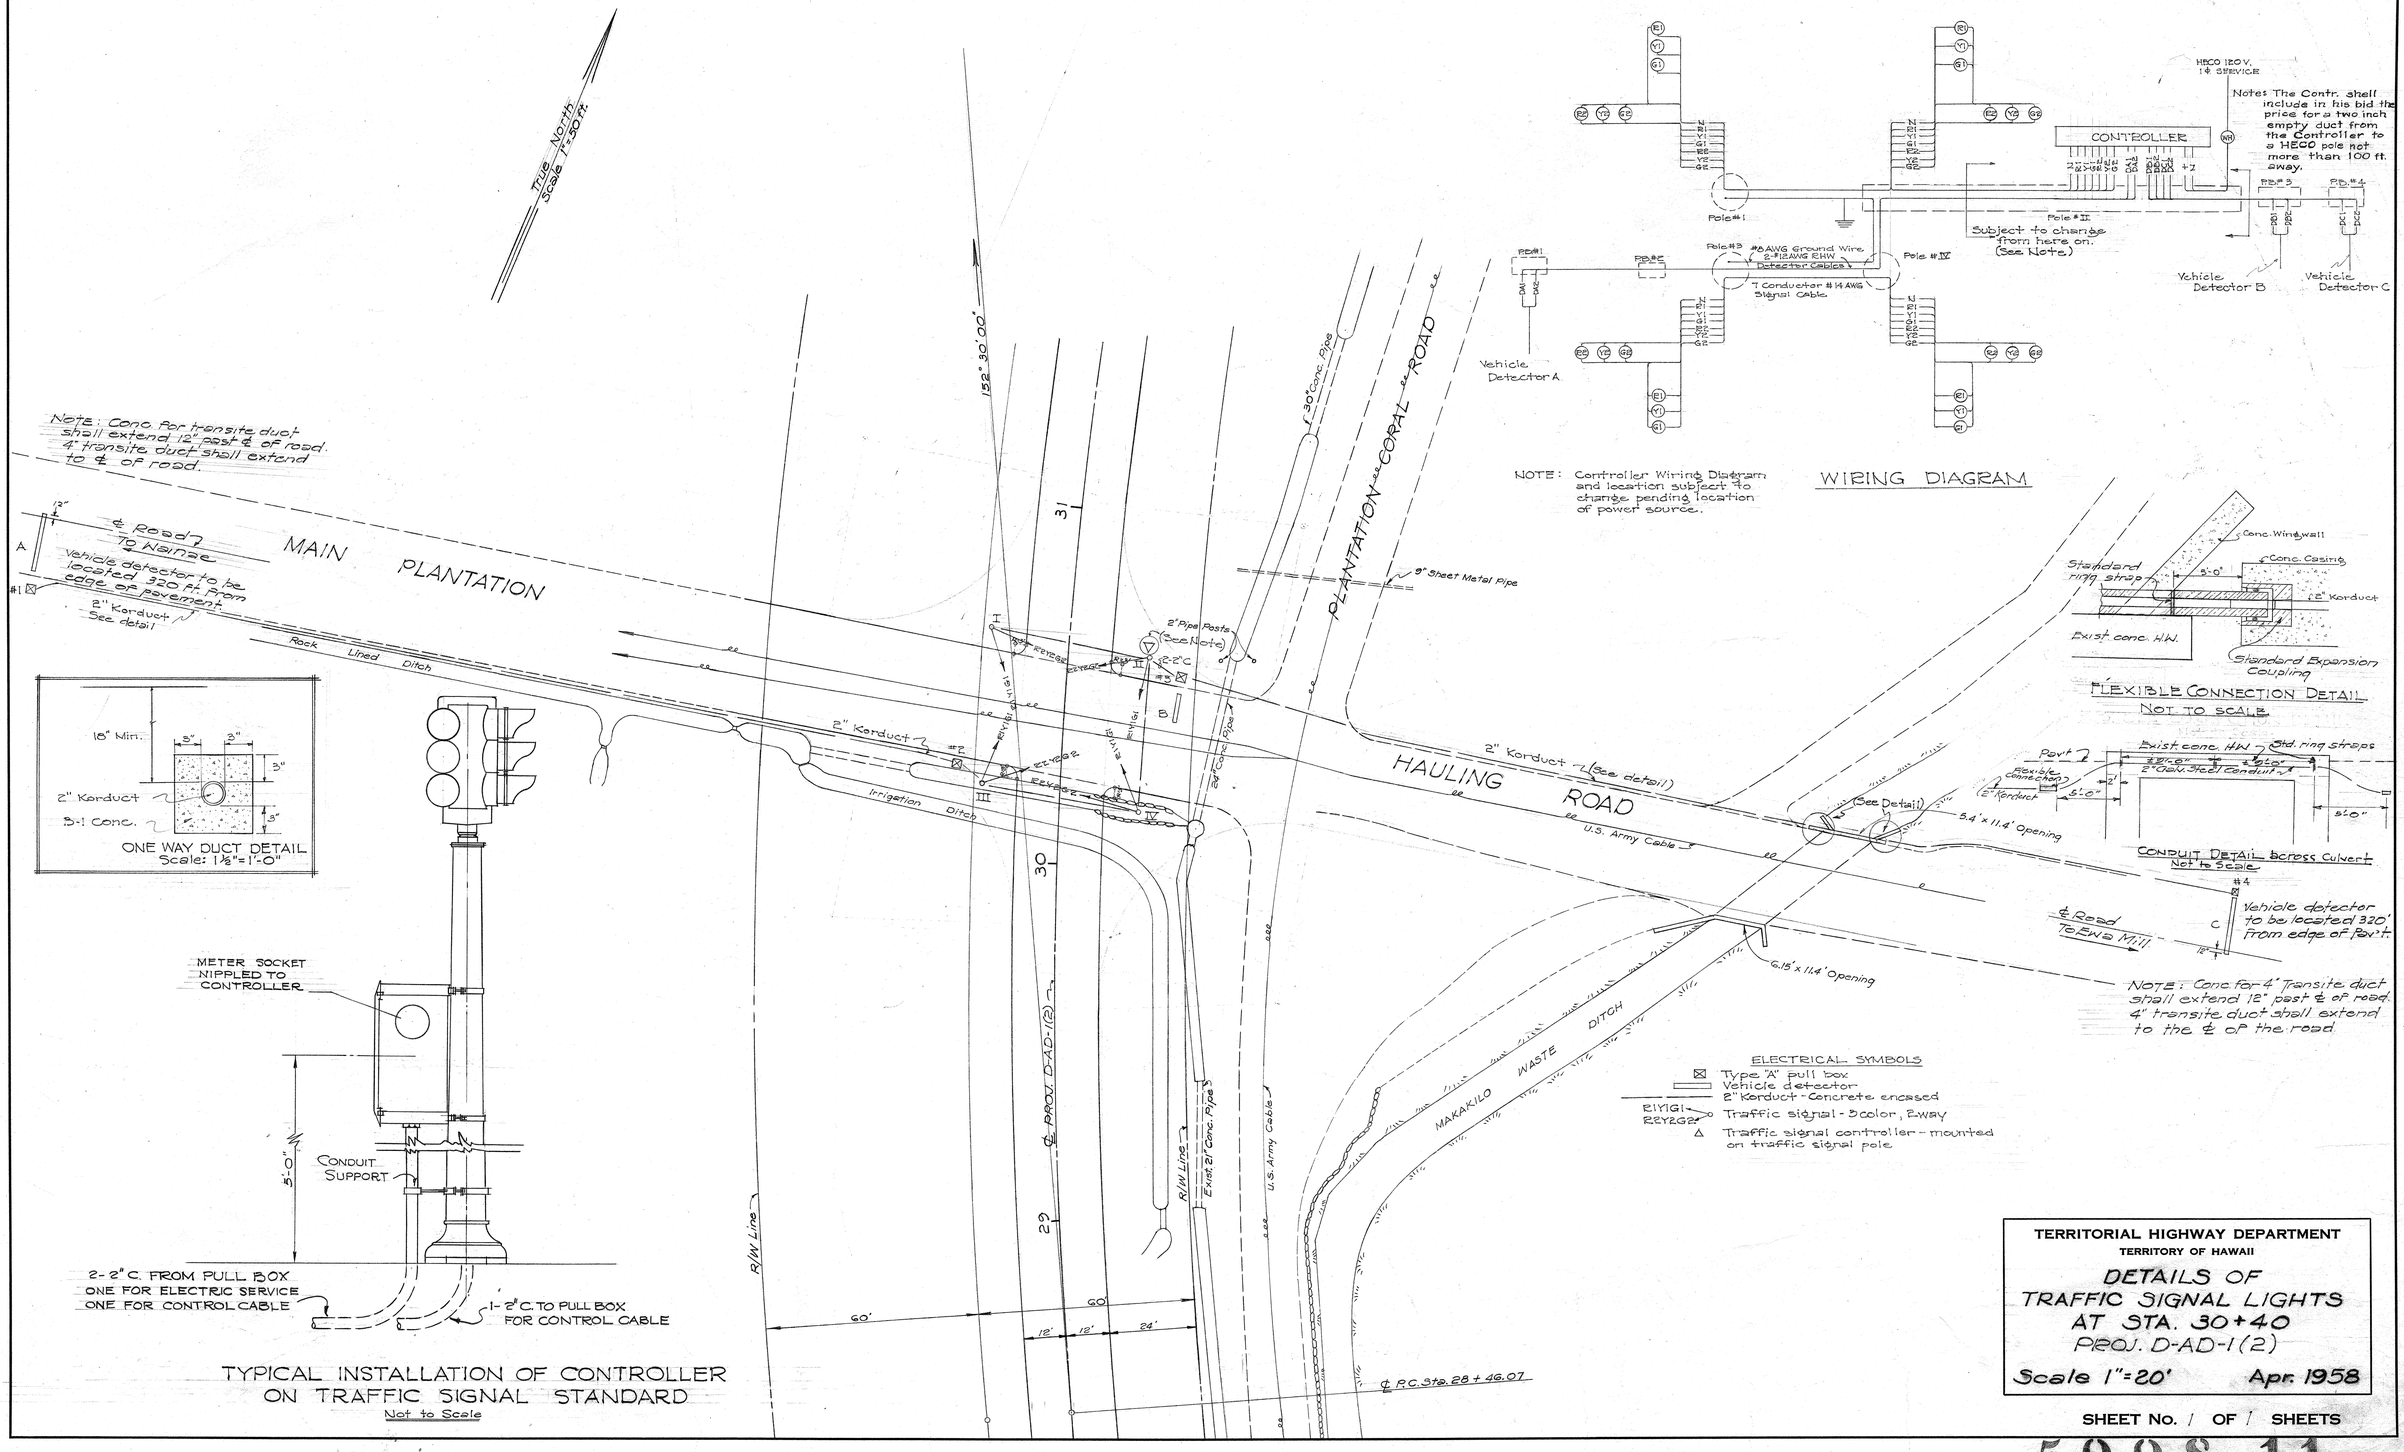

ORIGINAL PLAN		DATE
	SURVEY PLOTTED BY	
	TRACED BY	
	DESIGN BY	
	DRAWN BY	
	QUANTITIES BY	
	QUANTITIES CHECKED BY	
NOTE BOOK No.	CHECKED BY	

TERRITORIAL HIGHWAY DEPARTMENT
TERRITORY OF HAWAII

DETAILS OF TRAFFIC SIGNAL LIGHTS AT STA. 30+40

PROJ. D-AD-1(2)

Scale 1"=20' Apr. 1958

SHEET No. 1 OF 1 SHEETS

5998.11

PRINTED ON DIEPO 1000H CLEARPRINT