FED. ROAD DIST. NO.	STATE	FED. AID PROJ. NO.	FISCAL YEAR	SHEET NO.	TOTAL SHEETS
HAWAII	HAW.	STP-0901(3)	1993	1	30

INDEX TO DRAWINGS

SHEET NO.	DESCRIPTION
1	TITLE SHEET
2	STANDARD PLANS SUMMARY
3	GENERAL NOTES & LEGEND
4 – 10	TYPICAL SECTIONS & PAVING DETAILS
11 – 15	ROADWAY PLAN
16 – 30	TRAFFIC LEGEND, NOTES, DETAILS, MARKING, SIGINING, LOOP DETECTORS, & SUMMARY

STATE OF HAWAII

DEPARTMENT OF TRANSPORTATION

HIGHWAYS DIVISION

HONOLULU, HAWAII

"AS-BUILT"

PLANS FOR

BARBERS POINT ACCESS ROAD RESURFACING

NAVY GATE TO H-1 MAKAKILO OVERPASS

FEDERAL AID PROJECT NO. STP-0901(3)

DISTRICT OF EWA

ISLAND OF OAHU

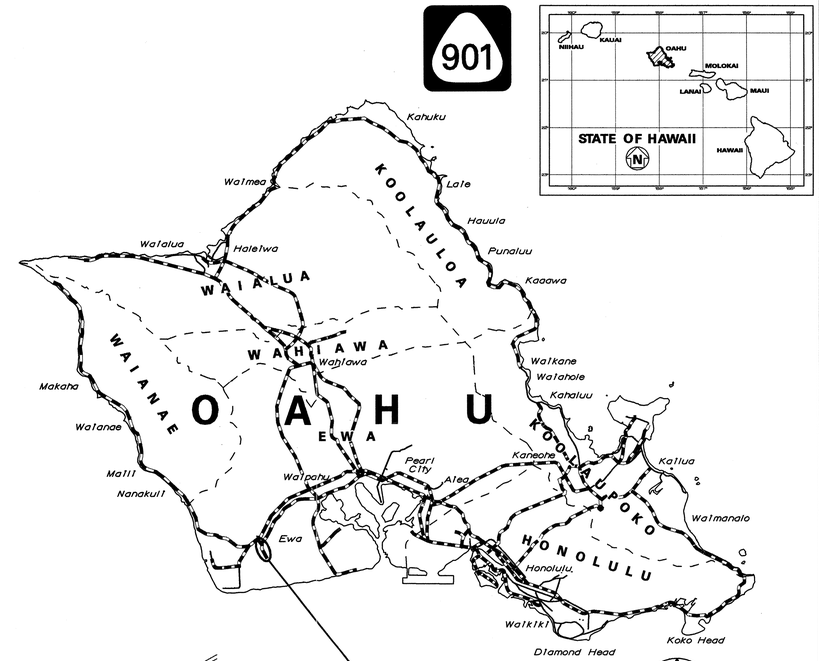

FEDERAL AID PROJECT NO. STP-0901(3)

Length of Project: 1.49 mi.

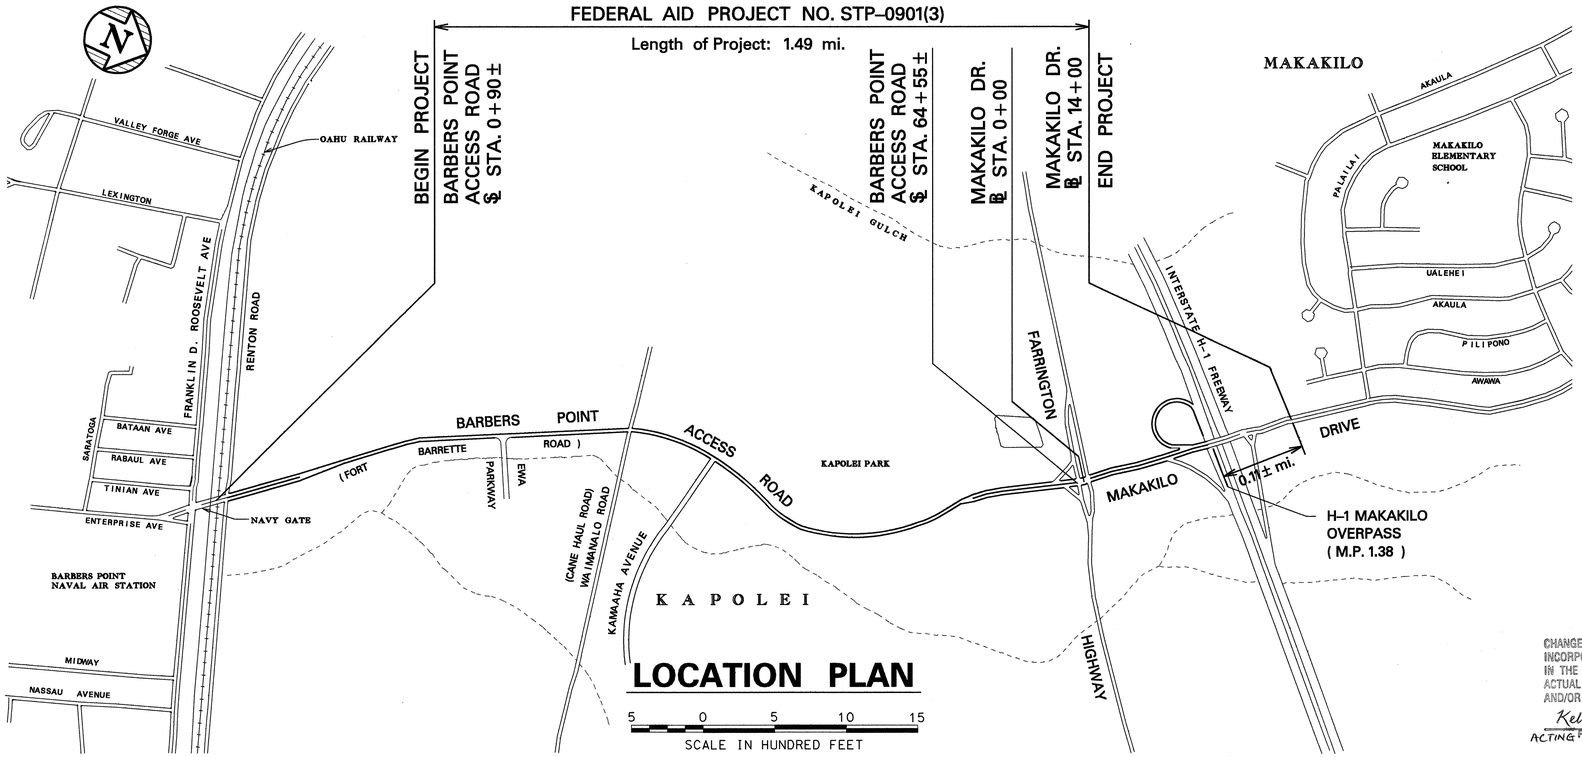

LOCATION PLAN

5 0 5 10 15

SCALE IN HUNDRED FEET

FEDERAL AID PROJECT NO. STP-0901(3)

MILE POST 0.00 TO MILE POST 1.38

DESIGN DESIGNATION

	Navy Gate to Farrington Hwy.	Farrington Hwy. to Makakilo Overpass
CURRENT ADT(1992)	10,990	14,390
DESIGN ADT(2002)	13,650	17,780
DHV	1,570	1,570
D	85/15	80/20
T_{24}	13.5	13.5

CHANGES MADE DURING CONSTRUCTION HAVE BEEN INCORPORATED ON THESE PLANS EXCEPT CHANGES IN THE ORIGINAL THEORETICAL QUANTITIES. FOR ACTUAL QUANTITIES, REFER TO PROJECT LEDGER AND/OR COMPUTATION BOOK.

Kelvin Akagawa 8-10-99

ACTING RESIDENT ENGINEER DATE

DEPARTMENT OF TRANSPORTATION
STATE OF HAWAII

APPROVED:

A. Harada 3/19/93

FOR DIR. OF TRANSPORTATION DATE

UNIT "C" | DESIGNED BY J. KASAMOTO P. S. & E. BY | PHONE 587-2250 | DATE AUG., 1992

1bprdtsht.dgn/george 2/10/93