

PROJECT NO.	STATE	FED. AID DIST. NO.	FISCAL YEAR	SHEET NO.	TOTAL SHEETS
HAWAII	HAW.	2-C-01	1939	3	9


LIST OF COMMON ABBREVIATIONS

- H.L.R.R. Hand laid riprap
- M.H.W. Masonry headwall
- Cir.Conc.Culv. Circular concrete culvert which is either
 - a) cast in place circular concrete culvert or
 - b) concrete pipe culvert
- C.D.I. Concrete drop intake
- C.H.W. Concrete headwall
- o T.P. Telephone pole
- o E.P. Wood electric pole
- Large tree

Datum Elevations U.S.C. & G.S.
Azimuths referred to Puu Iki Δ

Curve Data
Δ = 58° 50' 30"
D = 3' 26' 42"
R = 1663.13
T = 937.92
L = 1708.00
SE = 0.05

NOTE: See Sheet No. 4498.4 for Adjusted, Relocated & Industrial track for this Project.

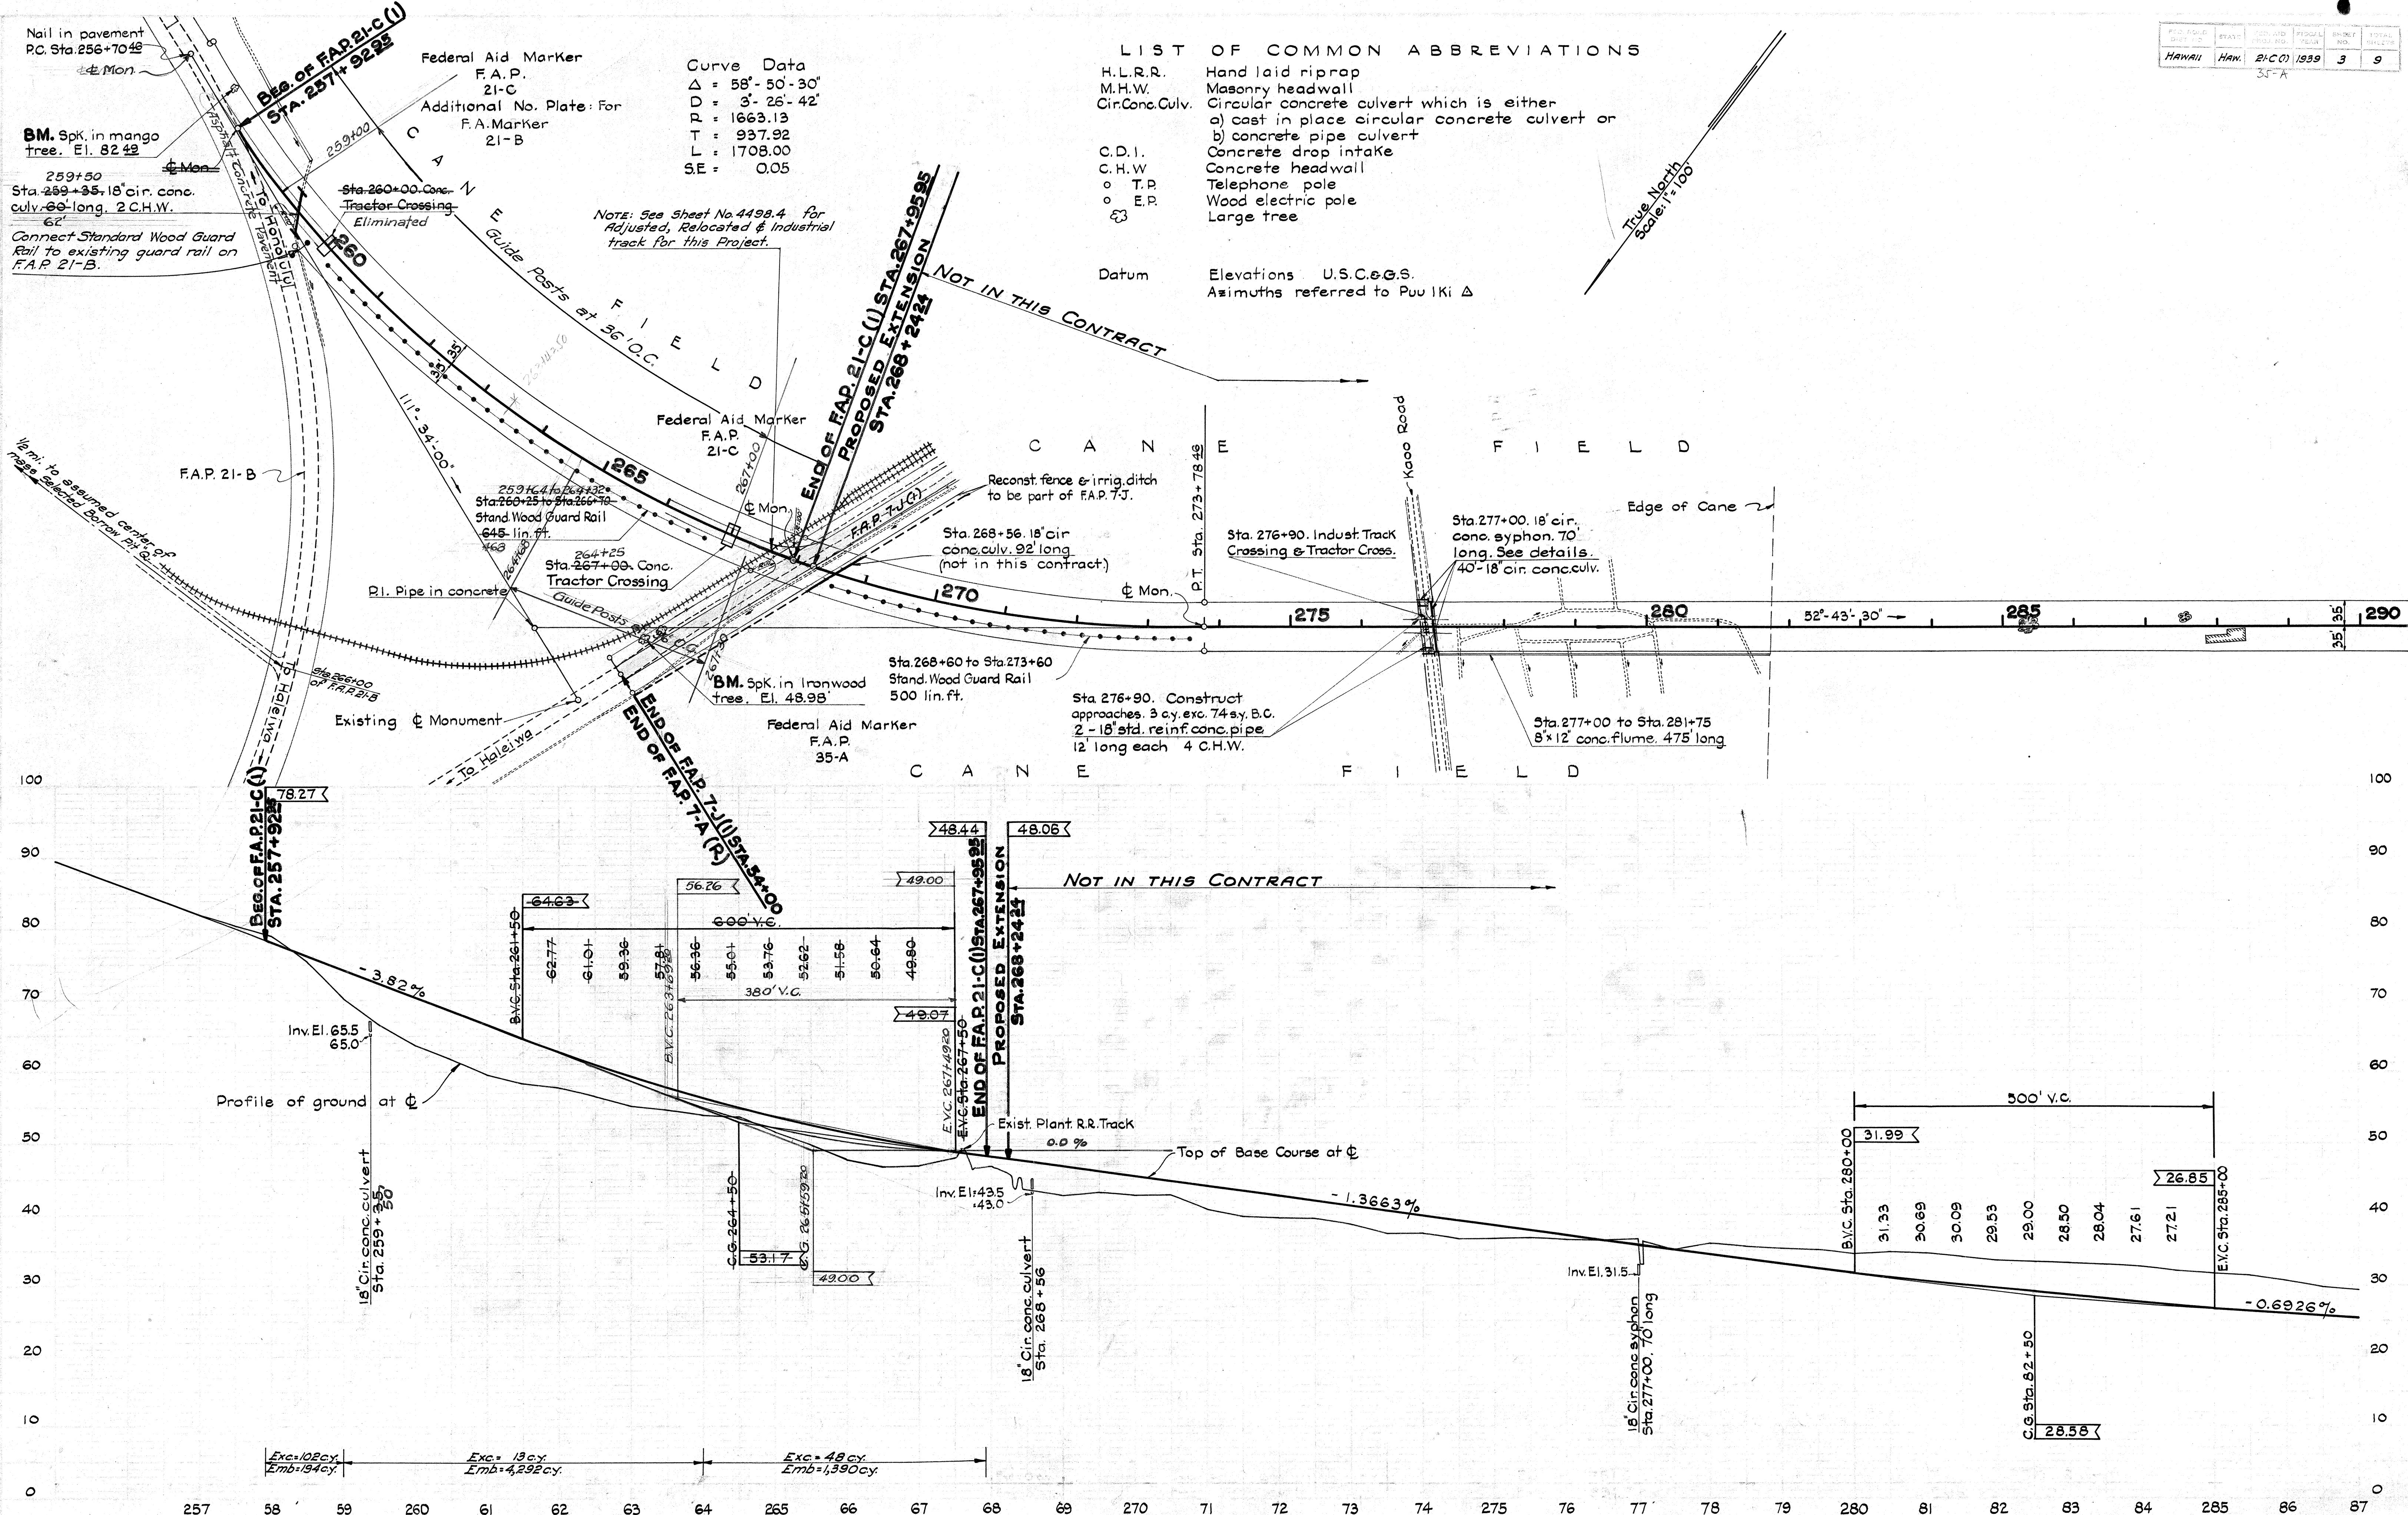

12.2638
12.4339
H.H. Chung
H.H. Chung

DATE
BY
CHECKED
NO.
NO.
NO.

DATE
BY
CHECKED
NO.
NO.
NO.

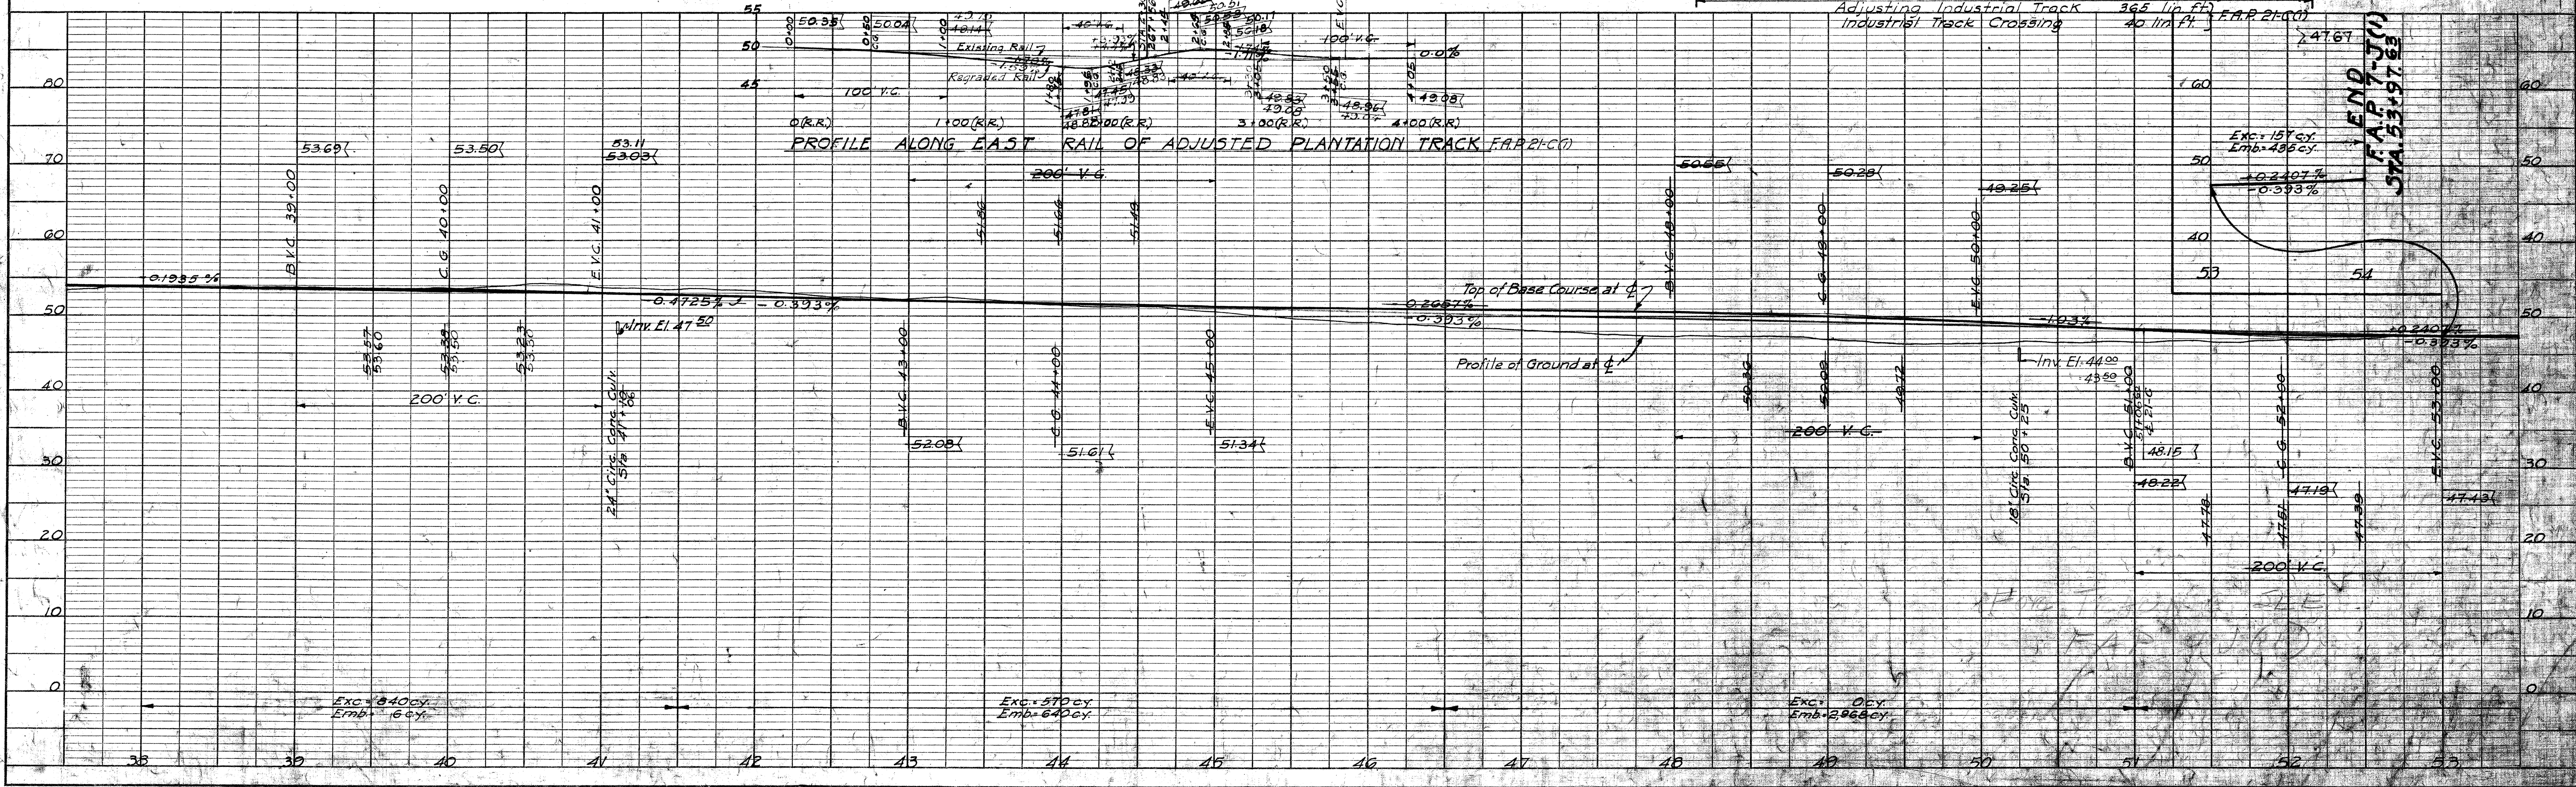
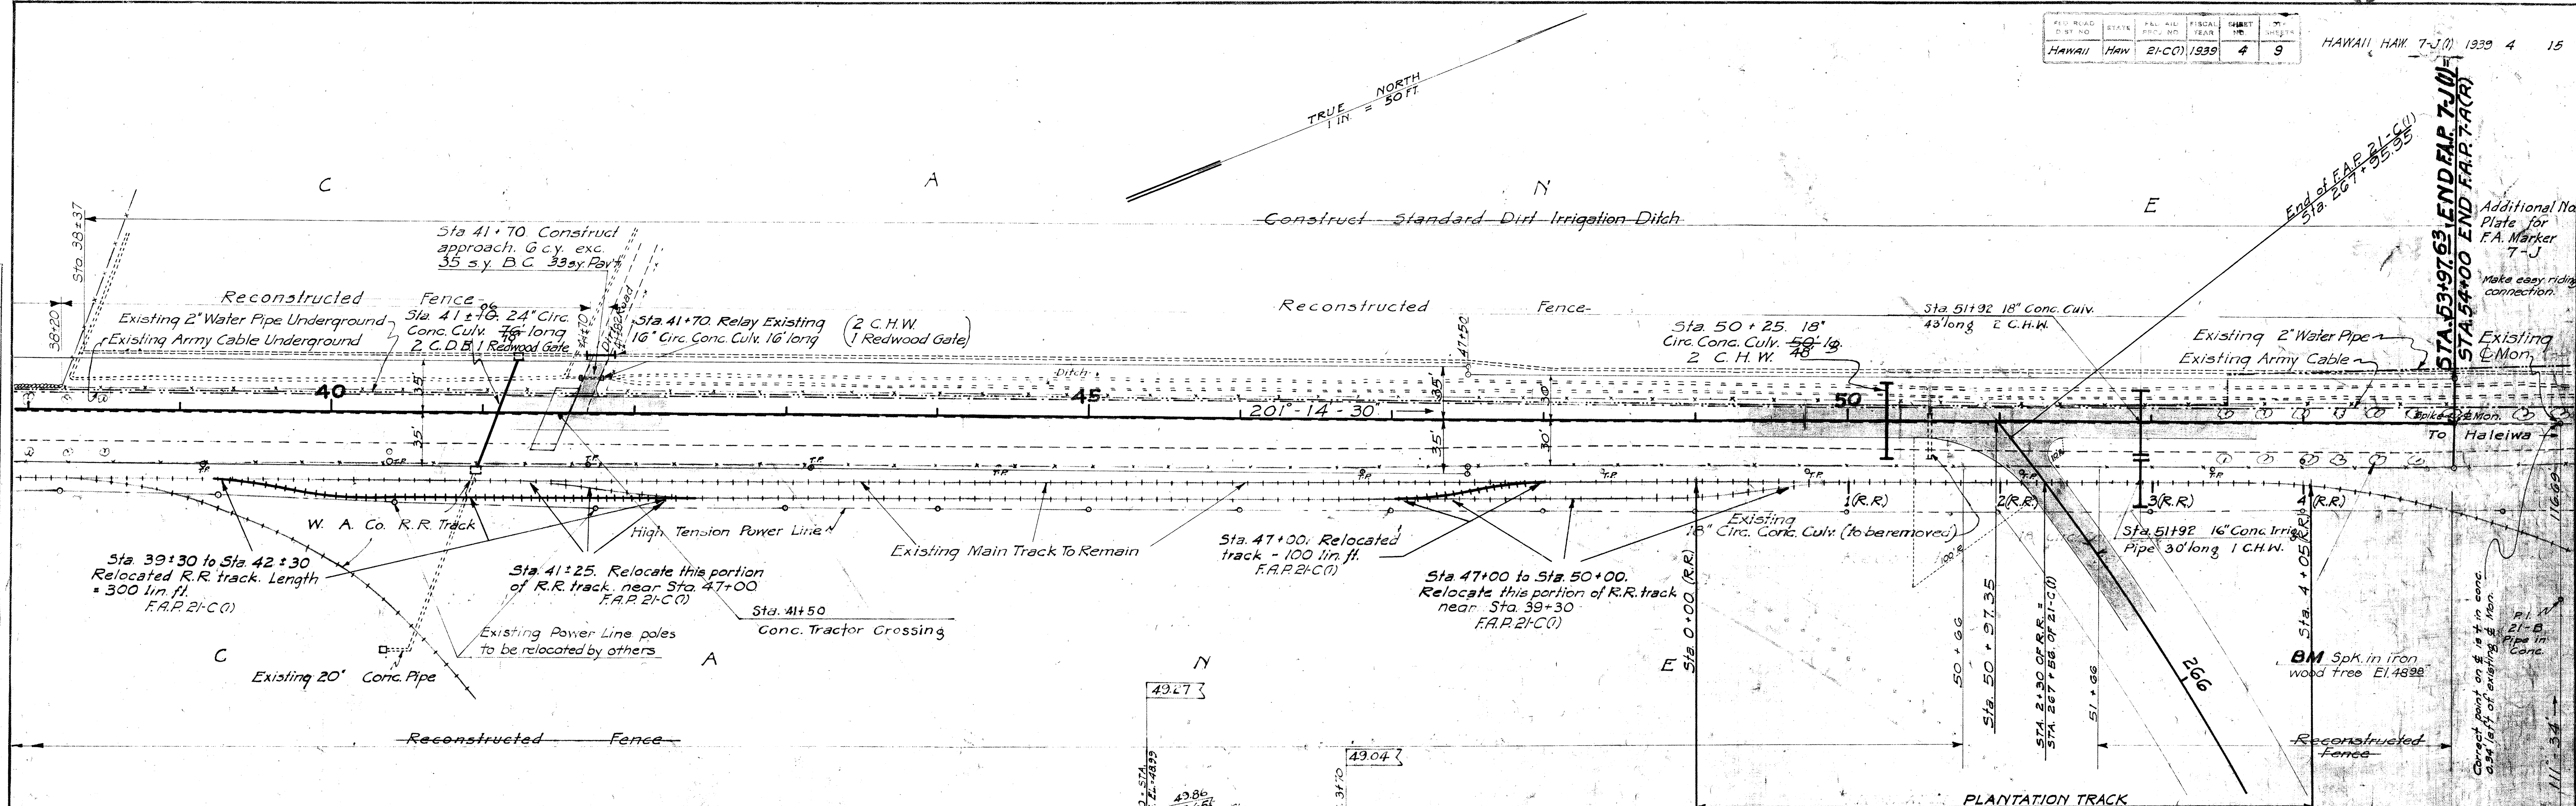


PLATE 1-PLAN-PROFILE O.P.R. & P.E. STANDARD
KUEPPEL & MOSER CO., NEW YORK

4498.4 4499.4