

FED. ROAD DIST. NO.	STATE	FED. AID PROJ. NO.	FISCAL YEAR	SHEET NO.	TOTAL SHEETS
HAWAII	HAW.	35A(1)	1939	10	33

STEEL SCHEDULE

NK NO.	SIZE	DESCRIPTION	LGTH	TOT. L.	TOT. WT.
600	15	$\frac{3}{4}"$ sp. 12' o.c. MK 500	22'-4"	330	435
601	15	$\frac{3}{4}"$ sp. 12' o.c. MK 501	37'-1"	556	834
602	15	$\frac{3}{4}"$ sp. 12' o.c. MK 502	34'-7"	519	779
400	10	$\frac{1}{2}"$ sp. 12' o.c. MK 400	13'-8"	138	93
401	10	$\frac{1}{2}"$ sp. 12' o.c. MK 401	11'-9"	118	79
501	8	$\frac{3}{8}"$ sp. 12' o.c. MK 501	13'-3"	106	110
403	2	$\frac{1}{2}"$ sp. 12' o.c. MK 403	13'-6"	39	26
404	6	$\frac{1}{2}"$ sp. 12' o.c. MK 404	11'-7"	70	47
405	4	$\frac{1}{2}"$ sp. 12' o.c. MK 405	10'-0"	40	27
406	4	$\frac{1}{2}"$ sp. 12' o.c. MK 406	5'-0"	20	13
407	4	$\frac{1}{2}"$ sp. 12' o.c. MK 407	4'-0"	30	20
408	28	$\frac{1}{2}"$ sp. 12' o.c. MK 408	4'-0"	112	75
500	12	$\frac{5}{8}"$ sp. 12' o.c. MK 500	11'-7"	139	145

QUANTITIES

Concrete	18 cu. yds.
Reinf. Steel	2743 lbs.
Excavation	20 cu. yds.


TERRITORIAL HIGHWAY DEPARTMENT
TERRITORY OF HAWAII

STA. 264+40
12'x8' Box Culvert
Extension
WAIALUA-KAENA ROAD
F.A.P. 35A(1)

SHEET No. 10 OF 33 SHEETS

5003.10

5003.10

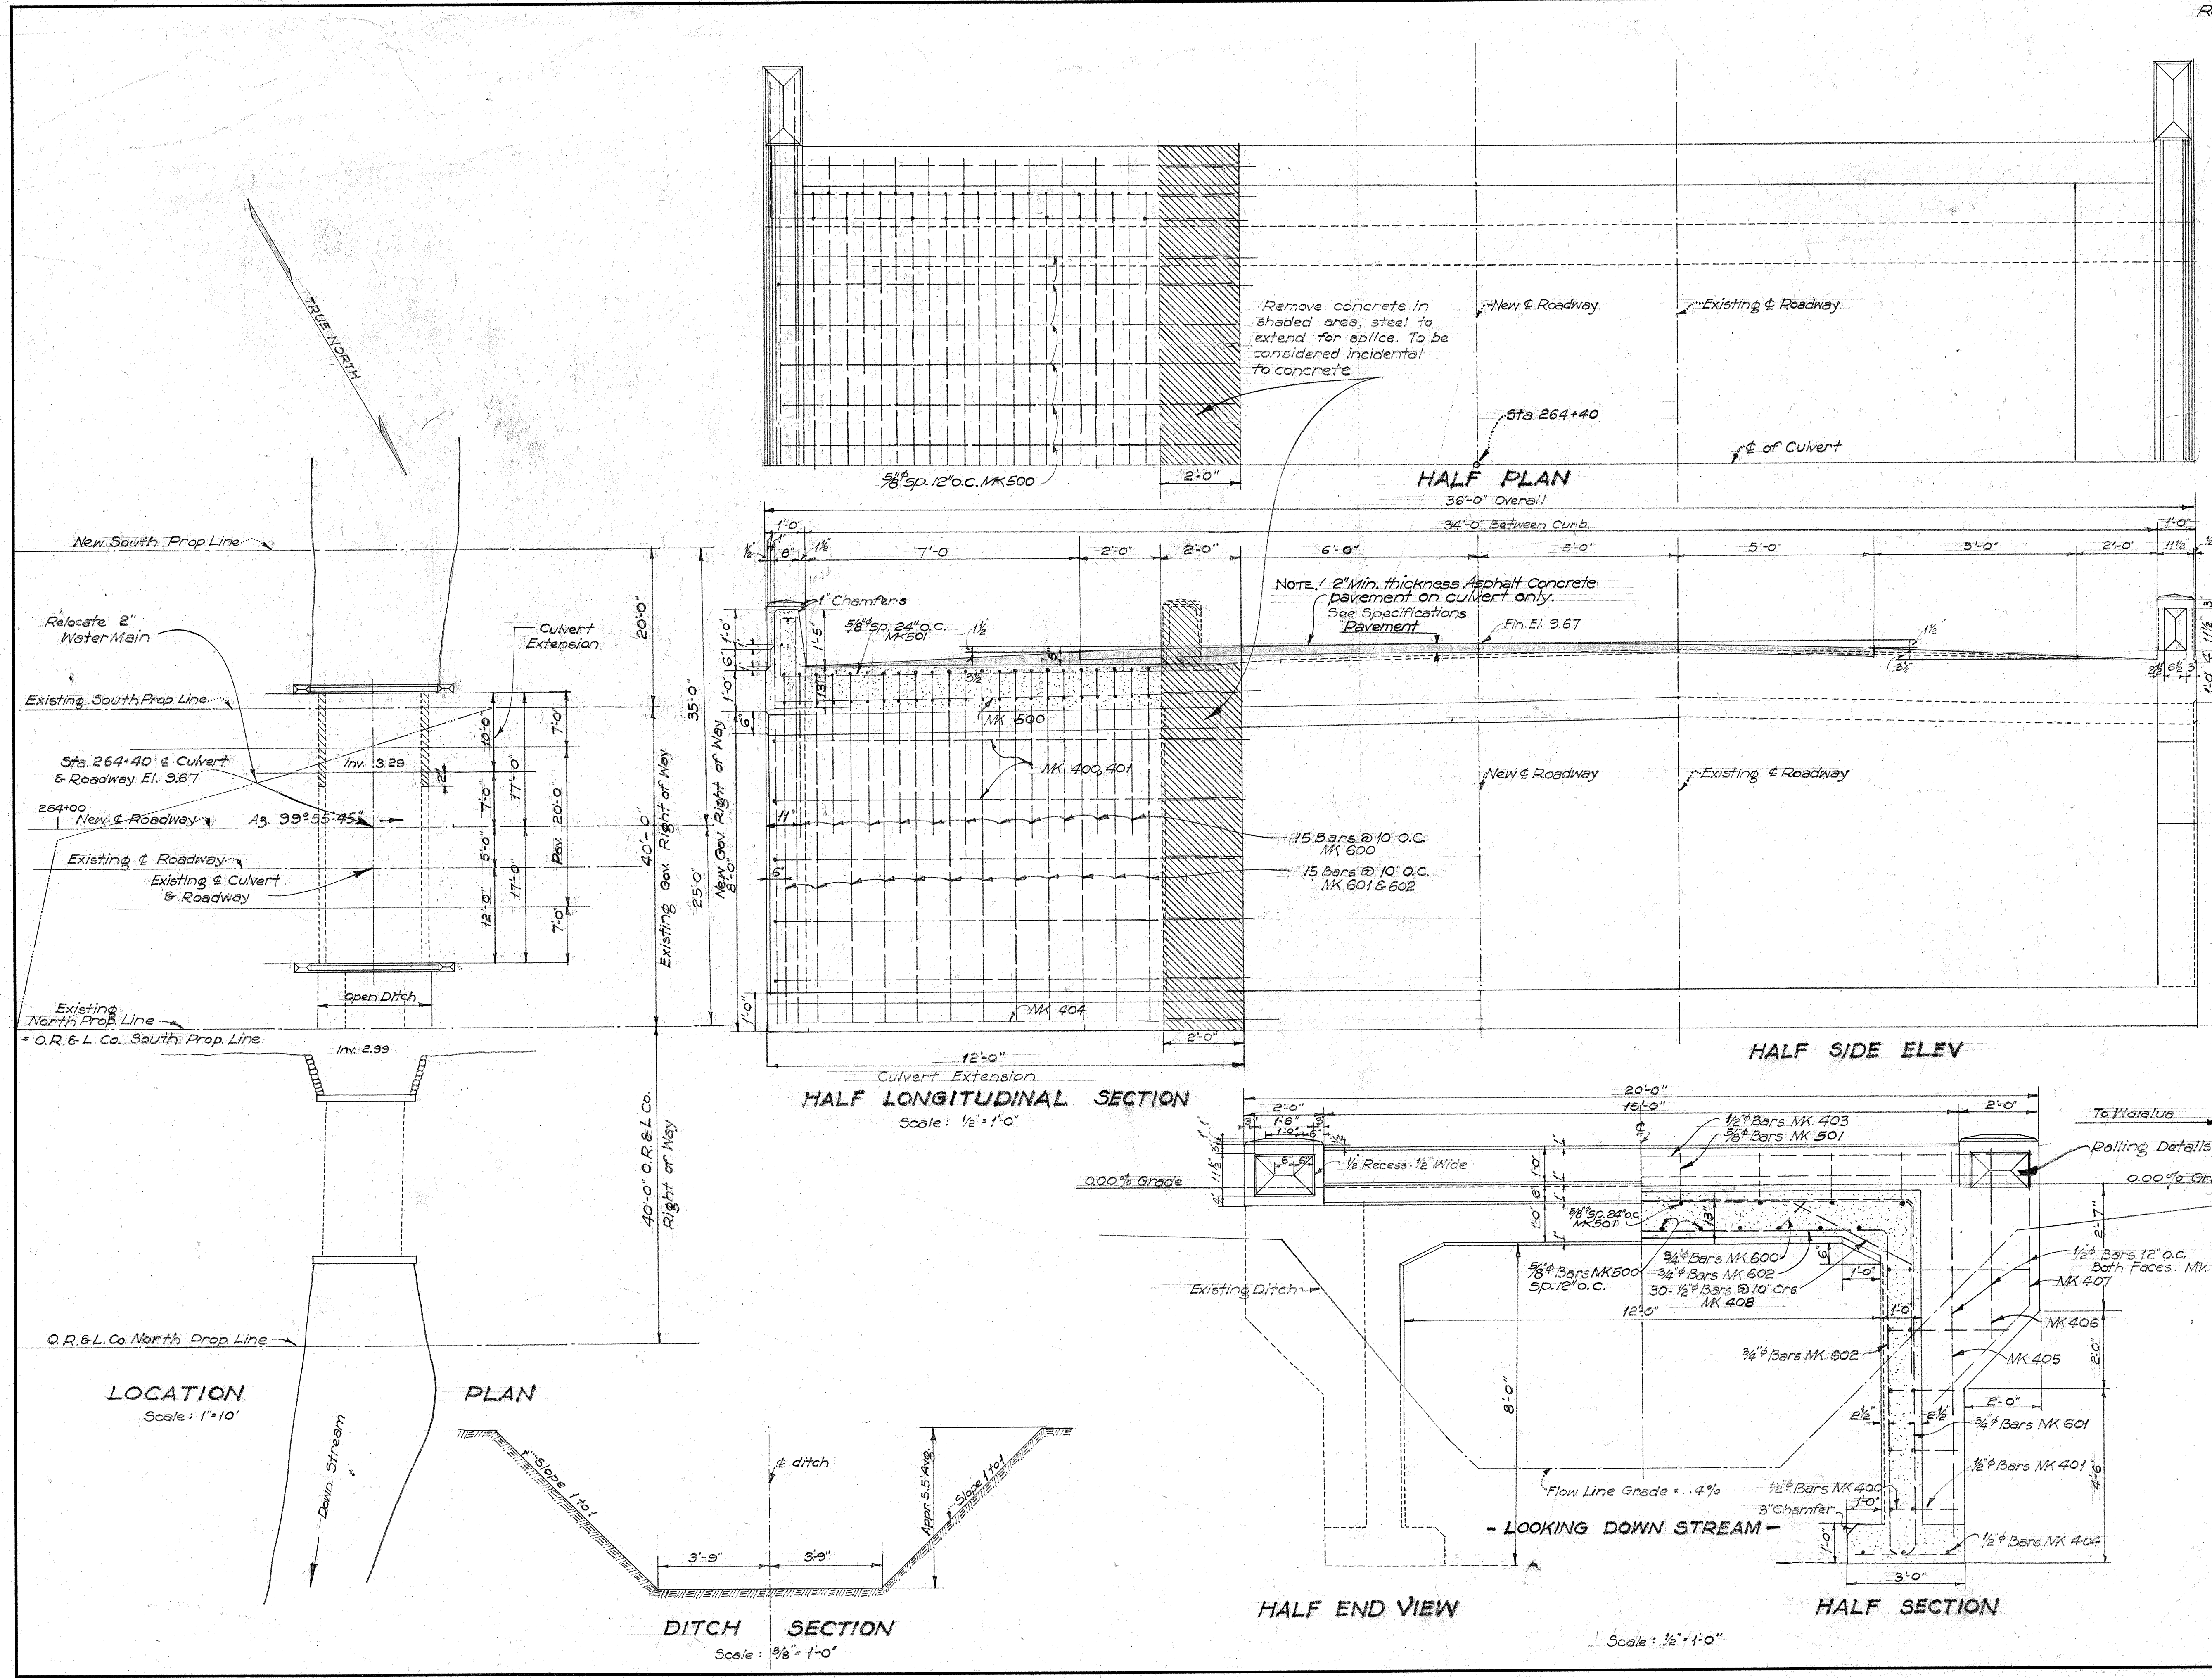

Revision
Trans. bars bot slab $\frac{3}{8}"$ sp. 12' o.c.
top " " " "

DESIGNED BY	DATE
TRACED BY	
QUANTITIES BY	
NOTE BOOK	
QUANTITIES CHECKED BY	
NO.	