3

FED. ROAD DIST. NO.	STATE	FED. AID PROJ. NO.	FISCAL YEAR	SHEET NO.	TOTAL SHEETS
HAWAII	HAW.	FAGH35B(1)	1939	1	58

5001. INDEX TO DRAWINGS

SHEET NO.	DESCRIPTION
1	TITLE SHEET
2	TYPICAL SECTIONS Also 5002 5003
3-4	PLAN & PROFILE
5	INTERSECTION DETAILS
6-7	PLAN & PROFILE R.R. RELOCATION
8-9	STANDARD DETAILS (H, & H_2)
10-11	MISCELLANEOUS DETAILS
12	SYPHON DETAILS
13	BOX CULVERT DETAILS
14-16	HIGHWAY OVERPASS DETAILS
17	STANDARD BRIDGE DETAILS (C.)
18-31	HIGHWAY UNDERPASS DETAILS
32-46	CROSS SECTIONS
47-49	CROSS SECTIONS (RANCH I CAMP RD.)
50-58	CROSS SECTIONS (R.R. RELOCATION)

5004

TERRITORY OF HAWAII
TERRITORIAL HIGHWAY DEPARTMENT
HONOLULU T.H.

PLANS OF

WAIALUA - KAENA PT. ROAD

FEDERAL AID GRADE CROSSING PROJECT NO. F.A.G.H. 35-B(1)

DISTRICT OF WAIALUA
ISLAND OF OAHU

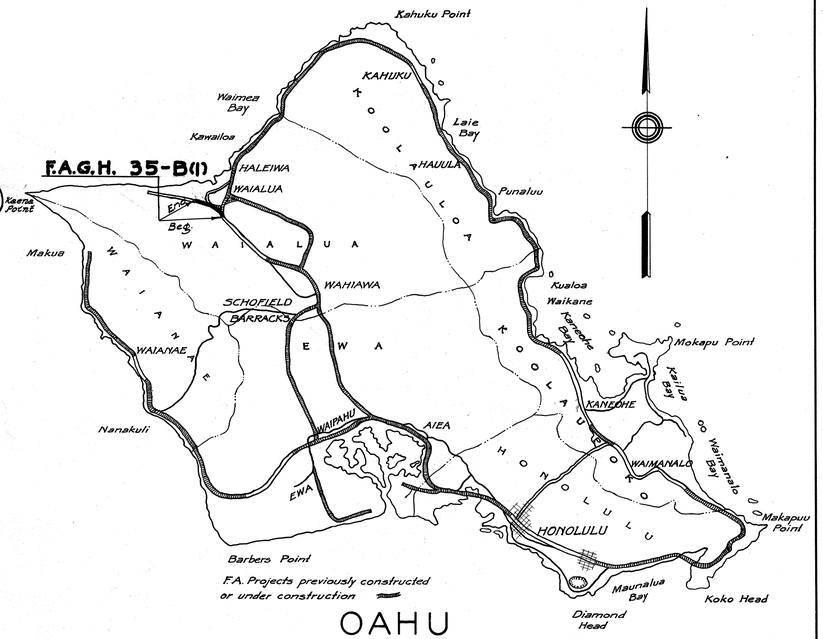

CONVENTIONAL SIGNS

- EXISTING ROAD
- EXISTING FENCE
- BOUNDARY LINE (NOT FENCED)
- EXISTING STONE FENCE
- RAILROAD
- CENTER LINE ROADWAY
- LARGE TREE
- CULVERTS

SCALE

PLAN		1 INCH	= 100 FEET
PROFILE	HOR	1 INCH	= 100 FEET
	VER	1 INCH	= 10 FEET
CROSS SECTION	HOR	1 INCH	= 5 FEET
	VER	1 INCH	= 5 FEET

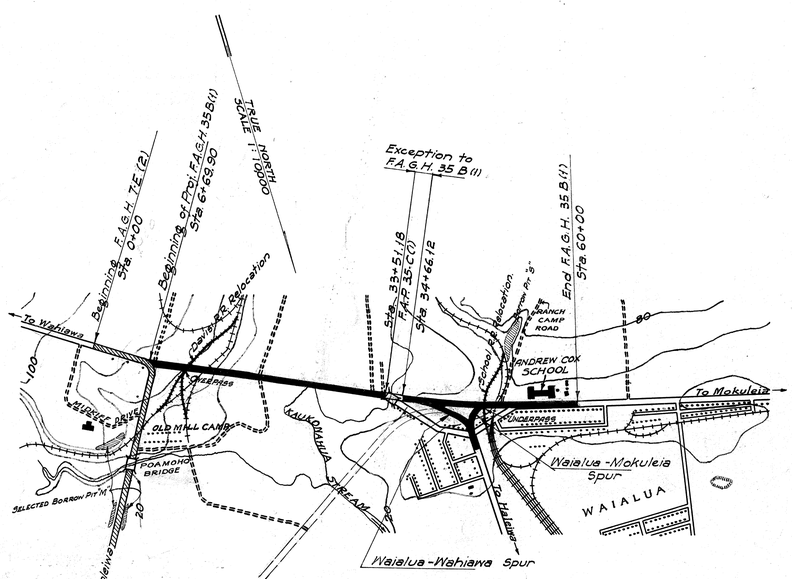

LAYOUT OF PROJECT
SCALE 1:10,000

Gross Length of Project	=	1.010 Mi.
Exception	=	0.021 "
Bridges over 20' span	=	0.004 "
Net Length of Roadway	=	0.985

0.989

ORIGINAL PLAN		DATE
	SURVEY PLOTTED BY	
	DESIGNED BY	
	DRAWN BY	Dec/1938
	TRACED BY G. K. Clark	
	QUANTITIES BY	
NOTE BOOK	QUANTITIES CHECKED BY	
No.	CHECKED BY	

RECOMMENDED FOR APPROVAL
[redacted]
DISTRICT ENGINEER, Pub. Rds. Adm. Federal Works Agency

RECOMMENDED FOR APPROVAL
[redacted]
CHIEF WESTERN REGION, Pub. Rds. Adm. Federal Works Agency

APPROVED
[redacted]
COMMISSIONER, Pub. Rds. Adm. Federal Works Agency

APPROVED
Louis B. Cain
Date 5/1/39
TERRITORIAL HIGHWAY ENGINEER

5001.1

PRINTED ON
MUTY TRACING CLOTH
A E CO., N.Y.