Revised March 7th 1940
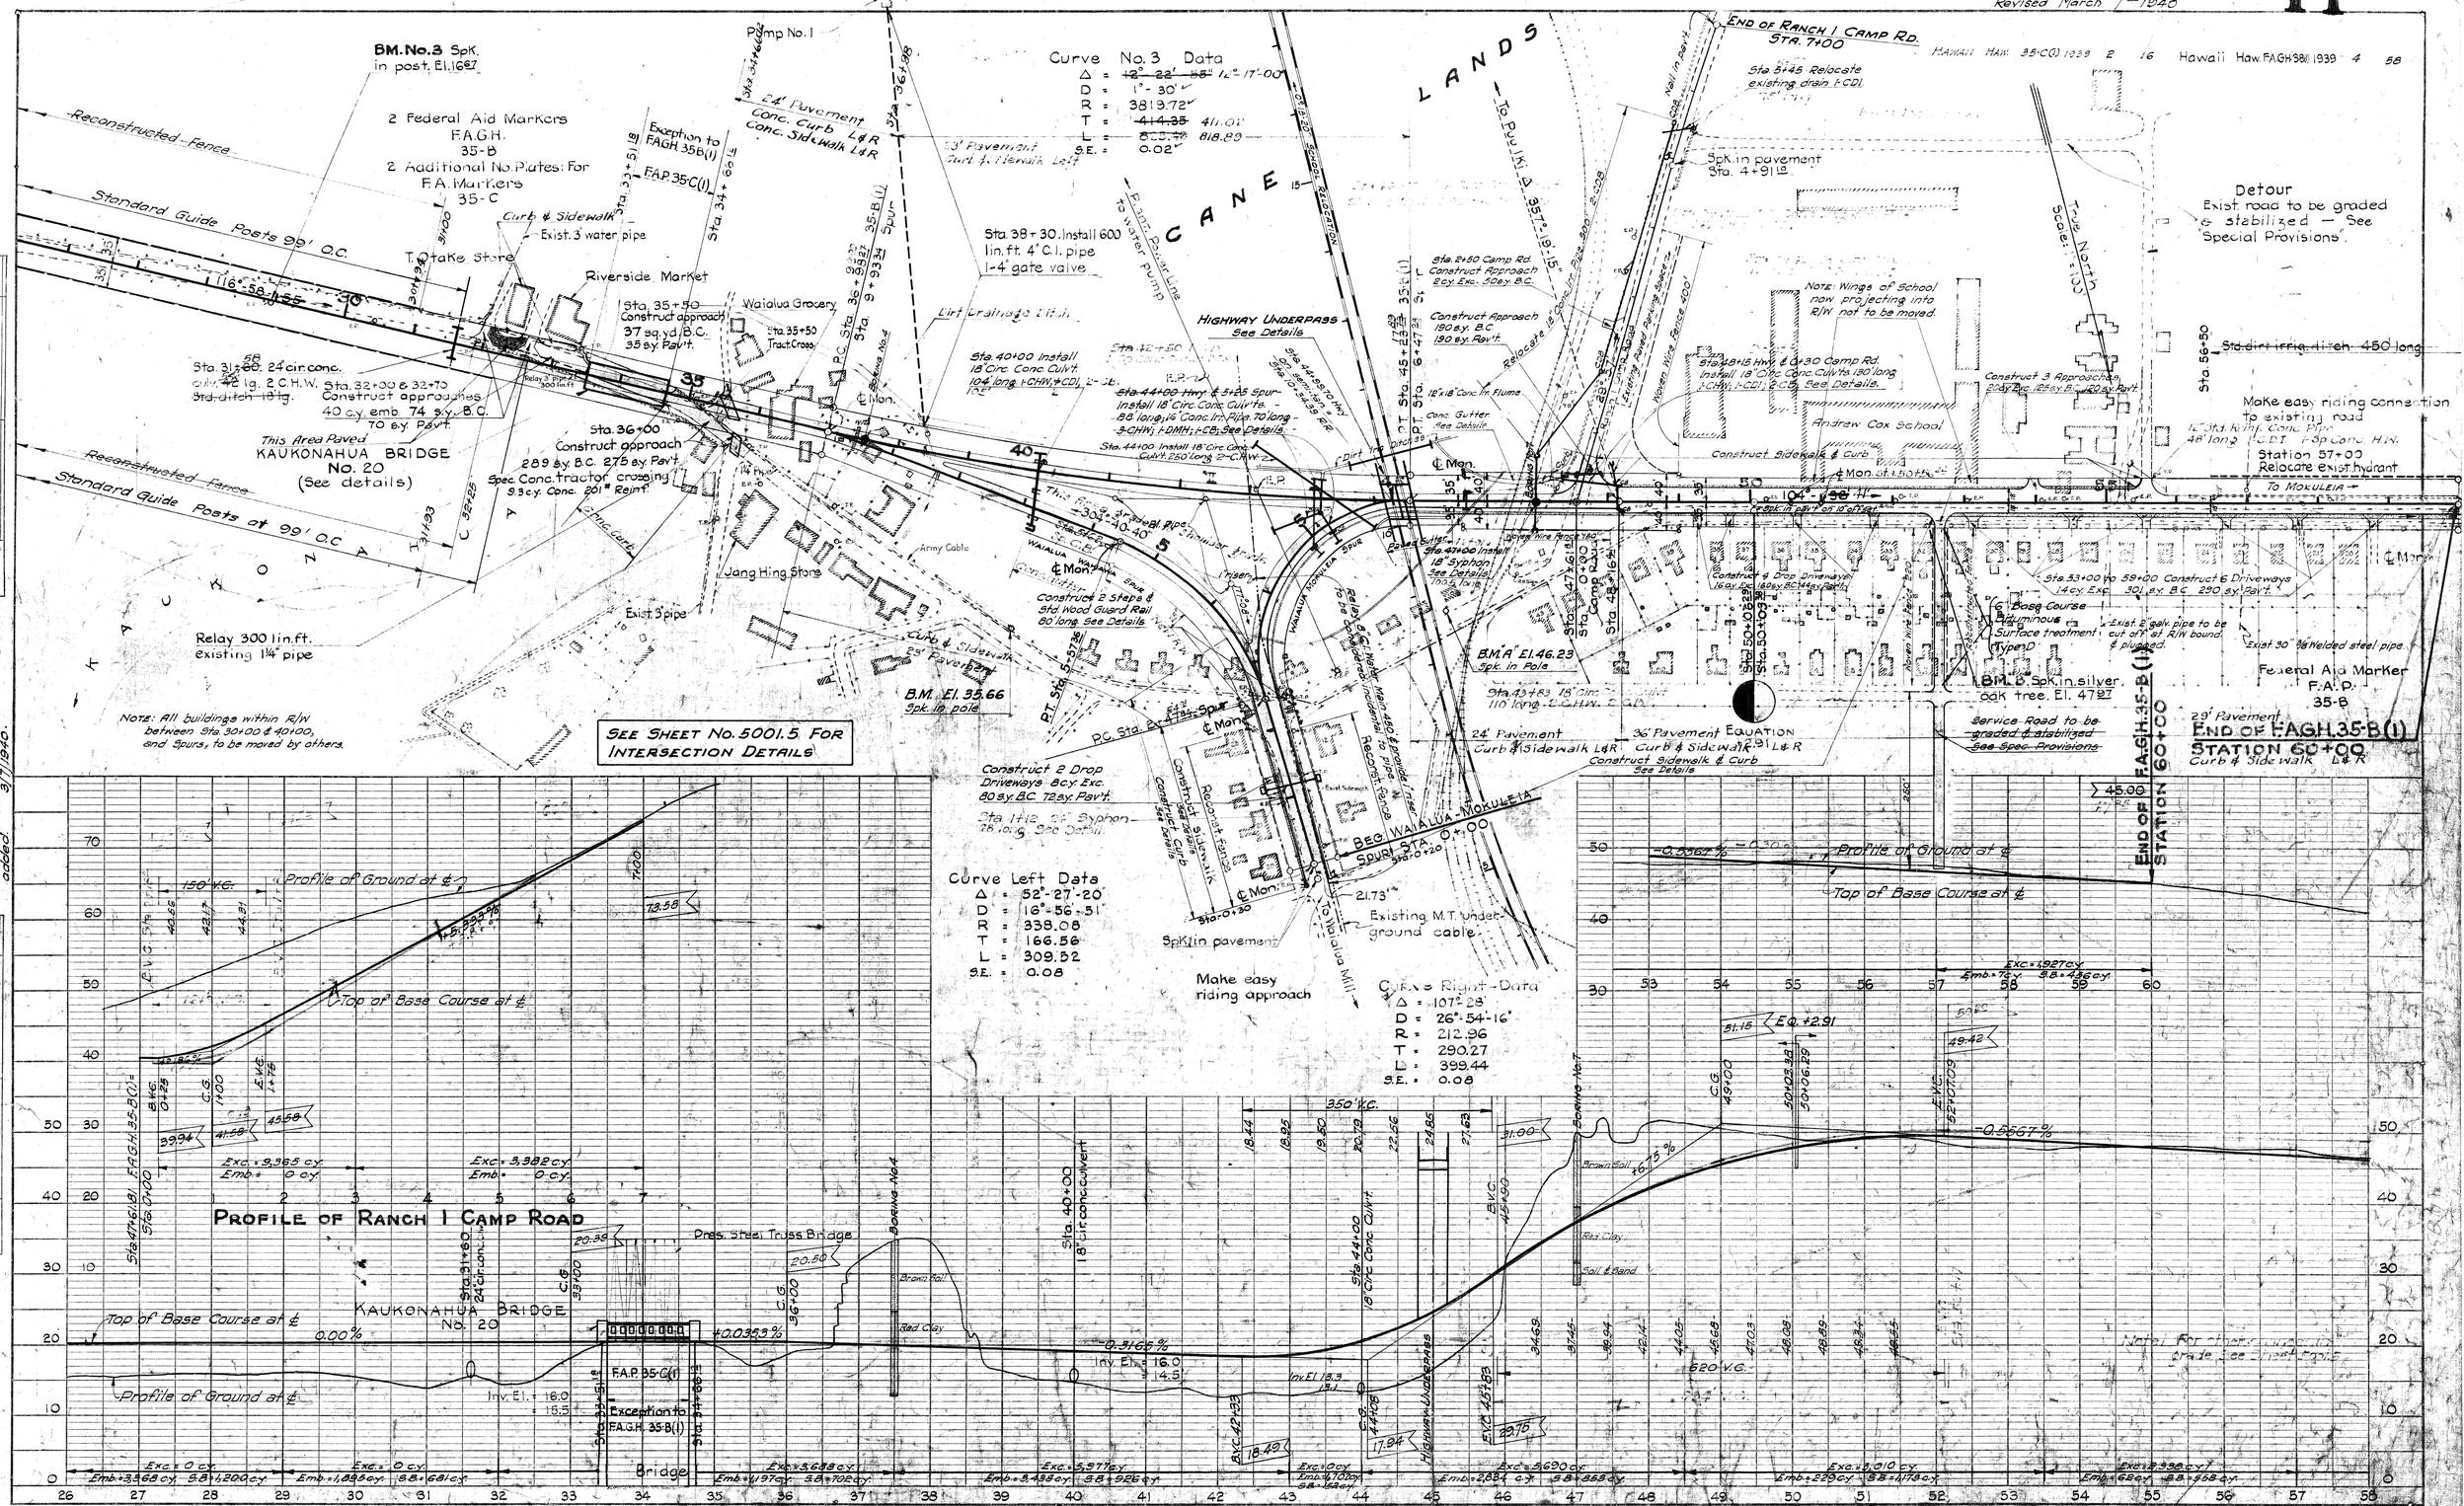
HAWAII HAW. 35-C(I) 1939 2 16 Hawaii Haw. F.A.G.H. 38(I) 1939 4 58