FED. ROAD DIST. NO.	STATE	PROJ. NO.	FISCAL YEAR	SHEET NO.	TOTAL SHEETS
HAWAII	HAW.	930D-01-69	1969	1	8

INDEX TO DRAWINGS

SHEET NO.	DESCRIPTION
1	TITLE SHEET
2	PLAN, PROFILE & DETAILS
3-7	STANDARD DETAILS
8	PROJECT IDENTIFICATION SIGN

STATE OF HAWAII
DEPARTMENT OF TRANSPORTATION
HIGHWAYS DIVISION
HONOLULU, HAWAII

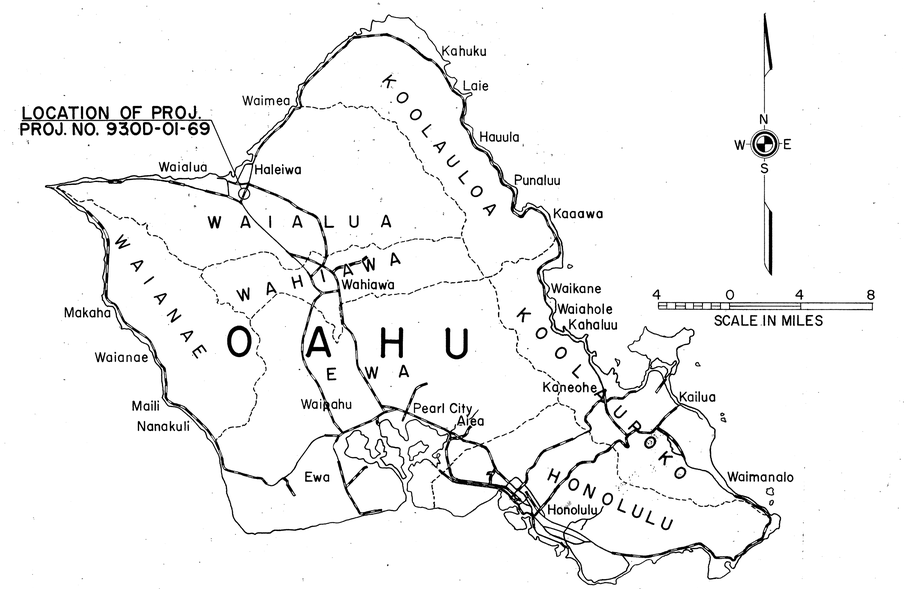

"AS BUILT"
PLANS FOR
CONSTRUCTION OF

DRAINAGE IMPROVEMENTS
ON
KAUKONAHUA ROAD
VICINITY OF KOGA STORE
PROJECT NO. 930D-01-69

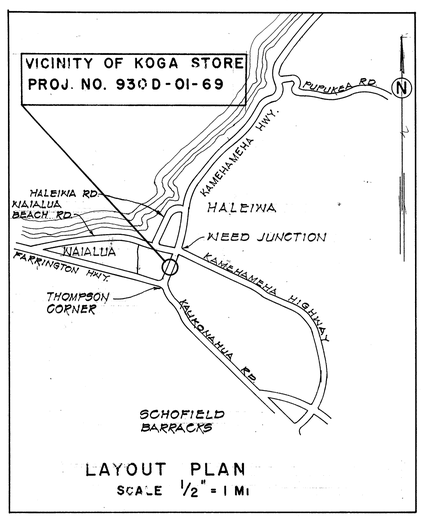

DISTRICT OF WAIALUA
ISLAND OF OAHU

NOTE:
ALL CHANGES MADE DURING CONSTRUCTION HAVE BEEN NOTED IN RED ON THESE TRACINGS AND CHECKED BY:

George G. Fails
PROJECT ENGINEER

11/12/73
DATE

DEPARTMENT OF TRANSPORTATION
STATE OF HAWAII
APPROVED:
for E. Alvey Wright 5/13/69
DIR. OF TRANSPORTATION DATE

R. Terada May 1969