FED. ROAD DIST. NO.	STATE	PROJ. NO.	FISCAL YEAR	SHEET NO.	TOTAL SHEETS
HAWAII	HAW.	804A-01-87M	1987	1	30

INDEX TO DRAWINGS

SHEET NO.	DESCRIPTION
1	TITLE SHEET
2	TYPICAL SECTIONS
3	MISCELLANEOUS DETAILS
4	GENERAL NOTES & LEGEND
5-9	PLANS
10	UTILITY GENERAL NOTES
11-30	SIGNING, PAVEMENT MARKING PLANS & DETAILS

STATE OF HAWAII

DEPARTMENT OF TRANSPORTATION
HIGHWAYS DIVISION
HONOLULU, HAWAII

"AS BUILT"

PLANS FOR

WHITMORE AVENUE RESURFACING AND SHOULDER IMPROVEMENTS

KAMEHAMEHA HIGHWAY TO MILITARY GATE

PROJECT NO. 804A-01-87M

DISTRICT OF WAHIAWA
ISLAND OF OAHU

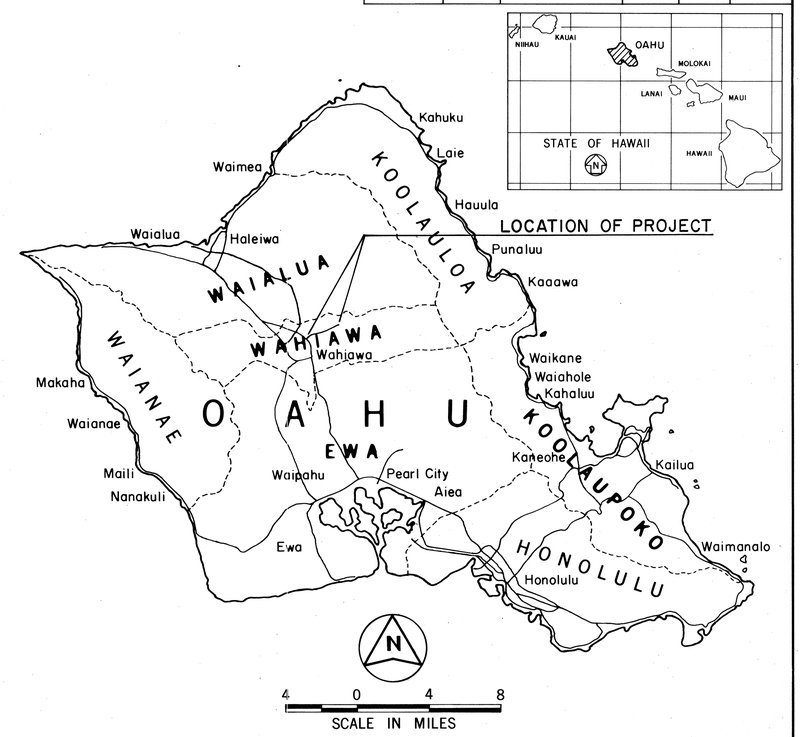

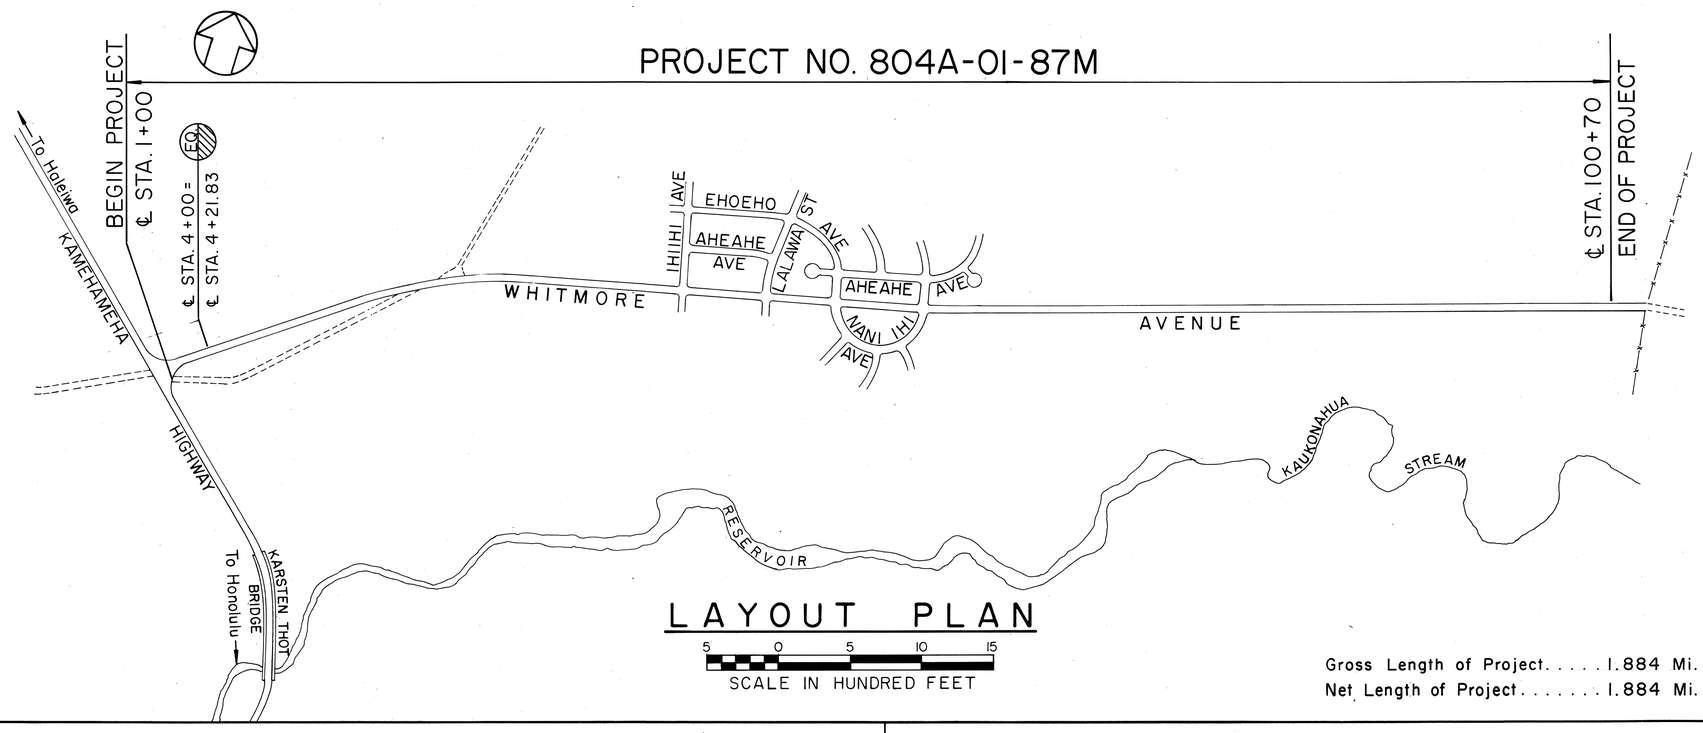

LAYOUT PLAN

5 0 5 10 15
SCALE IN HUNDRED FEET

Gross Length of Project. . . . . 1.884 Mi.
Net Length of Project. . . . . 1.884 Mi.

CHANGES MADE DURING CONSTRUCTION HAVE BEEN INCORPORATED ON THESE PLANS EXCEPT CHANGES IN THE ORIGINAL THEORETICAL QUANTITIES. FOR ACTUAL QUANTITIES, REFER TO PROJECT LEDGER AND/OR COMPUTATION BOOK.

Earl J. Kolotelu — RESIDENT ENGINEER — 3-15-88 DATE

DEPARTMENT OF TRANSPORTATION
STATE OF HAWAII
APPROVED:
for DIR. OF TRANSPORTATION — 5/16/88 DATE

UNIT "A"	J. FRONDA	548-7493	APRIL, 1986
DESIGNED BY	P. S. & E. BY	PHONE	DATE