FED. ROAD DIST. NO.	STATE	PROJ. NO.	FISCAL YEAR	SHEET NO.	TOTAL SHEETS
HAWAII	HAW.	7012A-01-21	2022	14	14

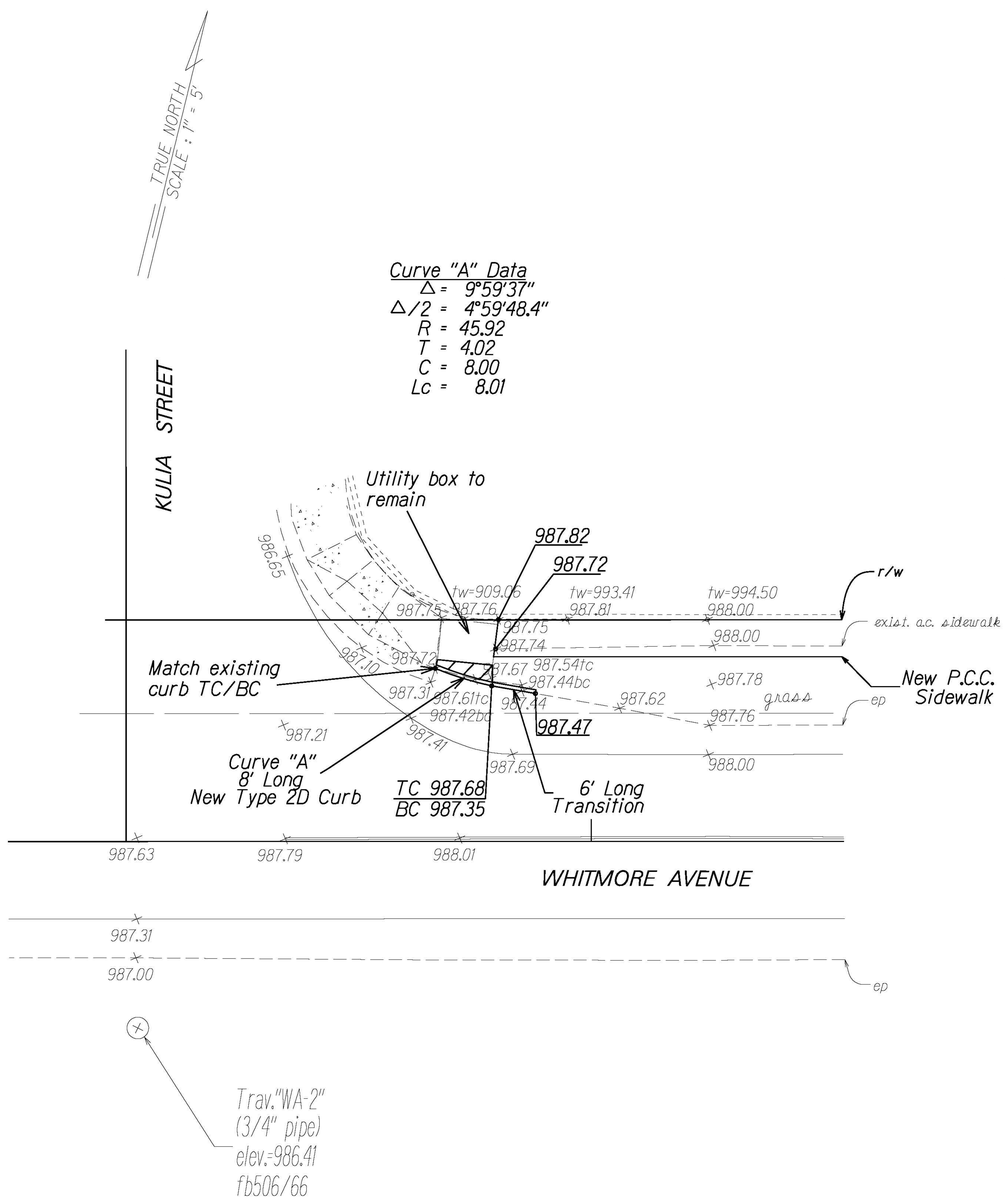

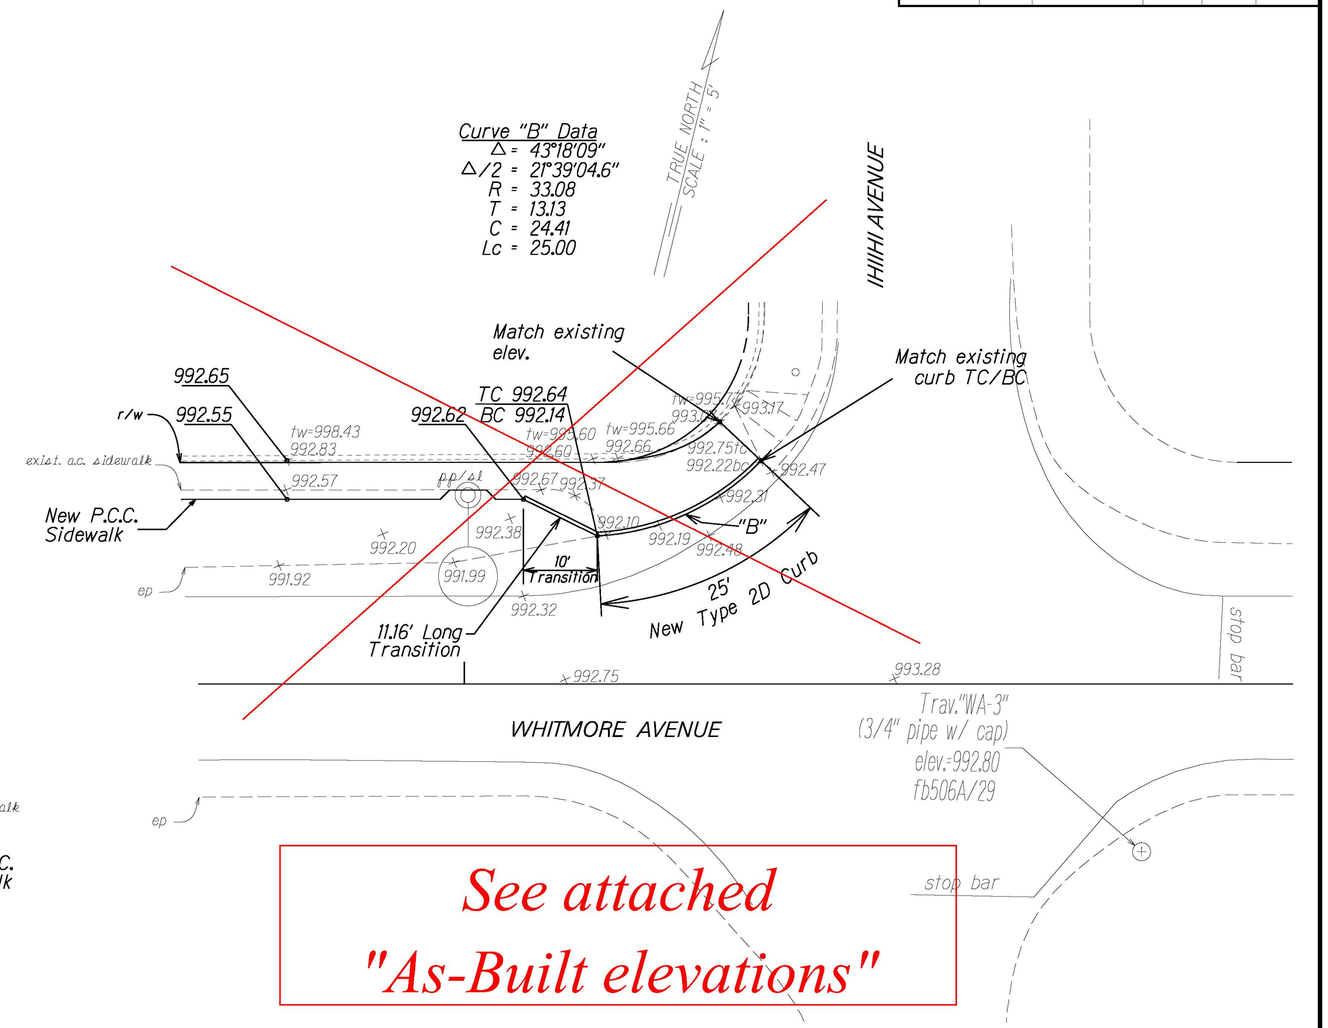

See attached "As-Built elevations"

AS-BUILT DRAWINGS
November 07 2022

Note:

For New Type 2D Curb details, see Standard Plan D-05.

ORIGINAL PLANS	SURVEY PLOTTED BY	DATE
	DRAWN BY	
	TRACED BY	
NOTE BOOK	DESIGNED BY	
	QUANTITIES BY	
No. 2WTM	CHECKED BY	

STATE OF HAWAII
DEPARTMENT OF TRANSPORTATION
HIGHWAYS DIVISION

CURBING PLANS

WHITMORE AVENUE SIDEWALK IMPROVEMENTS
Uakanikoo Street to Ihiihi Avenue
Project No. 7012A-01-21

Scale: 1" = 5' Date: October, 2021

SHEET No. 1 OF 1 SHEETS

As-Built elevations

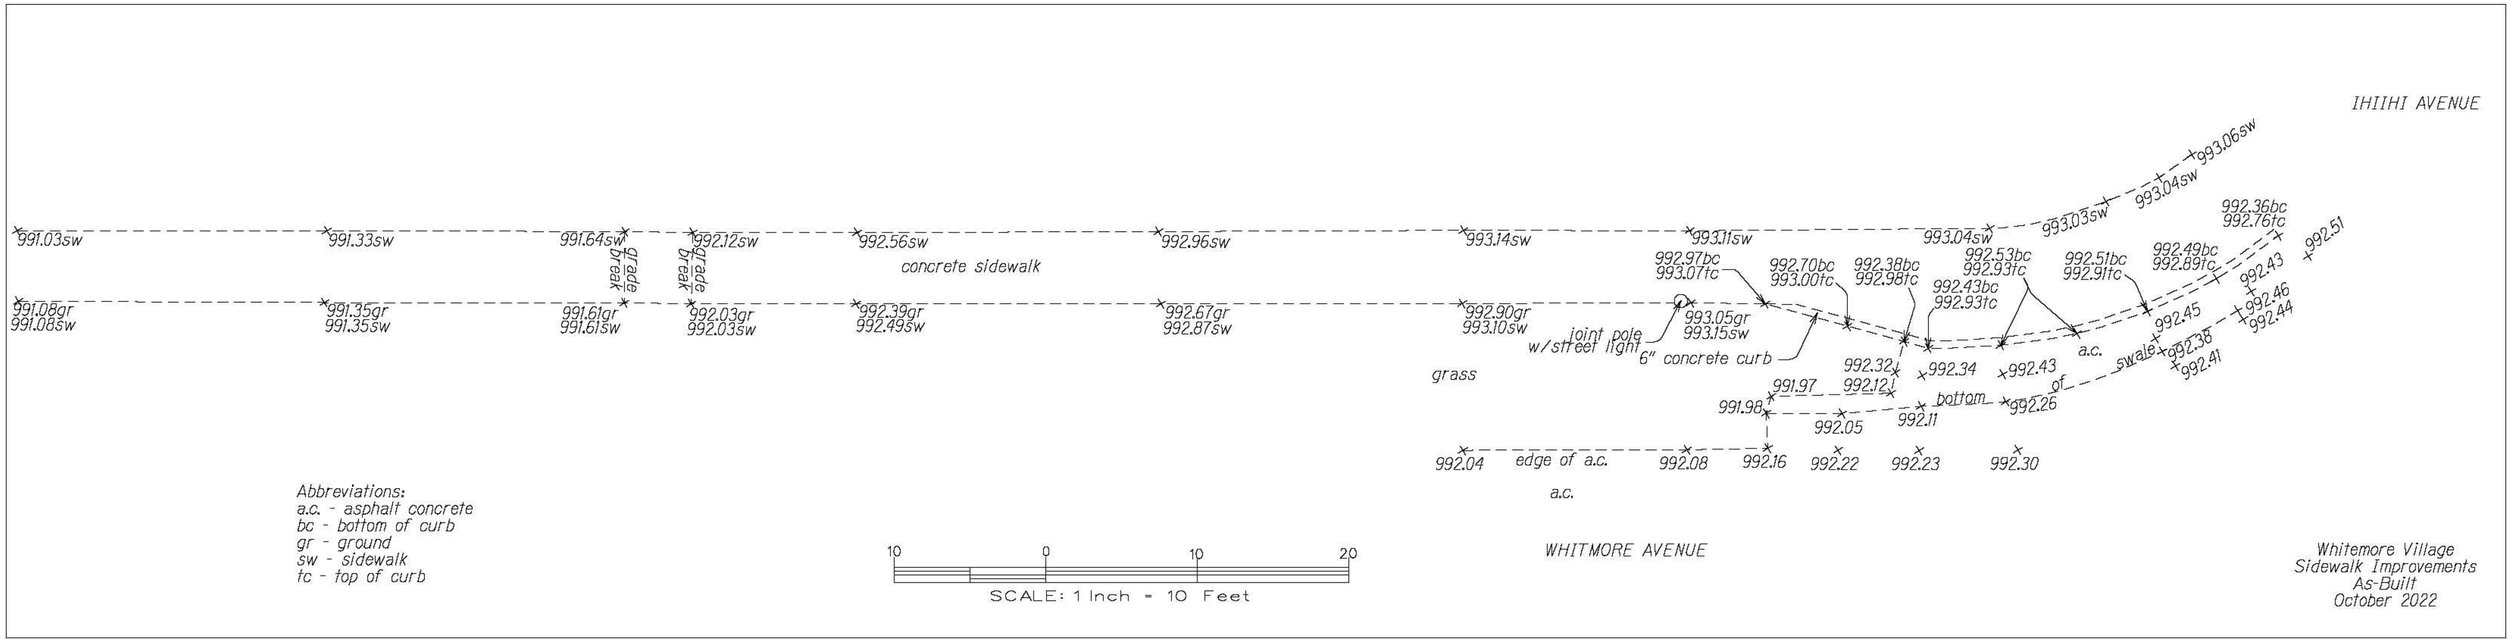

Abbreviations:
a.c. - asphalt concrete
bc - bottom of curb
gr - ground
sw - sidewalk
tc - top of curb

Whitemore Village
Sidewalk Improvements
As-Built
October 2022

AS-BUILT DRAWINGS

November 07 2022