INDEX TO DRAWINGS	
SHEET NO.	DESCRIPTION
1	TITLE SHEET
2	STANDARD PLANS SUMMARY
3 – 7	GENERAL NOTES AND LEGEND
8 – 10	WATER POLLUTION & EROSION CONTROL NOTES
11	SEDIMENT AND EROSION CONTROL PLAN
12	ROADWAY PLAN
13	TYPICAL SECTIONS & DETAILS
14	CURBING PLANS

FED. ROAD DIST. NO.	STATE	PROJ. NO.	FISCAL YEAR	SHEET NO.	TOTAL SHEETS
HAWAII	HAW.	7012A–01–21	2022	1	14

7012

STATE OF HAWAII

DEPARTMENT OF TRANSPORTATION

HIGHWAYS DIVISION

HONOLULU, HAWAII

"AS-BUILT"

PLANS FOR

WHITMORE AVENUE SIDEWALK IMPROVEMENTS

UAKANIKOO STREET TO IHIIHI AVENUE

PROJECT NO. 7012A–01–21

DISTRICT OF WAHIAWA

ISLAND OF OAHU

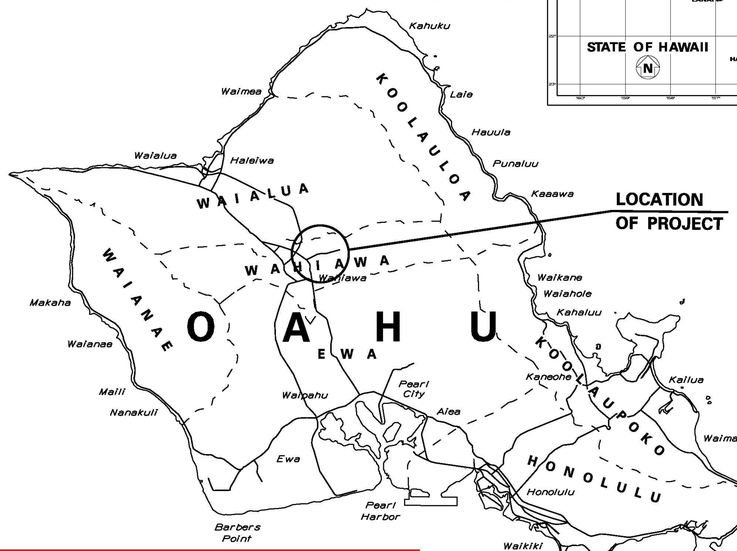

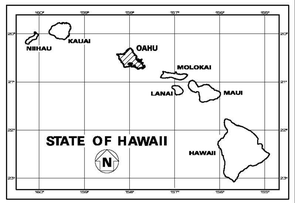

PROJECT LIMITS

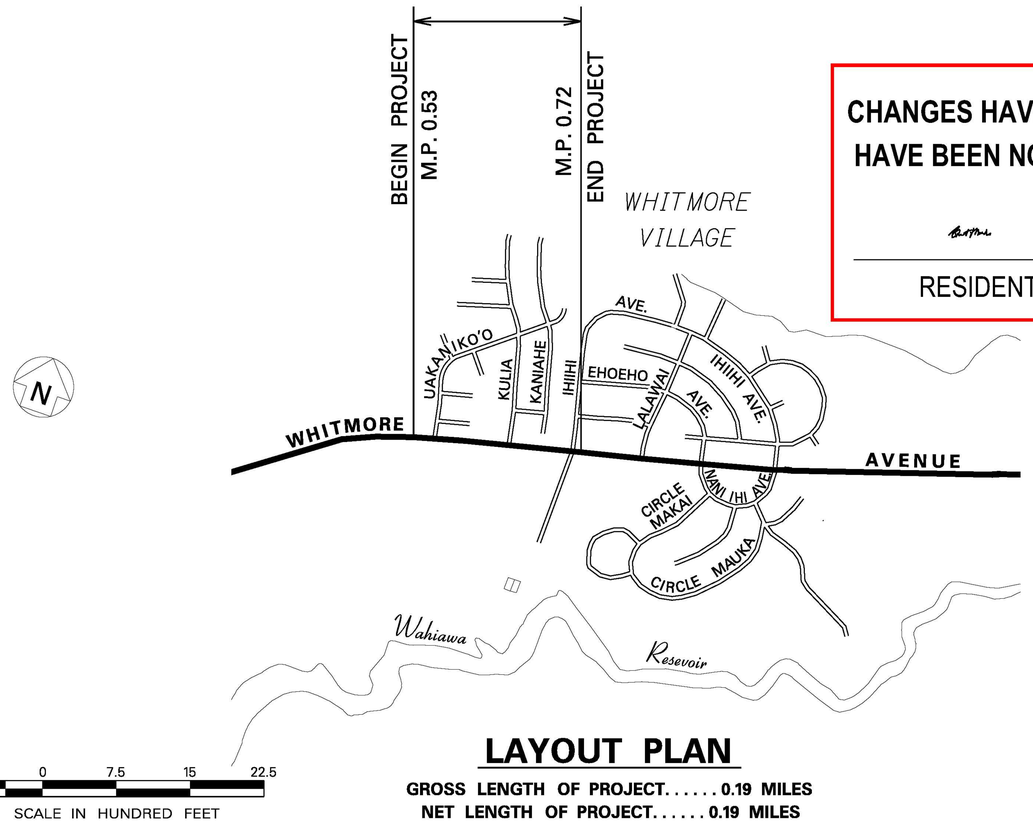

CHANGES HAVE BEEN MADE DURING CONSTRUCTION HAVE BEEN NOTED ON THESE PLANS AND CHECKED

RESIDENT ENGINEER — DATE: Nov 7, 2022

4 0 4 8
SCALE IN MILES

MILE POST 0.53 TO MILE POST 0.72

LAYOUT PLAN

GROSS LENGTH OF PROJECT. . . . . 0.19 MILES
NET LENGTH OF PROJECT. . . . . 0.19 MILES

AS-BUILT DRAWINGS
November 07 2022

DEPARTMENT OF TRANSPORTATION
STATE OF HAWAII
APPROVED:
DIR. OF TRANSPORTATION — DATE: Oct 19, 2021

Sept.,2021 DATE
692–7570 PHONE
HWY–DD MANAGED BY
HWY–D DESIGNED BY