FED. ROAD DIST. NO.	STATE	FED. AID PROJ. NO.	FISCAL YEAR	SHEET NO.	TOTAL SHEETS
HAWAII	HAW.	F-090-1(12) UNIT 1	1967	2	5

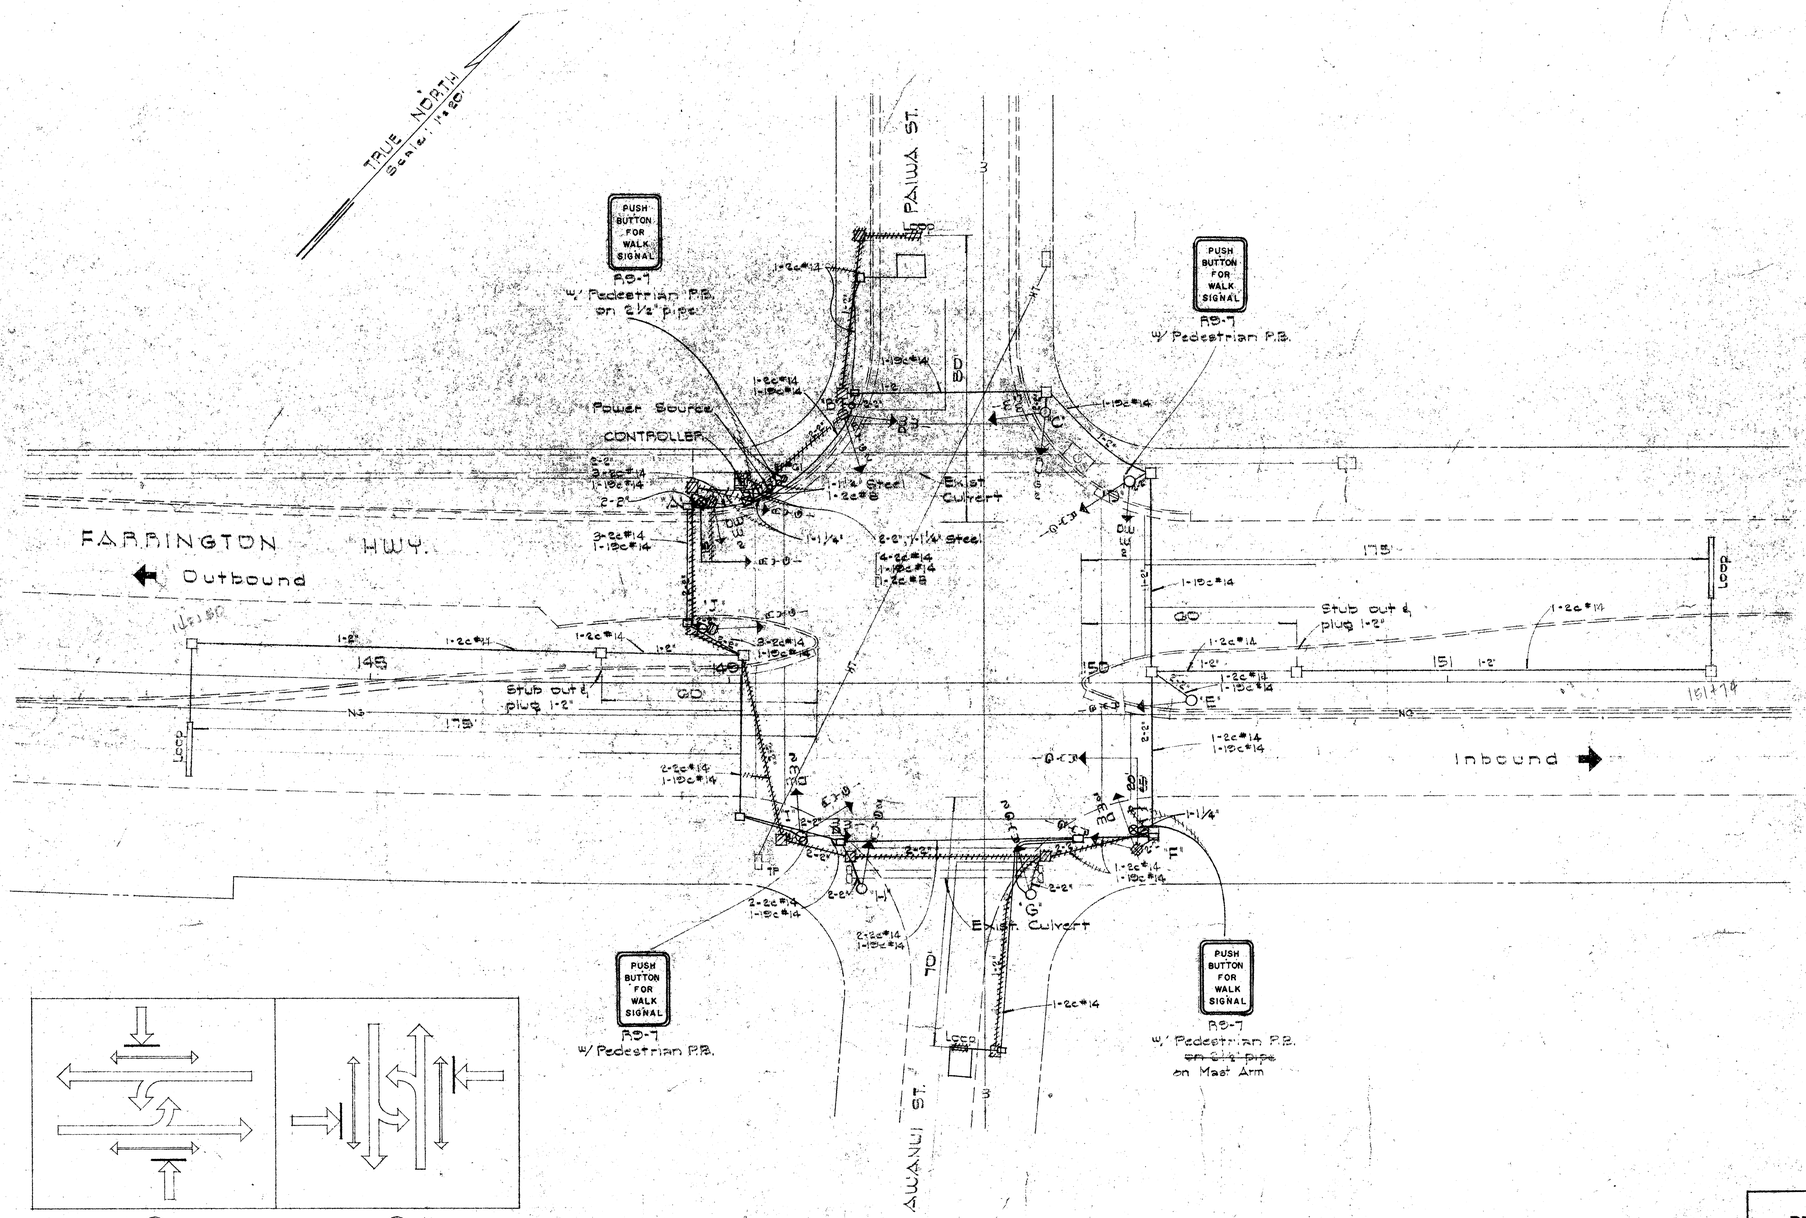

STATE OF HAWAII
DEPARTMENT OF TRANSPORTATION
HIGHWAYS DIVISION

TRAFFIC SIGNAL SYSTEM

FARRINGTON HIGHWAY
AT
PAIWA ST. AND AWANUI ST.

Project No. F-090-1(12), Unit 1
Scale: 1" = 20'
Rev. March 1967

SHEET No. OF SHEETS

SEE TCP-10300(6) FOR MAP (2)

ORIGINAL PLAN	SURVEY PLOTTED BY	DATE
	DRAWN BY	
	TRACED BY	
NOTE BOOK	DESIGNED BY	
	QUANTITIES BY	
NO.	CHECKED BY	

PRINTED ON NO. 1000H CLEARPRINT