FED. ROAD DIST. NO.	STATE	PROJ. NO.	FISCAL YEAR	SHEET NO.	TOTAL SHEETS
HAWAII	HAW.	7101A-01-89M	1989	1	27

INDEX TO DRAWINGS

SHEET NO.	DESCRIPTION
1	TITLE SHEET
2	STANDARD PLANS SUMMARY
3 - 4	GENERAL NOTES, TYPICAL
	SECTIONS AND DETAILS
5 - 13	PLANS
14 - 23	PAVEMENT MARKING PLANS
	AND DETAILS
24 - 27	BRIDGE GUARDRAIL CONNECTION
	DETAILS

STATE OF HAWAII

DEPARTMENT OF TRANSPORTATION

HIGHWAYS DIVISION

HONOLULU, HAWAII

"AS-BUILT"

PLANS FOR

FARRINGTON HIGHWAY RESURFACING

LEOKANE STREET TO KAMEHAMEHA HIGHWAY

PROJECT NO. 7101A-01-89M

DISTRICT OF EWA

ISLAND OF OAHU

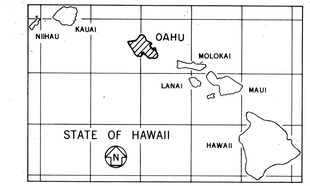

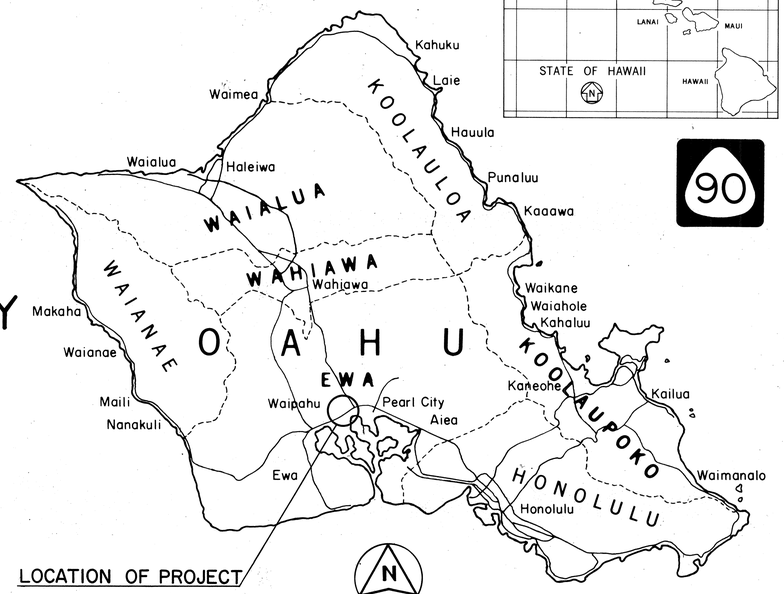

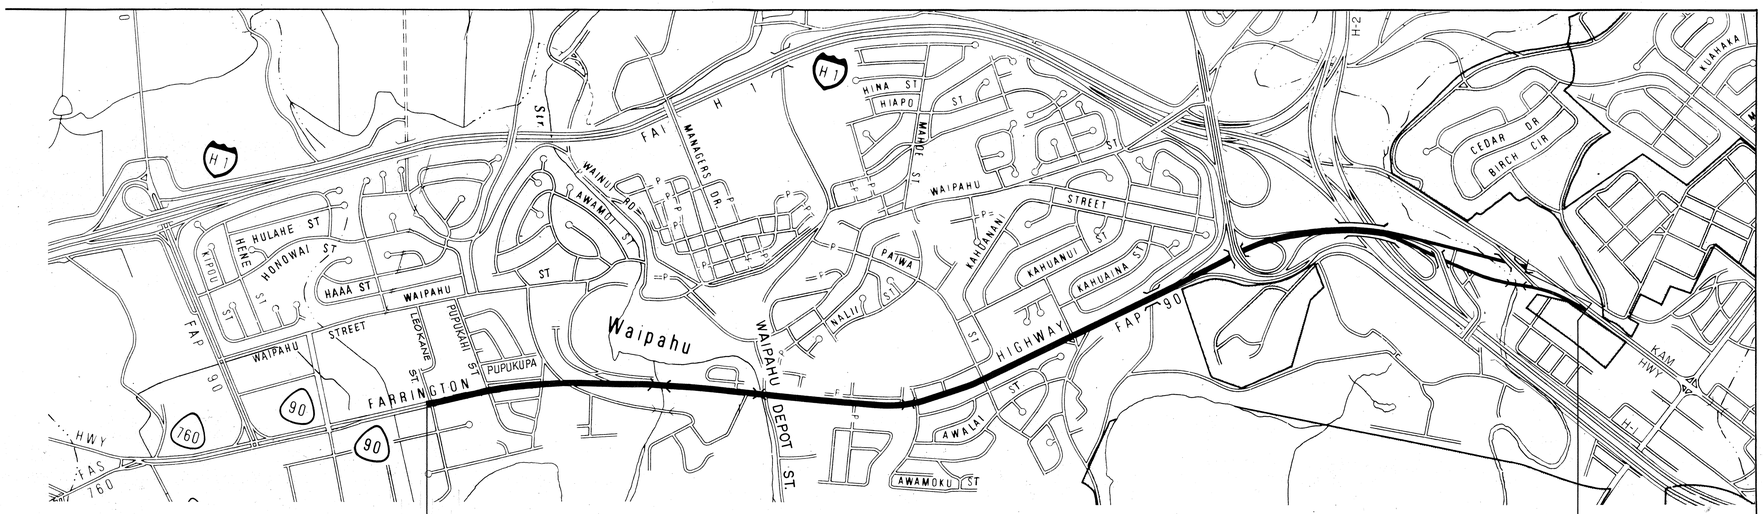

BEGIN PROJECT F.H. ℄ STA. 70+00

END PROJECT F.H. ℄ O.B. STA. 26+15 ±
F.H. ℄ I.B. STA. 25+85 ±

LAYOUT PLAN

SCALE IN THOUSAND FEET

GROSS LENGTH OF PROJECT .....2.25 miles
NET LENGTH OF PROJECT .....2.23 miles

SCALE IN MILES

MILE POST 0.60 TO MILE POST 3.00

CHANGES MADE DURING CONSTRUCTION HAVE BEEN INCORPORATED ON THESE PLANS EXCEPT CHANGES IN THE ORIGINAL THEORETICAL QUANTITIES. FOR ACTUAL QUANTITIES, REFER TO PROJECT LEDGER AND/OR COMPUTATION BOOK.

Michael D. Miura — 5/14/91
RESIDENT ENGINEER — DATE

DESIGN UNIT "E" — A. YAMAGUCHI — 548-7534 — AUG., 1988
DESIGNED BY — P. S. & E. BY — PHONE — DATE

DEPARTMENT OF TRANSPORTATION
STATE OF HAWAII

APPROVED:

Edward Thrus — 5/3/89
DIR. OF TRANSPORTATION — DATE

DD-D-6-9