FED. ROAD DIST. NO.	STATE	FED. AID PROJ. NO.	FISCAL YEAR	SHEET NO.	TOTAL SHEETS
HAWAII	HAW.	STP-7101(1)	1998	C.O. 4	16

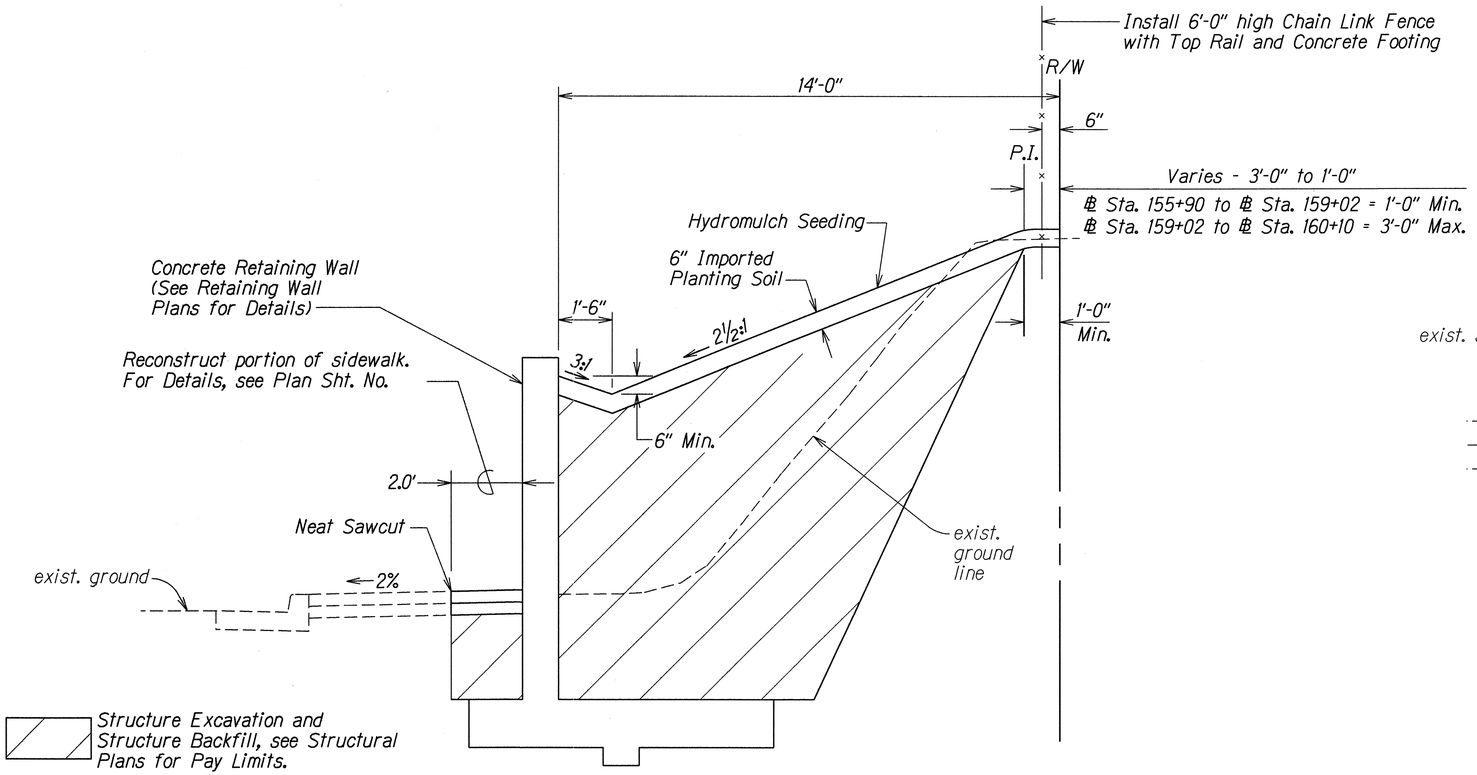

TYPICAL SECTION
℄ STA. 155+90± to ℄ STA. 160+10±
Scale: ½"=1'-0"

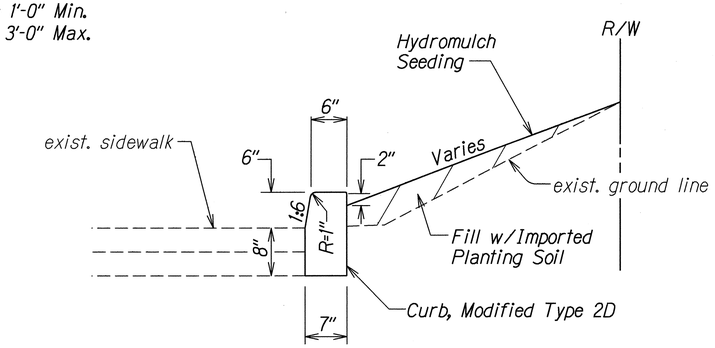

Note: See Standard Plan D-04 for additional curb, Type 2D Details.

TYPICAL SECTION
℄ STA. 161+42± to ℄ STA. 162+37± Rt.
Scale: 1"=1'-0"

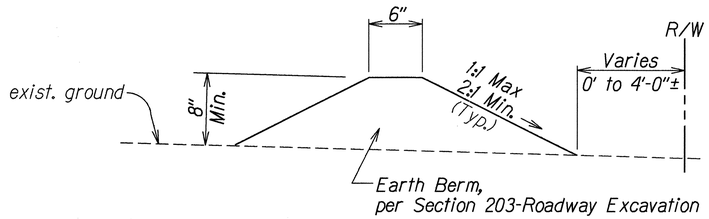

TYPICAL SECTION OF EARTH BERM
℄ STA. 152+50± RT. TO ℄ STA. 154+00± RT.
Scale: 1½"=1'-0"

ORIGINAL PLAN	SURVEY PLOTTED BY	DATE 1/31/98
	DRAWN BY J. Mitsuyoshi, MH	
NOTE BOOK dd3/yrne	TRACED BY R. Segueira	
	DESIGNED BY	
	QUANTITIES BY	
	CHECKED BY	

DATE	REVISION
1/4/99	Revise Typical Section, ℄ Sta. 155+90± to ℄ Sta. 160+10±.

STATE OF HAWAII
DEPARTMENT OF TRANSPORTATION
HIGHWAYS DIVISION

TYPICAL SECTIONS

FARRINGTON HWY. RETAINING WALL
Vicinity of Awanui St. to Waipio Pt. Access Rd.
F.A. Proj. No. STP-7101(1)

Scale: As Shown Date: April 1998

SHEET No. 1 OF 1 SHEETS

C.O. 4