


Revision: This portion of work originally contemplated to be done under Proj. No. SN-FAP 9-D(1) July 0, 1945. 9-D(4) deleted from that project and put back under Proj. No. SN-FAP 9-D(2) from 4 to 6 lanes. Feb. 1945.

ORIGINAL	SURVEY	DATE
DESIGNED BY	PLANNED BY	PLANNED BY
NOTED BY	NOTED BY	NOTED BY
CHECKED BY	CHECKED BY	CHECKED BY

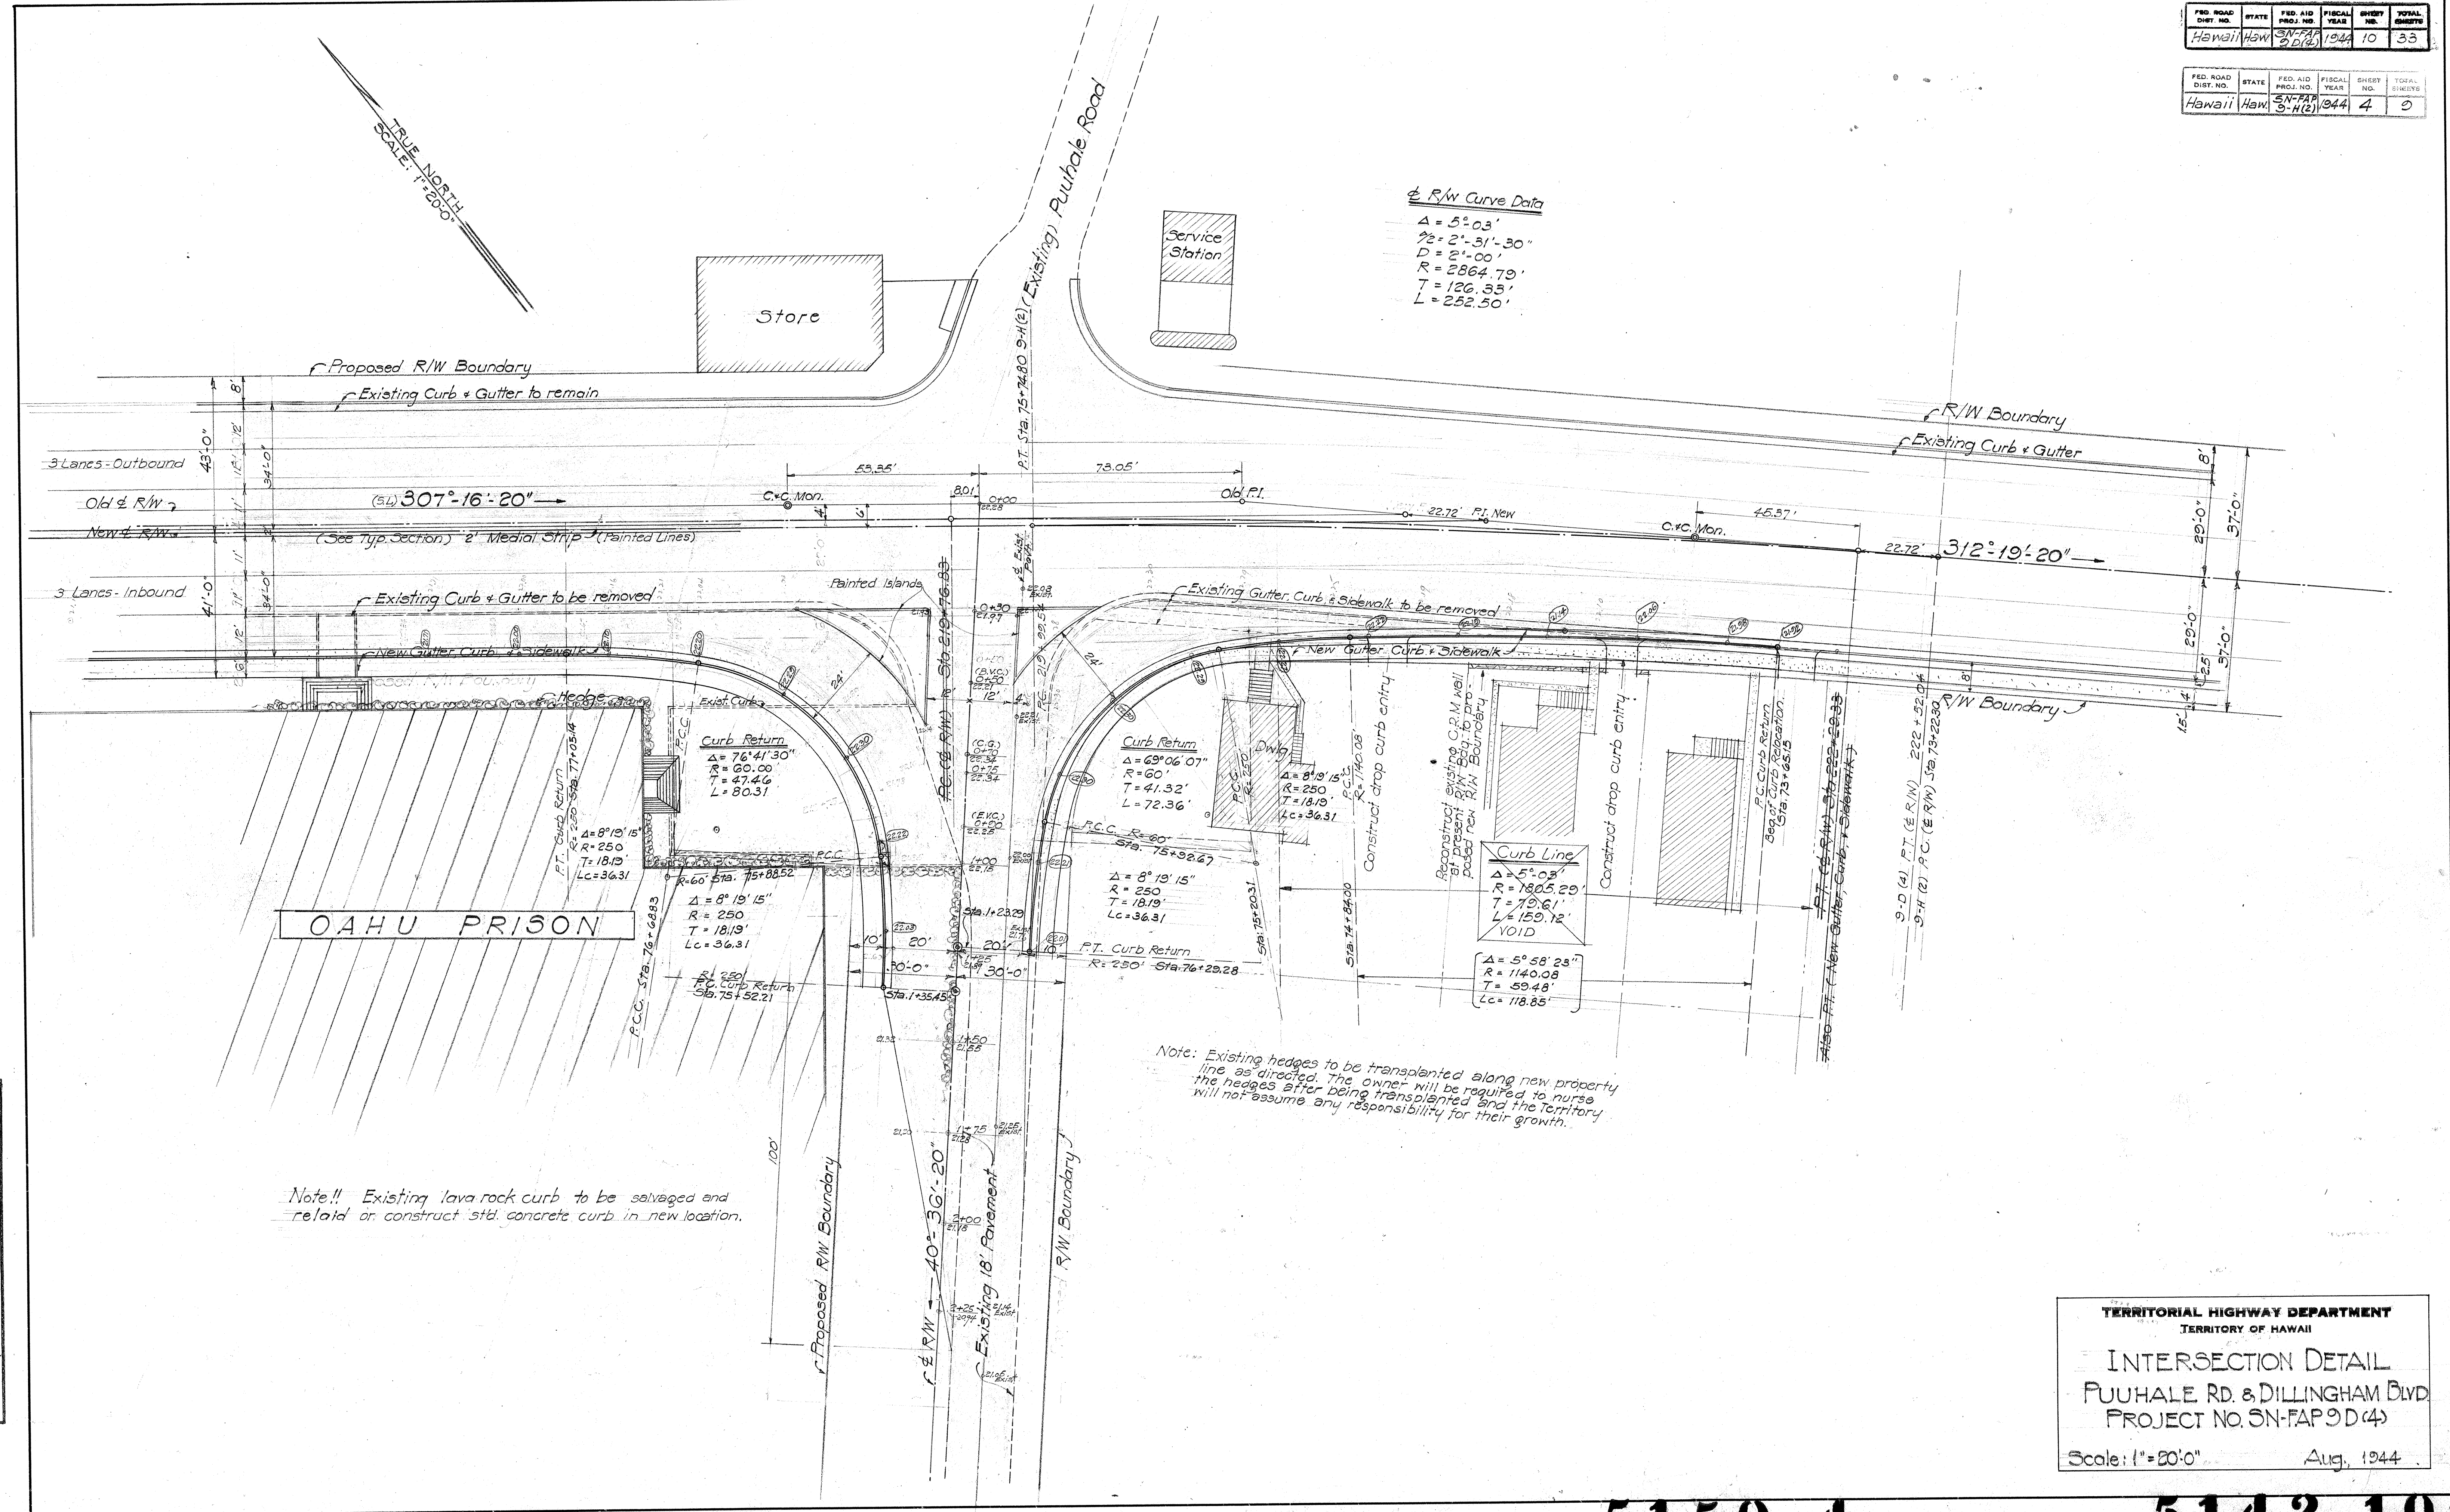

5159.4

5142.10