HAWAII HAW. SN FAP 9-D(4) 1942 1

Sec. #2

INDEX TO DRAWINGS	
SHEET NO.	DESCRIPTION
1	Title Sheet
2	Typical Sections
3-8	Plan & Profile
9	Curve & Culvert Details
10	Puuhale Road Intersection
11-14	Standard Details
15-33	Cross Sections

All changes made during construction have been shown in red on these tracings and checked by

Resident Engineer.

Date

TERRITORY OF HAWAII

TERRITORIAL HIGHWAY DEPARTMENT

HONOLULU T.H.

PLANS OF

KAMEHAMEHA HIGHWAY
PUULOA ROAD TO OAHU PRISON

FEDERAL AID PROJECT NO. SN-FAP 9-D(4) Sec. #2

HONOLULU DISTRICT
ISLAND OF OAHU

SCALE

PLAN ..... 1 INCH = 50 FEET

PROFILE ..... HOR., 1 INCH = 50 FEET; VER., 1 INCH = 5 FEET

CROSS SECTIONS HOR., 1 INCH = 10 FEET; VER., 1 INCH = 10 FEET

Centerline 175
Boundary (Not Fenced)
Boundary (Fenced)
Existing Road
Railroad Track
Circular Conc. Culv't.
Concrete Box Culv't.
Bridge
Telephone Pole
Electric Pole
Coconut Palm

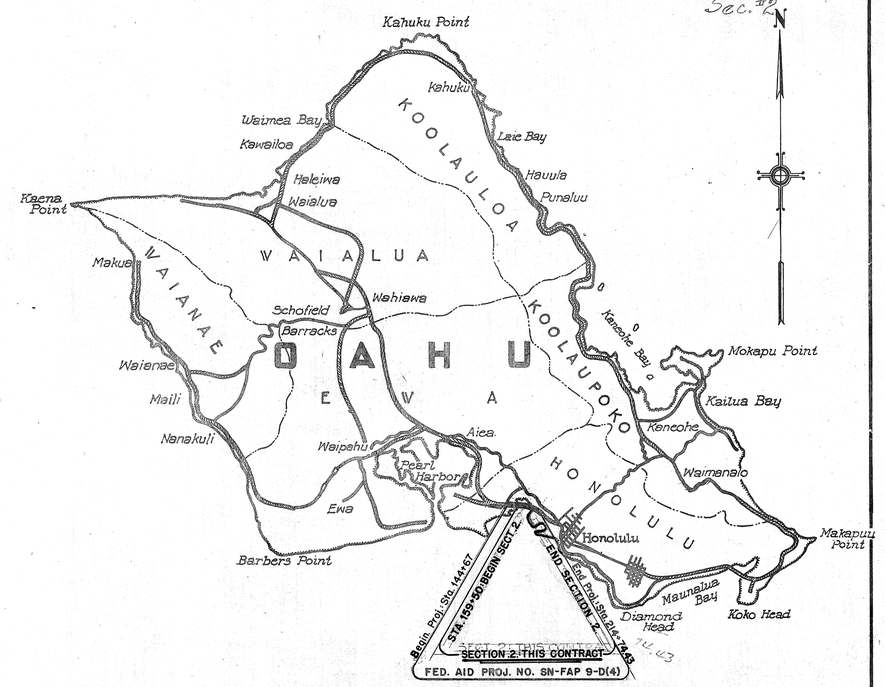

Federal Aid Projects previously constructed or under construction

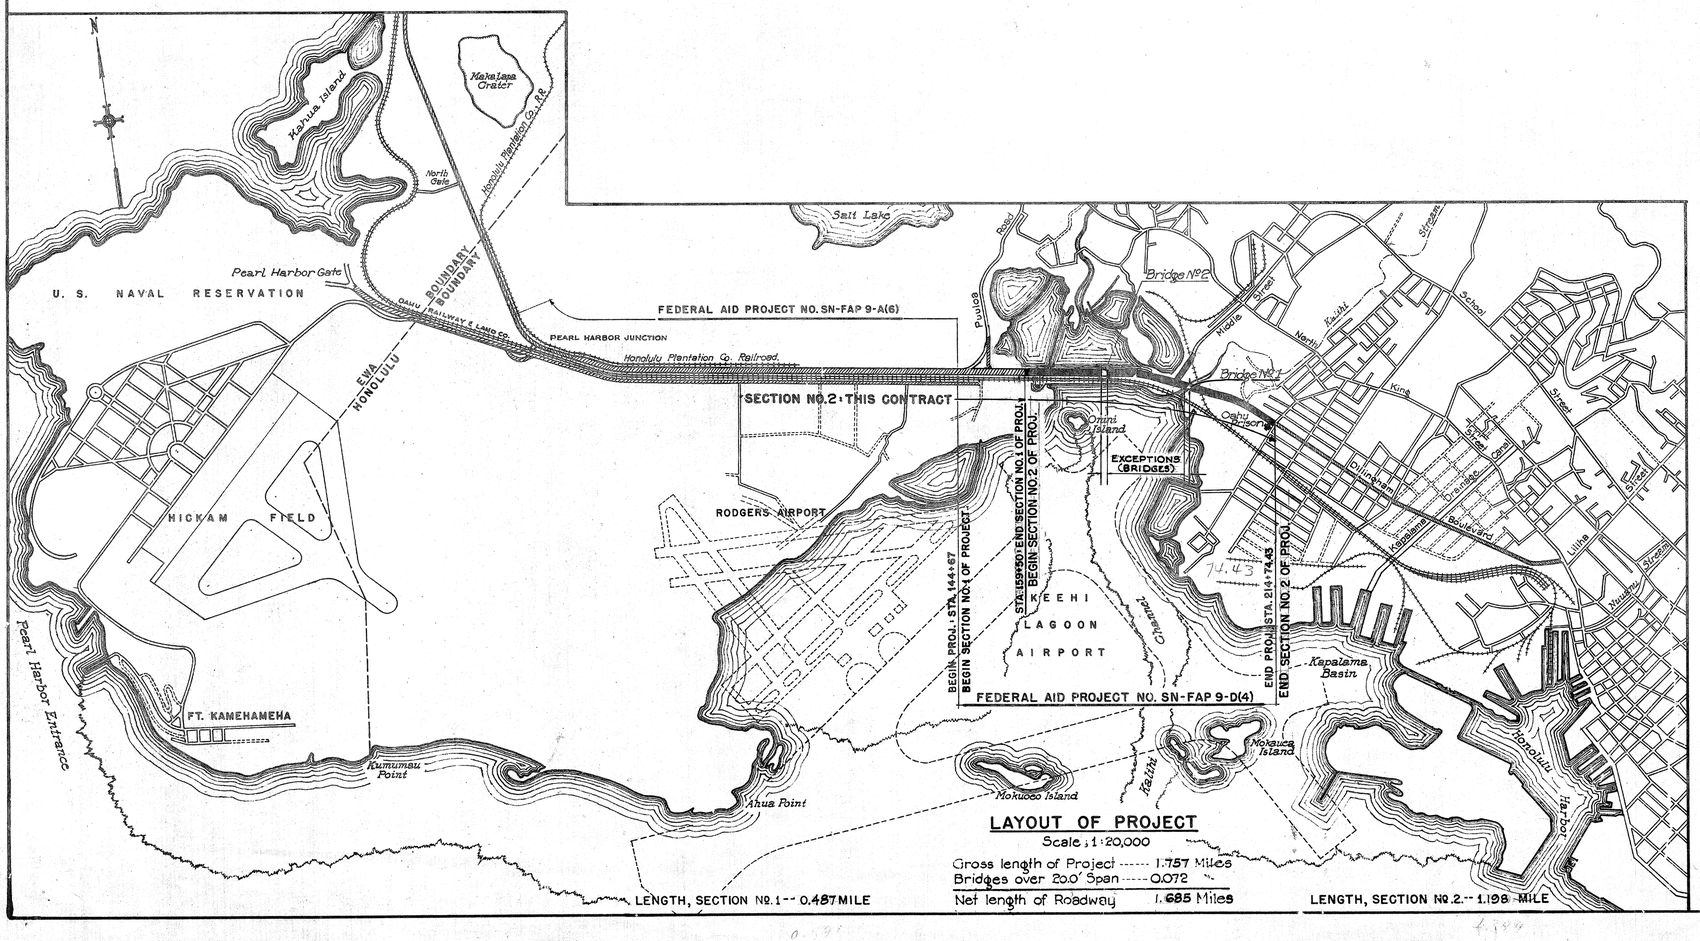

LAYOUT OF PROJECT

Scale: 1:20,000

Gross length of Project ..... 1.757 Miles
Bridges over 20.0' Span 0.072
Net length of Roadway 1.685 Miles

APPROVED

B. F. Rush
Territorial Highway Engineer
Date: 8-22-44

APPROVED

[redacted]

RECOMMENDED FOR APPROVAL

[redacted]

PRINCIPAL HIGHWAY ENGINEER
Public Roads Administration
Federal Works Agency

RECOMMENDED FOR APPROVAL

[redacted]

CHIEF: WESTERN REGION
Public Roads Administration
Federal Works Agency

APPROVED

[redacted]

COMMISSIONER
Public Roads Administration
Federal Works Agency

Revised: May 1944 - Checked by: J.O.Y.

5142.1