| FED. ROAD DIST. NO. | STATE | FED. AID PROJ. NO. | FISCAL YEAR | SHEET NO. | TOTAL SHEETS |
|---|---|---|---|---|---|
| HAWAII | HAW. | S 19(1) | 1947 | 1 | 12 |

## INDEX TO DRAWINGS

| SHEET NO. | DESCRIPTION |
|---|---|
| 1 | Title Sheet |
| 2 | Typical Sections |
| 3-4 | Plan & Profile |
| 5-6 | Standard Details (Sheets 2 & 4) |
| 7-12 | Cross Sections |

All changes made during construction have been shown in red on these tracings and checked.

By E. K. Stone
RESIDENT ENGINEER

Date 7-28-48

TERRITORY OF HAWAII

# TERRITORIAL HIGHWAY DEPARTMENT

HONOLULU - T. H.

## PLANS OF

# PUULOA ROAD

## FEDERAL AID SECONDARY PROJECT NO. S 19 (1)

HONOLULU DISTRICT, ISLAND OF OAHU

### SCALES

| | | |
|---|---|---|
| PLAN | | 1 INCH = 100 FEET & 1 INCH = 50 FEET |
| PROFILE | HOR. | 1 INCH = 100 FEET & 1 INCH = 50 FEET |
| | VER. | 1 INCH = 10 FEET & 1 INCH = 5 FEET |
| CROSS SECTIONS | HOR. | 1 INCH = 10 FEET |
| | VER. | 1 INCH = 10 FEET |

### CONVENTIONAL SIGNS

- Centerline
- Boundary Lines, or
- Fences (Noted), or
- Existing Roadway
- Circular Conc. Culvert
- Railroad
- Telephone Pole — T.P.
- Electric Power Line Pole — E.P.
- Sewer Manhole — S.M.H.
- Telephone Manhole — T.M.H.
- Fire Hydrant — F.H.
- Water Valve — W.V.
- Water Manhole — W.M.H.
- St'd Conc. Roll Curb
- Water Main — W
- Gasoline Pipe Line — G
- Communication Cable
- Warning & Regulatory Signs — (Type)
- Centerline Monument

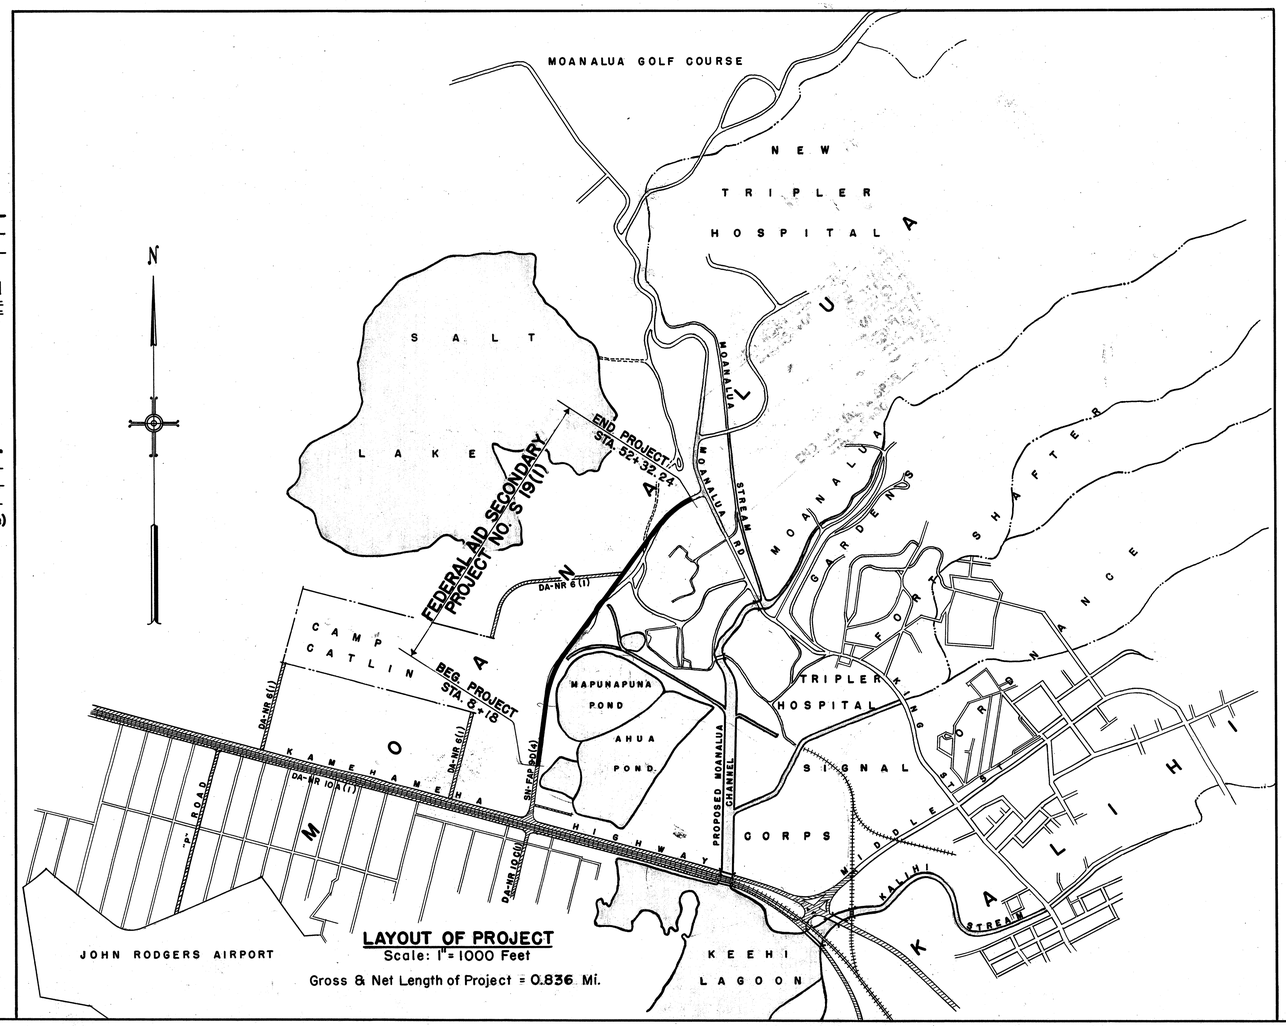


**LAYOUT OF PROJECT**
Scale: 1" = 1000 Feet
Gross & Net Length of Project = 0.836 Mi.

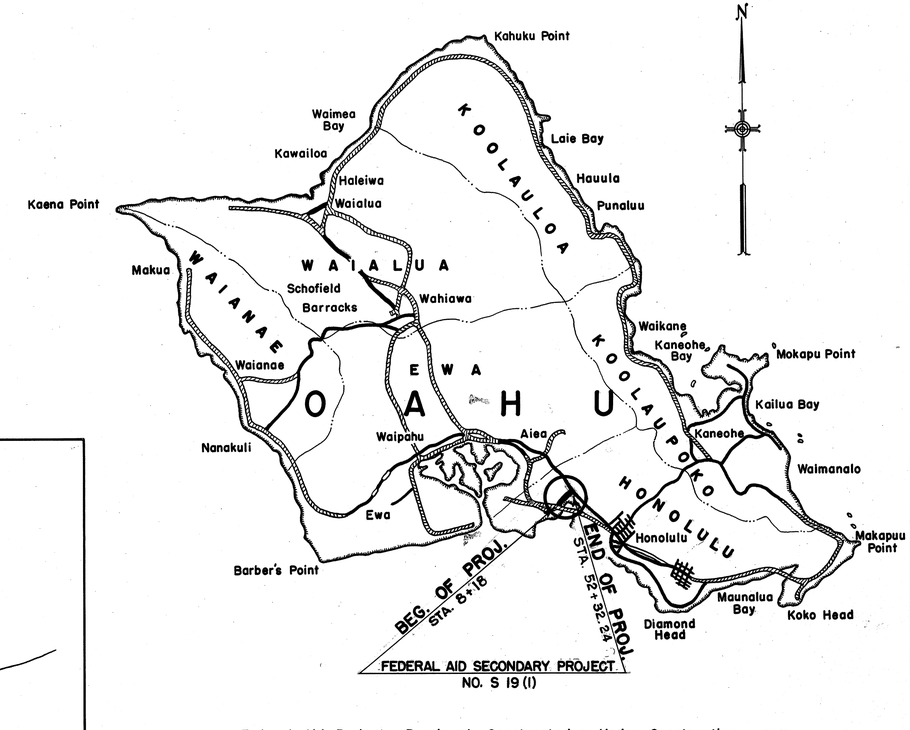


Federal Aid Projects Previously Constructed or Under Construction

APPROVED: DATE 8-13-47
TERRITORIAL HIGHWAY ENGINEER

APPROVED: DATE 10-8-45
B. F. Rush
TERRITORIAL HIGHWAY ENGINEER

RECOMMENDED FOR APPROVAL: DATE
DISTRICT ENGINEER
PUBLIC ROADS ADMINISTRATION
FEDERAL WORKS AGENCY

APPROVED: DATE
DIVISION ENGINEER
PUBLIC ROADS ADMINISTRATION
FEDERAL WORKS AGENCY

| ORIGINAL PLAN | SURVEY PLOTTED BY | DATE |
|---|---|---|
| | DESIGNED BY | |
| | DRAWN BY | |
| NOTE BOOK | TRACED BY | |
| No. | QUANTITIES BY | |
| | QUANTITIES CHECKED BY | |
| | CHECKED BY | |

Rev. 11 July 47

5-31-47

5164.1

DO-K 6